

AC.	ALTERNATING CURRENT	M	MOTOR
ALT.	ALTERNATE	MAX.	MAXIMUM
AR	ALARM RELAY	MCC	MOTOR CONTROL CENTER
AUTO.	AUTOMATIC	MCM	THOUSAND CIRCULAR MILS
AUX.	AUXILIARY	MCP	MOTOR CIRCUIT PROTECTOR
		MECH.	MECHANICAL
BCG	BARE COPPER GROUND	MS	MOTOR STARTER
BD.	BOARD	MC	MAGNETIC CONTACTOR
BLDG.	BUILDING		
		N	NEUTRAL
C	CONDUIT	NA	NON-AUTOMATIC
CHLO.	CHLORINATOR	N.C.	NORMALLY CLOSED
CKT.	CIRCUIT	NEMA	NATIONAL ELECTRICAL MANUFACTURERS ASSOC.
CONT.	CONTINUATION, CONTINUED	NO.	NUMBER
COMP.	COMPRESSOR	N.O.	NORMALLY OPEN
CTRL.	CONTROL		
CR	CONTROL RELAY	OL	THERMAL OVERLOAD RELAY
CT	CURRENT TRANSFORMER		
CS	CONTROL STATION		
		P	POLE
DC	DIRECT CURRENT	PG&E	PACIFIC GAS & ELECTRIC CO.
DISC.	DISCONNECT	PNL.	PANEL
DIST.	DISTRIBUTION	PRI.	PRIMARY
DWG.	DRAWING	PS	PRESSURE SWITCH
DP	DISTRIBUTION PANEL	PSI	POUNDS PER SQUARE INCH
		PT	POTENTIAL TRANSFORMER
		PVC	POLYVINYL CHLORIDE
EXH.	EXHAUST	R	RED
(E), EXIST.	EXISTING	RD	ROAD
ELECT.	ELECTRICAL	RCT	REPEAT CYCLE TIMER
EL., ELEV.	ELEVATION	RECEPT.	RECEPTACLE
EMERG.	EMERGENCY	RM.	ROOM
EQUIP.	EQUIPMENT	RMC	REVERSE MAGNETIC CONTACTOR
ETM	ELAPSED TIME METER		
		SEC.	SECONDS
FLEX.	FLEXIBLE	SPEC.	SPECIFICATIONS
FLUOR.	FLUORESCENT	SULF.	SULFONATOR
FS	FLOW SWITCH	SV	SOLENOID VALVE
FMC	FORWARD MAGNETIC CONTACTOR		
		TEL.	TELEPHONE
G	GREEN	TEMP.	TEMPERATURE
GALV.	GALVANIZED	TERM.	TERMINAL
		TH	THERMOSTAT
		TR	TIMING RELAY
HLS	HIGH LEVEL SENSOR	TRANSF.	TRANSFORMER
HOA	HAND-OFF-AUTOMATIC	TYP.	TYPICAL
HMC	HIGH SPEED MAGNETIC CONTACTOR	TS	TORQUE SWITCH
INC.	INCANDESCENT	V	VOLTS
INST.	INSTANTANEOUS	V-A	VOLT-AMPERES
J	JUNCTION BOX		
		W	WIRE OR WIDTH
KV	KILOVOLTS	W/	WITH
KVA	KILOVOLT AMPERES	WH	WATT HOUR METER
KW	KILOWATTS		
L	LINE		
L1X, L2X	CONTROL POWER SOURCE		
LOL	LOW OIL LEVEL		
LTG.	LIGHTING		
LS	LEVEL SWITCH		
LMC	LOW SPEED MAGNETIC CONTACTOR		

	INDICATES EQUIPMENT REMOVAL
	EXPOSED CONDUIT, SEE NOTE 6
	CONCEALED CONDUIT, SEE NOTE 6
	CALLOUT, INDICATING CONDUIT SIZE, NO. OF WIRES & WIRE SIZE
	CALLOUT, INDICATING CONDUIT PER SCHEDULE
	LIGHTNING CONDUIT RUN. HATCH MARKS INDICATE NO. OF #12 CONDUCTORS NO HATCH MARKS 15 #12
	HOMERUN TO PANELBOARD OR AS INDICATED
	FLEXIBLE CONDUIT
	DEVICE PER LETTER ABBREVIATIONS
	SAFETY SWITCH
	FLUORESCENT LIGHT FIXTURE, SEE NOTE 1
	WALL MOUNTED FIXTURE, SEE NOTE 1
	SINGLE POLE SWITCH, SEE NOTE 2
	THREE-WAY SWITCH, SEE NOTE 2
	MANUAL MOTOR STARTER
	DUPLEX RECEPTACLE MOUNT AT $\pm 4'-0"$ OR AS NOTED
	DUPLEX RECEPTACLE MOUNT AT $\pm 1'-0"$ OR AS NOTED
	DUPLEX RECEPTACLE, MOUNTED ON BACK SPLASH
	GROUND ROD & GROUND ROD BOX
	CONTROL STATION
	UNIT HEATER
	POLE RISER
	WALL TELEPHONE OUTLET, MOUNT AT $1'-0"$ OR AS NOTED
	INSTRUMENTATION DEVICE
	SECURITY ALARM SENSOR
	ZONE 2

ENCLOSURE AS INDICATED

REMOTE CONTROL WIRING

SINGLE POLE CIRCUIT BREAKER

3-POLE CIRCUIT BREAKER

FUSE, AMPERE RATING AS NOTED

CONTROL DEVICE COIL, PREFIX NO. WHEN USED DISTINGUISHES BETWEEN DEVICES OF THE SAME TYPE DEVICE (TYPE PER ABBREVIATIONS)

PUSH-TO-TEST INDICATING LIGHT, COLOR PER ABBREVIATION

NORMALLY OPEN PUSHBUTTON, SEE NOTE 3

NORMALLY CLOSED PUSHBUTTON, SEE NOTE 3

2-POSITION SELECTOR SWITCH

3-POSITION SELECTOR SWITCH

MANUAL STARTER, SINGLE POLE UNLESS OTHERWISE NOTED.

TERMINALS — DISCONNECTING TYPE TERMINALS

GROUND CONNECTION

CONTACT NORMALLY OPEN, SEE NOTES 3, 4 & 5

CONTACT NORMALLY CLOSED, SEE NOTES 3, 4 & 5

SINGLE POLE SWITCH

SWITCH, 3P EXCEPT WHERE NOTED.
RATING AS NOTED

CIRCUIT BREAKER, 3P EXCEPT WHERE NOTED.
RATING IN AMPS AS NOTED. AF-AMP FRAME; AT-AMP TRIP

3P MOTOR CIRCUIT PROTECTOR UPPER NO.
INDICATES FRAME SIZE IN AMPS
LOWER NO. INDICATES TRIP

FUSE, RATING AS NOTED

TRANSFORMER, RATING AS NOTED

CURRENT TRANSFORMER

PANELBOARD

MOTOR, NO. INDICATES HORSEPOWER

DOUBLE THROW SWITCH,
AUTO OR MANUAL AS INDICATED

FULL VOLTAGE, NON-REVERSING
MAGNETIC STARTER, SIZE AS NOTED

SERVICE TERMINATION

ELEMENTARY DIAGRAM REFERENCE NO.

CONTROLS PROVIDED W/EQUIPMENT AND
NOT A PART OF THE ELECTRICAL WORK

DEVICE PER ABBREVIATION

HEATER, RATING AS INDICATED

INDICATES EQUIPMENT REMOVAL



1. LOWER CASE LETTER ADJACENT TO A FIXTURE INDICATES SWITCH CIRCUIT. INSIDE UPPER CASE LETTER INDICATES FIXTURE TYPE AS DESCRIBED IN THE SPECIFICATION AND FIXTURE SCHEDULE.
2. LOWER CASE LETTER ADJACENT TO SWITCH INDICATES SWITCH CIRCUIT.
3. "NORMAL" STATUS OF CONTACTS OR VALVES IS THE SHELF POSITION.
4. NUMBER AND/OR LETTERS IDENTIFY CONTACTS & OPERATING COIL.
5. NUMBER AND/OR LETTERS IDENTIFY DEVICE.
6. CONDUIT SIZE & FILL SHALL BE AS INDICATED. WHERE NO SIZE IS SHOWN, THE CONDUIT SHALL BE SIZED IN ACCORDANCE WITH THE RECENT EDITION OF THE NATIONAL ELECTRICAL CODE.
7. UNDERLINED WORDS SHOWN AT PUSHBUTTONS, LIGHTS, SELECTOR SWITCHES, ETC., INDICATE THE LEGEND PLATE REQUIREMENT FOR THAT PARTICULAR DEVICE. ANY ADDITIONAL NAMEPLATES ARE INDICATED ON ELEVATIONS WITH THE REQUIRED NAMEPLATE INSCRIPTIONS.
8. ADJACENT UPPER CASE LETTER & NUMBER IDENTIFY PANELBOARD & CIRCUIT NUMBER.
9. EXCEPT AS NOTED, EQUIP. MOUNTING HEIGHTS ABOVE FLOOR SHALL BE AS FOLLOWS:

PANELBOARD-----6'-6" (TOP OF ENCLOSURE)
SWITCHES-----4'-0"
RECEPTACLES-----3'-0" PER SPECS.
CONTROL STATIONS-----4'-2"
LIGHTING TRANSF.-----8'-0" (TOP OF)

<u>SYMBOL</u>	<u>TYPE</u>	<u>CLOSED ON</u>
	LEVEL	RISING LEVEL
	LEVEL	FALLING LEVEL
	PRESSURE	RISING PRESSURE
	PRESSURE	FALLING PRESSURE
	LIMIT	ACTUATION

<u>SYMBOL</u>	<u>NORMAL</u>	<u>OPEN TO CLOSE</u>	<u>CLOSE TO OPEN</u>
	OPEN	DELAY	INST.
	CLOSED	INST.	DELAY


@	AT
Y	WYE
▽	DELTA CONNECTED
£	AND
∅	PHASE
⌋	TO CIRCUIT
	INCHES
!	FEET

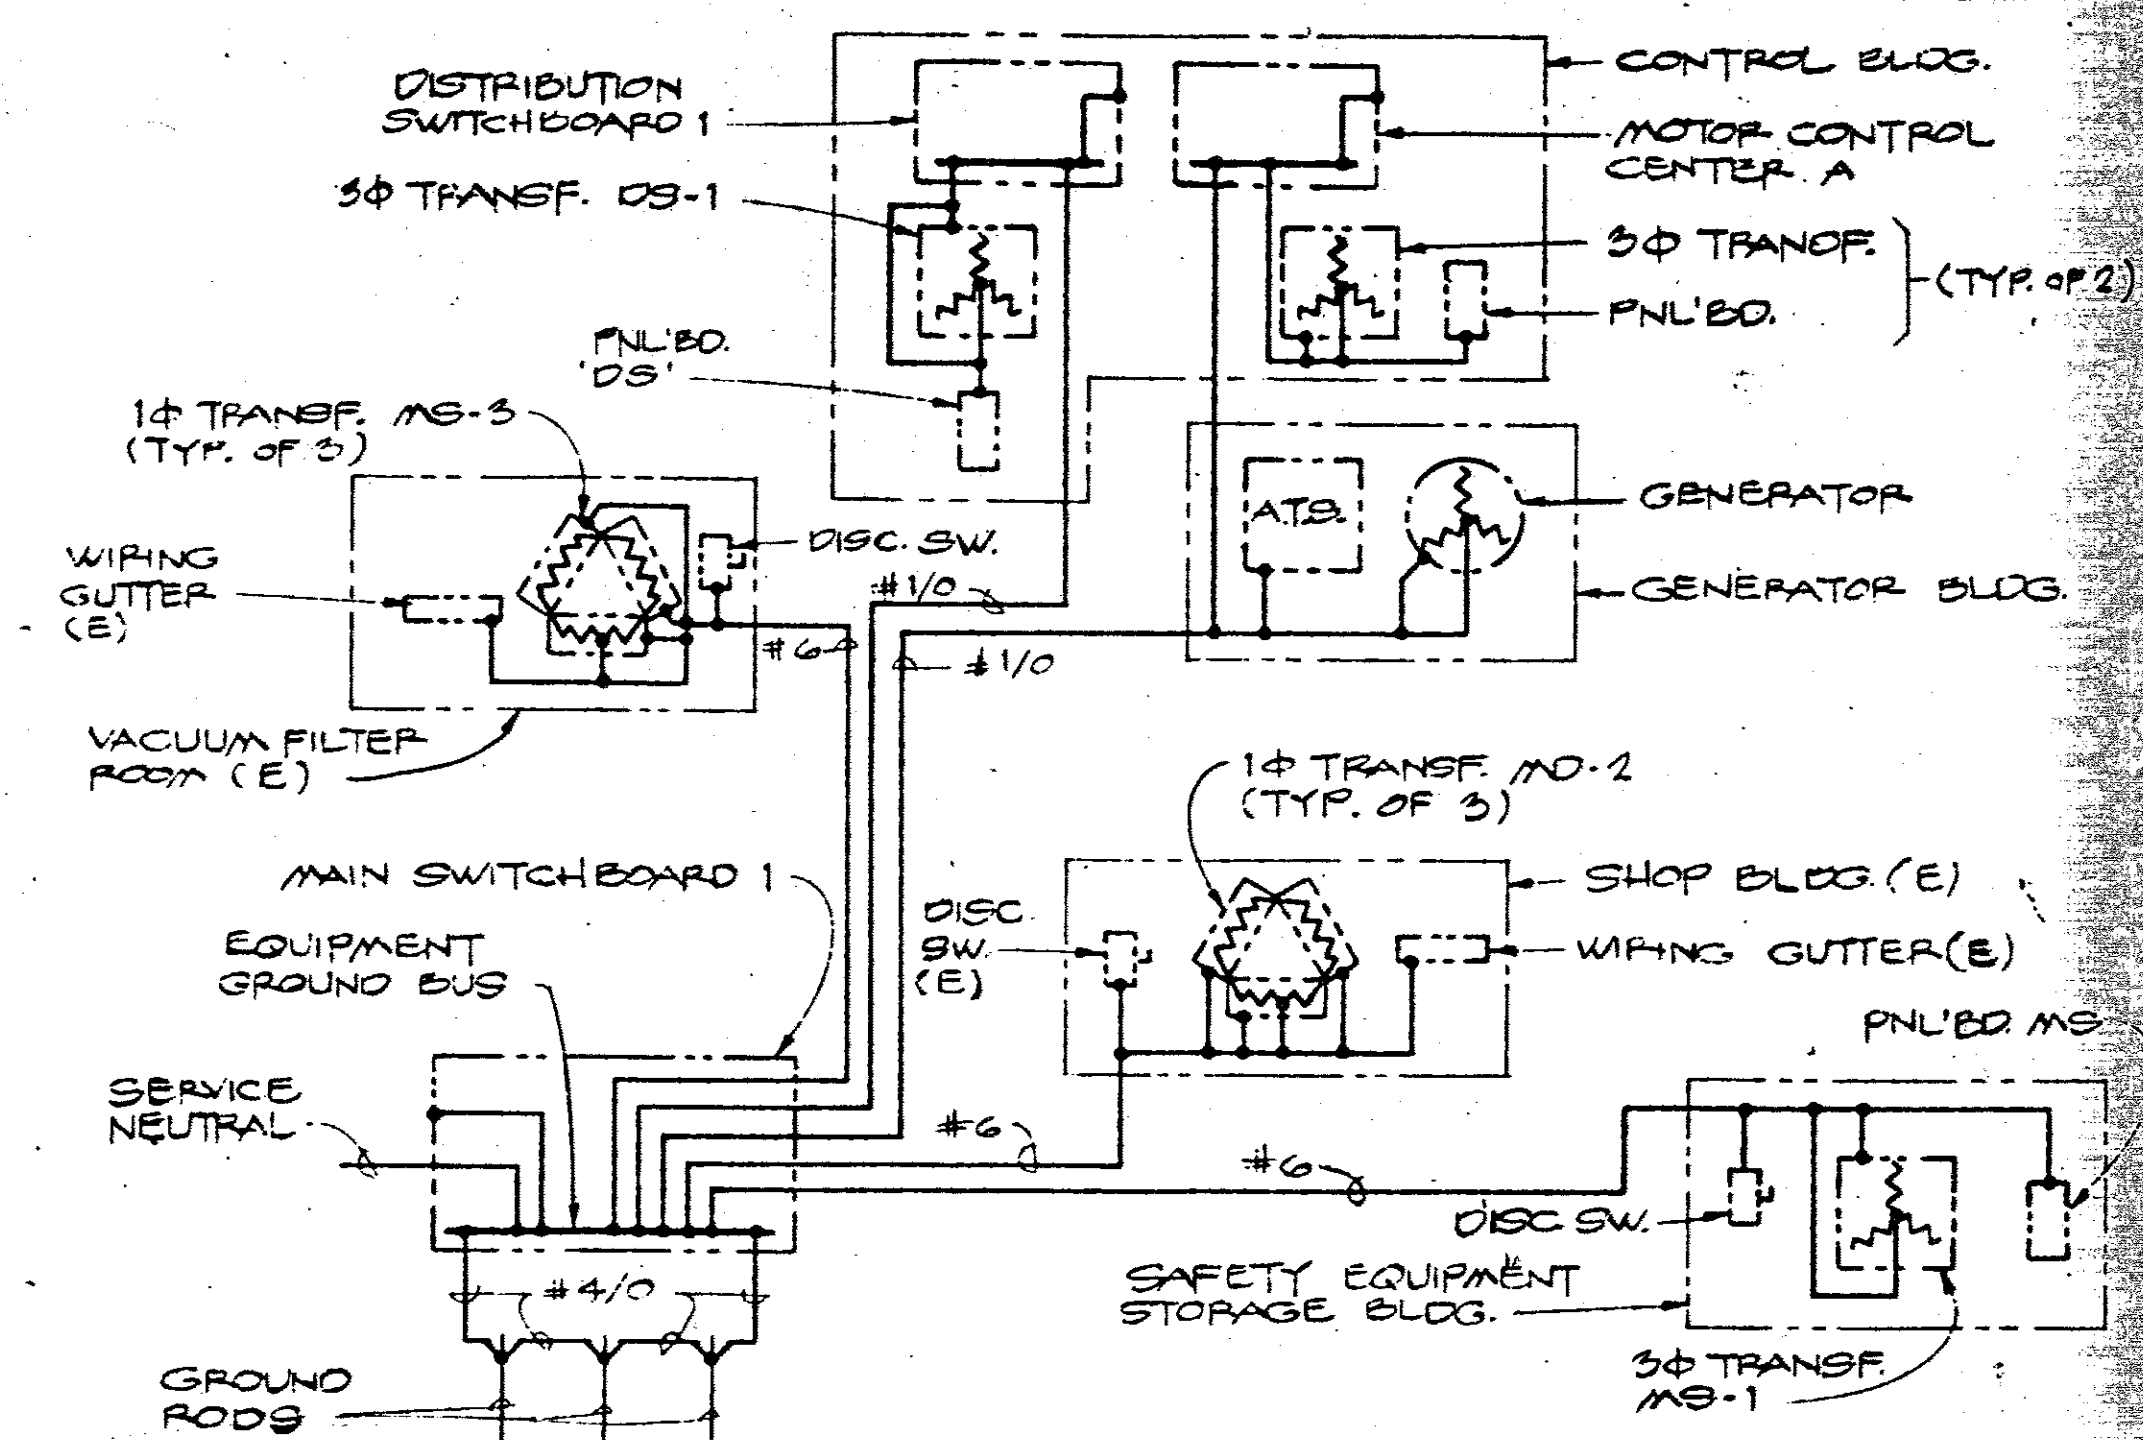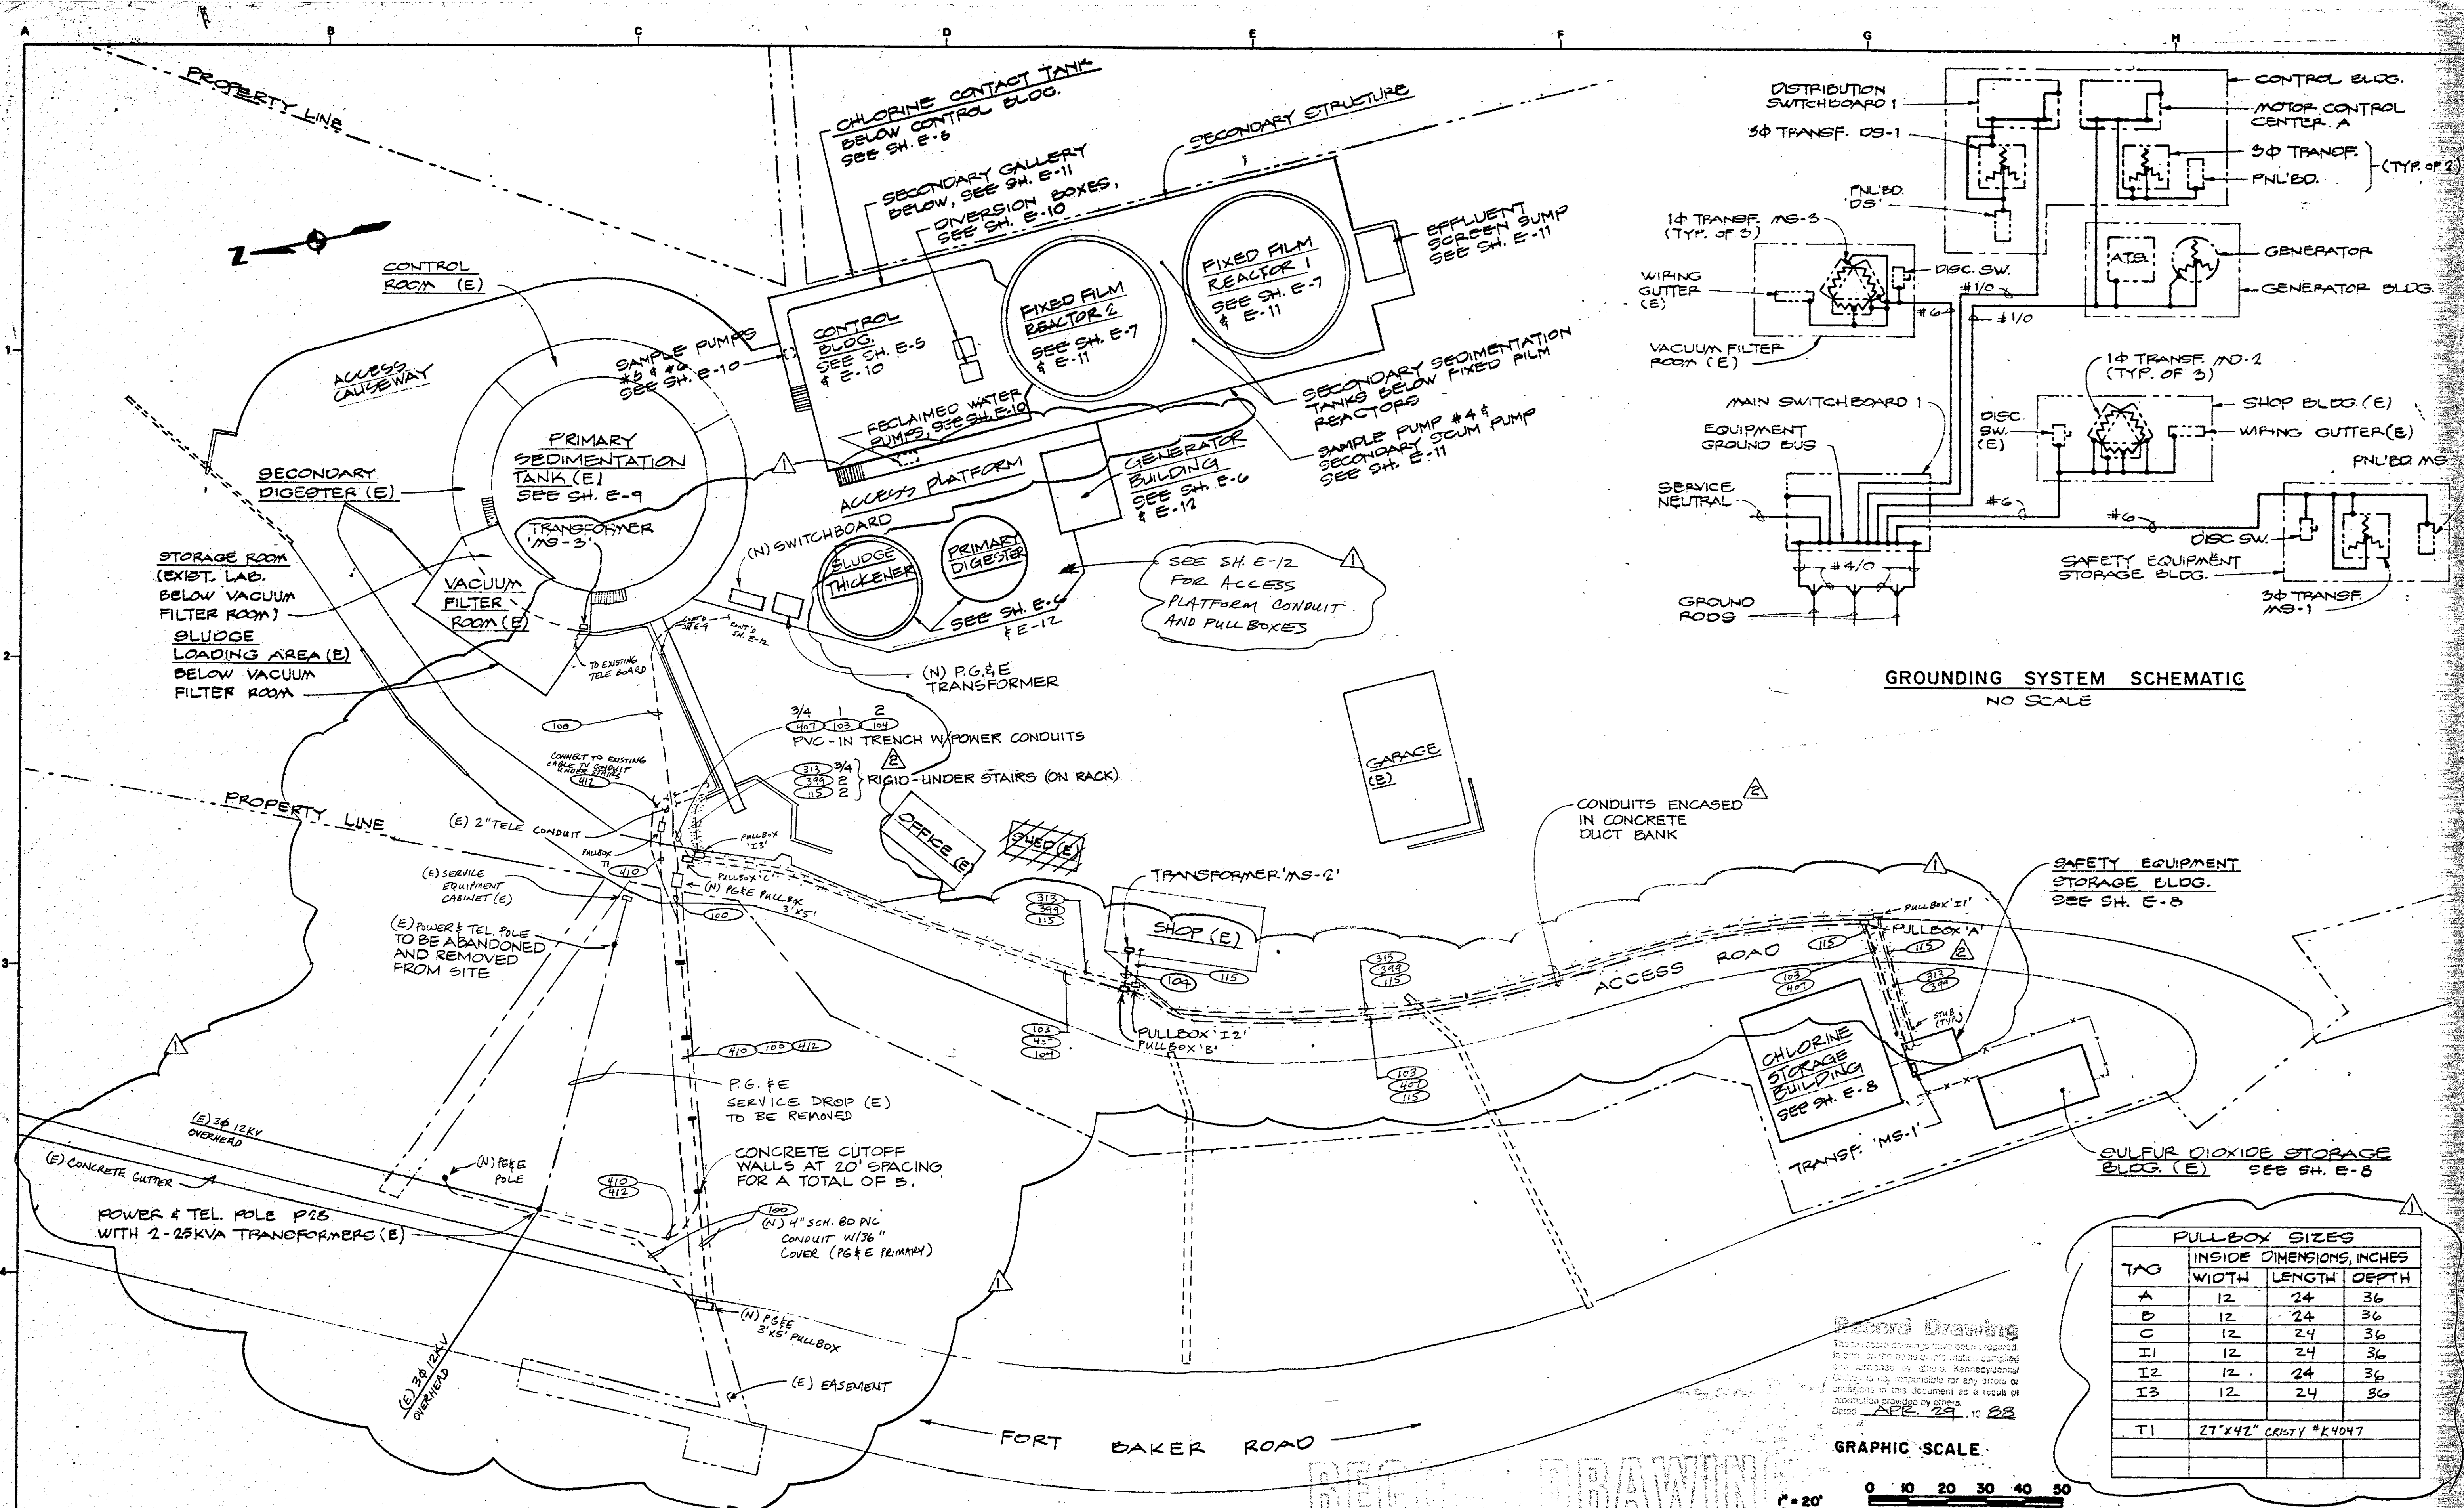


PULLBOX SIZES

TAG	INSIDE DIMENSIONS, INCHES
	WIDTH LENGTH DEPTH
A	12 24 36
B	12 24 36
C	12 24 36
I1	12 24 36
I2	12 24 36
I3	12 24 36
T1	27"X42" CRISTY #K4047


Record Drawing
This record drawing has been prepared in accordance with the provisions of the California Electrical Code, and is intended to be used as a guide for the construction of the project. It is not to be used as a basis for any other project or for any other purpose. The user of this drawing is responsible for any errors or omissions in this document as a result of information provided by others.
Date: APR 29 1988

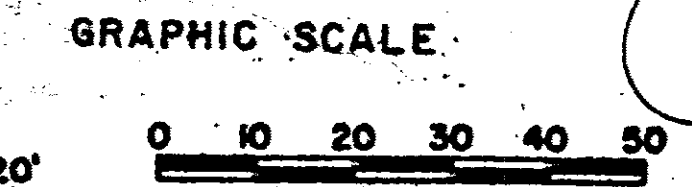

ADDENDUM NO. 2 CO NO. 59 & 8		Reference Information and Notes: 1. SEE SHT. E-8 AND E-9 FOR CONDUIT SCHEDULES.		Record Drawing These drawings have been prepared in accordance with the provisions of the California Electrical Code, and are intended to be used as a guide for the construction of the project. It is not to be used as a basis for any other project or for any other purpose. The user of this drawing is responsible for any errors or omissions in this document as a result of information provided by others. Date: 1/29/81		Wastewater Plant Improvements Sausalito - Marin City Sanitary District C-06-2464 Kennedy/Jenks Engineers San Francisco Submitted: <i>[Signature]</i> Date: 1/29/81		ELECTRICAL SITE PLAN Scale: 1" = 20' Job No. 0112 Sheet E-2 of 2	
--	--	---	--	--	--	---	--	---	--

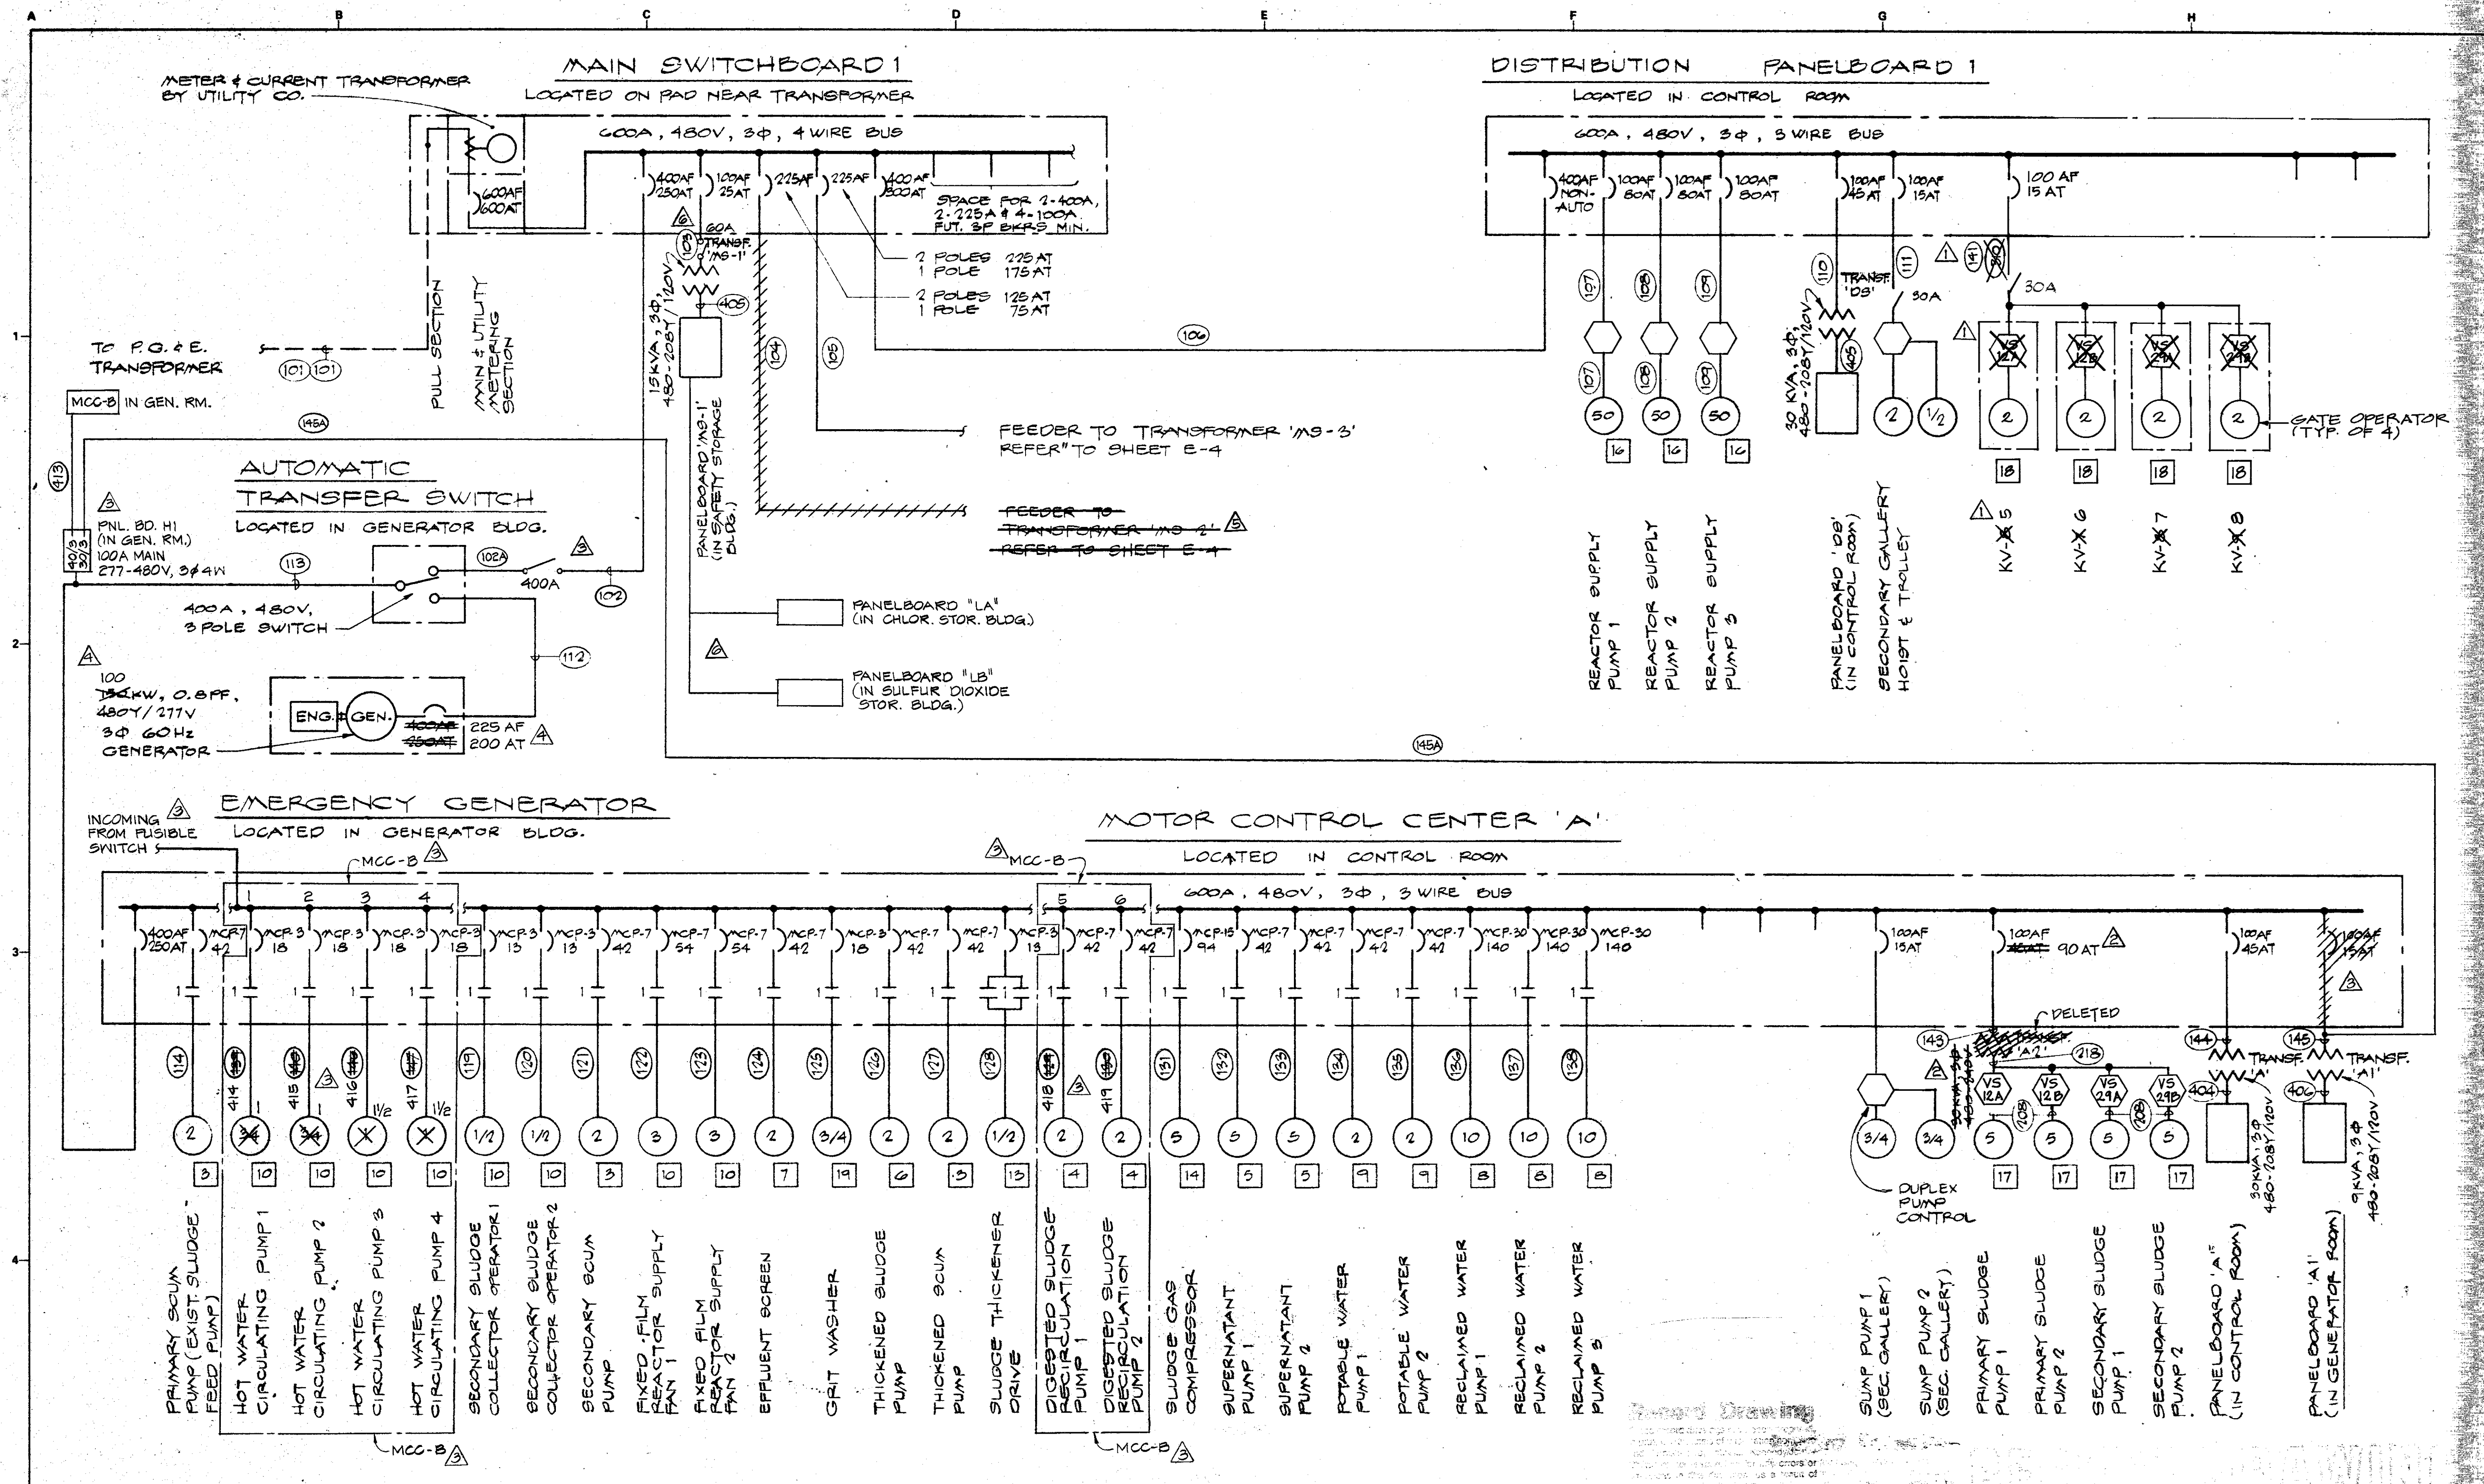


CO NO. 7 CO NO. 15 ADDENDUM NO. 2 CO NO. 12 CO NO. 25 CLARIFICATION Revised Description Submit App'd Date Refer to Tracing for Latest Revision	Reference Information and Notes: Record Drawing These record drawings have been prepared in part on the basis of information compiled and furnished by others. Kennedy/Jenks Engineers is not responsible for any errors or omissions in this document as a result of information provided by others. Date: APR 29, 1988	Designed: RDS Drawn: WL Checked: JWS Date: 1/29/81 Wastewater Plant Improvements C-06-2464 Sausalito - Marin City Sanitary District Kennedy/Jenks Engineers San Francisco Submitted: [Signature] C9373 Approved: [Signature]	Scale: NONE Job No.: 0112 Sheet: E-3 of: 1 SINGLE LINE DIAGRAM I
---	--	--	--

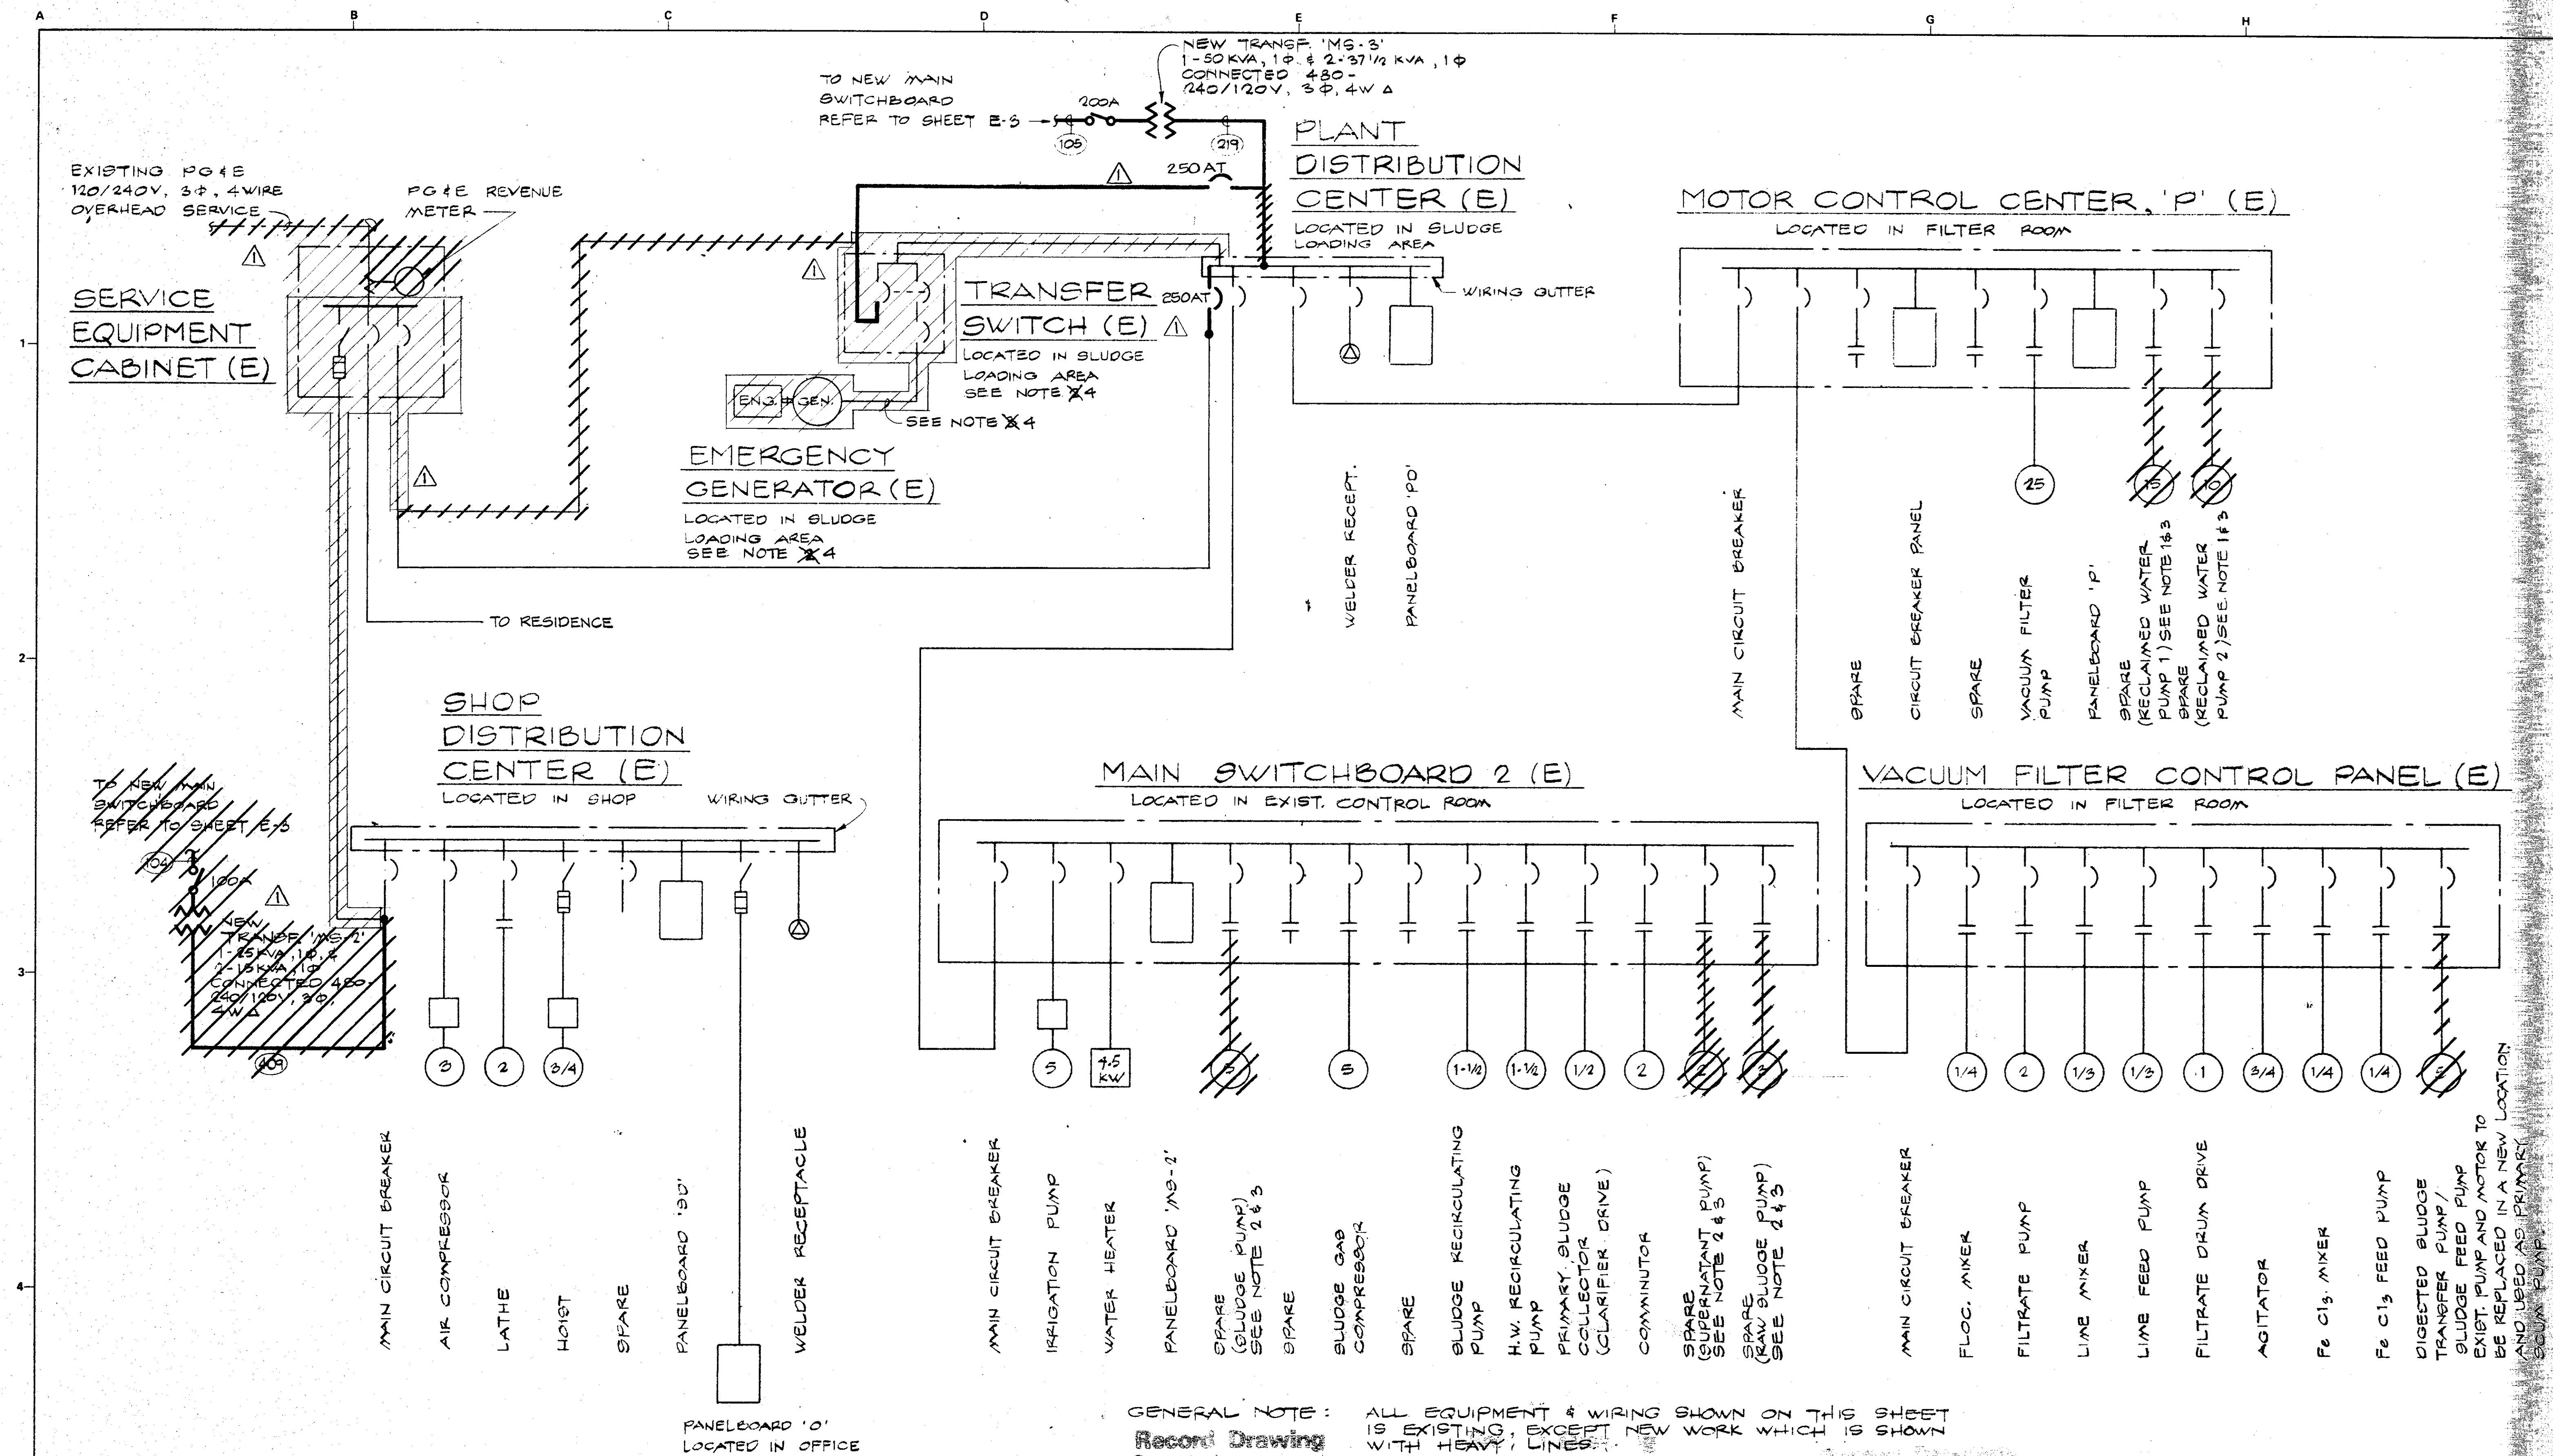


GENERAL NOTE: ALL EQUIPMENT & WIRING SHOWN ON THIS SHEET IS EXISTING, EXCEPT NEW WORK WHICH IS SHOWN WITH HEAVY LINES.

Record Drawing
 These record drawings have been prepared, in part, on the basis of information compiled and furnished by others. Kennedy/Jenks & Associates is not responsible for any errors or omissions in this document as a result of information provided by others.
 APR 29 1988

87 CO NO. 15 Revised Description Submit App'd Date Refer to Tracing for Latest Revision <td data-bbox="778 1829 1663 1992"> Reference Information and Notes: 1. TO BE DISCONNECTED AND ABANDONED IN PLACE. 2. TO BE REMOVED AND DELIVERED TO OWNER. 3. ABANDON CONDUIT AND CONDUCTORS IN PLACE. 4. TO BE LEFT IN PLACE AND REUSED </td> <td data-bbox="1663 1829 2334 1992"> Designed ROB Drawn WL Checked JWS Date 1/29/81 Wastewater Plant Improvements C-06-2464 Sausalito - Marin City Sanitary District Kennedy/Jenks Engineers San Francisco Submitted: Walter A. Salsman CSE:G Robert J. Leman <td data-bbox="2334 1829 3006 1992"> Scale NONE Job No. 0112 Sheet E-4 of 1 SINGLE LINE DIAGRAM 2 </td> </td>	Reference Information and Notes: 1. TO BE DISCONNECTED AND ABANDONED IN PLACE. 2. TO BE REMOVED AND DELIVERED TO OWNER. 3. ABANDON CONDUIT AND CONDUCTORS IN PLACE. 4. TO BE LEFT IN PLACE AND REUSED	Designed ROB Drawn WL Checked JWS Date 1/29/81 Wastewater Plant Improvements C-06-2464 Sausalito - Marin City Sanitary District Kennedy/Jenks Engineers San Francisco Submitted: Walter A. Salsman CSE:G Robert J. Leman <td data-bbox="2334 1829 3006 1992"> Scale NONE Job No. 0112 Sheet E-4 of 1 SINGLE LINE DIAGRAM 2 </td>	Scale NONE Job No. 0112 Sheet E-4 of 1 SINGLE LINE DIAGRAM 2
---	---	---	---

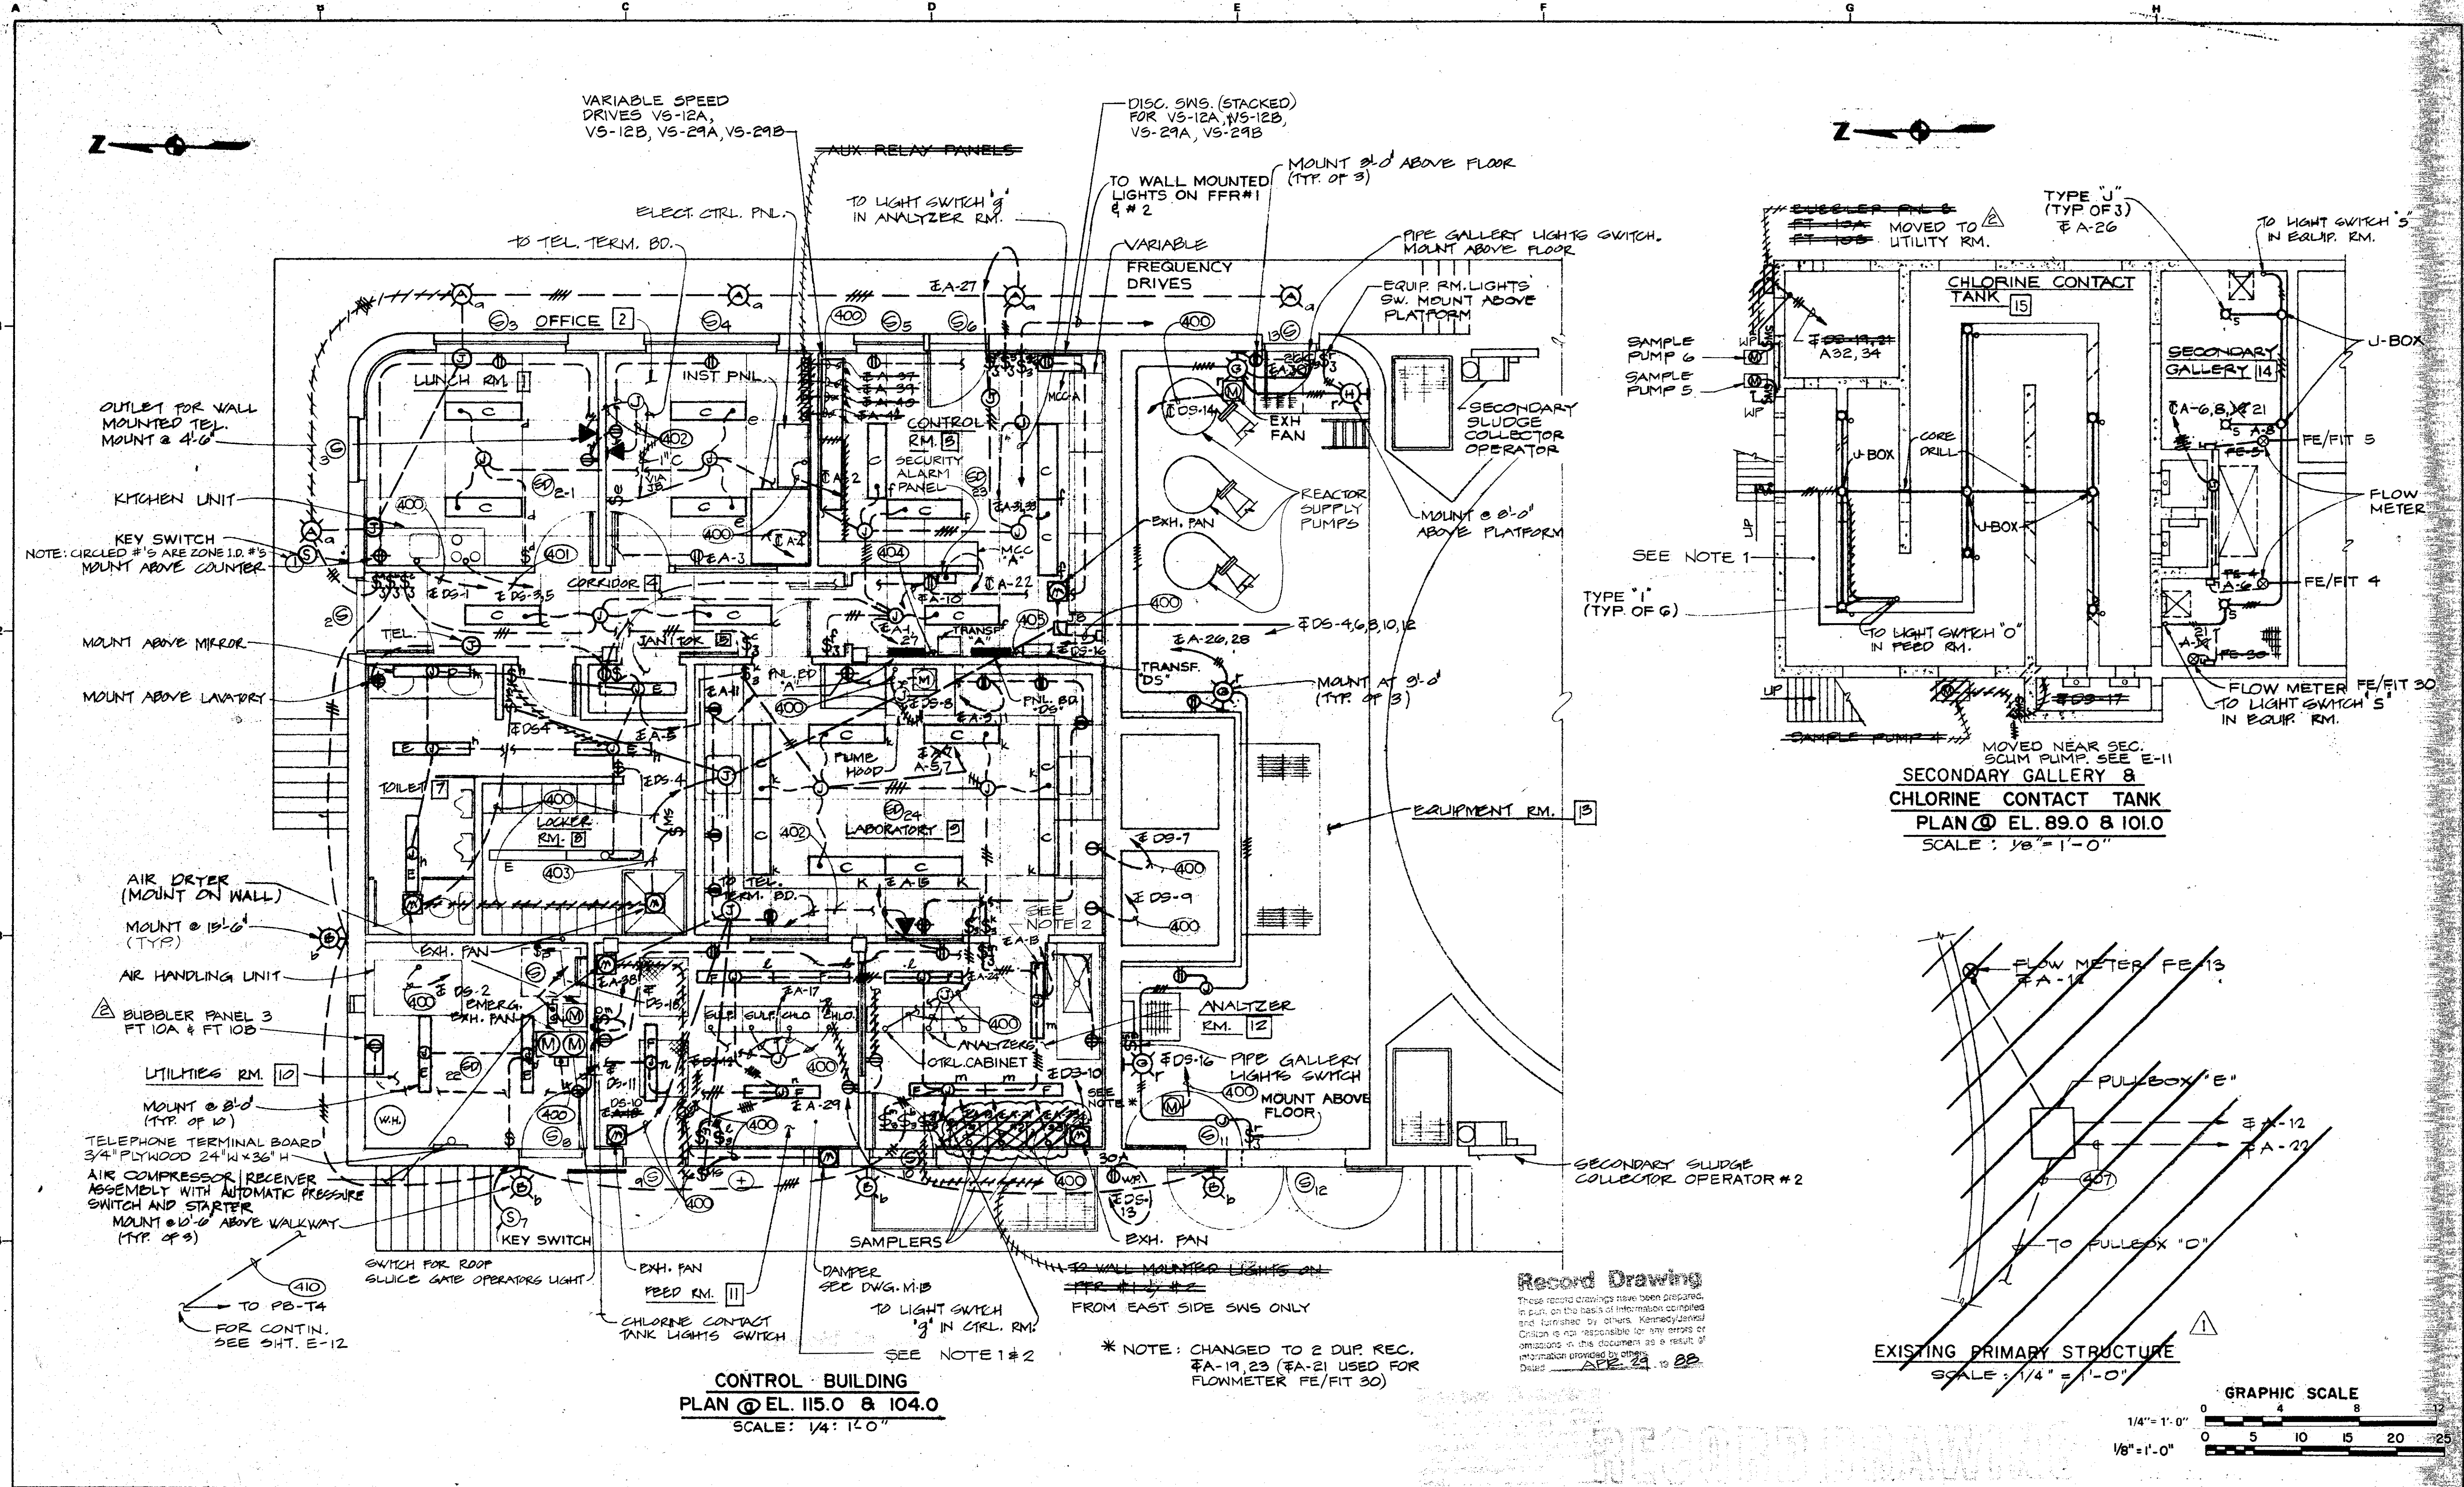

FIELD CHANGE CO NO. 53 CO NO. 16		Reference Information and Notes: 1. RM. IS CORROSIVE ATMOSPHERE. PROVIDE CONDUIT SEAL FOR EVERY CONDUIT THAT LEAVES THE BLDG. 2. MOUNT TYPE "F" LT. FIXTURE 9'-0" ABOVE FLOOR. 3. NUMEROUS FIELD CHANGES WITHIN CONTROL BUILDING NOT DESIGNATED BY ③.		Designed AA Drawn WL/LCS Checked JWS Date 11/29/01	Wastewater Plant Improvements Sausalito - Marin City Sanitary District C-06-2464 Kennedy/Jenks Engineers Submitted: <i>Walter Schuman</i> C9270 Approved: <i>Paul J. Green</i>	LIGHTING PLANS I Scale AS NOTED Job No. 0112 Sheet E-5 of
---	--	---	--	---	---	--

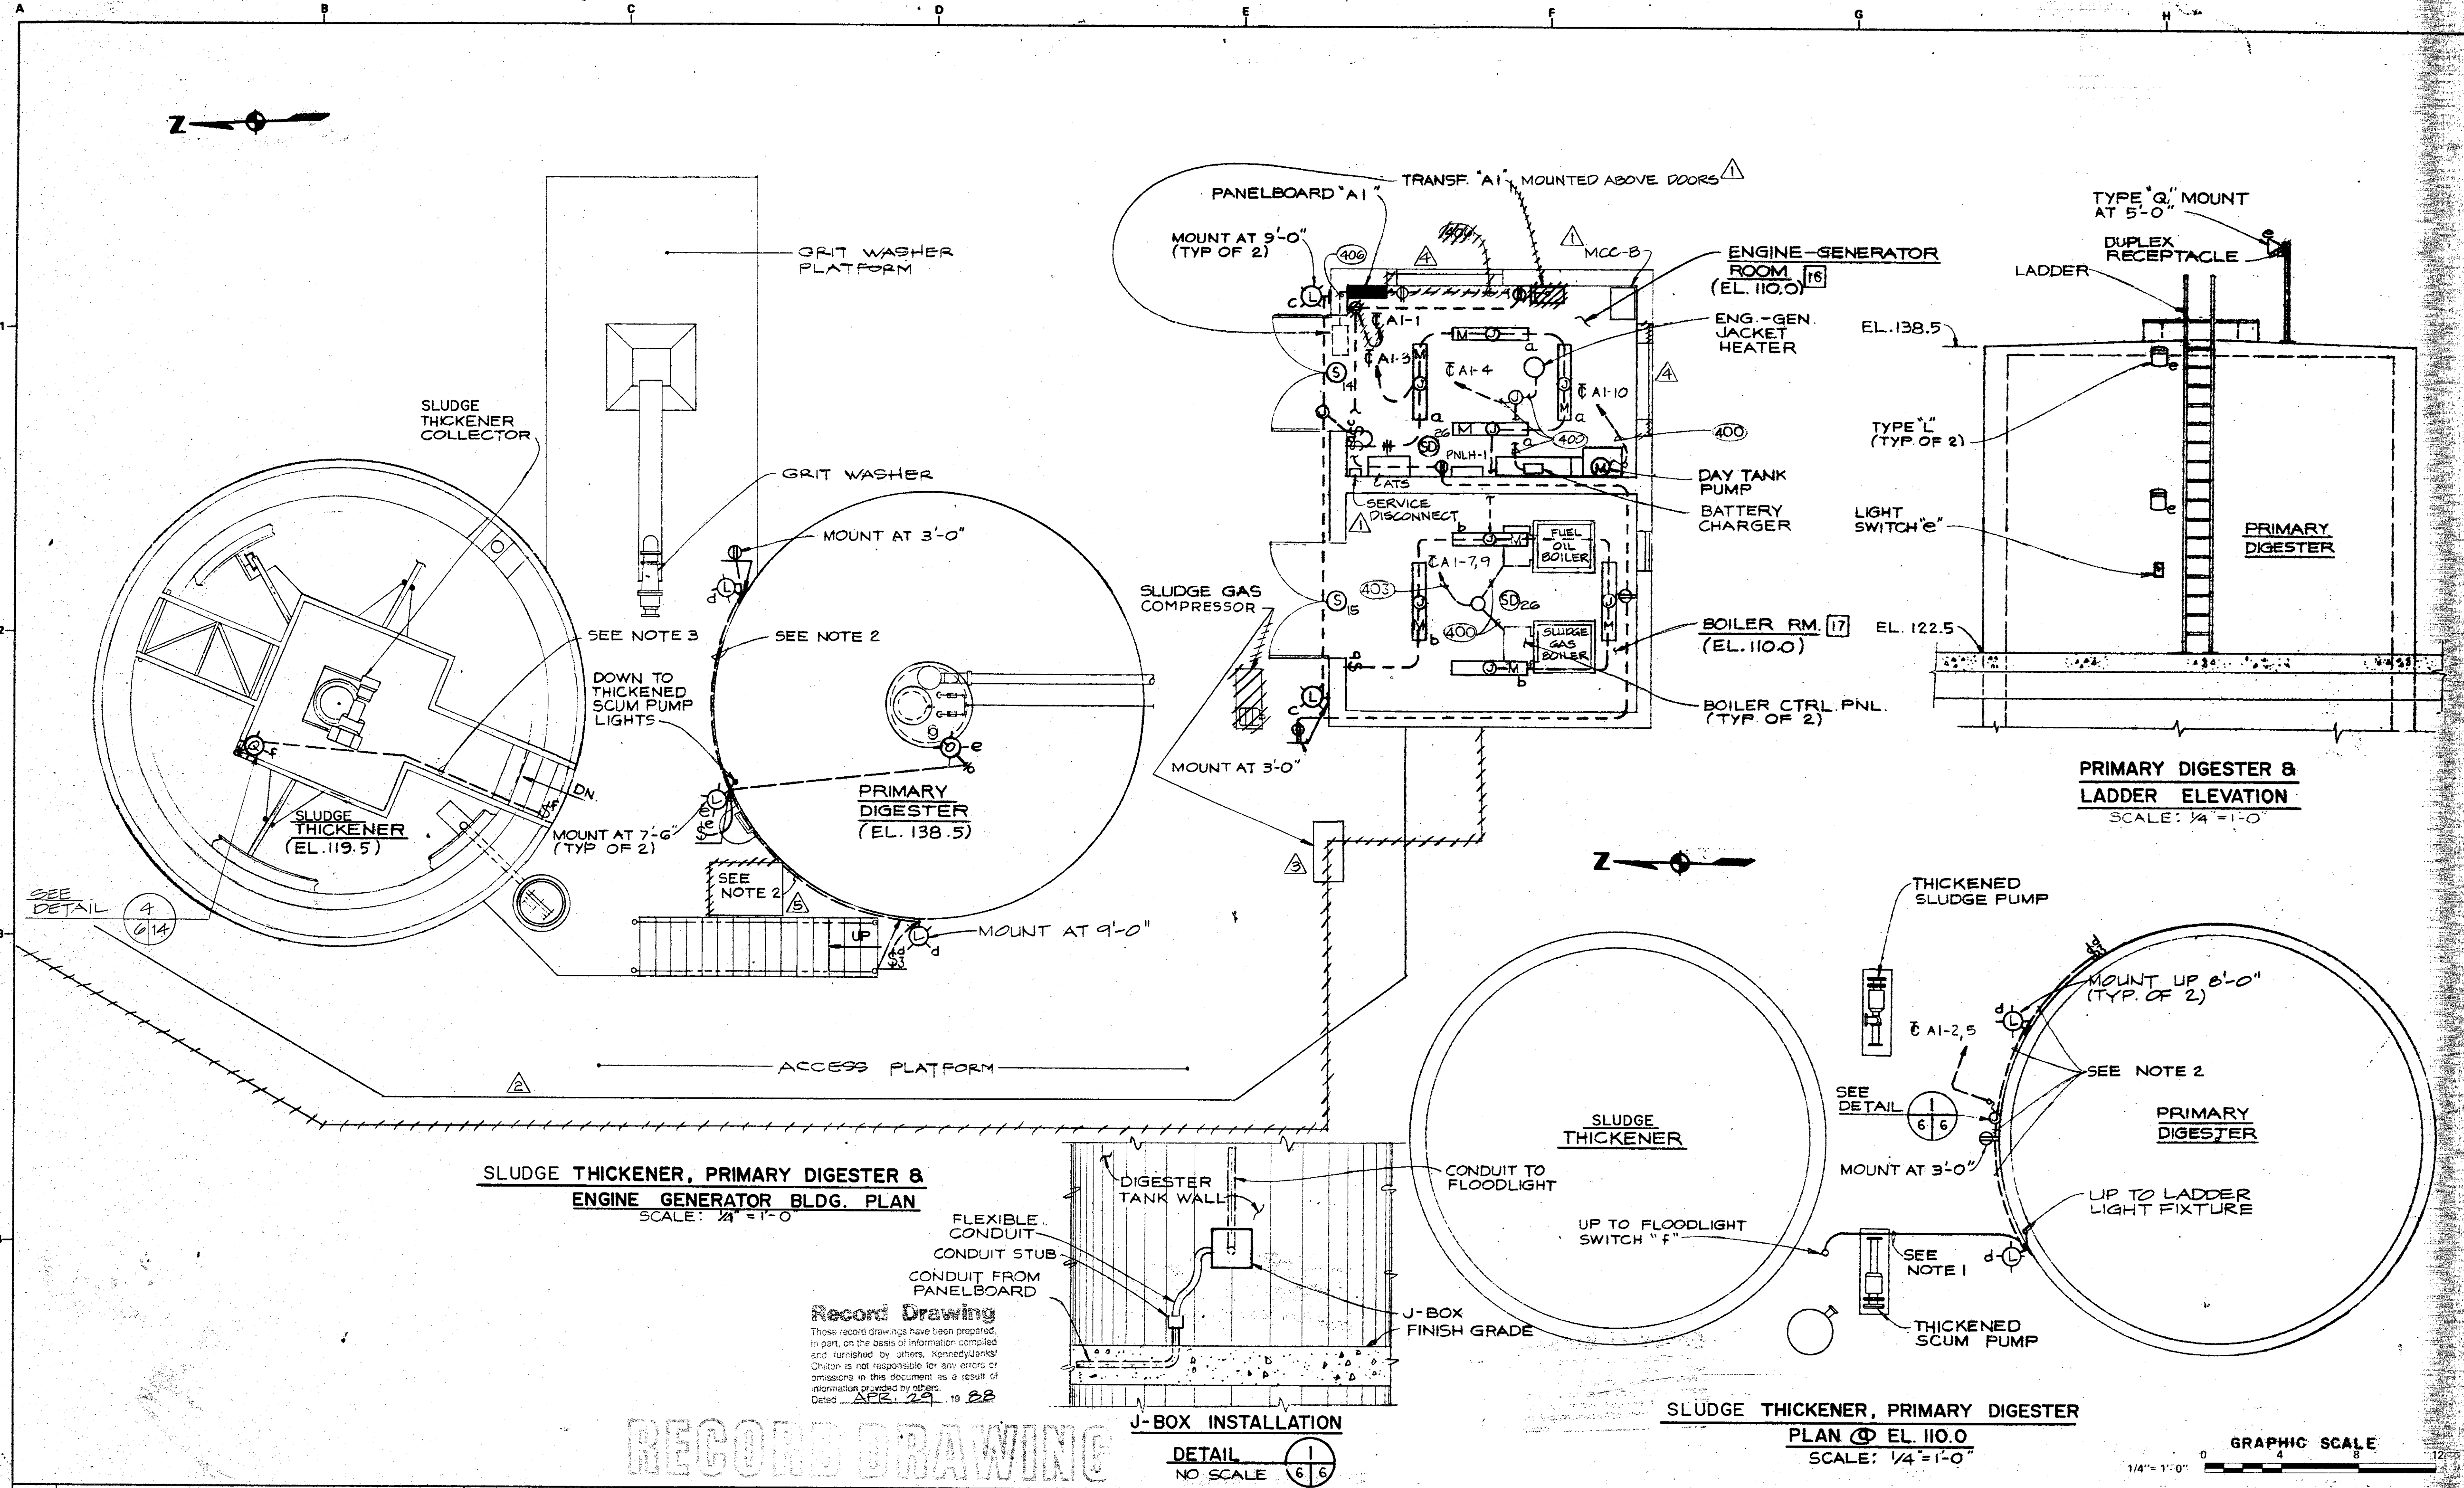

Revised	Description	Submit	Appr'd	Date
1	FIELD CHANGE			
2	CO NO. 50			
3	CO NO. 35			
4	CO NO. 23			
5	CO NO. 12			

Reference Information and Notes:

1. RUN & SUPPORT CONDUIT ON UNDERSIDE OF DEGRITTER PLATFORM.
2. CONCEAL CONDUIT IN PRIMARY DIGESTER WALL.
3. RUN & SUPPORT CONDUIT ON UNDERSIDE OF WALKWAY.

Designed: A.A.
Drawn: CB/LCS
Checked: JWS
Date: 11/29/81


Wastewater Plant Improvements C-06-2464
Sausalito - Marin City Sanitary District

Kennedy/Jenks Engineers
Submitted: [Signature]
Approved: [Signature]
C9370


San Francisco

LIGHTING PLANS 2

Scale: AS NOTED
Job No. 0112
Sheet E-6 of

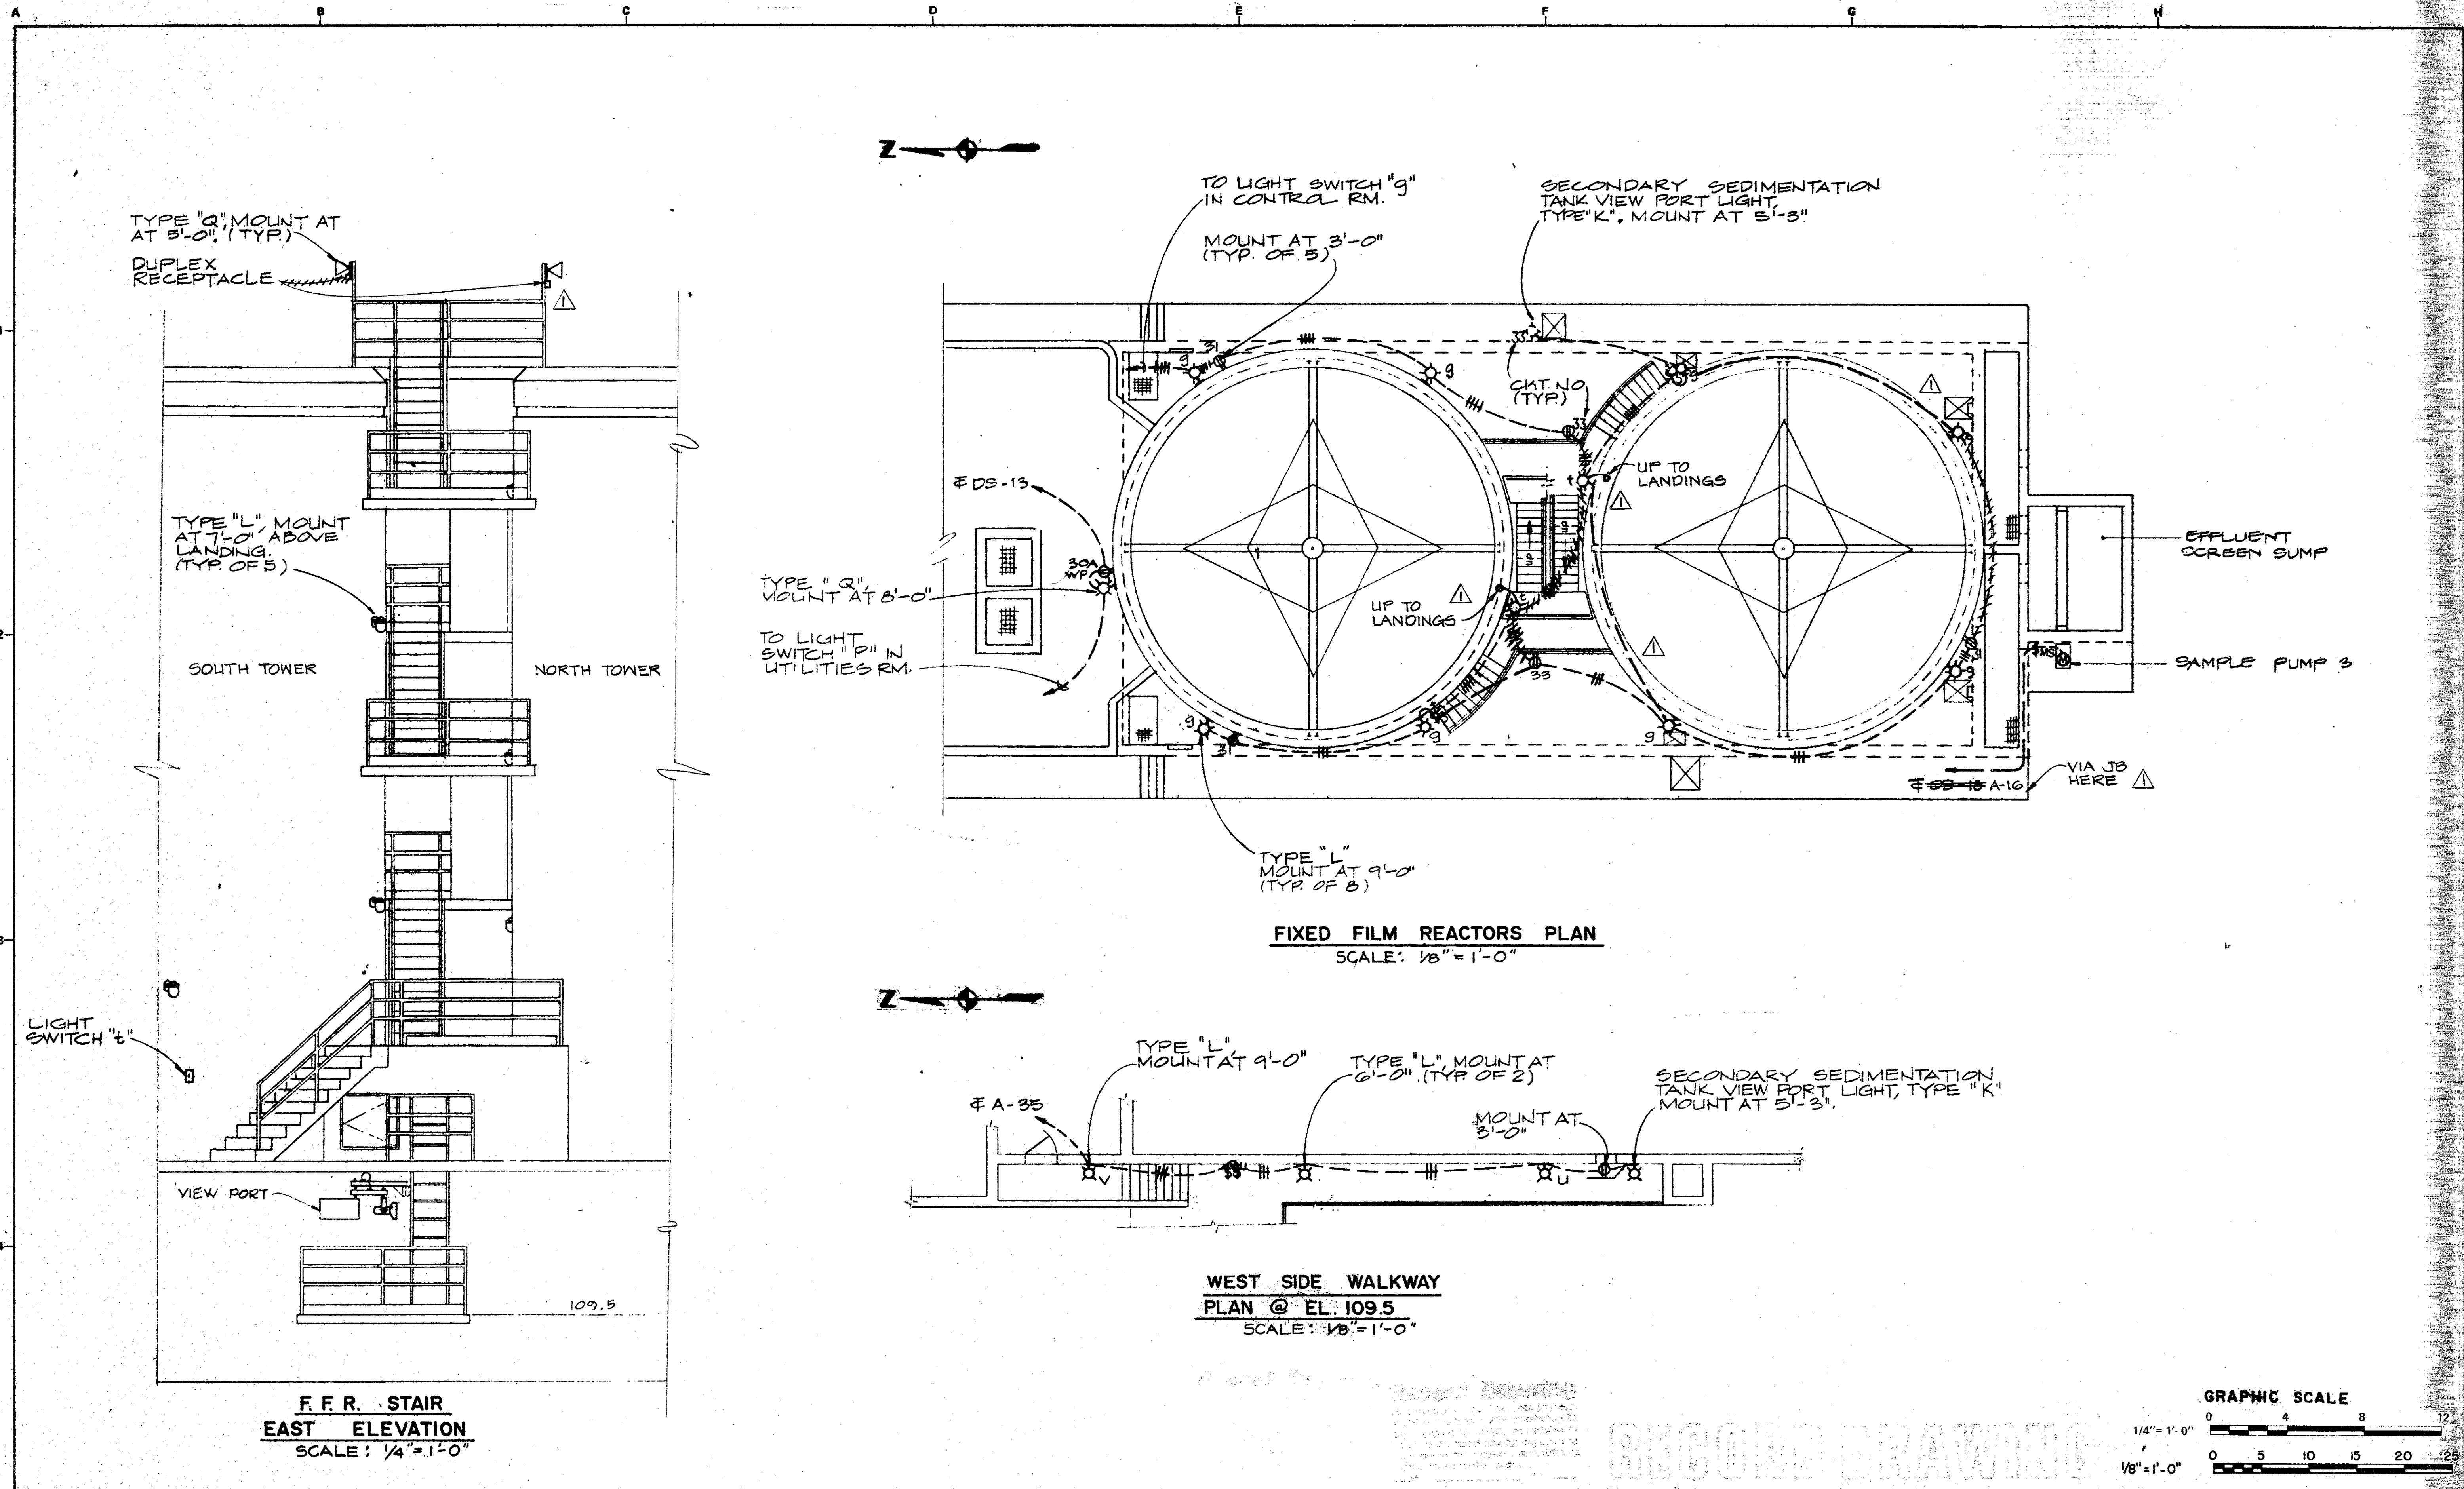

▲ FIELD CHANGE <table border="1" style="width:100%; border-collapse: collapse; font-size: 8px;"> <thead> <tr> <th>Revised</th> <th>Description</th> <th>Submit</th> <th>App'd</th> <th>Date</th> </tr> </thead> <tbody> <tr> <td> </td> <td> </td> <td> </td> <td> </td> <td> </td> </tr> </tbody> </table>				Revised	Description	Submit	App'd	Date						Reference Information and Notes: These record drawings have been prepared in part on the basis of information compiled and furnished by others. Kennedy/Jenks & Gilson is not responsible for any errors or omissions in this document as a result of information provided by others. Date: <u>APR 29, 1988</u>		Record Drawing Designed: <u>AA</u> Drawn: <u>WL/LCS</u> Checked: <u>JWS</u> Date: <u>1/29/81</u>		Wastewater Plant Improvements C-06-2484 Sausalito - Marin City Sanitary District Kennedy/Jenks Engineers San Francisco Submitted: <u>Walter J. Spina</u> C9370 Approved: <u>Robert J. Gentry</u>		LIGHTING PLANS 3		Scale AS NOTED Job No. 0112 Sheet E-7 of
				Revised	Description	Submit	App'd	Date														
GRAPHIC SCALE 1/4" = 1'-0" 1/8" = 1'-0"																						

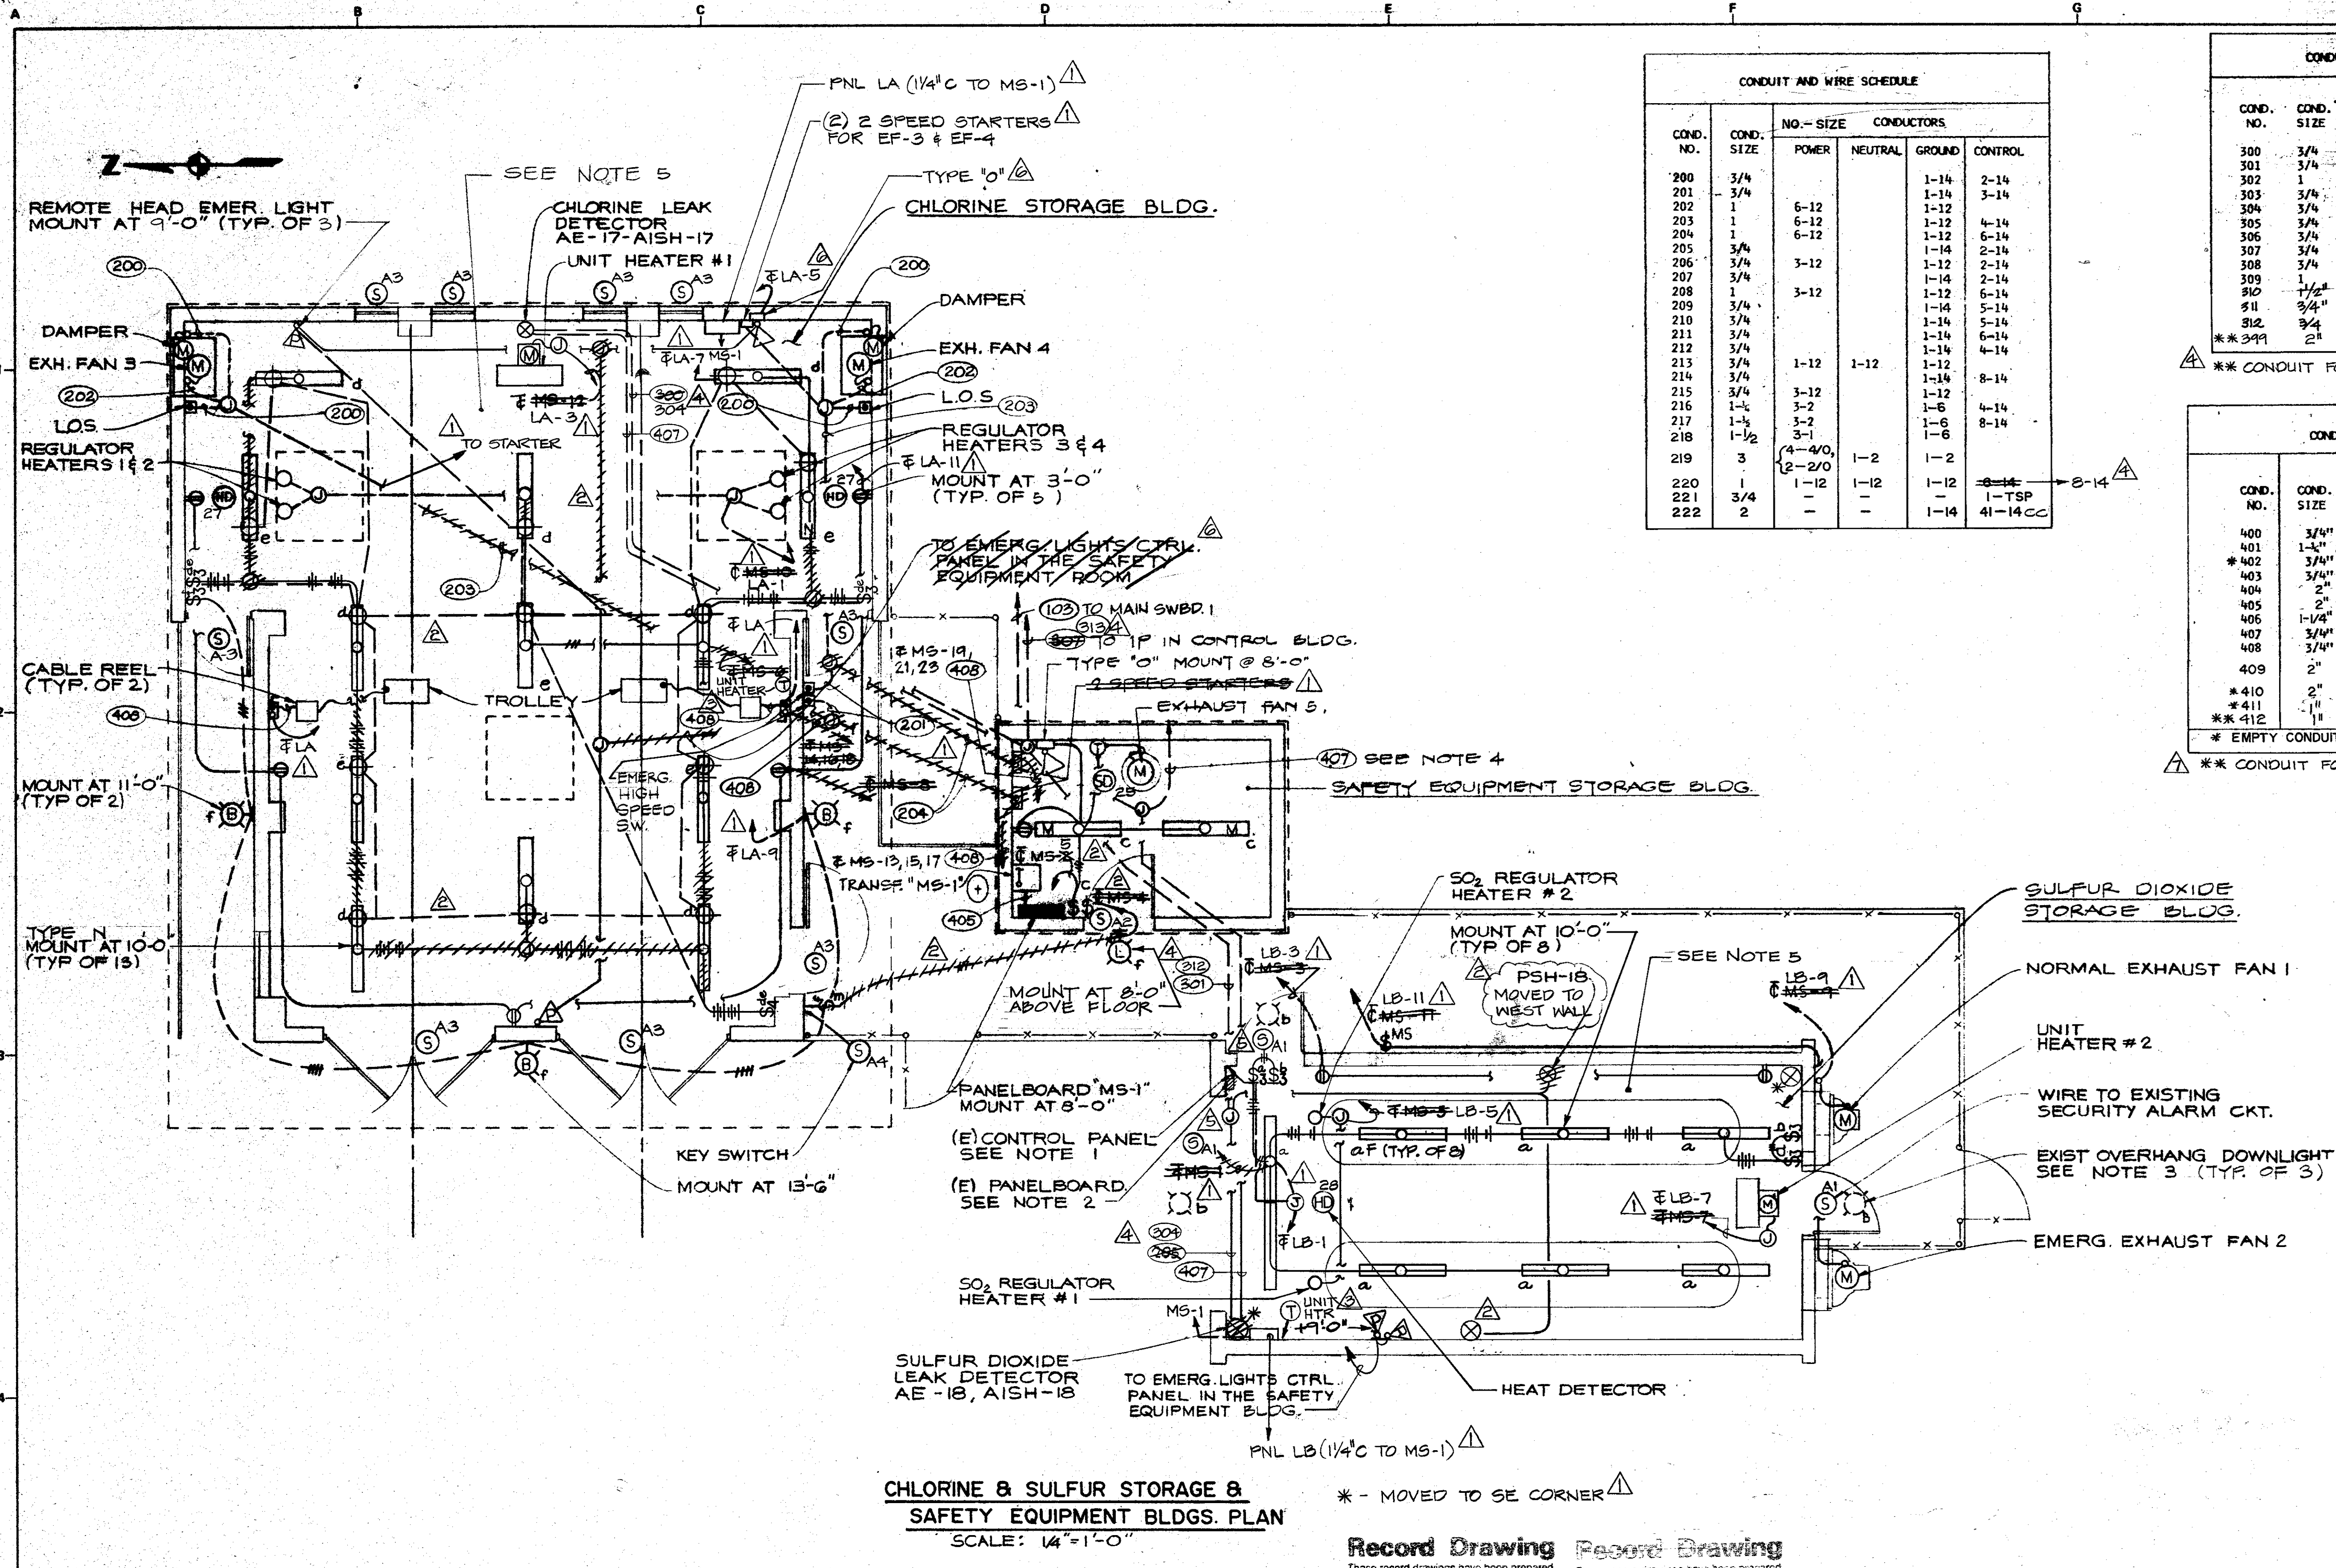

CONDUIT AND WIRE SCHEDULE					
COND. NO.	COND. SIZE	NO. - SIZE CONDUCTORS			
		POWER	NEUTRAL	GROUND	CONTROL
200	3/4			1-14	2-14
201	3/4			1-14	3-14
202	1	6-12		1-12	
203	1	6-12		1-12	4-14
204	1	6-12		1-12	6-14
205	3/4			1-14	2-14
206	3/4	3-12		1-12	2-14
207	3/4			1-14	2-14
208	1	3-12		1-12	6-14
209	3/4			1-14	5-14
210	3/4			1-14	5-14
211	3/4			1-14	6-14
212	3/4			1-14	4-14
213	3/4	1-12	1-12	1-12	
214	3/4			1-14	8-14
215	3/4	3-12		1-12	
216	1-1/2	3-2		1-6	4-14
217	1-1/2	3-2		1-6	8-14
218	1-1/2	3-1		1-6	
219	3	4-4/0, 2-2/0	1-2	1-2	
220	1	1-12	1-12	1-12	8-14
221	3/4	-	-	-	1-TSP
222	2	-	-	1-14	41-14 CC

CONDUIT AND WIRE SCHEDULE					
COND. NO.	COND. SIZE	NO. - SIZE CONDUCTORS			
		POWER	NEUTRAL	GROUND	CONTROL
300	3/4			1-14	2-14
301	3/4			1-14	4-14
302	1			1-14	8-14
303	3/4			1-14	4-14
304	3/4				1-TSP
305	3/4			1-14	2-14
306	3/4			1-14	5-14
307	3/4			1-14	6-14
308	3/4			1-14	7-14
309	1			1-14	8-14
310	1 1/2			1-14	20-14
311	3/4			1-14	7-14
312	2				2-TSP
** 349					

CONDUIT AND WIRE SCHEDULE					
COND. NO.	COND. SIZE	NO. - SIZE CONDUCTORS			
		POWER	NEUTRAL	GROUND	CONTROL
400	3/4"	1-12	1-12	1-12	-
401	1-1/2"	2-4	1-4	1-8	-
* 402	3/4"	-	-	-	-
403	3/4"	2-12	1-12	1-12	-
404	2"	1-1	1-1	1-6	-
405	2"	3-1	1-1	1-6	-
406	1-1/4"	3-4	1-4	1-8	-
407	3/4"	1-12	1-12	1-12	-
408	3/4"	3-12	-	1-12	-
409	2"	{ 2-3/0, 1-1/0	1-6	1-2	-
* 410	2"	-	-	-	-
* 411	1 1/2"	-	-	-	-
* 412	1 1/2"	-	-	-	-
* EMPTY CONDUIT. WIRES TO BE PROVIDED BY PT & T CO.					


CONDUIT AND WIRE SCHEDULE					
COND. NO.	COND. SIZE	NO. - SIZE WIRE			
		POWER	NEUTRAL	GROUND	CONTROL
250	1 1/2"	7-12	1-12	3-12	14-14
251	2 1/2"	15-12	1	5-12, 3-14	45-14
252	3"	24-12	3-12	10-12, 3-14	59-14
253	1 1/2"	6-12		2-12, 3-14	17-14
254	2"	12-12		4-12, 1-14	33-14
255	2 1/2"	30-12	3-12	15-12	
256	3"			4-14	97-14
257	1"	3-12	3-12	3-12	1-1
258	1"	6-12		2-12	4-14
259	1 1/2"			2-14	24-14
260	2"	15-12		5-12, 1-14	32-14
261	2"	15-12		5-12, 1-14	32-14
262	1 1/2"				
263	1 1/2"			1-14	24-14

CONDUIT AND WIRE SCHEDULE					
COND. NO.	COND. SIZE	NO. - SIZE WIRES			
		POWER	NEUTRAL	GROUND	CONTROL
313	3/4"	—	—	—	3-TSP
314	1"	—	—	—	4-TSP
316	1"	—	—	—	6-TSP
319	1 1/2"	—	—	—	9-TSP
321	2"	—	—	—	14-TSP
322	2"	—	—	—	18-TSP
323	3/4"	—	—	—	—
324	2"	—	—	—	17-TSP
325	1 1/4"	—	—	—	10-TSP
326	1 1/2"	—	—	—	12-TSP

CHLORINE & SULFUR STORAGE & SAFETY EQUIPMENT BLDGS. PLAN
SCALE: 1/4" = 1'-0"

Record Drawing
These record drawings have been prepared, in part, on the basis of information compiled and furnished by others. Kennedy/Jenks/Chilton is not responsible for any errors or omissions in this document as a result of information provided by others.
Date: 11/29/81

RECORD DRAWING

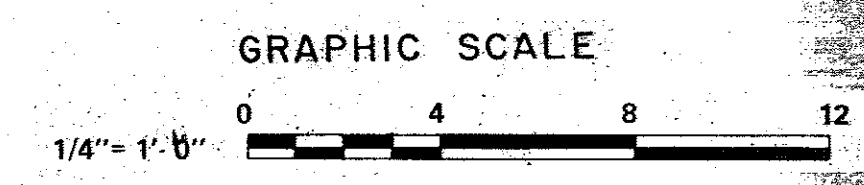

Revised	Description	Submit	App'd	Date
1	CO NO. 59			
2	CO NO. 60			
3	CO NO. 16			
4	CLARIFICATION			
5	FIELD CHANGE			
6	CO NO. 7			


Reference Information and Notes:
1. TO BE ABANDONED IN PLACE.
2. TO BE REMOVED AND DELIVERED TO OWNER.
3. CONNECT TO LIGHT CKT. & MS-1.
4. TO CONTROL BUILDING PANELBOARD "A", CONNECT TO &A-22
5. BLDG. IS CORROSIVE ATMOSPHERE. PROVIDE CONDUIT SEAL FOR EVERY CONDUIT THAT LEAVES THE BLDG.

Designed AA	Wastewater Plant Improvements Sausalito - Marin City Sanitary District	C-06-2464
Drawn W/L/LS	Kennedy/Jenks Engineers	San Francisco
Checked JWS	Submitted: Walter J. Kennedy	Approved: Robert J. Kennedy
Date 11/29/81	D9370	

LIGHTING & POWER PLAN

CONDUIT AND WIRE SCHEDULE					
COND. NO.	COND. SIZE	NO-SIZE	CONDUCTORS		
			POWER	NEUTRAL	GROUND
100	4"	-	-	-	CONTROL
101	4"	-	-	-	-
102	3"	3-250	-	1-1/0	-
103	1"	3-6	-	1-6	-
104	3"	2-4/0, 1-2	-	1-6	-
105	3"	3-350	-	1-1/0	-
106	1-1/2"	3-2	-	1-6	2-14
107	1-1/2"	3-2	-	1-6	2-14
108	1-1/2"	3-2	-	1-6	2-14
109	1-1/2"	3-2	-	1-6	2-14
110	3/4"	3-6	-	1-6	-
111	3/4"	3-12	-	1-12	-
112	3/4"	3-250	-	1-1/0	-
113	3/4"	3-250	-	1-1/0	-
114	1"	3-12	-	1-12	2-14
115	2"	-	-	-	-
116	3"	-	-	-	-
117	-	-	-	-	-
118	-	-	-	-	-
119	3/4"	3-12	-	1-12	2-14
120	3/4"	3-12	-	1-12	2-14
121	1"	3-12	-	1-12	2-14
122	3/4"	3-12	-	1-12	2-14
123	3/4"	3-12	-	1-12	2-14
124	1"	3-12	-	1-12	2-14
125	1"	3-12	-	1-12	2-14
126	1"	3-12	-	1-12	2-14
127	1"	3-12	-	1-12	2-14
128	1"	3-12	-	1-12	2-14
129	1"	3-12	-	1-12	2-14
130	1"	3-12	-	1-12	2-14
131	1"	3-12	-	1-12	2-14
132	1"	3-12	-	1-12	2-14
133	1"	3-12	-	1-12	2-14
134	3/4"	3-12	-	1-12	2-14
135	3/4"	3-12	-	1-12	2-14
136	3/4"	3-12	-	1-12	2-14
137	3/4"	3-12	-	1-12	2-14
138	3/4"	3-12	-	1-12	2-14
139	3/4"	3-12	-	1-12	2-14
140	3/4"	3-12	-	1-12	2-14
141	3/4"	3-12	-	1-12	2-14
142	3/4"	3-12	-	1-12	2-14
143	1"	3-6	-	1-6	-
144	1"	3-6	-	1-6	-
145	3/4"	3-12	-	1-12	2-14
146	3/4"	3-12	-	1-12	2-14
147	3/4"	3-12	-	1-12	2-14


* EMPTY CONDUIT WIRES TO BE PROVIDED BY PG&E CO.

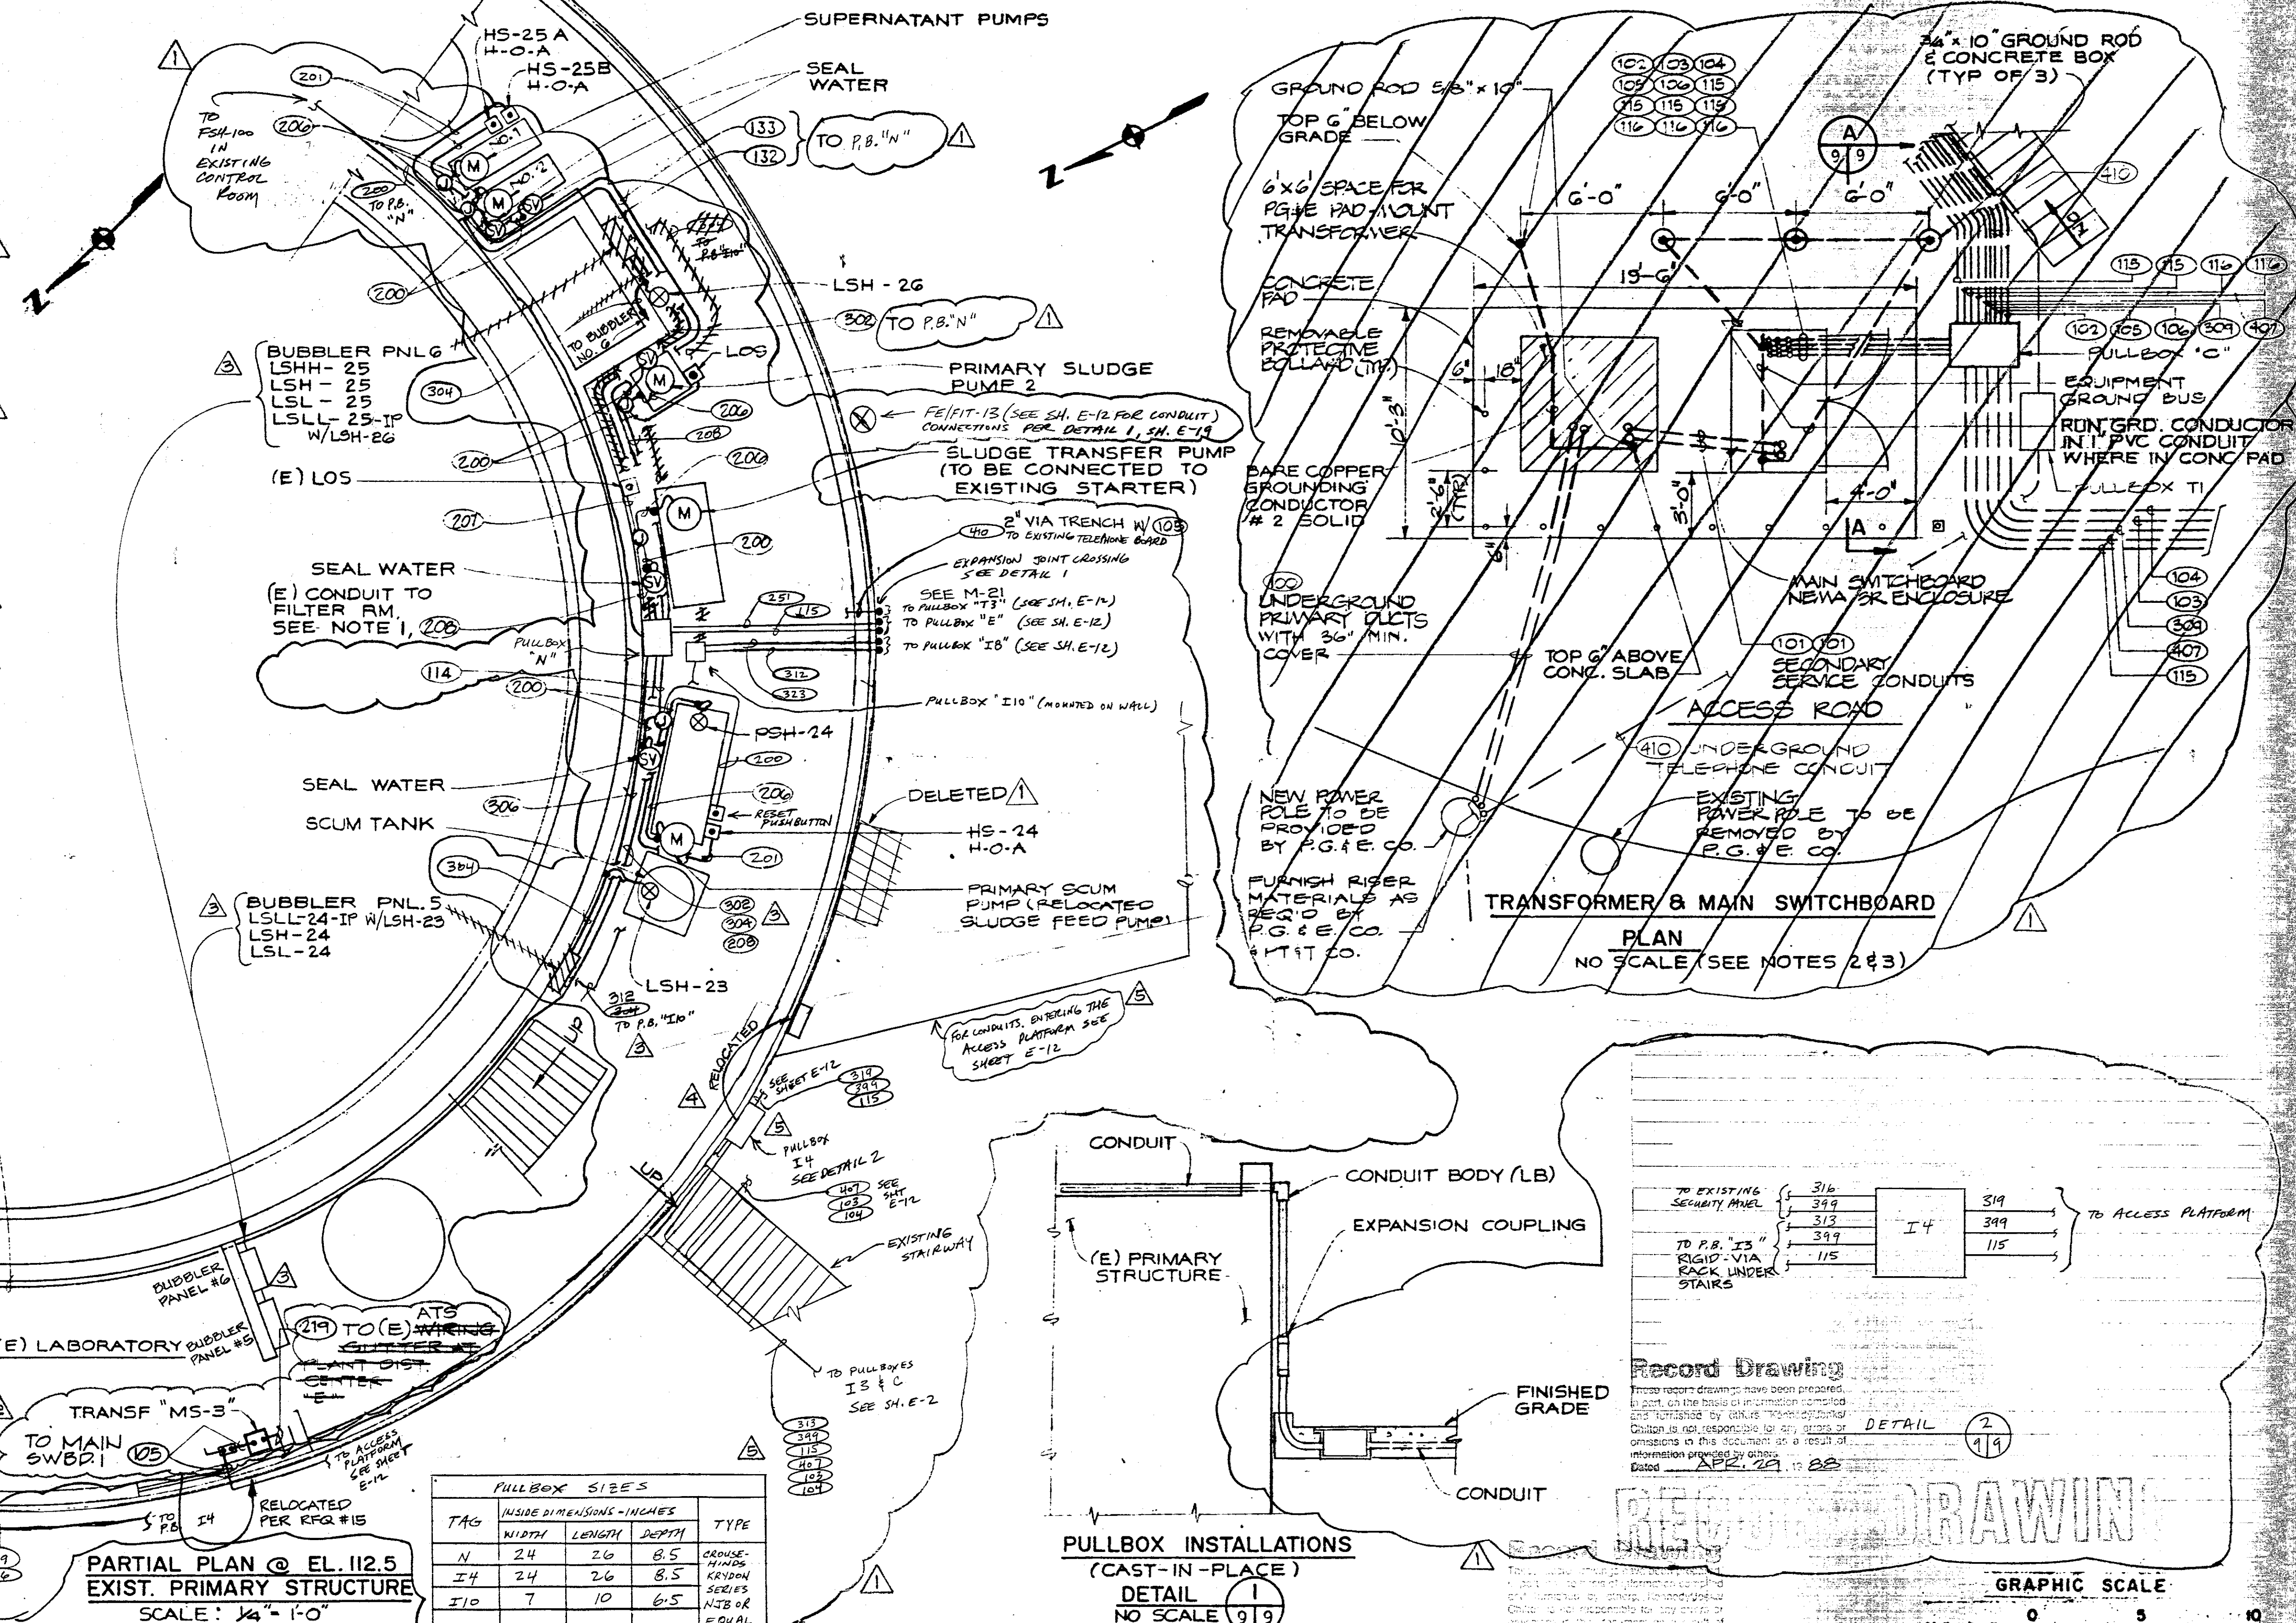

PARTIAL PLAN @ EL. 112.5
EXIST. PRIMARY STRUCTURE
SCALE: 1/4" = 1'-0"

PULLBOX SIZES				
TAG	INSIDE DIMENSIONS - INCHES			
	WIDTH	LENGTH	DEPTH	TYPE
N	24	26	8.5	CRUSH-RESISTANT
I-4	24	26	8.5	KRYDOL SERIES
I-10	7	10	6.5	NETS OR EQUAL

PULLBOX INSTALLATIONS
(CAST-IN-PLACE)
DETAIL 1
NO SCALE

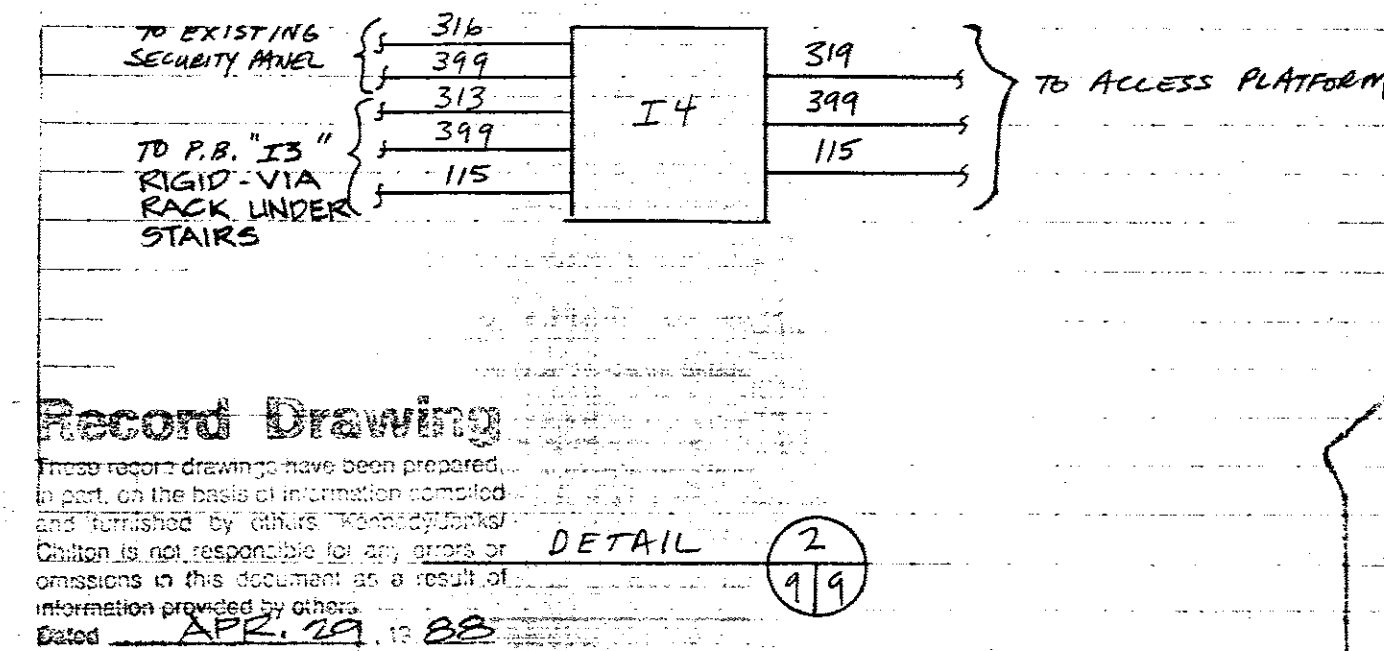


Record Drawing
GRAPHIC SCALE
1/4" = 1'-0"

Revised	Description	Submit	App'd	Date
1	CO NO. 59 FIELD CHANGE			
2	CO NO. 45			
3	CO NO. 15			
4	CO NO. 16			

Reference Information and Notes:
1. PROVIDE NEW WIRES IN THE EXISTING CONDUIT TO THE EXISTING STARTER IN THE VACUUM FILTER CONTROL PANEL.
2. THERE IS A ROCK NEAR GROUND SURFACE. DRILLING MAYBE NECESSARY TO INSTALL GROUND RODS.
3. FOR GROUND CONDUCTOR SIZES SEE GROUNDING SYSTEM SCHEMATIC SH. E-2.


Designed RDS/AA	Wastewater Plant Improvements Sausalito - Marin City Sanitary District	C-06-2464
Drawn AYS/LCS	KennedyJenks Engineers	San Francisco
Checked JWS	Submitted: Walter Schuman	Approved: Robert J. [Signature]
Date 1/29/81	9370	

Scale 1/4" = 1'-0"	Job No. 0112	Sheet E-9
POWER PLANS I		

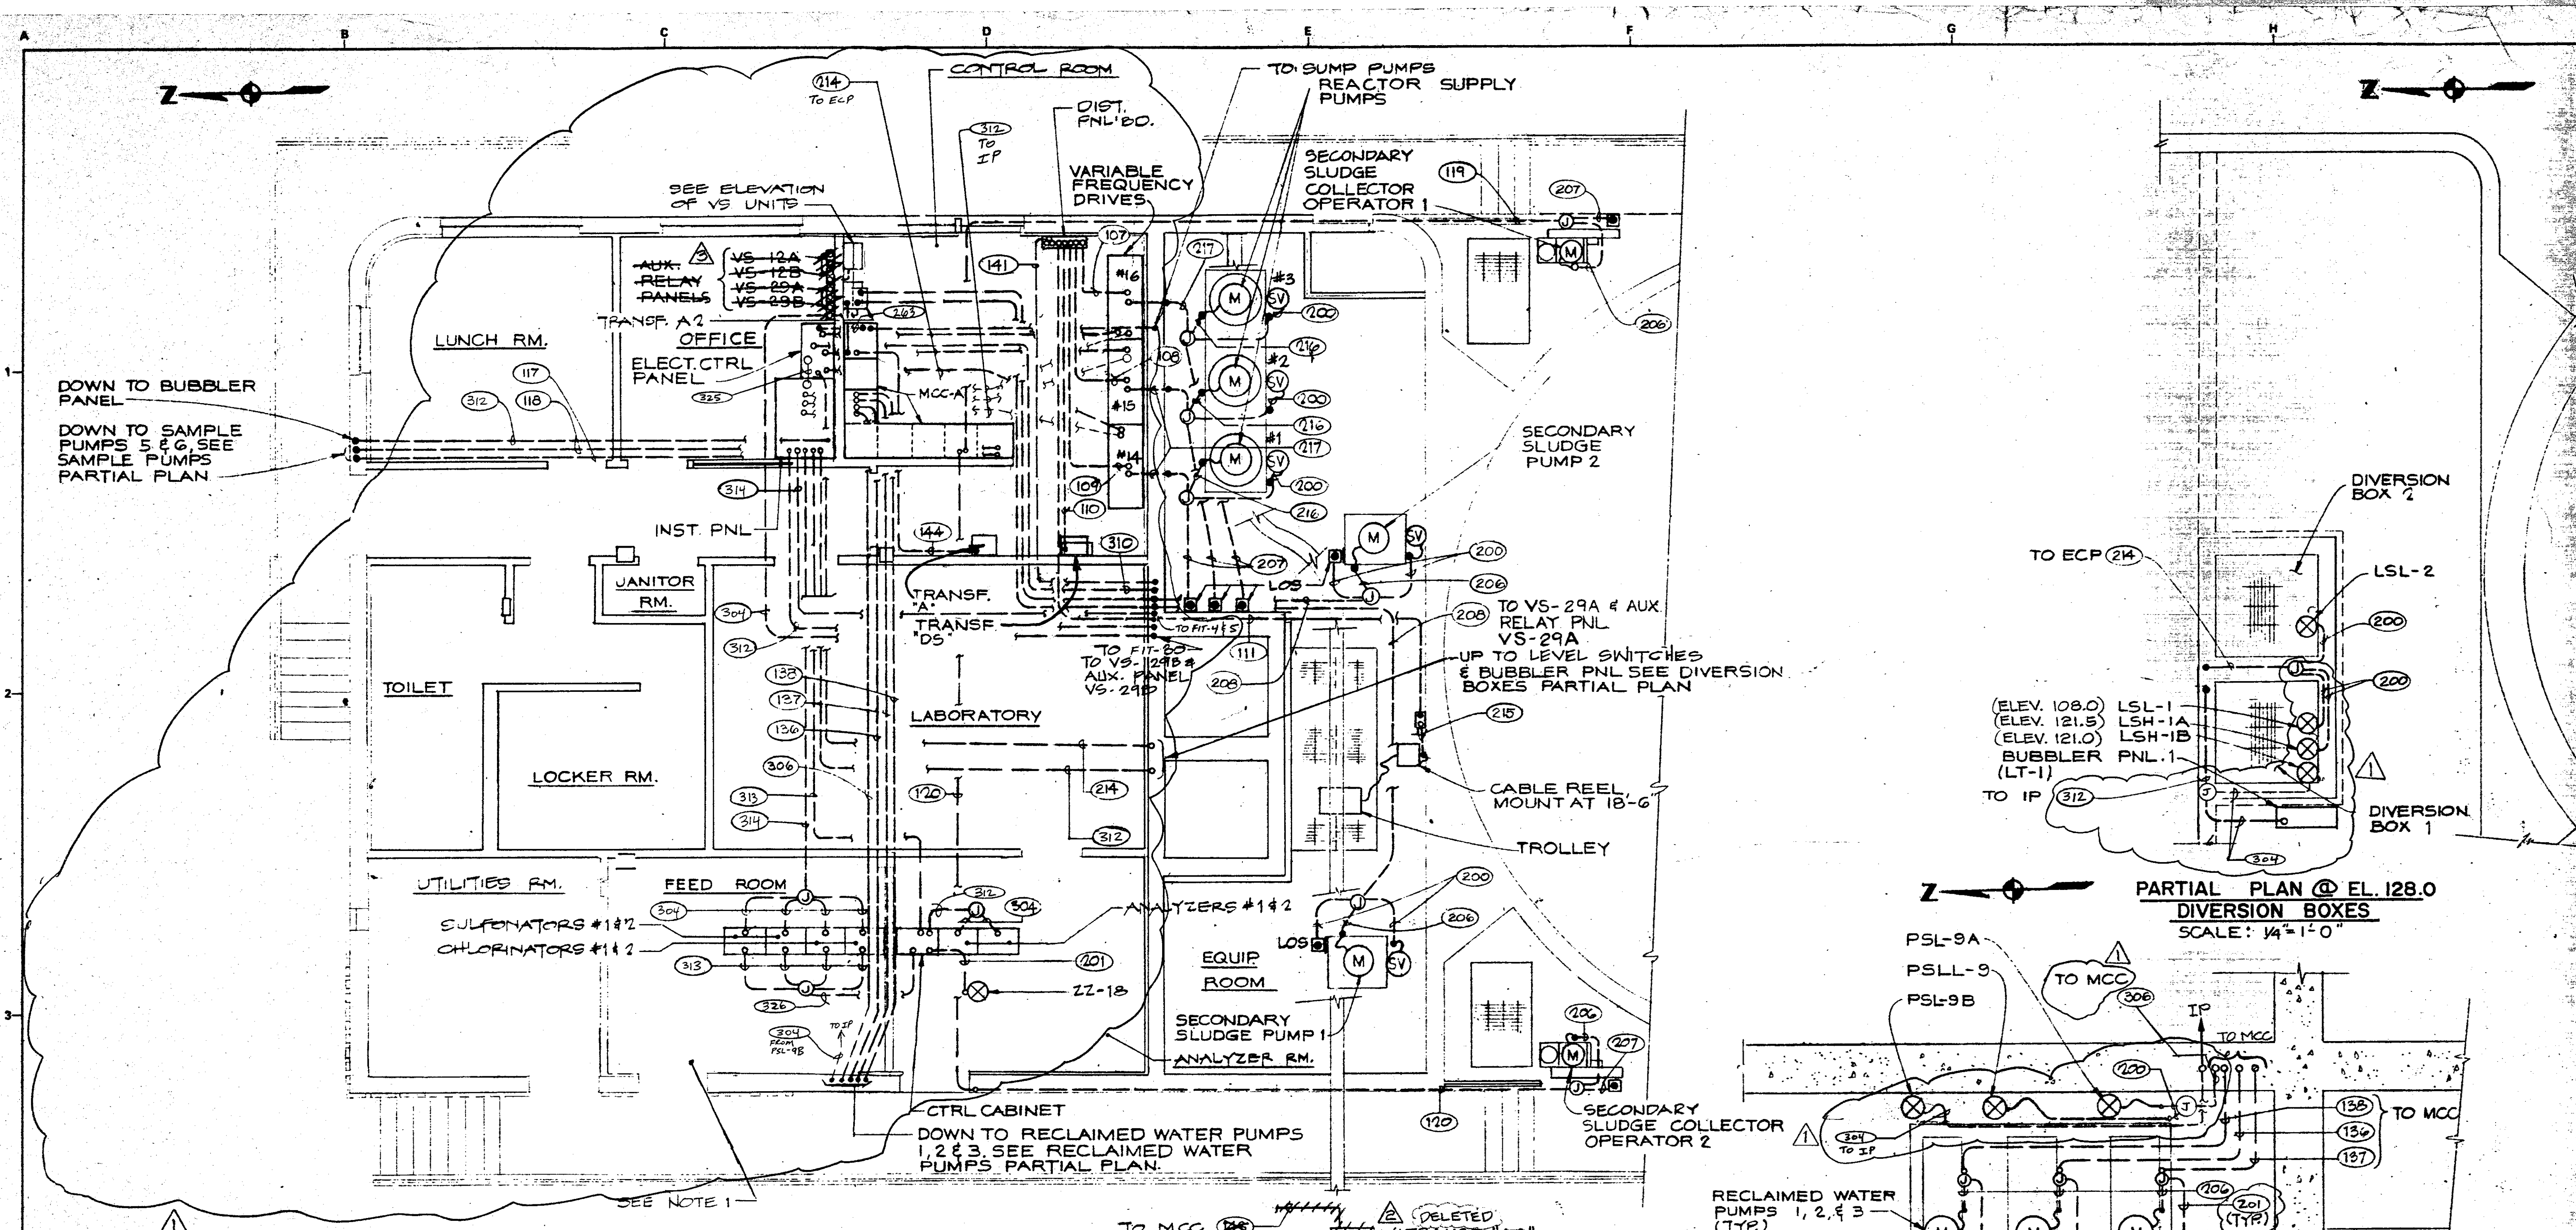


**CONTROL BUILDING
PLAN @ EL. 115.0 & 104.0
SCALE: 1/4" = 1'-0"**

**PARTIAL PLAN @ EL. 128.0
DIVERSION BOXES
SCALE: 1/4" = 1'-0"**

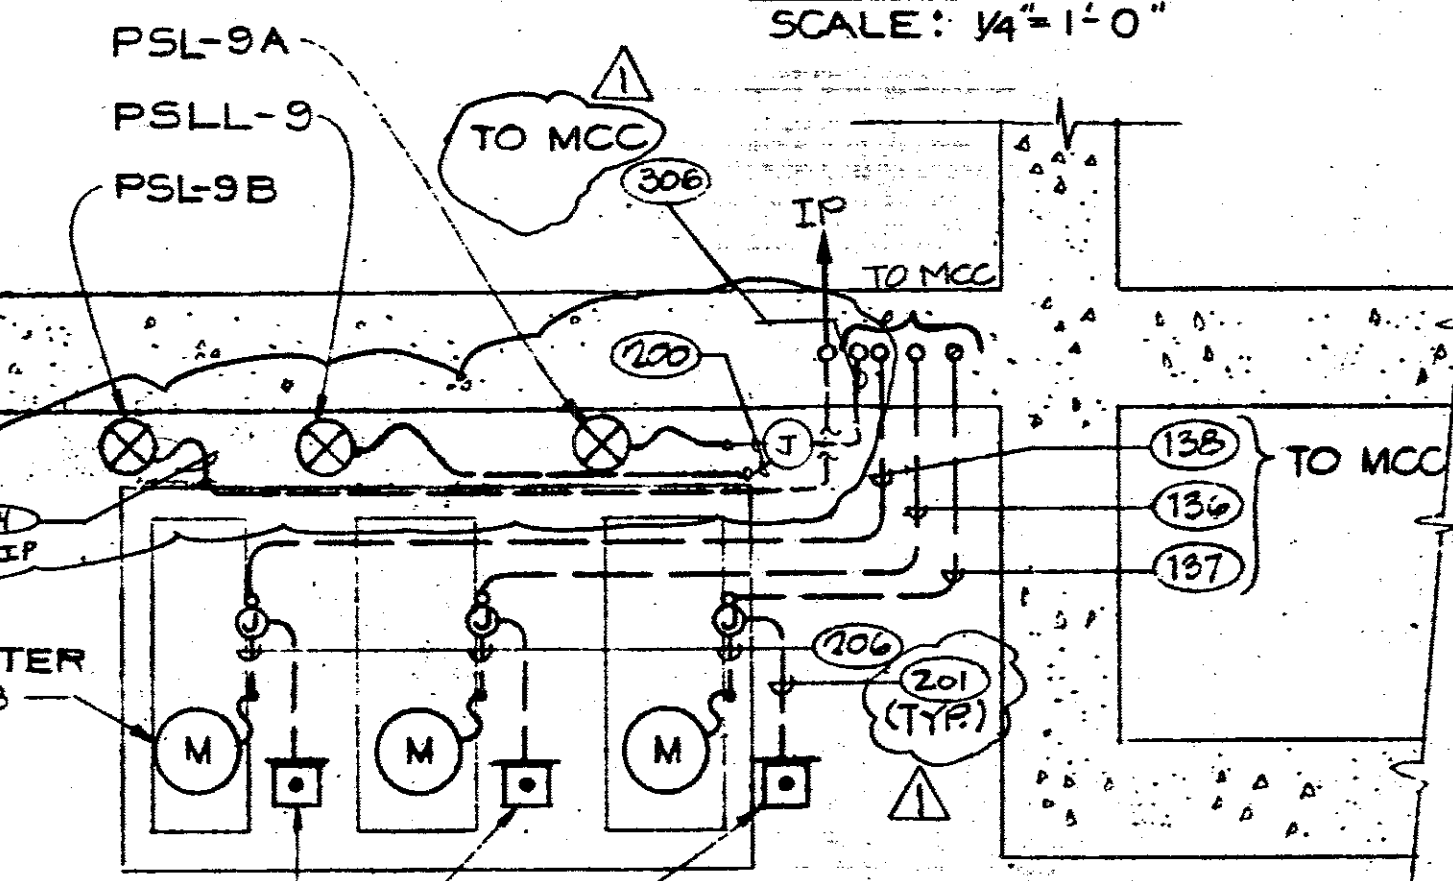


**PARTIAL PLAN @ EL. 110.0
RECLAIMED WATER PUMPS
SCALE: 1/2" = 1'-0"**

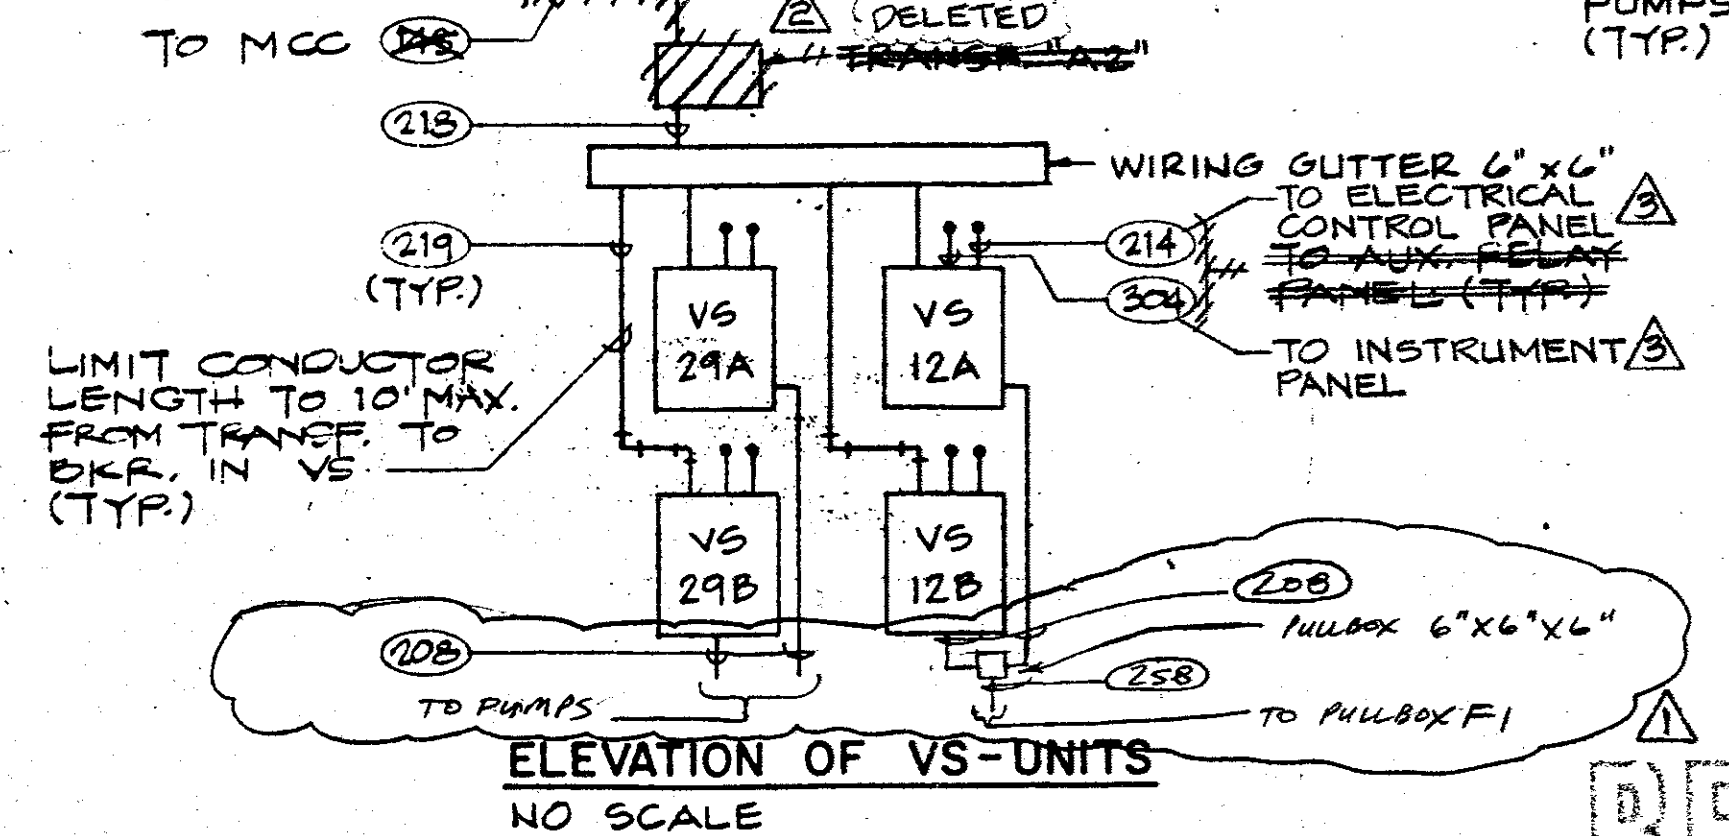

Record Drawing
These record drawings have been prepared in accordance with the information supplied and furnished by others. Kennedy/Jenks/Gilston is not responsible for any errors or omissions in this document as a result of information provided by others.
Dated: APR. 29, 1988

Record Drawing
These record drawings have been prepared in accordance with the information supplied and furnished by others. Kennedy/Jenks/Gilston is not responsible for any errors or omissions in this document as a result of information provided by others.
Dated: APR. 29, 1988

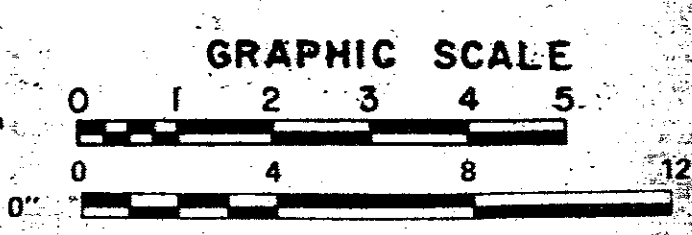


RECORD DRAWING

FIELD CHANGE				
CO NO. 25				
CO NO. 10				
Revised	Description	Submit	App'd	Date

Reference Information and Notes:
1. RM. IS CORROSIVE ATMOSPHERE. PROVIDE CONDUIT SPAN CONDUIT THAT LEAVES THE BLDG.

Designed RDS/AA	Wastewater Plant Improvements Sausalito - Marin City Sanitary District	C-06-2484
Drawn AYS/LCS	Kennedy/Jenks Engineers	San Francisco
Checked	Submitted: Walter J. Chasman	Approved: [Signature]
Date 1/29/81	C5370	

POWER PLANS 2		Scale AS NOTED
		Job No. 0112
		Sheet E-10

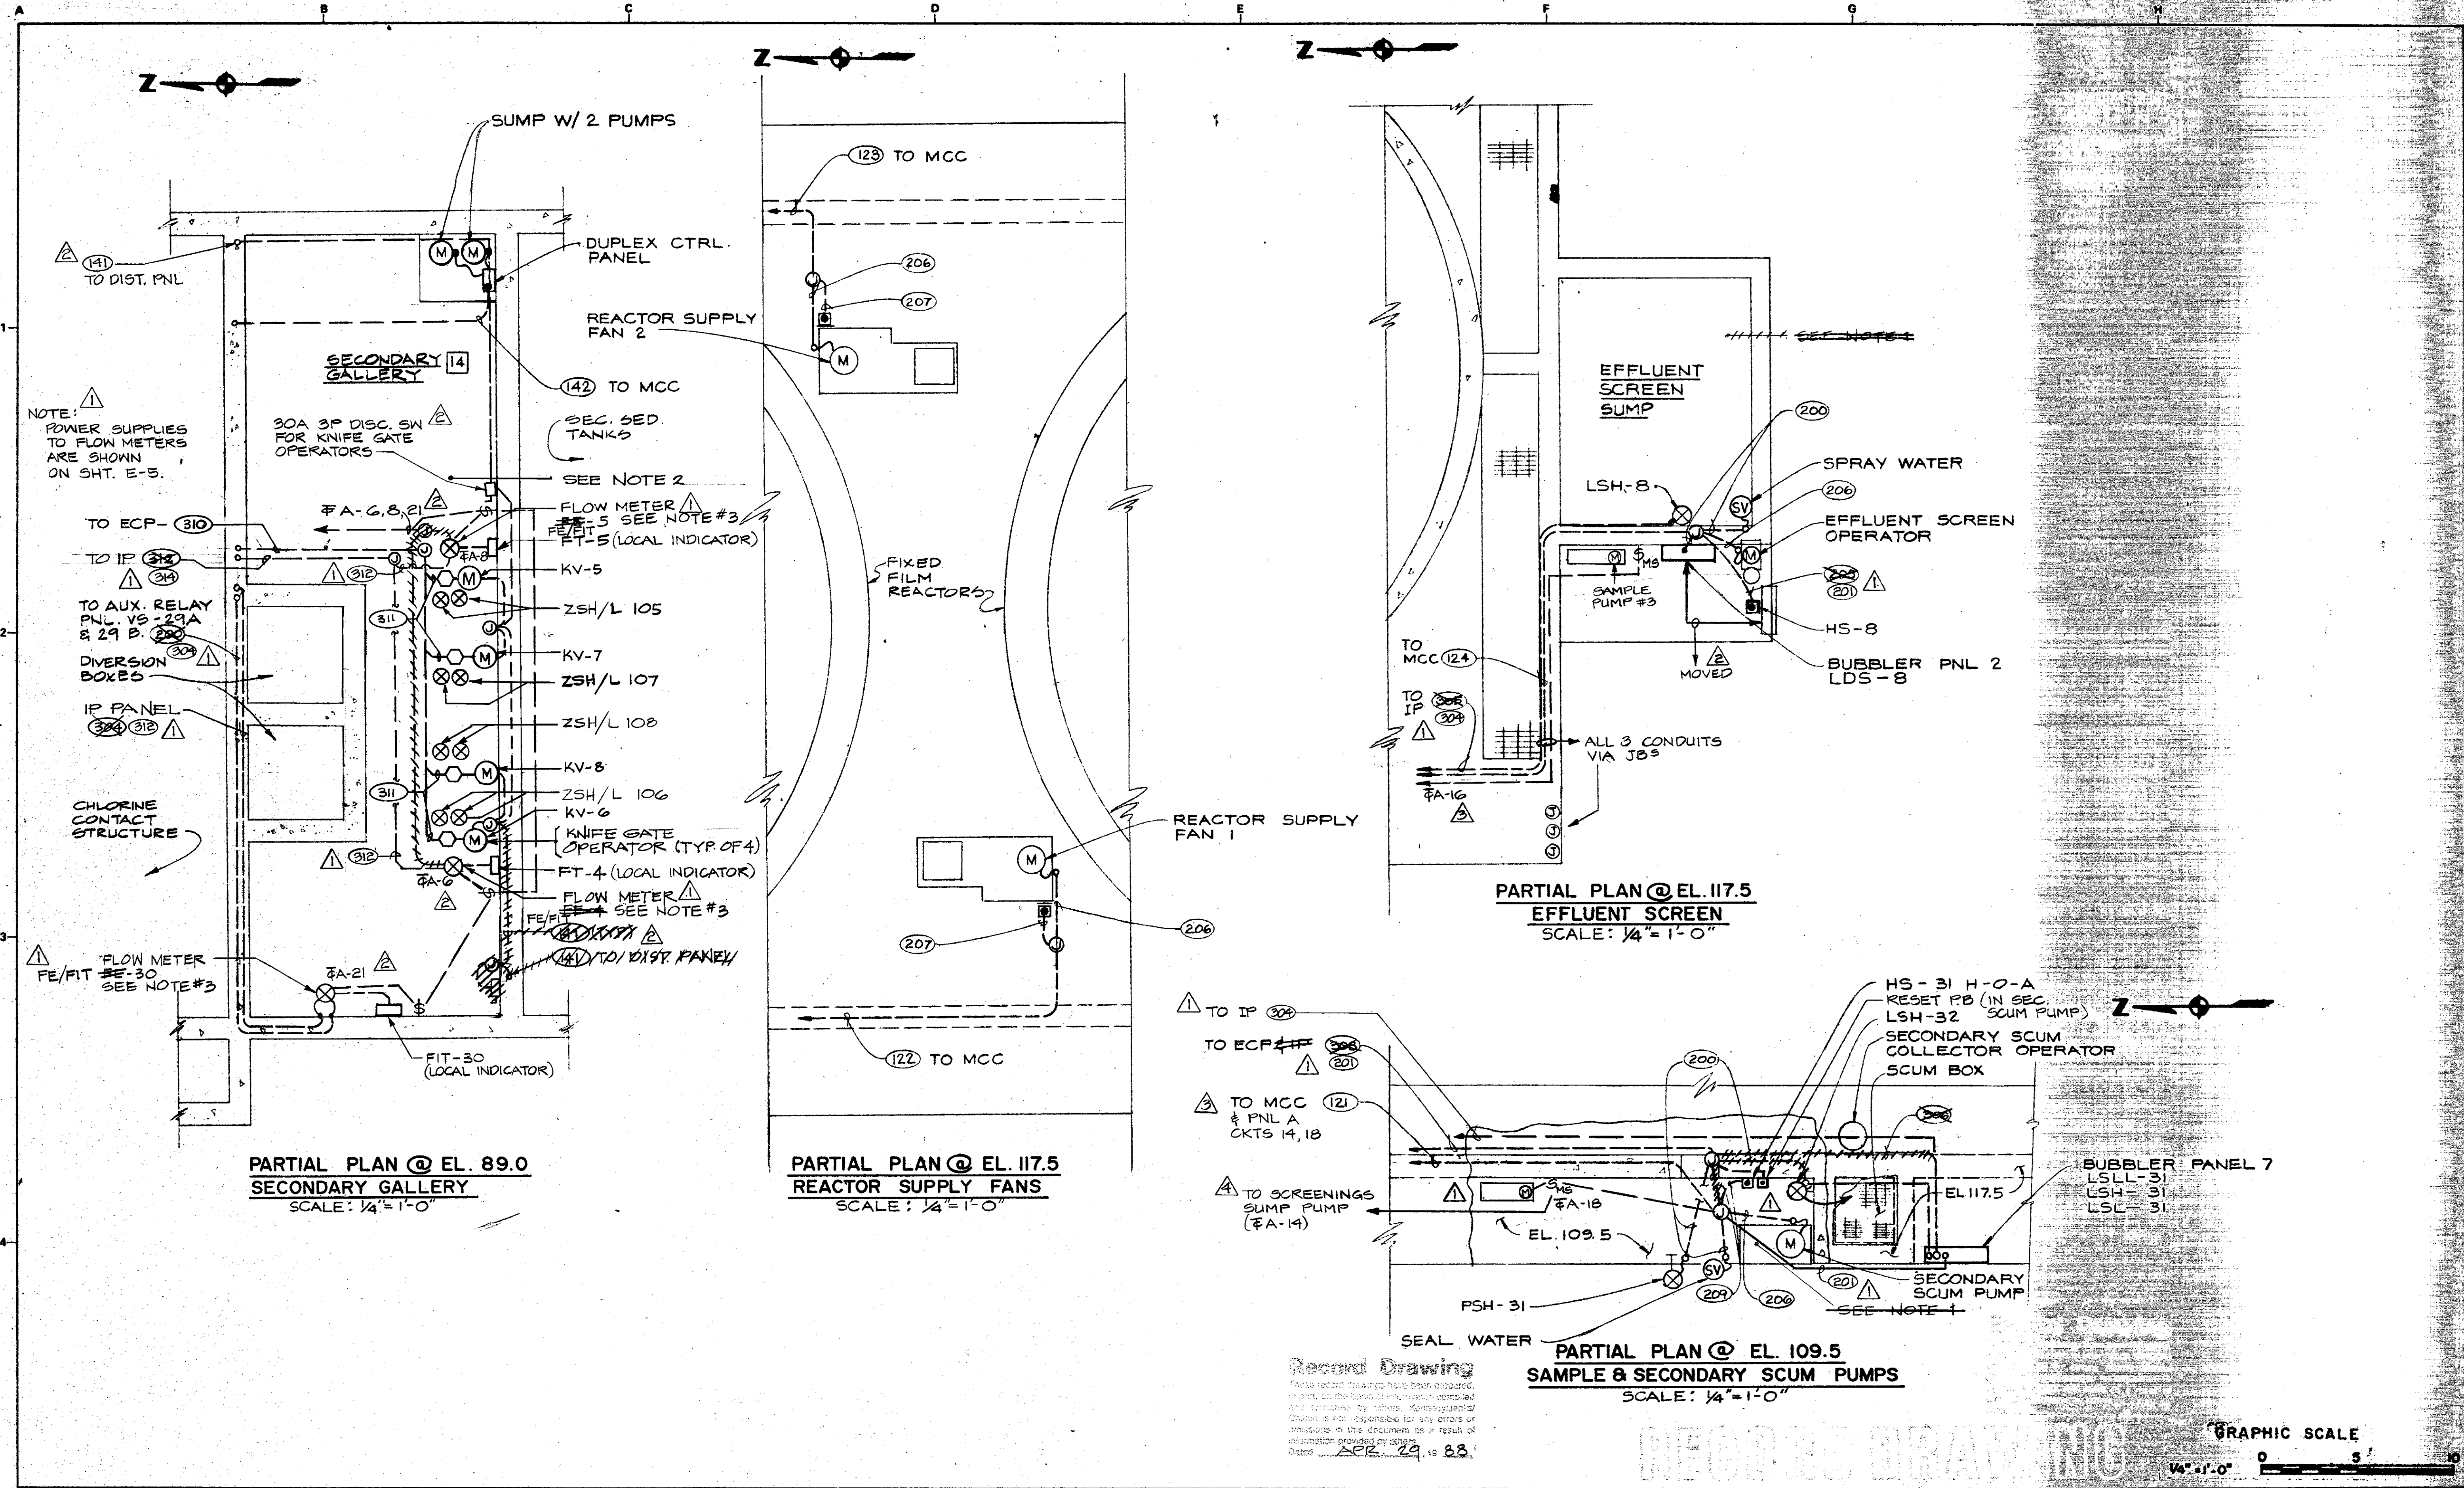


CO NO. 24	
CO NO. 57	
FIELD CHANGE	
CO NO. 16	
Revised	Description
Refer to Tracing for Latest Revision	

Reference Information and Notes:

- HAZARDOUS LOCATION, CLASS I, DIV. I, GROUPS C&D. PROVIDE CONDUIT SEAL FOR EVERY CONDUIT THAT LEAVES THE BLDG.
- AREA IS DAMP LOCATION.
- FOR FLOW METER DETAIL SEE SHT. E-19.

Designed RDS/AA	Wastewater Plant Improvements Sausalito - Marin City Sanitary District	C-06-2484
Drawn AYS/LCS	Kennedy/Jenks Engineers	San Francisco
Checked JWS	Submitted: <i>William J. Herman</i>	Approved: <i>Robert J. Veruca</i>
Date 1/29/81	C9370	

POWER PLANS 3	Scale 1/4" = 1'-0"
Job No. 0112	Sheet E-11

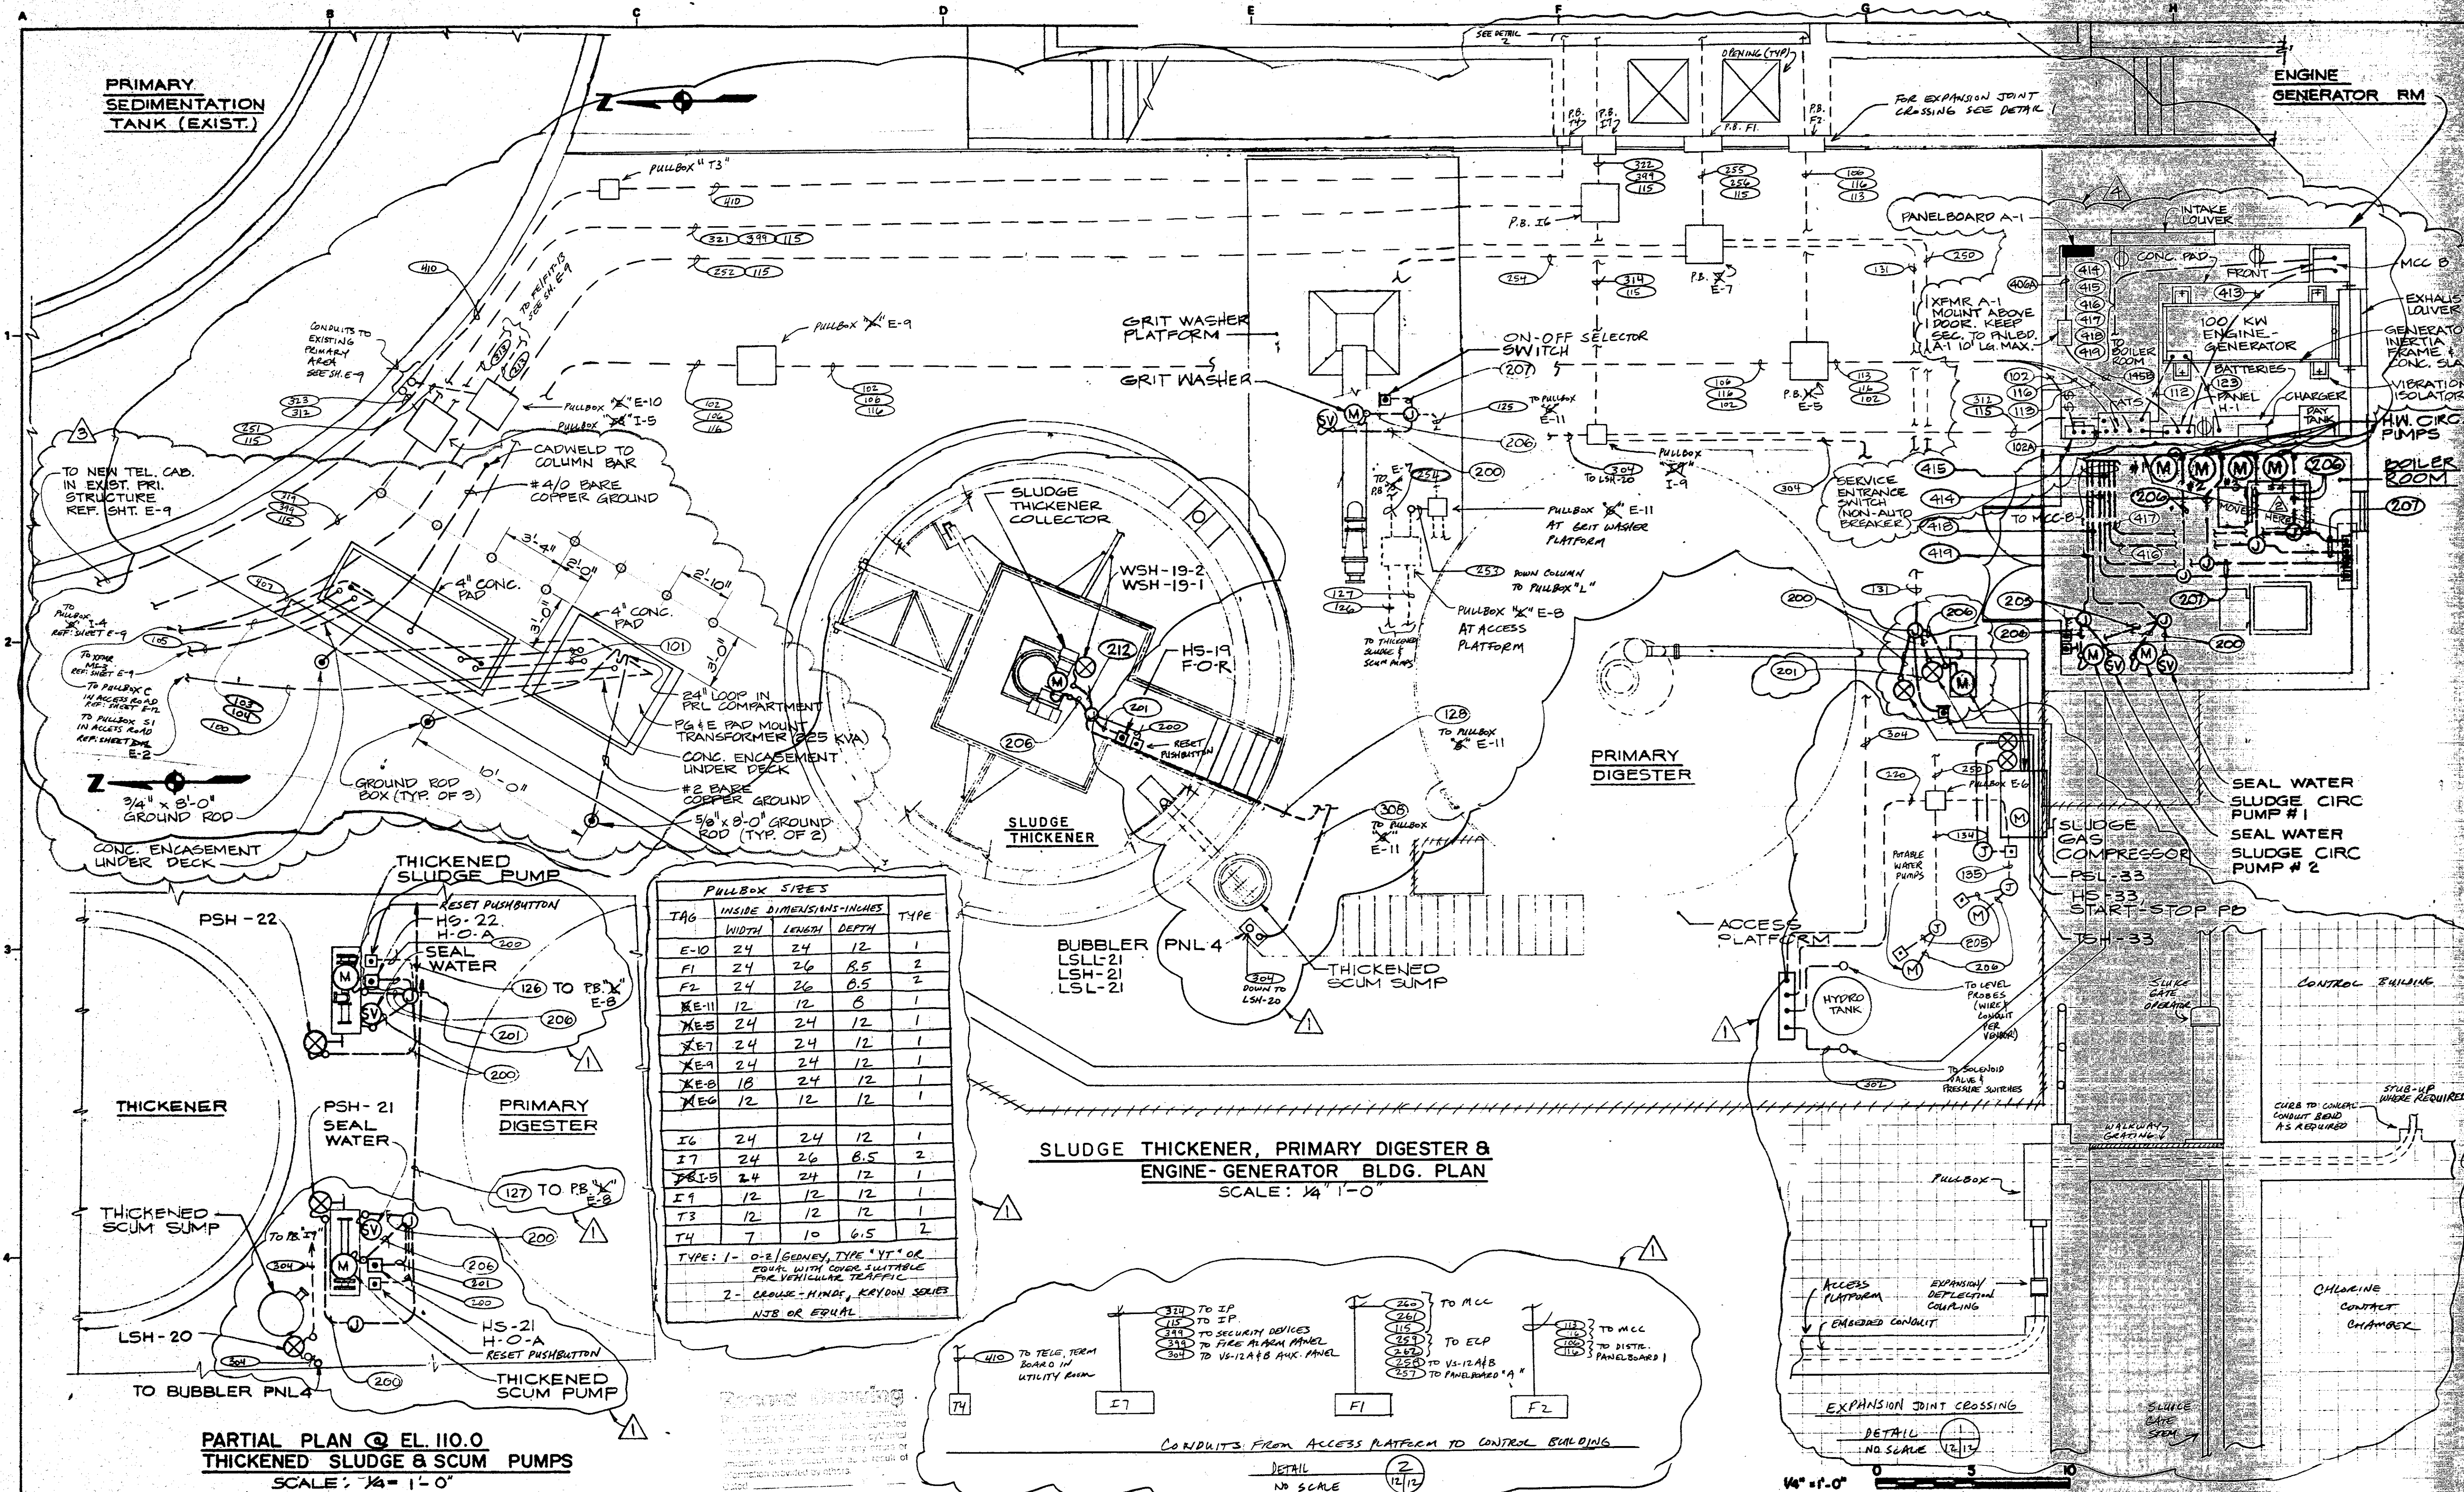

	CO NO. 12			
	CO NO. 59			
	FIELD CHANGE			
	CO NO. 16			
Revised	Description	Submit	App'd	Date
Refer to Tracing for Latest Revision				

Record Information and Notes:

Record Drawing

These record drawings have been prepared in accordance with the information provided by the client and the design engineer. The design engineer is responsible for the accuracy of the information provided and the design of the project. The client is responsible for the accuracy of the information provided and the design of the project.

Dated: APR 29 19 88

RECORD DRAWING

Designed RDS/AA	Wastewater Plant Improvements C-06-2484	
Drawn LCS	Sausalito - Marin City Sanitary District	
Checked	Kennedy/Jenks Engineers	San Francisco
Date 1/29/01	Submitted: <i>William J. Jensen</i> C9370	Approved: <i>[Signature]</i>

FIXTURE SCHEDULE							
FIXTURE TYPE	LAMP			1Ø VOLTS	MOUNTING	DESCRIPTION	CATALOG NO.
	NO.	TYPE	WATTS				
A	1	INCAND.	150	120	RECESS	OUTDOOR, SQ. DOWNLIGHT W/ A FLAT PRESNEL LENS & GALVANIZED STEEL HOUSING.	McPHILBEN 4-811BE
B	1	INCAND.	300	120	WALL	WEATHERPROOF W/ A PRISMATIC LENS, A VANDALPROOF SHIELD & A CORROSION RESISTANT FINISH.	DEVINE LIGHTING D415-A3
C	2	FLUOR.	35	120	RECESS	COMMERCIAL, NON-AIR HANDLING TROFFER W/ A PRISMATIC VIRGIN ACRYLIC LENS & BAKED WHITE ENAMEL FINISH.	DAY-BRITE 4G21-6X9-4
D	2	FLUOR.	35	120	WALL	COMMERCIAL W/ AN ACRYLIC DIFFUSER, ALUMINUM HOUSING & A CLEAR LACQUER FINISH.	COLUMBIA 5112G
E	1	FLUOR.	35	120	SURFACE	COMMERCIAL, WRAP-AROUND W/ A CLEAR ACRYLIC LENS & BAKED WHITE ENAMEL FINISH.	McPHILBEN 37-80A
F	1	FLUOR.	35	120	PENDANT	INDUSTRIAL, ENCLOSED & GASKETED, THERMOPLASTIC HOUSING & A HIGH-IMPACT ACRYLIC LENS.	MILLER FM-2121-04
G	1	INCAND.	200	120	WALL	INDUSTRIAL, ENCLOSED & GASKETED W/ GLASS GLOBE CAST ALUMINUM GUARD & MALLEABLE IRON HOUSING.	HOLOPHANE 6100-A
H	1	INCAND.	100	120	WALL	SAME AS TYPE G FIXTURE.	MILLER FM-1105-04
I	1	INCAND.	100	120	WALL	INDUSTRIAL, WATER-TIGHT W/ CLEAR GLASS GLOBE & FIBERGLASS HOUSING.	BENJAMIN PA-2414-4R
J	1	INCAND.	200	120	WALL	INDUSTRIAL, EXPLOSION-PROOF W/ CLEAR GLASS GLOBE & COPPER-FREE ALUMINUM GUARD.	MILLER KW-2101-04
K	1	PAR	250	120	SURFACE	INDUSTRIAL, WEATHERPROOF, SPOTLIGHT W/ BRACKET ARMS, ALUMINUM HOUSING & CORROSION RESISTANT FINISH.	APPLETON GSW-202-G
L	1	INCAND.	150	120	WALL	INDUSTRIAL, WEATHERPROOF W/ CLEAR GLASS GLOBE, DIE-CAST ALUMINUM HOUSING & GUARD.	APPLETON GSW-102-G
M	1	FLUOR.	35	120	SURFACE	INDUSTRIAL, OPEN-TYPE W/ A REFLECTOR & A BAKED WHITE ENAMEL FINISH.	CROUSE-HINDS NDA-22G
N	2	FLUOR.	35	120	PENDANT	SAME AS TYPE F FIXTURE.	APPLETON AC-1575
O	1	INCAND.	18	120	WALL	INDUSTRIAL, EMERGENCY LIGHT W/ A SEALED & GASKETED, NEMA 4X, ENCLOSURE.	STONCO LINE D4440
P	1	INCAND.	18	120	WALL	CORROSION RESISTANT, PAR-36, REMOTE EMERGENCY LIGHT HEAD.	McGILL 5300-7400
Q	1	INCAND.	150	120	WALL	WEATHERPROOF, BULLET-TYPE FLOODLIGHT W/ DIE-CAST ALUMINUM HOUSING & CORROSION RESISTANT FINISH.	HUBBELL AOWXF-11110
R	2	FLUOR.	35	120	SURFACE	SAME AS TYPE M FIXTURE.	COLUMBIA FS-140-W4

PANELBOARD SCHEDULE "A1"											
208/120 VOLTS, 3 PHASE, 4 WIRE				100 AMP BUS		90 AMP MAIN		CIRCUIT BREAKER		MOUNTING SURFACE	
CKT. NO.	DESCRIPTION	CONNECTED VOLT-AMPS			TRIP AMPS/POLES	CKT. NO.	DESCRIPTION	CONNECTED VOLT-AMPS			TRIP AMPS/POLES
		A	B	C				A	B	C	
1	OUTSIDE BLDG., BOILER & GENERATOR ROOM RECEPT.	1080			20/1	2	THICKENER & PRIMARY DIGESTER AREA RECEPT.	720			20/1
3	OUTSIDE BLDG., BOILER & GENERATOR ROOM LIGHTS		620		20/1	4	BATTERY CHARGER & JACKET HEATER DAY TANK	600			15/1
5	THICKENER & PRIMARY DIGESTER AREA LIGHTS			1200	20/1	6	SPARE				15/1
7	BOILER	828			15/1	8	SPARE JACKET HEATER				15/1
9	BOILER		828		15/1	10	DAY TANK PUMP				15/1
11	SPARE			-	20/1	12	SPARE				20/1
13	SPARE				15/1	14	SPARE				15/1
15	SPACE			-	15/1	16	SPACE				15/1
17	SPACE			-	15/1	18	SPACE				15/1
SUBTOTALS		1908	1448	1200				720	600		
PHASE TOTALS		Ø A = 2628 Ø B = 2876 Ø C = 1200									
TOTAL VOLT-AMPS		6,704									

PANELBOARD SCHEDULE "MS-1"											
208/120 VOLTS, 3 PHASE, 4 WIRE			225 AMP BUS			150 AMP MAIN CIRCUIT BREAKER			MOUNTING: SURFACE		
CKT. NO.	DESCRIPTION	CONNECTED VOLT-AMPS			TRIP AMPS/ POLES	CKT. NO.	DESCRIPTION	CONNECTED VOLT-AMPS			TRIP AMPS/ POLES
		A	B	C				A	B	C	
1	SULFUR STO. BLDG. LIGHTS	730			20/1	2	SAFETY EQUIP. BLDG. LIGHTS RECEPT. & EMERG. LIGHT	524			20/1
3	SULFUR STO. BLDG. RECEPT.		720		20/1	4	CHLORINE STO. BLDG. & SAFETY EQUIP. BLDG. OUTSIDE LIGHTS		1050		20/1
5	SULFUR DIOXIDE REGULATOR HEATERS			100	15/1	6	CHLORINE STO. BLDG. LIGHTS			1040	20/1
7	SULFUR STO. BLDG. UNIT HTR. 2	138			15/1	8	CHLORINE STO. BLDG. RECEPT.	1080			20/1
9	SULFUR STO. BLDG. EXH. FAN		236		15/1	10	CHLORINE REGULATOR HEATERS		200		15/1
11	SULFUR STO. BLDG. EMERG. EXH. FAN			1127	25/1	12	CHLORINE STO. BLDG. UNIT HTR. 1			138	15/1
13	CHLORINE STO. BLDG. EXH. FAN 3	480				14	HOIST & TROLLEY	1164			
15	CHLORINE STO. BLDG. EXH. FAN 3		480		15/3	16	HOIST & TROLLEY		1164		20/3
17	CHLORINE STO. BLDG. EXH. FAN 3			480		18	HOIST & TROLLEY			1164	
19	CHLORINE STO. BLDG. EXH. FAN 4	480				20	SPARE	-			15/1
21	CHLORINE STO. BLDG. EXH. FAN 4		480		15/3	22	SPARE		-		15/1
23	CHLORINE STO. BLDG. EXH. FAN 4			480		24	SPARE			-	15/1
25	SPARE				15/1	26	SPARE	-			20/1
27	SPARE		-		15/1	28	SPARE		-		20/1
29	SPARE			-	15/1	30	SPARE			-	20/1
SUBTOTALS		1828	1916	2187				2768	2414	2342	
PHASE TOTALS		Ø A = 4596 Ø B = 4330 Ø C = 4529									
TOTAL VOLT-AMPS		13455									

PANELBOARD SCHEDULE "A"											
208/120 VOLTS, 3 PHASE, 4 WIRE				400 AMP BUS		300 AMP MAIN CIRCUIT BREAKER		MOUNTING SURFACE			
CKT. NO.	DESCRIPTION	CONNECTED VOLT-AMPS			TRIP AMPS/POLES	CKT. NO.	DESCRIPTION	CONNECTED VOLT-AMPS			TRIP AMPS/POLES
		A	B	C				A	B	C	
1	LUNCH & CONTROL RM., OFFICE & CORRIDOR LIGHTS	880			20/1	2	ELECTRICAL CONTROL PANEL	500			15/1
3	LUNCH RM. & OFFICE RECEPT.		1080		20/1	4	INSTRUMENT PANEL		500		15/1
5	JANITOR & LOCKER RM., TOILET & CORRIDOR LIGHTS			320	20/1	6	FLOW METER FE-4 FIT 4 			550	15/1
7	LABORATORY LIGHTS	640			20/1	8	FLOW METER FE-5 FIT 5	550			15/1
9	LABORATORY RECEPT.		900		20/1	10	CONTROL RM., JANITOR RM. & TOILET RECEPT.		900		20/1
11	LABORATORY RECEPT.			720	20/1	12	FLOW METERS FE-13 & FE-30			350	15/1
13	UTILITIES FEED & ANALYZER RM. LIGHTS	400			20/1	14	SPACE SCREENINGS SUMP PUMP				1P
15	UTILITIES FEED & ANALYZER RM. RECEPT.		1440		20/1	16	SPACE SAMPLE PUMP 3				1P
17	SULFONATORS #1 & #2, CHLORINATOR #1 & #2			460	15/1	18	SPACE SAMPLE PUMP 4				1P
19	SAMPLER #1 ANAL. RM. RECEPT.	1150			15/1	20	SPACE				1P
21	SAMPLER #2 FLOW METER FE/FIT 30		180		15/1	22	SECURITY ALARM PNL*		320		15/1
23	SAMPLER #3 ANAL. RM. RECEPT.			1150	15/1	24	ANALYZER #1 & #2 CONTROL PNL			730	15/1
25	SPARE	-			20/1	26	PIPE GALLERY AND EQUIPMENT RM. LIGHTS 	700			20/1
27	OUTDOOR LIGHTS - NO. & WEST WALL	750			20/1	28	EQUIPMENT RM. RECEPT.		540		20/1
29	OUTDOOR LIGHTS - NORTH & EAST WALL			1200	20/1	30	PIPE GALLERY LIGHTS			600	20/1
31	OUTDOOR LIGHTS - P.F.R. AREA	1740			20/1	32	SPACE SAMPLE PUMP 5				1P
33	EAST VIEW PORT & F.P.R. STAIR LIGHTS	1840			20/1	34	SPACE SAMPLE PUMP 6				1P
35	WEST VIEW PORT & WALKWAY AREA LIGHTS		880		20/1	36	HYDRO TANK CONTROL			100	15/1
37	AUX. RELAY PNL. VS 12X SPARE	500			15/1	38	CHLORINE CONTACT TANK LIGHTS	600			20/1
39	AUX. RELAY PNL. VS 12X SPARE		500		15/L	40	AUX. RELAY PNL. VS 20X SPARE		500		15/1
41	SPARE				20/1	42	AUX. RELAY PNL. VS 20X SPARE		500		15/1
SUBTOTALS		5310	7660 6640	4730				2350	2760	2940 2660	
PHASE TOTALS		Ø A = 7660 Ø B = 10,420 Ø C = 7570									
TOTAL VOLT-AMPS		25650									

CO NO. 58				
CO NO. 50				
FIELD CHANGE				
CO NO. 24				
CO NO. 57				
CLARIFICATION				
Revised	Description	Submit.	App'd.	Date
	Refer to Tracing for Latest Revision			

Reference Information and Notes:

Record Drawing

These record drawings have been prepared, in part, on the basis of information compiled and furnished by others. Kennedy/Jenks/Chilton is not responsible for any errors or omissions in this document as a result of information provided by others.

Record Drawing


These record drawings have been prepared, in part, on the basis of information compiled and furnished by others. Kennedy/Jenks/Chilton is not responsible for any errors or omissions in this document as a result of information provided by others.

Designed	AA
Drawn	LCS
Checked	JWS
Date	1/29/81

Wastewater Plant Improvements		C-06-2484
Sausalito - Marin City Sanitary District		
Kennedy/Jenks Engineers		San Francisco
Submitted:	Walter J. Harman C9370	
Approved:	J. P. J. Owen	

SCHEDULES

Scale	NONE
Job No.	0112
Sheet	E-13
of	

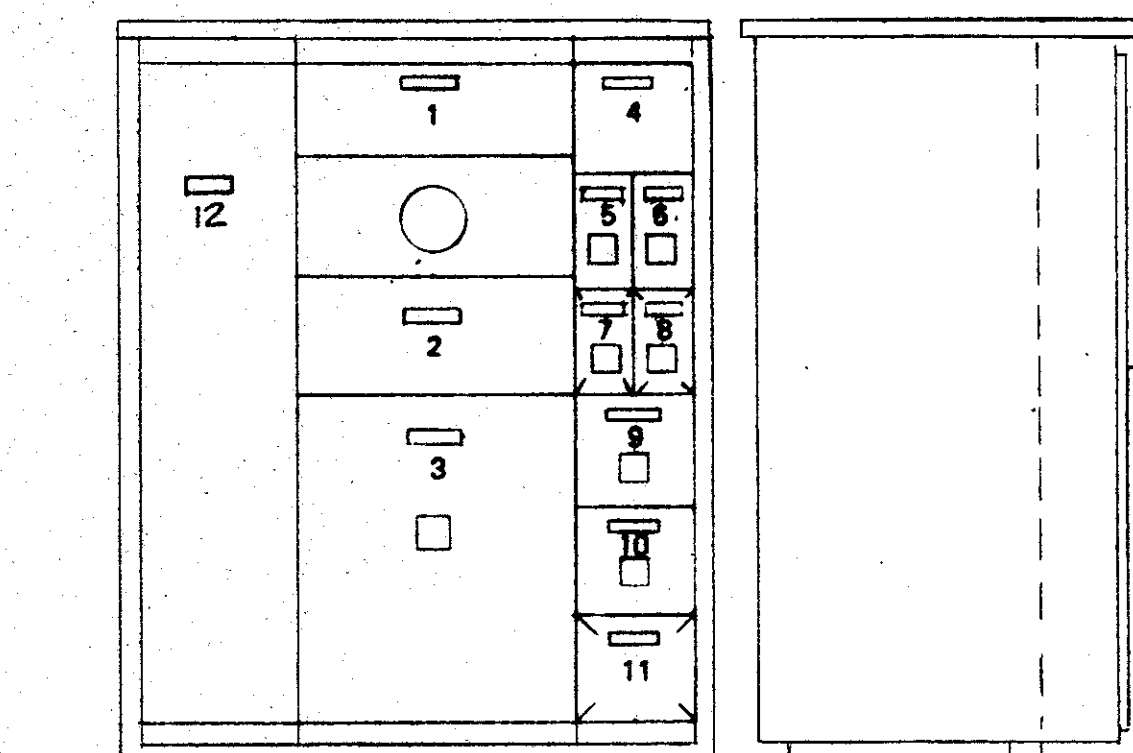


FRONT ELEVATION
(ENCLOSURE DOORS NOT SHOWN)

SIDE ELEVATION

MAIN SWITCHBOARD I
NO SCALE

NO.	NAMEPLATE INSCRIPTION
1.	MAIN SWITCHBOARD 1
2.	UTILITY CURRENT TRANSFORMERS
3.	MAIN
4.	TRANSFORMER MS-3 FEEDER
5.	TRANSFORMER MS-1 FEEDER
6.	TRANSFORMER MS-2 FEEDER
7.	(BLANK)
8.	(BLANK)
9.	DIST. SWITCHBOARD 1 FEEDER
10.	MCC "A" FEEDER
11.	(BLANK)
12.	PULL SECTION


OILTIGHT PUSHBUTTON

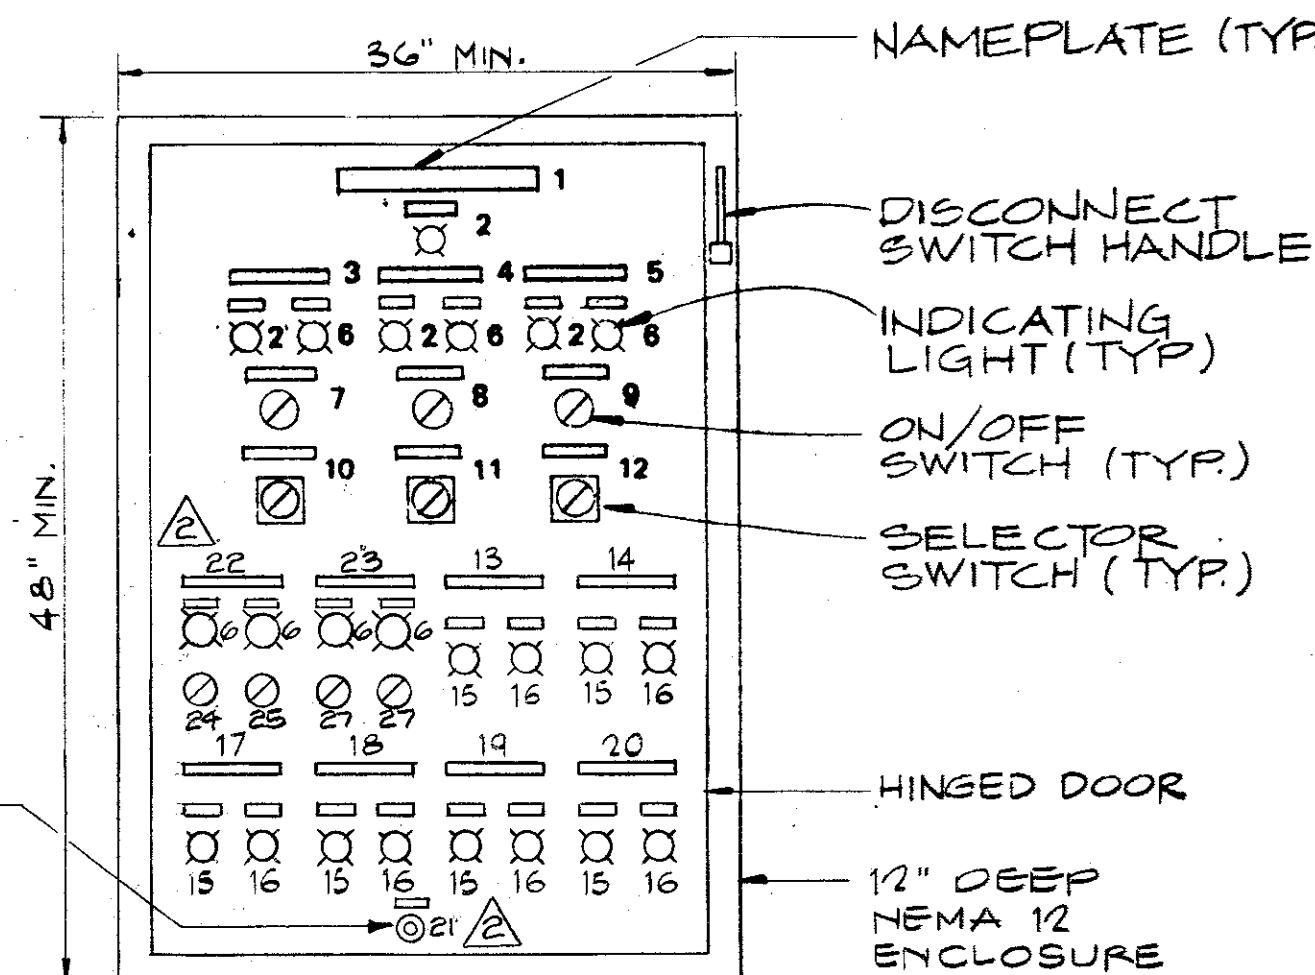

FRONT ELEVATION


ELECTRICAL CONTROL PANEL (ECP)
NO SCALE

NO.	NAMEPLATE INSCRIPTION
1.	ELECTRICAL CONTROL PANEL
2.	POWER ON
3.	REACTOR SUPPLY PUMP 1
4.	REACTOR SUPPLY PUMP 2
5.	REACTOR SUPPLY PUMP 3
6.	RUN
7.	SWITCH HS-14A
8.	SWITCH HS-15A
9.	SWITCH HS-16A
10.	SELECTOR SWITCH HS-14B
11.	SELECTOR SWITCH HS-15B
12.	SELECTOR SWITCH HS-16B
13.	SECONDARY EFFLUENT RECIRC. VALVE KV-9
14.	SECONDARY EFFLUENT RECIRC. VALVE KV-10
15.	FULLY OPEN
16.	FULLY CLOSED
17.	KNIFE VALVE KV-5
18.	KNIFE VALVE KV-6
19.	KNIFE VALVE KV-7
20.	KNIFE VALVE KV-8
21.	KNIFE VALVE LOW FLOW RESET
22.	PRIMARY SLUDGE PUMPS
23.	PUMP NO. 1 PUMP NO. 2
24.	SECONDARY SLUDGE PUMPS
25.	PUMP NO. 1 PUMP NO. 2
26.	SWITCH HS-12A
27.	HS-12B
28.	HS-29A
29.	HS-29B

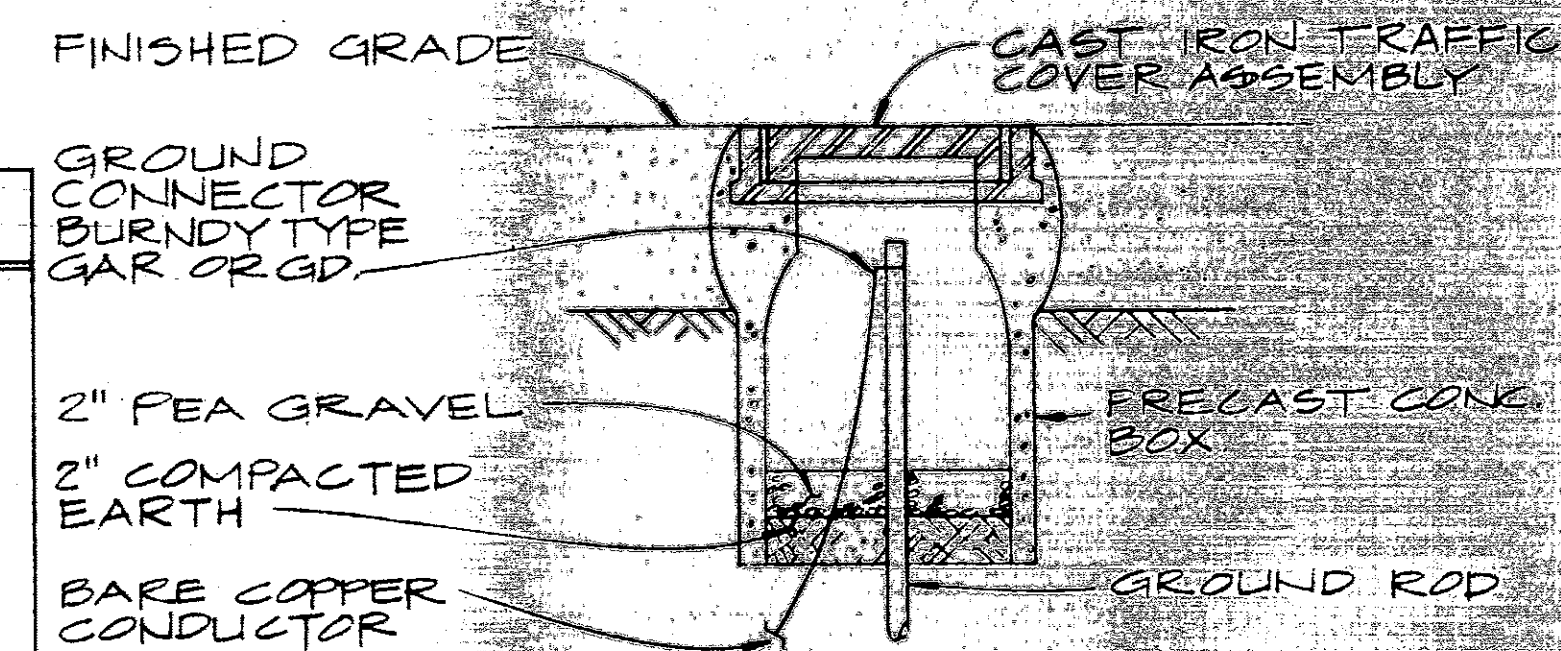


GROUND ROD BOX INSTALLATION

DETAIL 2
NO SCALE 14/14

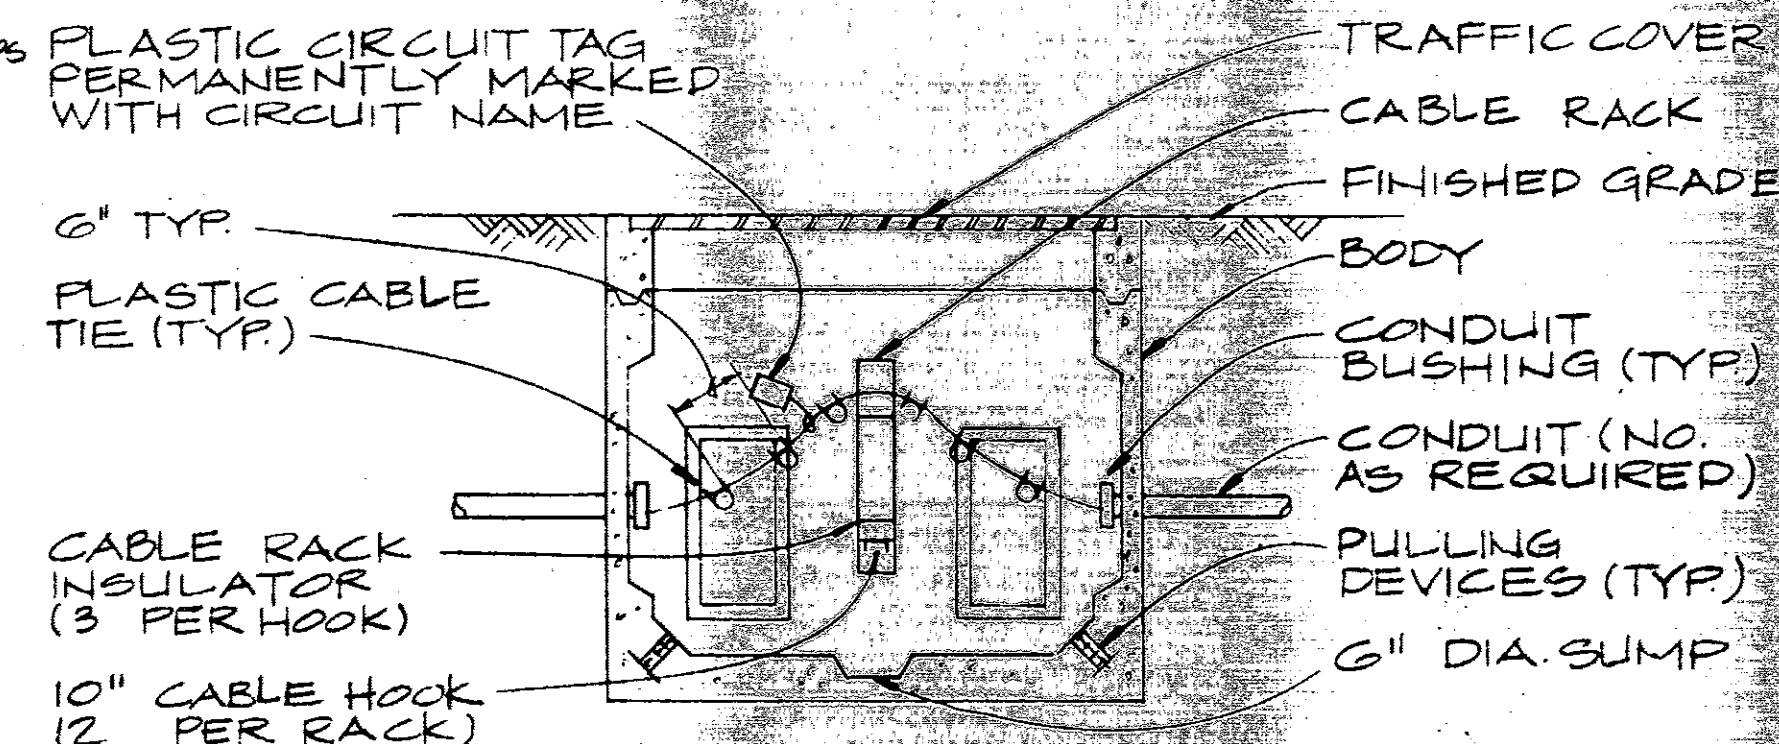

PRECAST CONCRETE PULLBOX INSTALLATION

DETAIL 3
NO SCALE 14/14

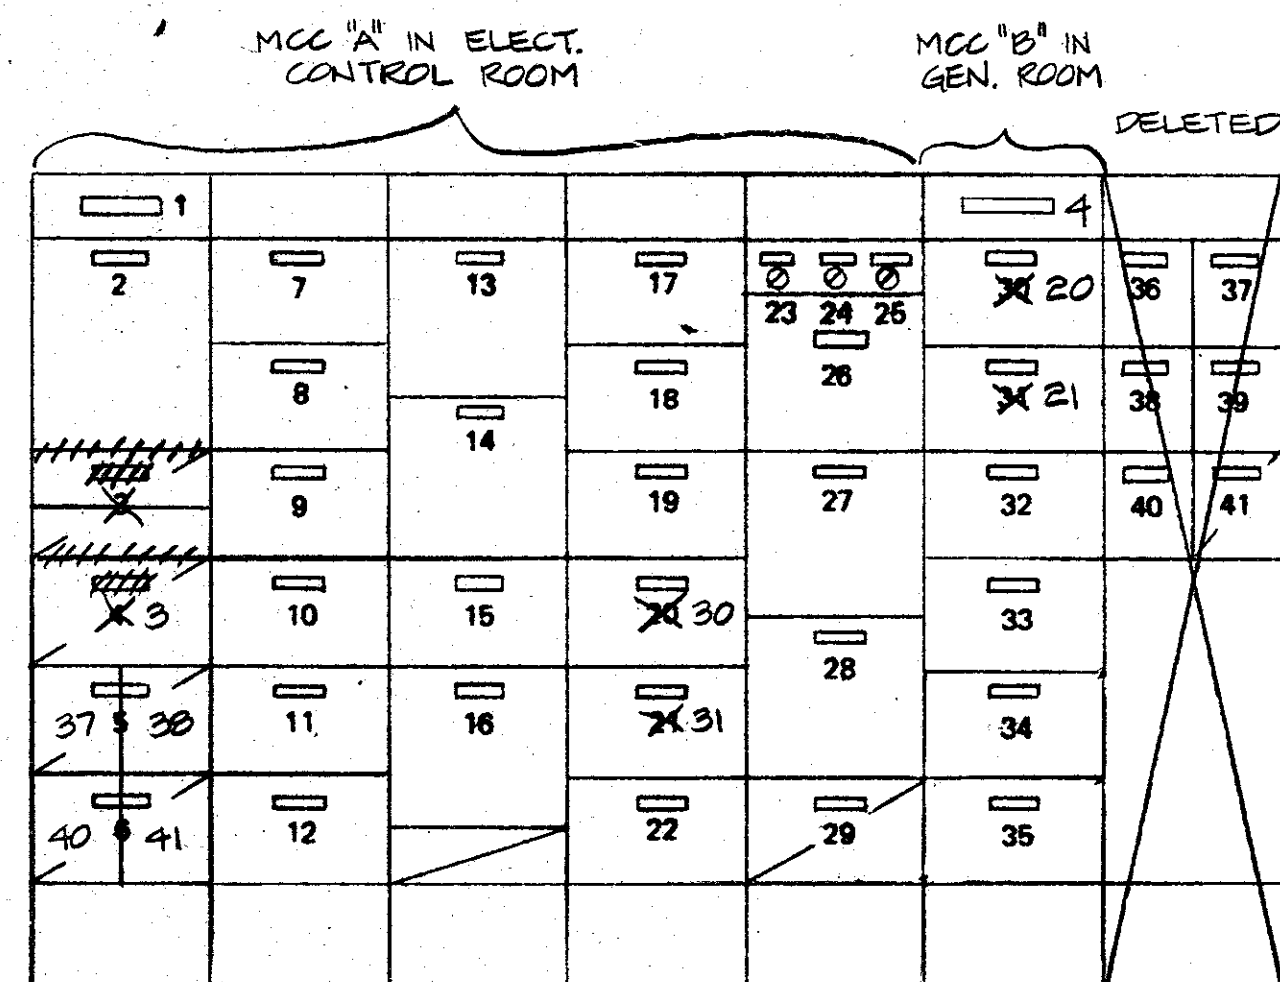


NOTE:

REFER TO CONTROL RM. LAYOUT
PLAN ON DWG. E-10 FOR RIGHT
ANGLED CONFIGURATION.

FRONT ELEVATION

MOTOR CONTROL CENTER "A" & "B"
NO SCALE

NO.	NAMEPLATE INSCRIPTION
1.	MOTOR CONTROL CENTER "A"
2.	MAIN CIRCUIT BREAKER
3.	(BLANK)
4.	(BLANK) MOTOR CONTROL CENTER "B"
5.	(BLANK)
6.	(BLANK)
7.	PRIMARY SCUM PUMP
8.	SECONDARY SLUDGE COLLECTOR OPERATOR 1
9.	SECONDARY SLUDGE COLLECTOR OPERATOR 2
10.	SECONDARY SCUM PUMP
11.	FIXED FILM REACTOR SUPPLY FAN 1
12.	FIXED FILM REACTOR SUPPLY FAN 2
13.	EFFLUENT SCREEN
14.	THICKENED SLUDGE PUMP
15.	THICKENED SCUM PUMP
16.	SLUDGE THICKENER DRIVE
17.	SUPERNATANT PUMP 1
18.	SUPERNATANT PUMP 2
19.	GRIT WASHER
20.	DIGESTED SLUDGE CIRCULATION PUMP 1
21.	DIGESTED SLUDGE CIRCULATION PUMP 2
22.	SLUDGE GAS COMPRESSOR
23.	SUPERNATANT PUMP LEAD/LAG SELECTION
24.	RECLAIMED WATER PUMP LEAD/LAG/FOLLOW SELECTION
25.	POTABLE WATER PUMP LEAD/LAG SELECTION
26.	RECLAIMED WATER PUMP 1
27.	RECLAIMED WATER PUMP 2
28.	RECLAIMED WATER PUMP 3
29.	(BLANK)
30.	POTABLE WATER PUMP 1
31.	POTABLE WATER PUMP 2
32.	H.W. CIRCULATING PUMP 1
33.	H.W. CIRCULATING PUMP 2
34.	H.W. CIRCULATING PUMP 3
35.	H.W. CIRCULATING PUMP 4
36.	KNIFE GATE FEEDER
37.	* SUMP PUMPS (SEC. GALLERY) FEEDER
38.	* TRANSFORMER A2 FEEDER - SLUDGE PUMPS
39.	* TRANSFORMER A1 FEEDER
40.	TRANSFORMER A FEEDER
41.	(BLANK)
42.	* DELETED

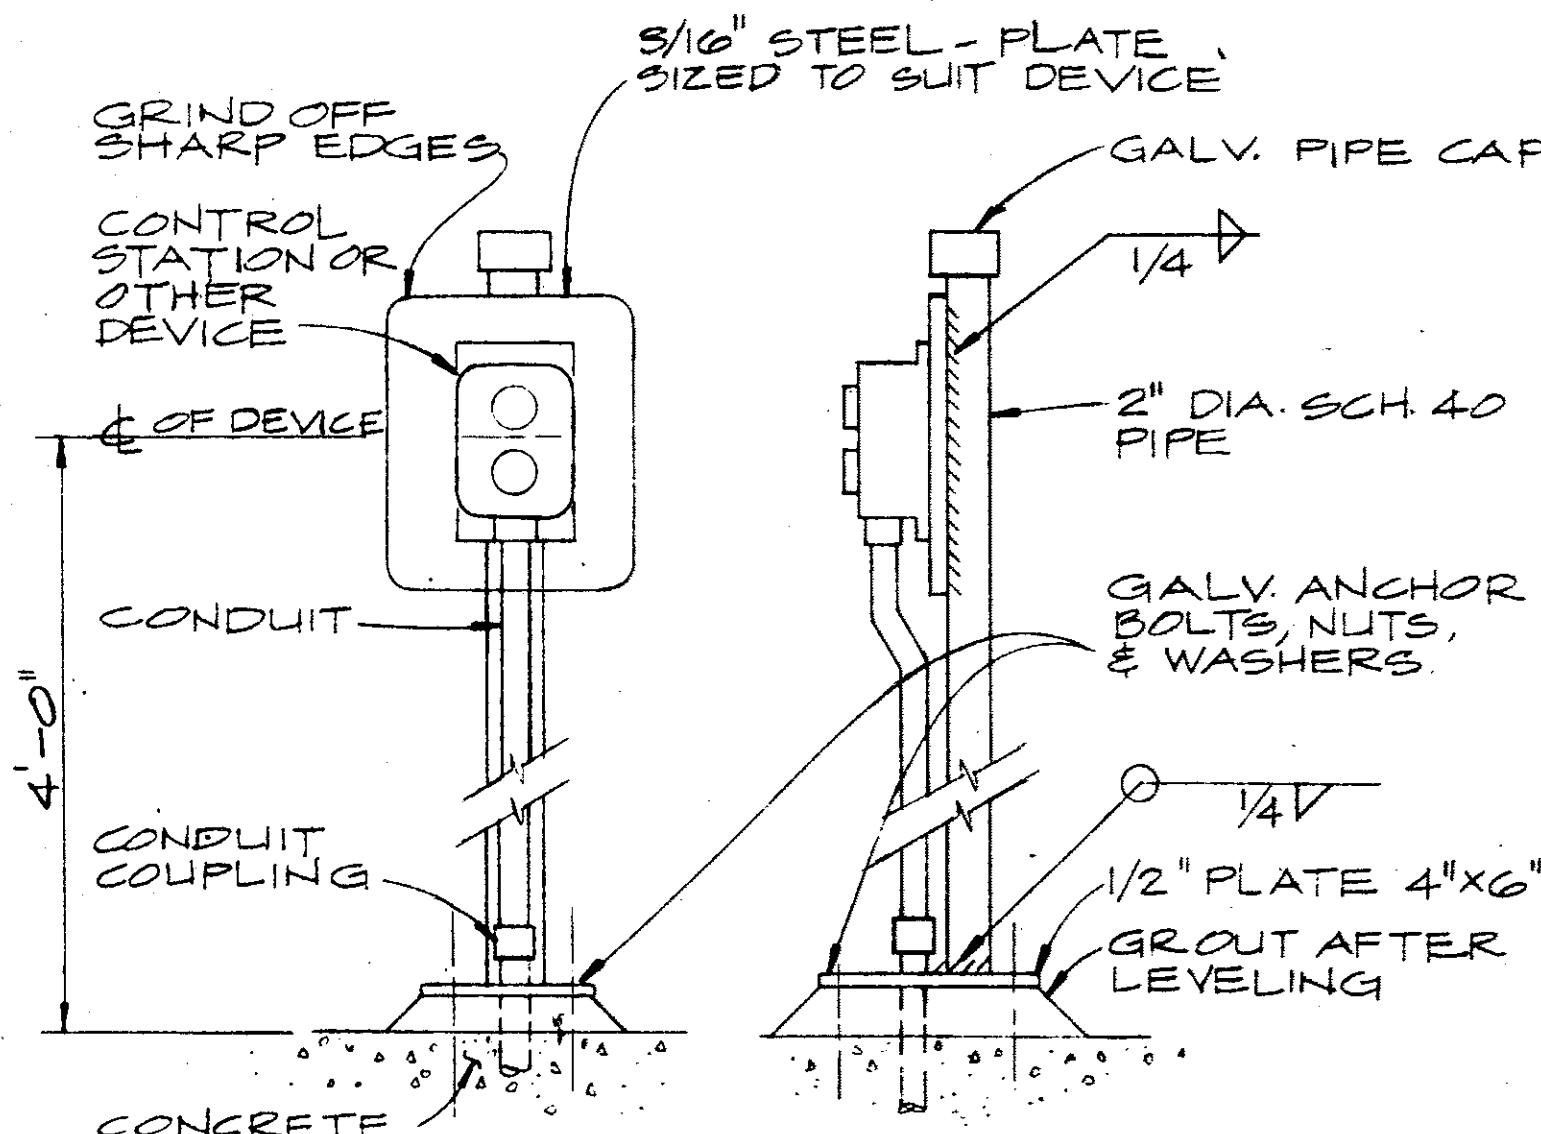


EQUIPMENT MOUNTING STAND

DETAIL 1
NO SCALE 14/14

NOTE:

1. HOT DIP GALVANIZE STAND AFTER FABRICATION
2. BOLT STAND TO CHECKER PLATE AT APPROPRIATE LOCATIONS

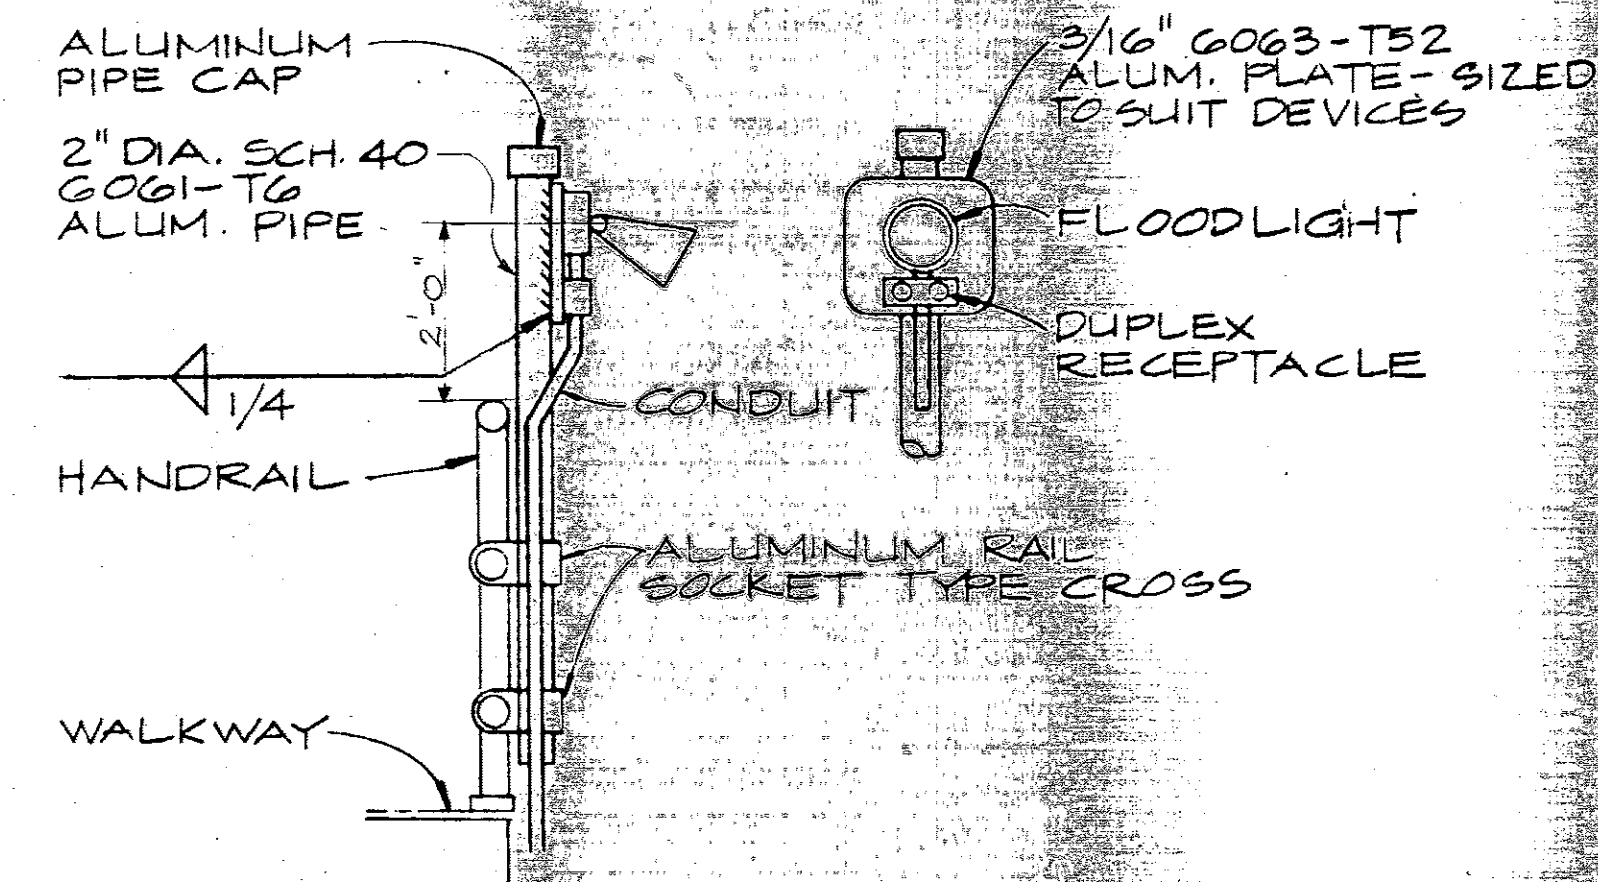

FLOODLIGHT MOUNTING

DETAIL 4
NO SCALE 14/14

Record Drawing

These record drawings have been prepared
in part on the basis of information compiled
and furnished by others. Kennedy/Jenks
Chilton is not responsible for any errors or
omissions in this document as a result of
information provided by others.
Date: APR. 24, 1988

Revised	Description	Submit	App'd	Date
1	CO NO. 25			
2	CO NO. 12			
3	FIELD CHANGE			
4	CLARIFICATION			

Reference Information and Notes:

Designed RDS	Wastewater Plant Improvements Sausalito - Marin City Sanitary District	C-06-2464
Drawn CAB	Kennedy/Jenks Engineers	San Francisco
Checked JWS	Submitted: <i>Victor Williams</i> C95:0	Approved: <i>Robert J. Quinn</i>
Date 1-29-81		

ELEVATIONS AND DETAILS

Scale NONE
Job No. 0112
Sheet E-14

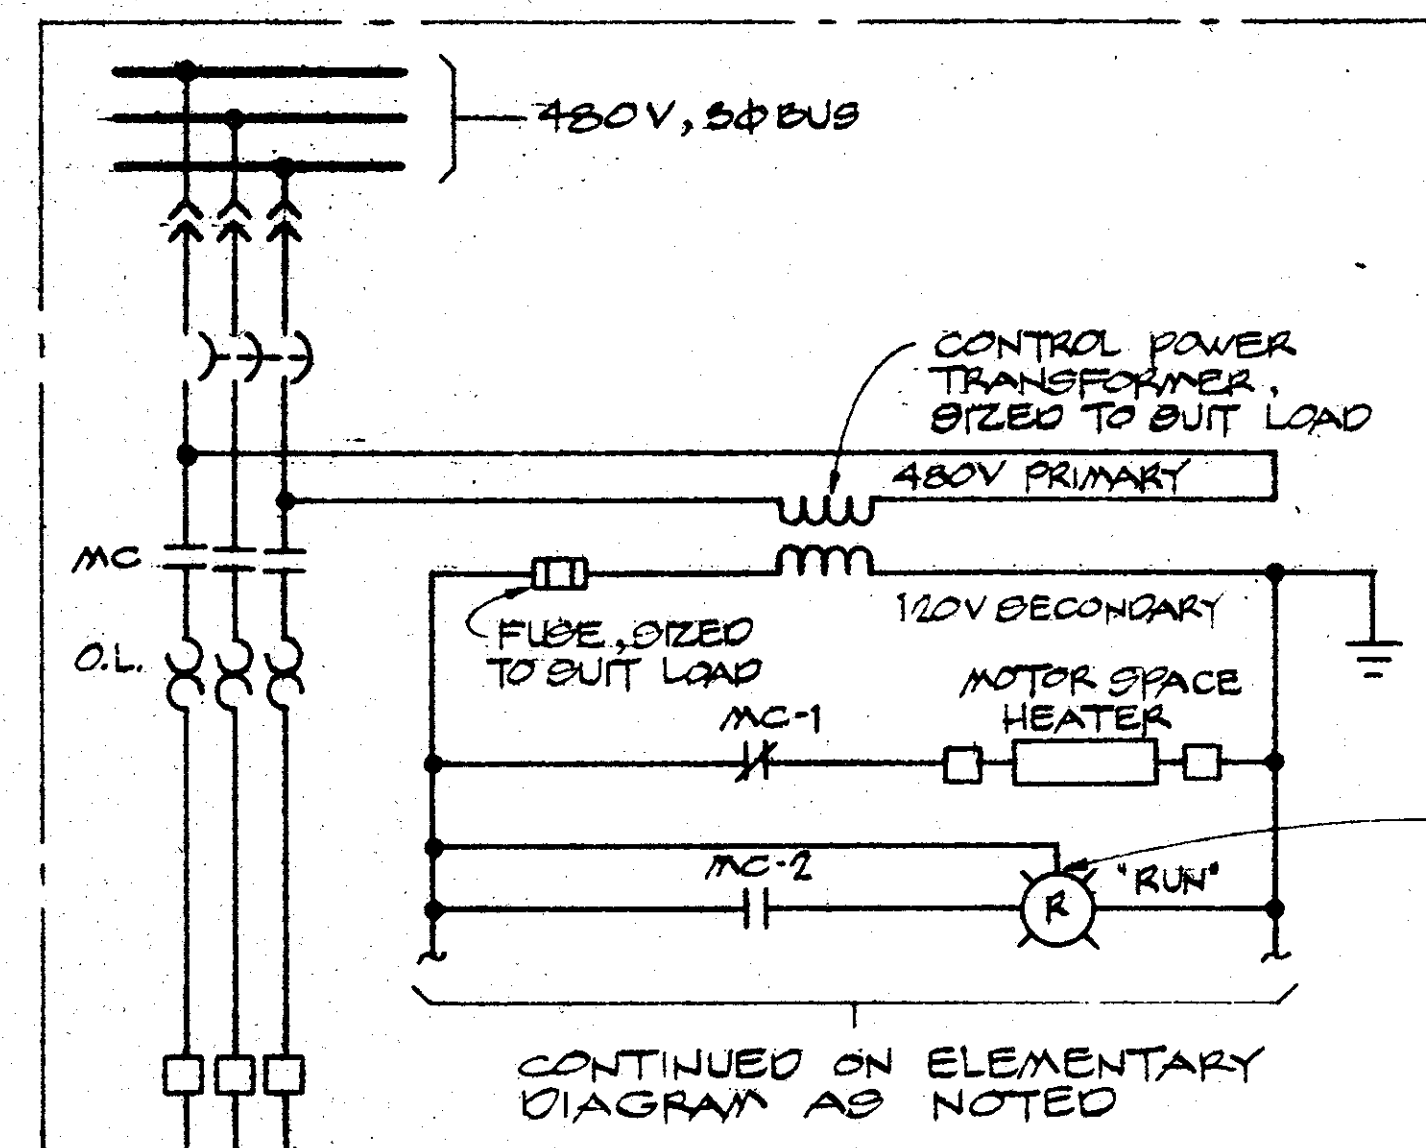


DIAGRAM 1

TYPICAL MOTOR CONNECTION AND CONTROL POWER SOURCE FOR FVNR STARTER.

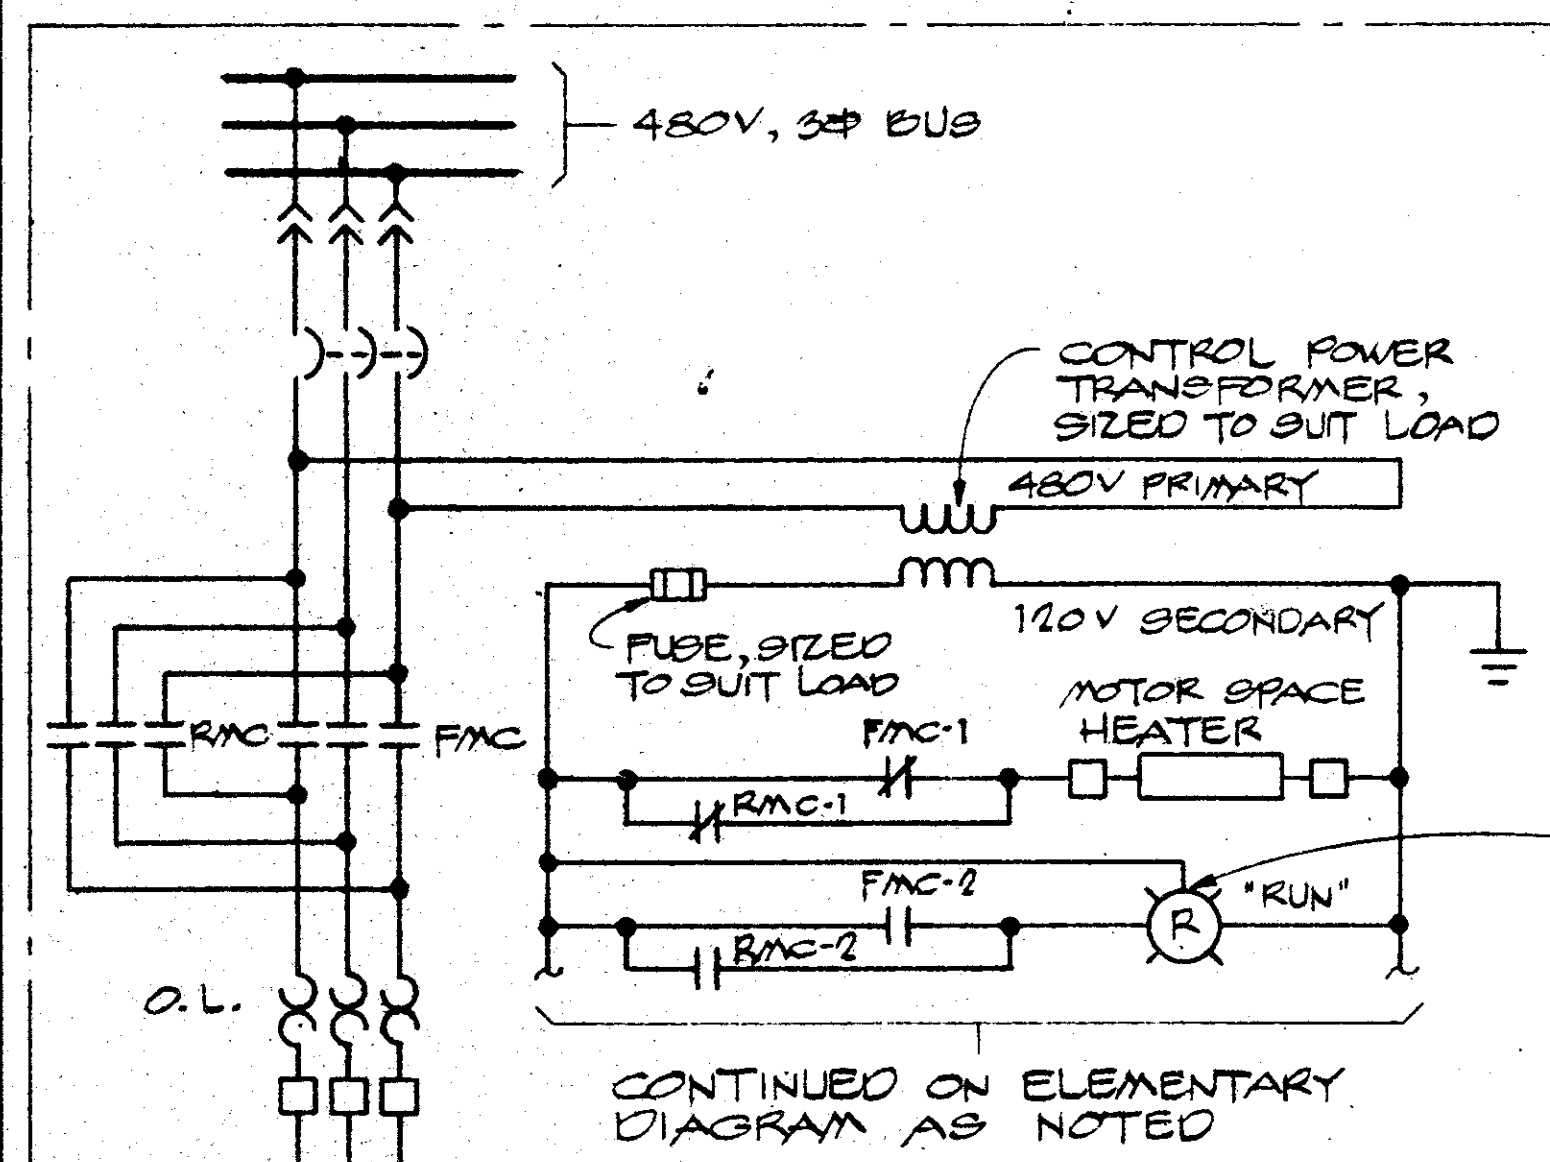


DIAGRAM 2

TYPICAL MOTOR CONNECTION AND CONTROL POWER SOURCE FOR FVR STARTER.

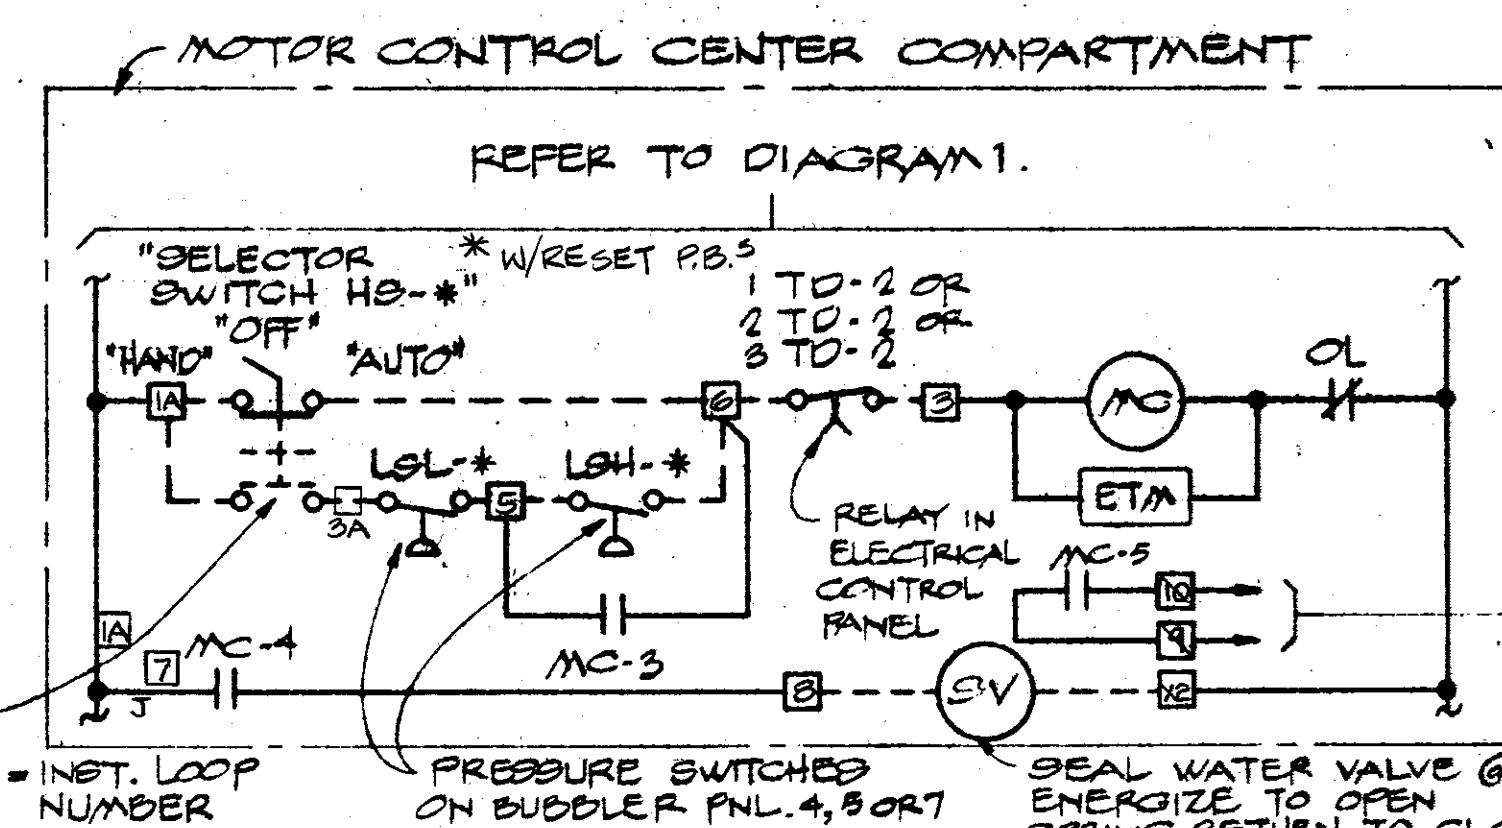


DIAGRAM 3

TYPICAL FOR: THICKENED SCUM PUMP
PRIMARY SCUM PUMP
SECONDARY SCUM PUMP

INST. LOOP MCC UNIT #5
21 3H
24 MCC-A 2B
31 2H

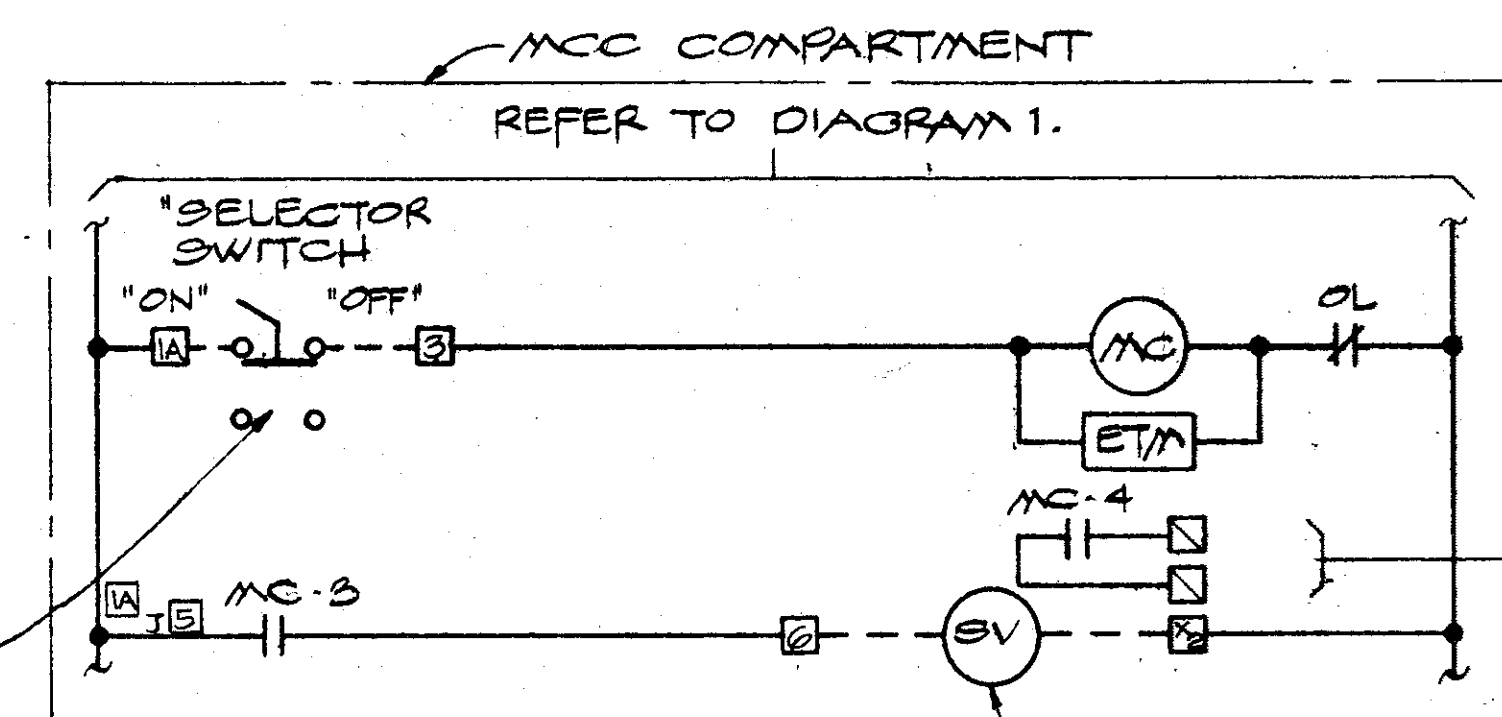


DIAGRAM 4

TYPICAL FOR: DIGESTED SLUDGE RECIRCULATION PUMP # 1 MCC-B 1B
DIGESTED SLUDGE RECIRCULATION PUMP # 2 1D

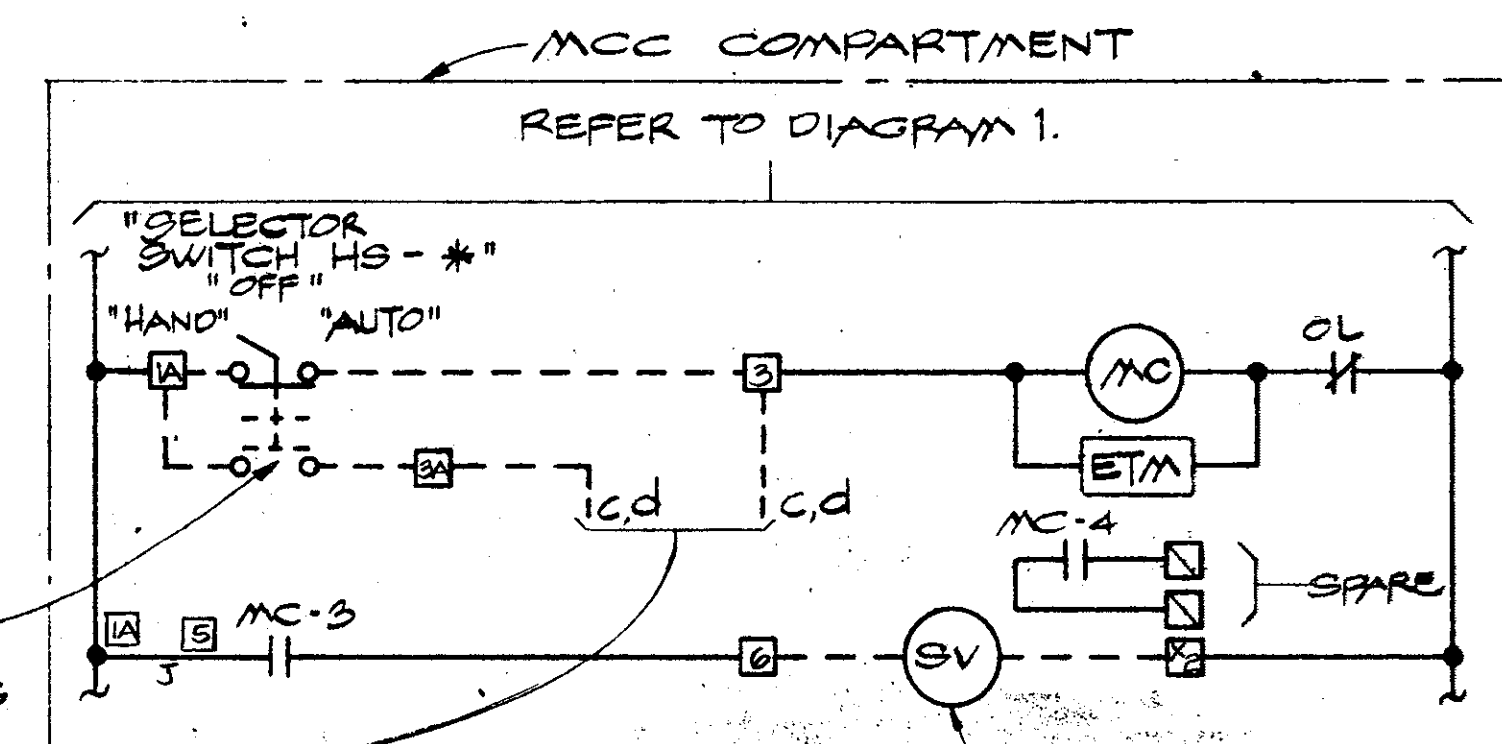


DIAGRAM 5

TYPICAL FOR: SUPERNATANT PUMP 1
SUPERNATANT PUMP 2

INST. LOOP MCC-A
25 A 4B
25 B 4D

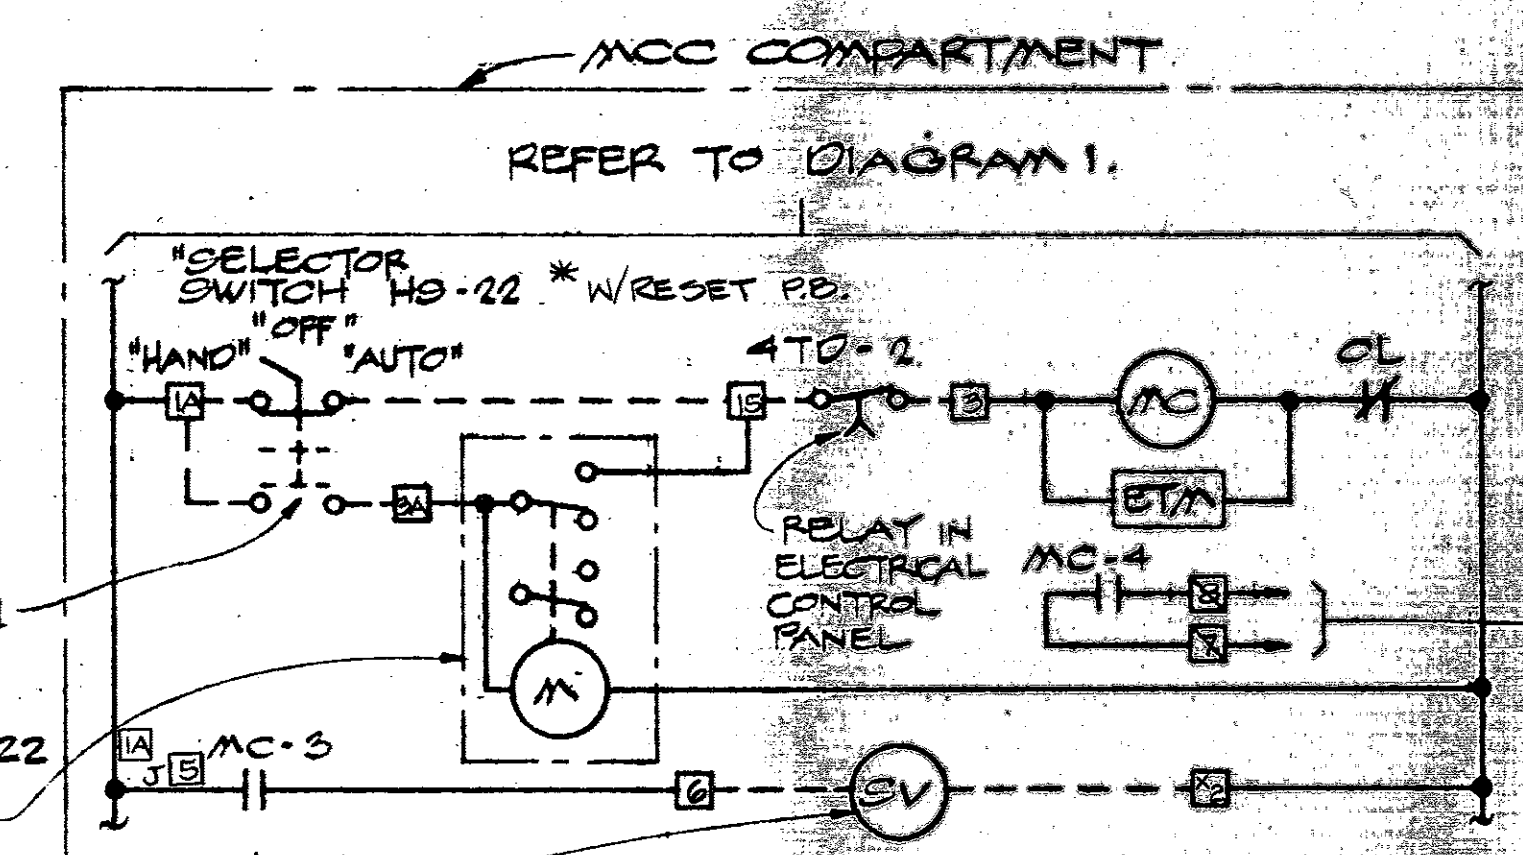


DIAGRAM 6
THICKENED SLUDGE PUMP

INST. LOOP MCC-A
22 3F

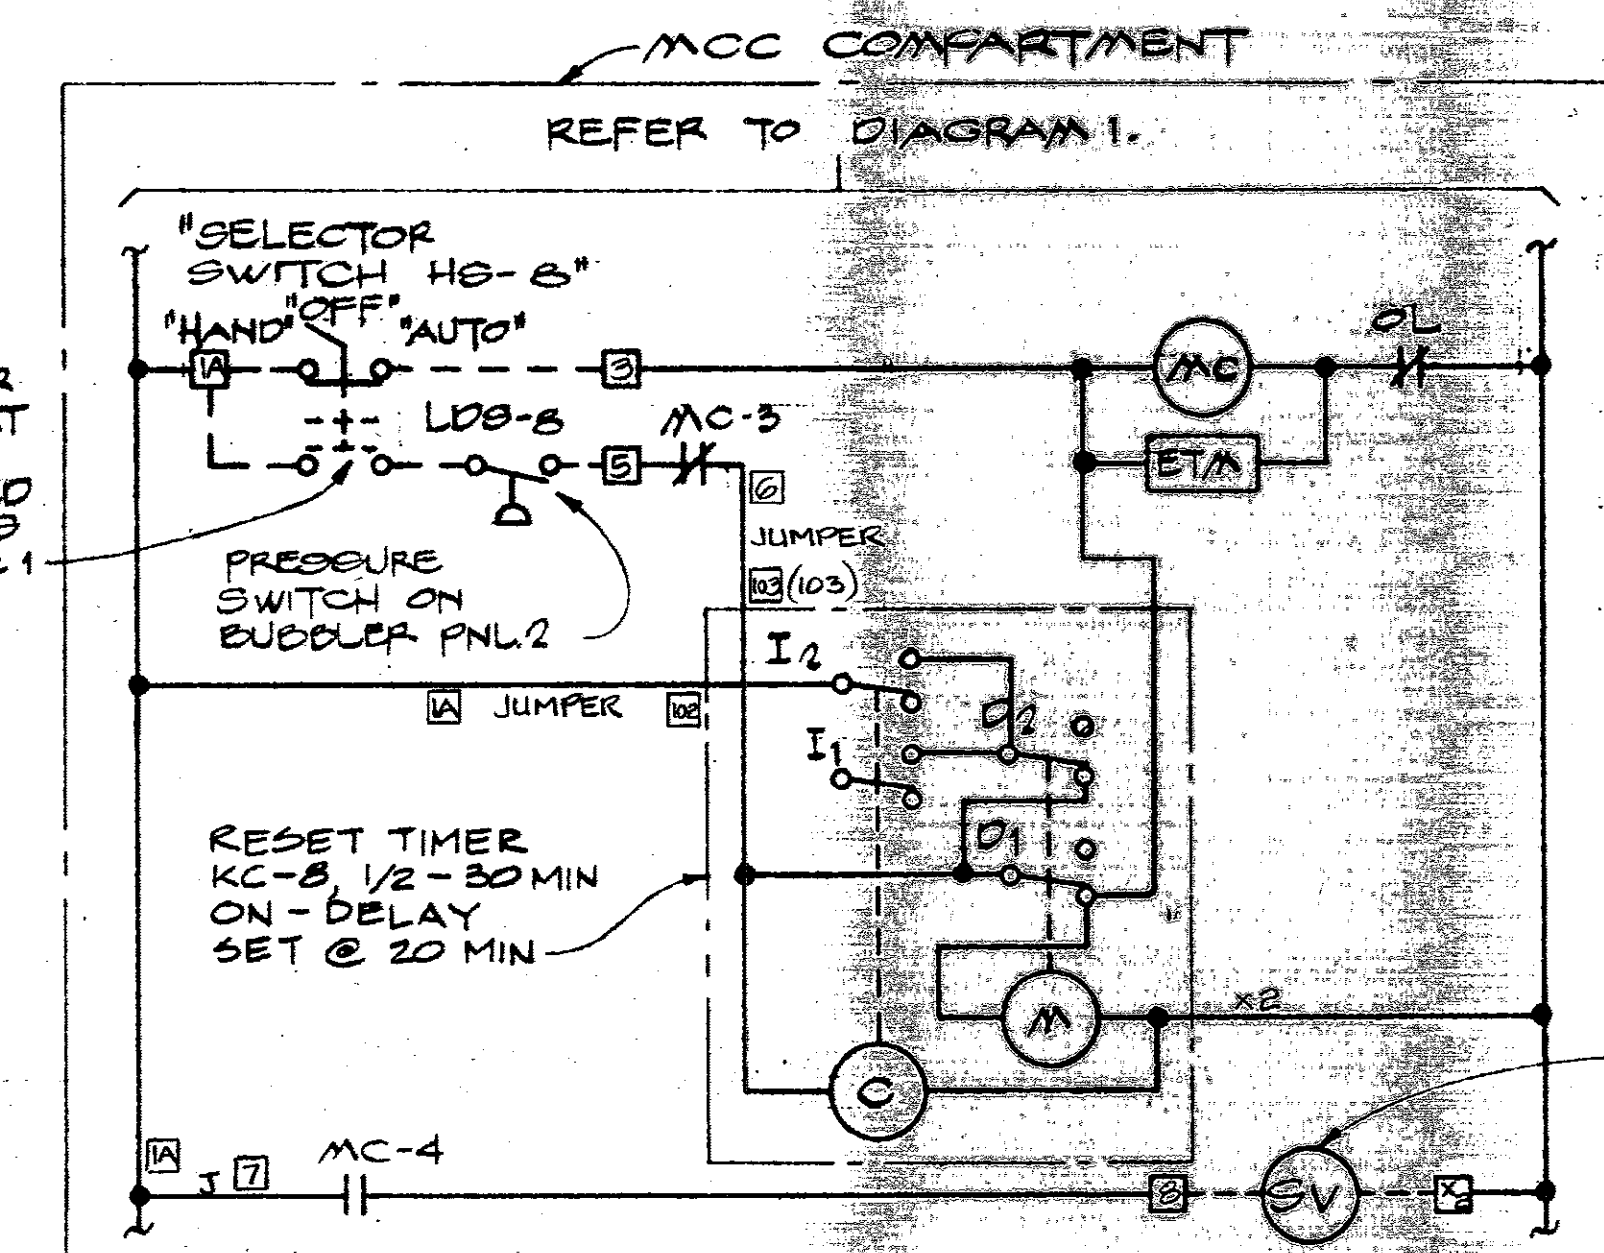


DIAGRAM 7
EFFLUENT SCREEN

INST. LOOP
8

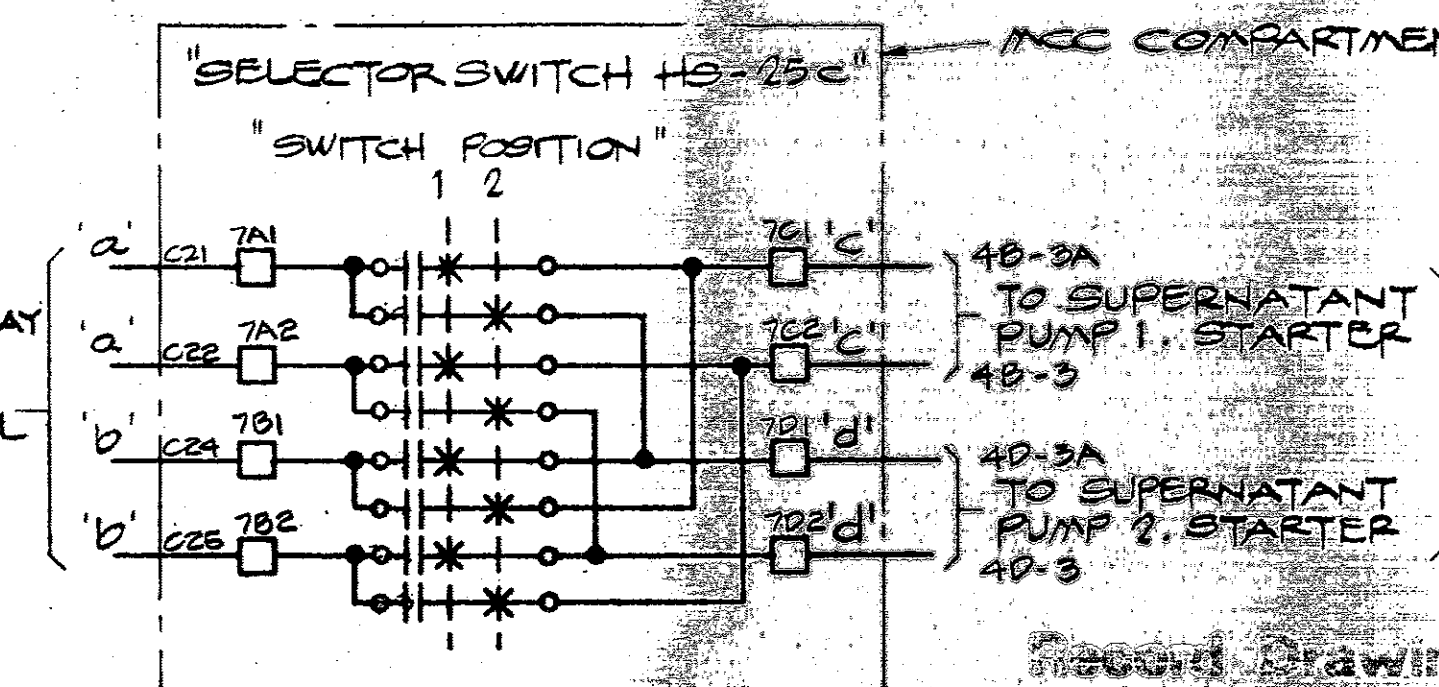


DIAGRAM 7A
SUPERNATANT PUMP LEAD/LAG CONTROL

TO 1CR #12CR RELAY CONTACTS IN ELECTRICAL CONTROL PANEL REFER TO DIAG. 21
40-3A TO SUPERNATANT PUMP 1, STARTER
40-3 TO SUPERNATANT PUMP 2, STARTER
40-3

REFER TO DIAG. 5


Revised	Description	Submit	App'd	Date
1	FIELD TERMINAL NUMBERS ADDED			
	Refer to Tracing for Latest Revision			

Reference Information and Notes:
1. PROVIDE MEANS FOR LOCKING IN THE "OFF" POSITION

Designed RDS	Wastewater Plant Improvements Sausalito - Marin City Sanitary District	C-06-2464
Drawn W/L	Kennedy/Jenks Engineers	San Francisco
Checked JWS	Submitted: Walter J. Hammer, C9370	Approved: Red J. Allen
Date 1/29/81		

ELEMENTARY DIAGRAMS 1-7

Scale NONE
Job No. 0112
Sheet E-15

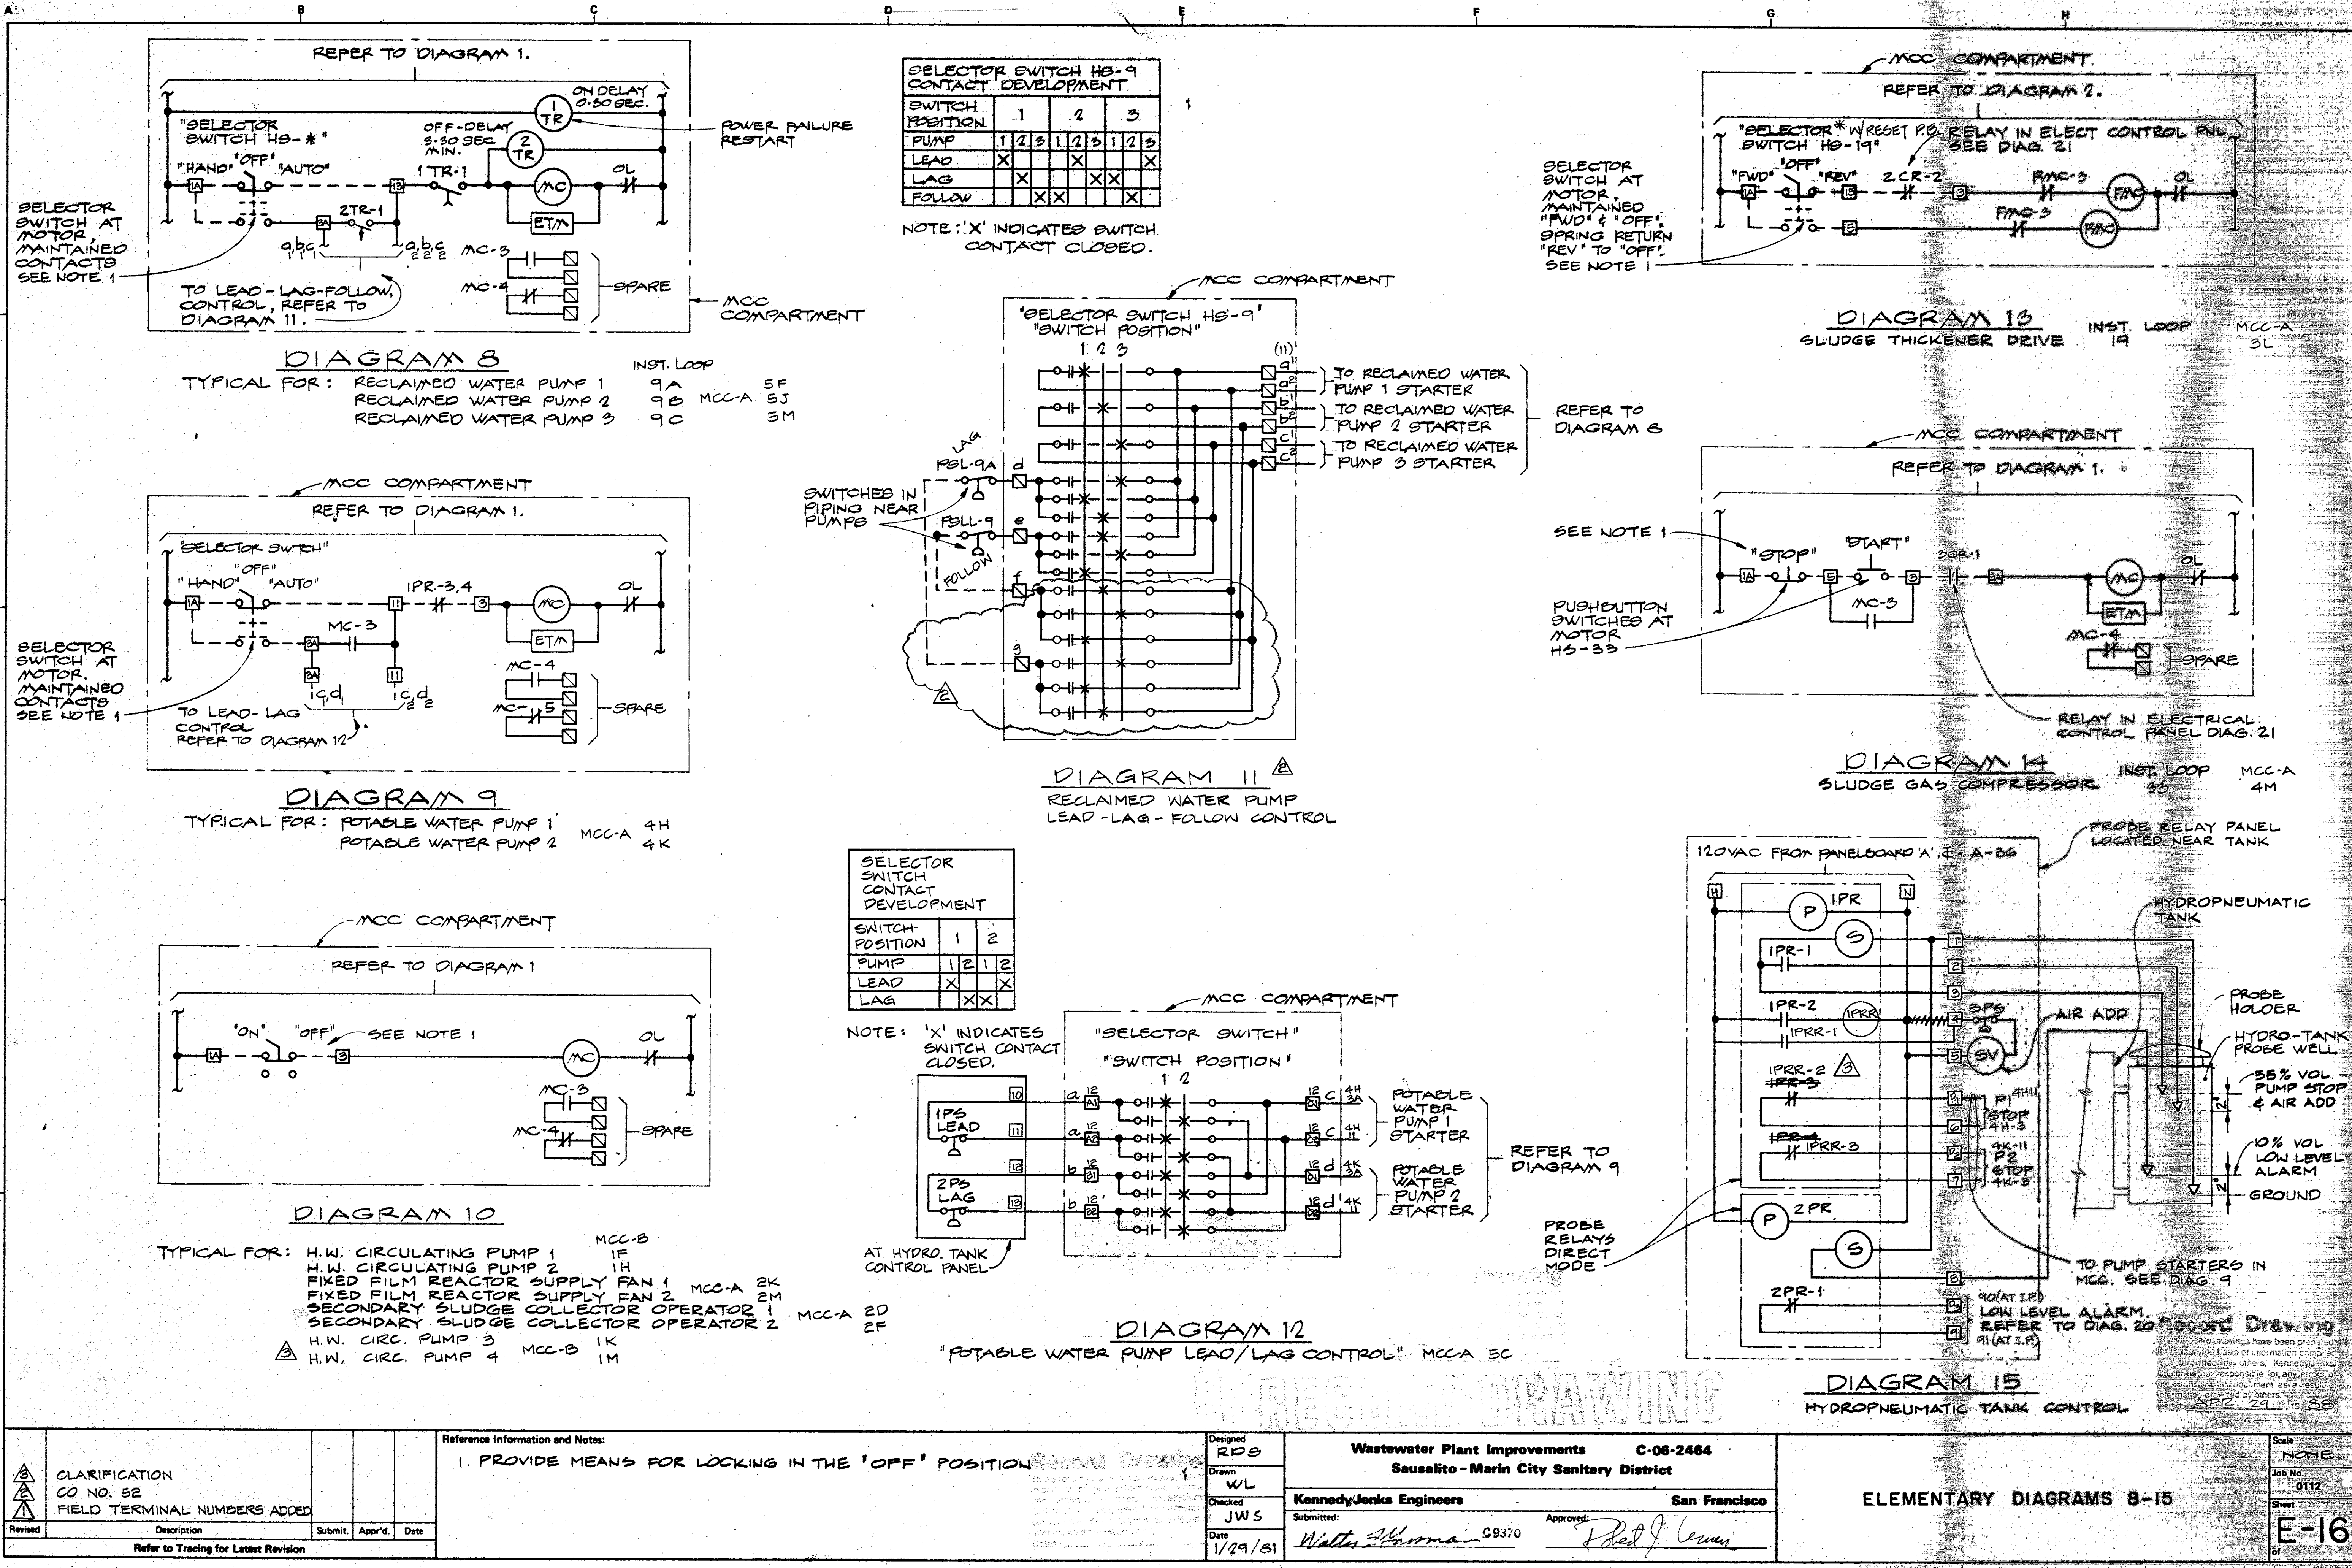

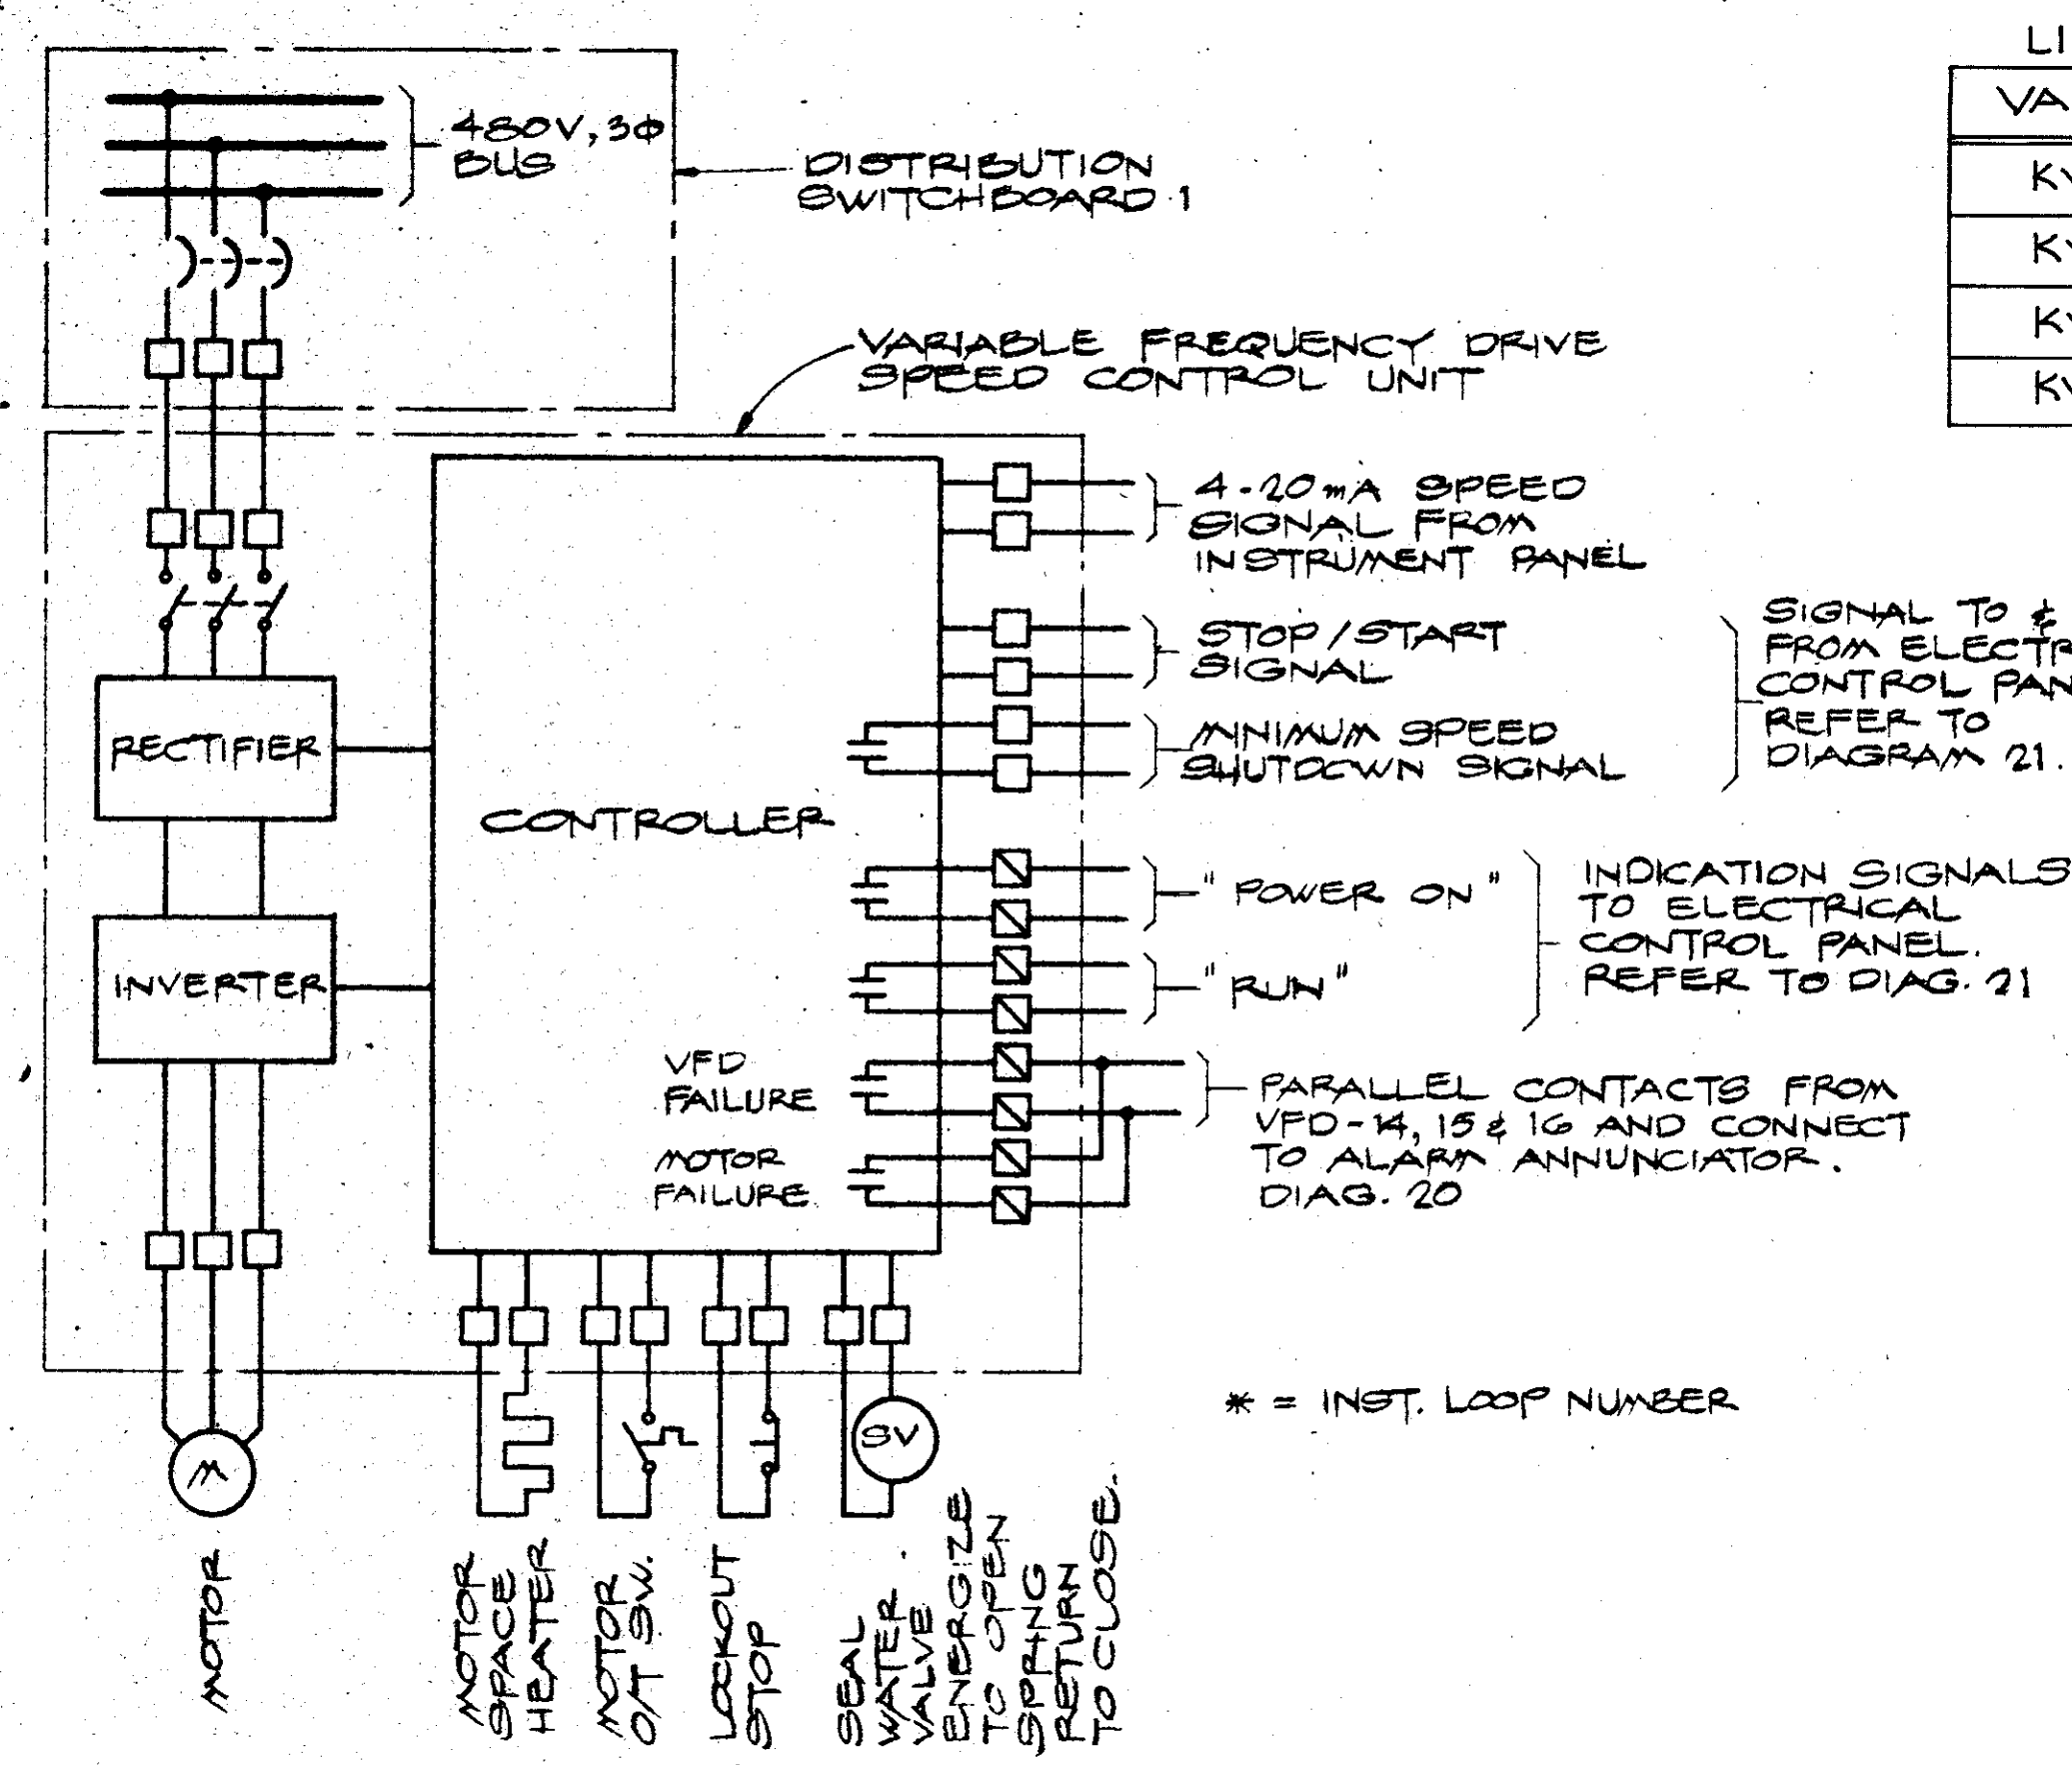


DIAGRAM 16
TYPICAL FOR REACTOR SUPPLY PUMP 1 VS 12A
REACTOR SUPPLY PUMP 2 VS 12B
REACTOR SUPPLY PUMP 3 VS 12C

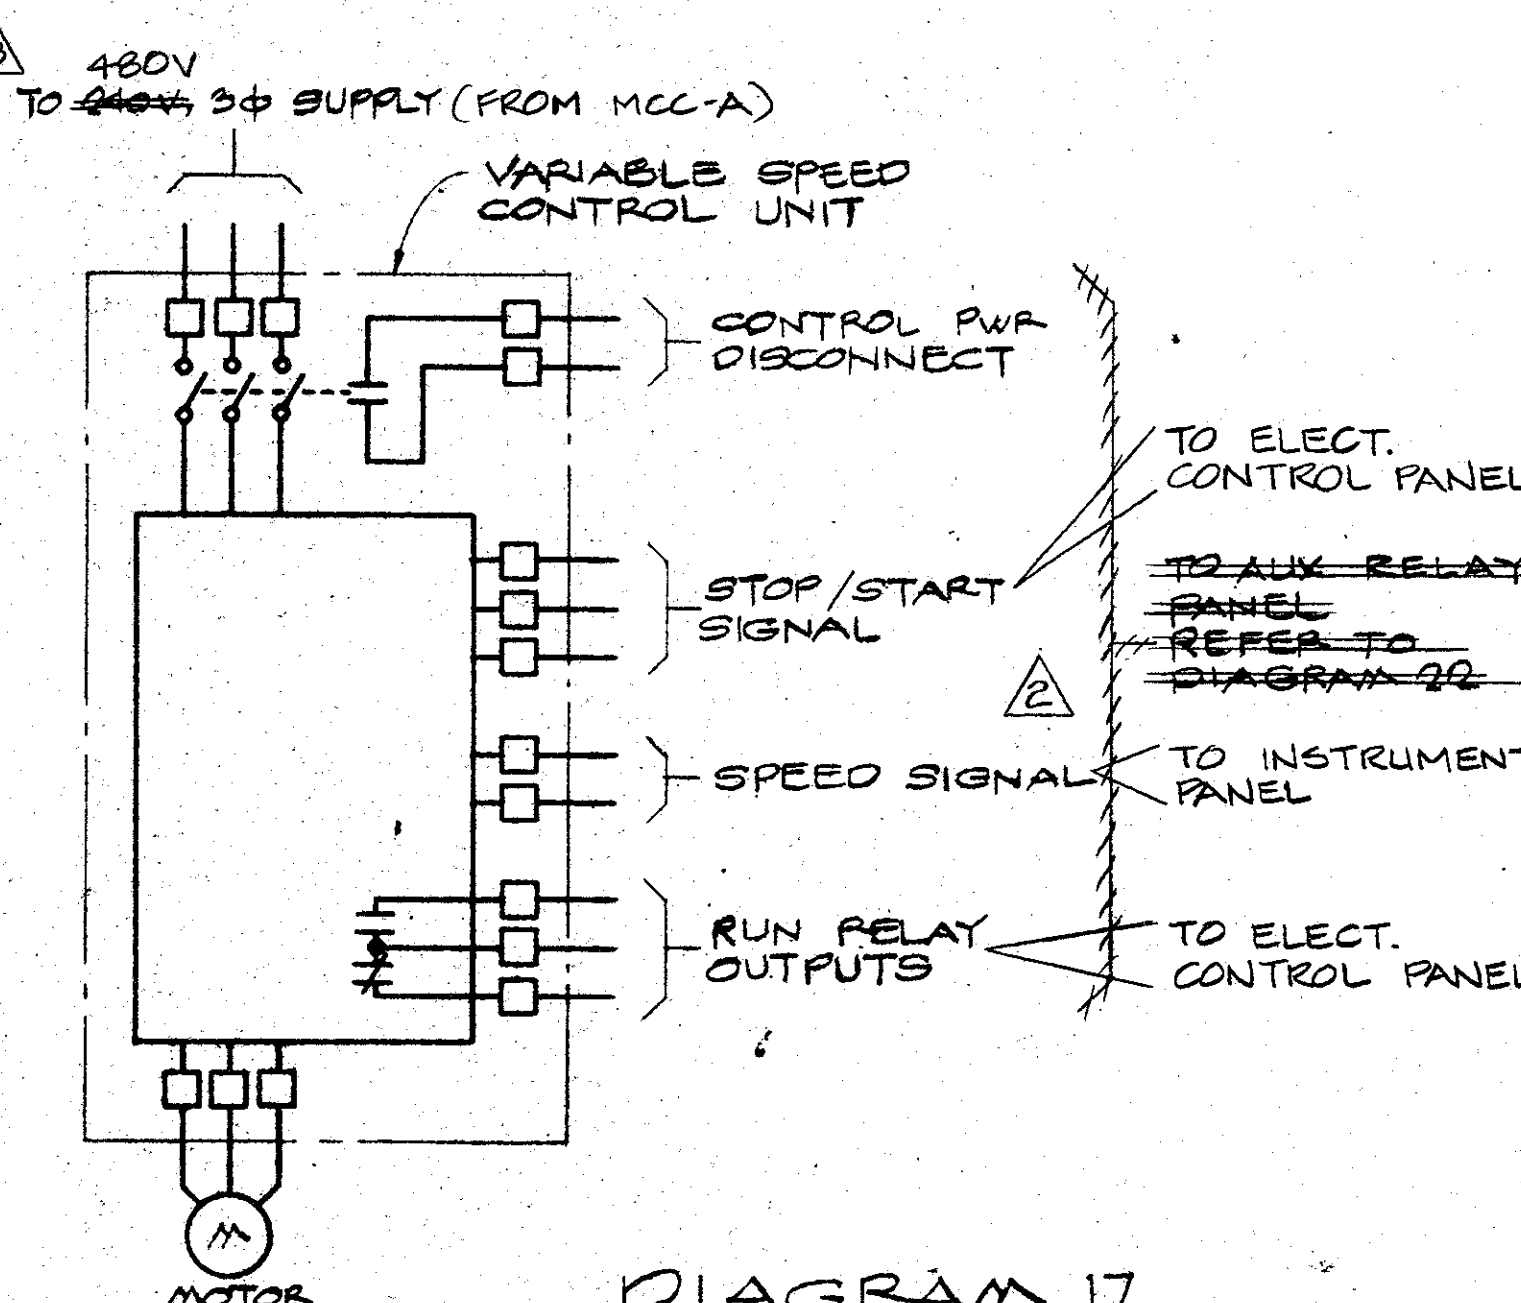


DIAGRAM 17
TYPICAL FOR: PRIMARY SLUDGE PUMP 1 VS 12A
PRIMARY SLUDGE PUMP 2 VS 12B
SECONDARY SLUDGE PUMP 1 VS 29A
SECONDARY SLUDGE PUMP 2 VS 29B

LIMIT SWITCH REFERENCES

VALVE NO	LSO-4	LSC-4
KV-5	ZSH 105	ZSL 105
KV-6	ZSH 106	ZSL 106
KV-7	ZSH 107	ZSL 107
KV-8	ZSH 108	ZSL 108

LIMIT SWITCH CONTACT DEVELOPMENT

CONTACT	VALVE POSITION	
	FULLY OPEN	FULLY CLOSED
LSC-1		
LSO-1		
LSC-2		
LSO-2		
LSC-3		
LSO-3		
LSC-4		
LSO-4		

NOTE:
CONTROL CIRCUIT SHOWN W/ GATE IN THE FULLY CLOSED POSITION.
--- CONTACT CLOSED.
--- CONTACT OPEN.

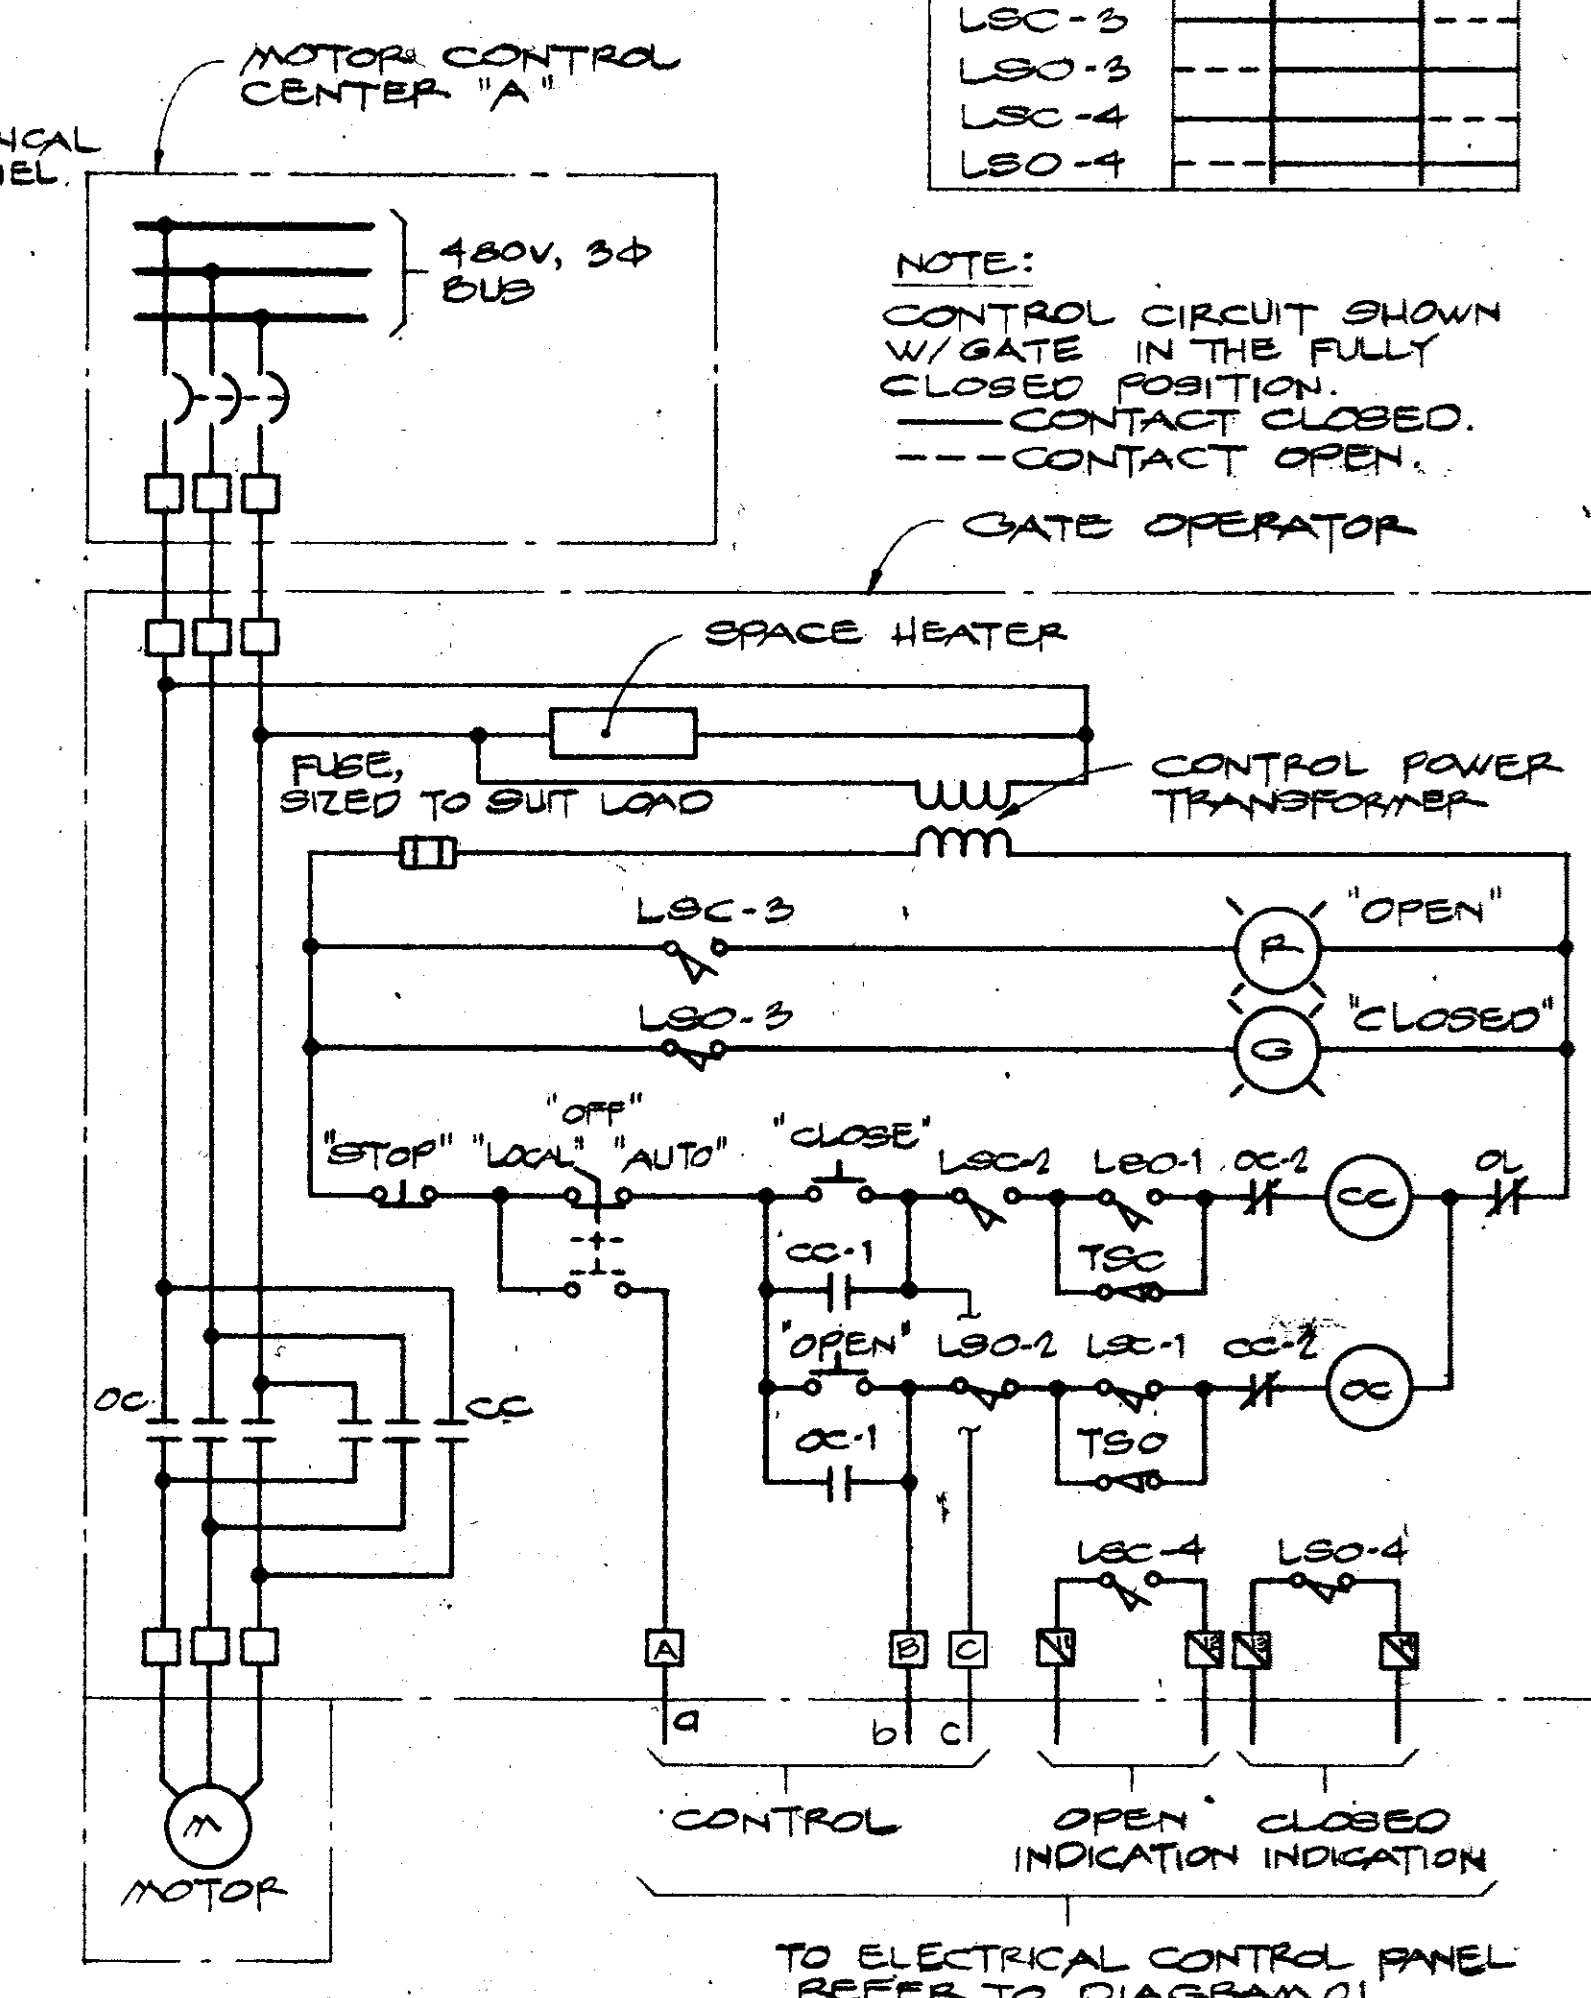


DIAGRAM 18
KNIFE VALVES KV-5, KV-6, KV-7, KV-8


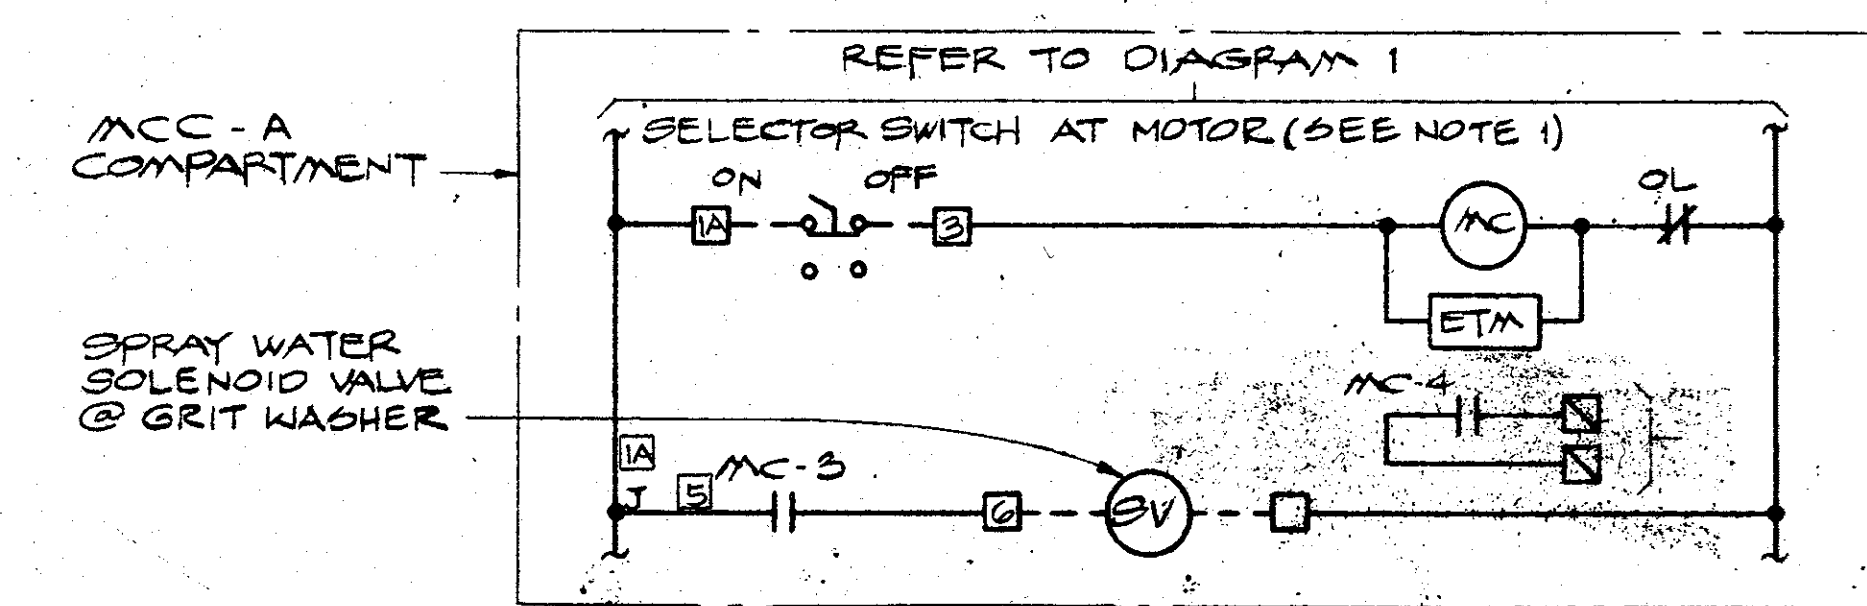


DIAGRAM 19
GRIT WASHER MCC-A 4F

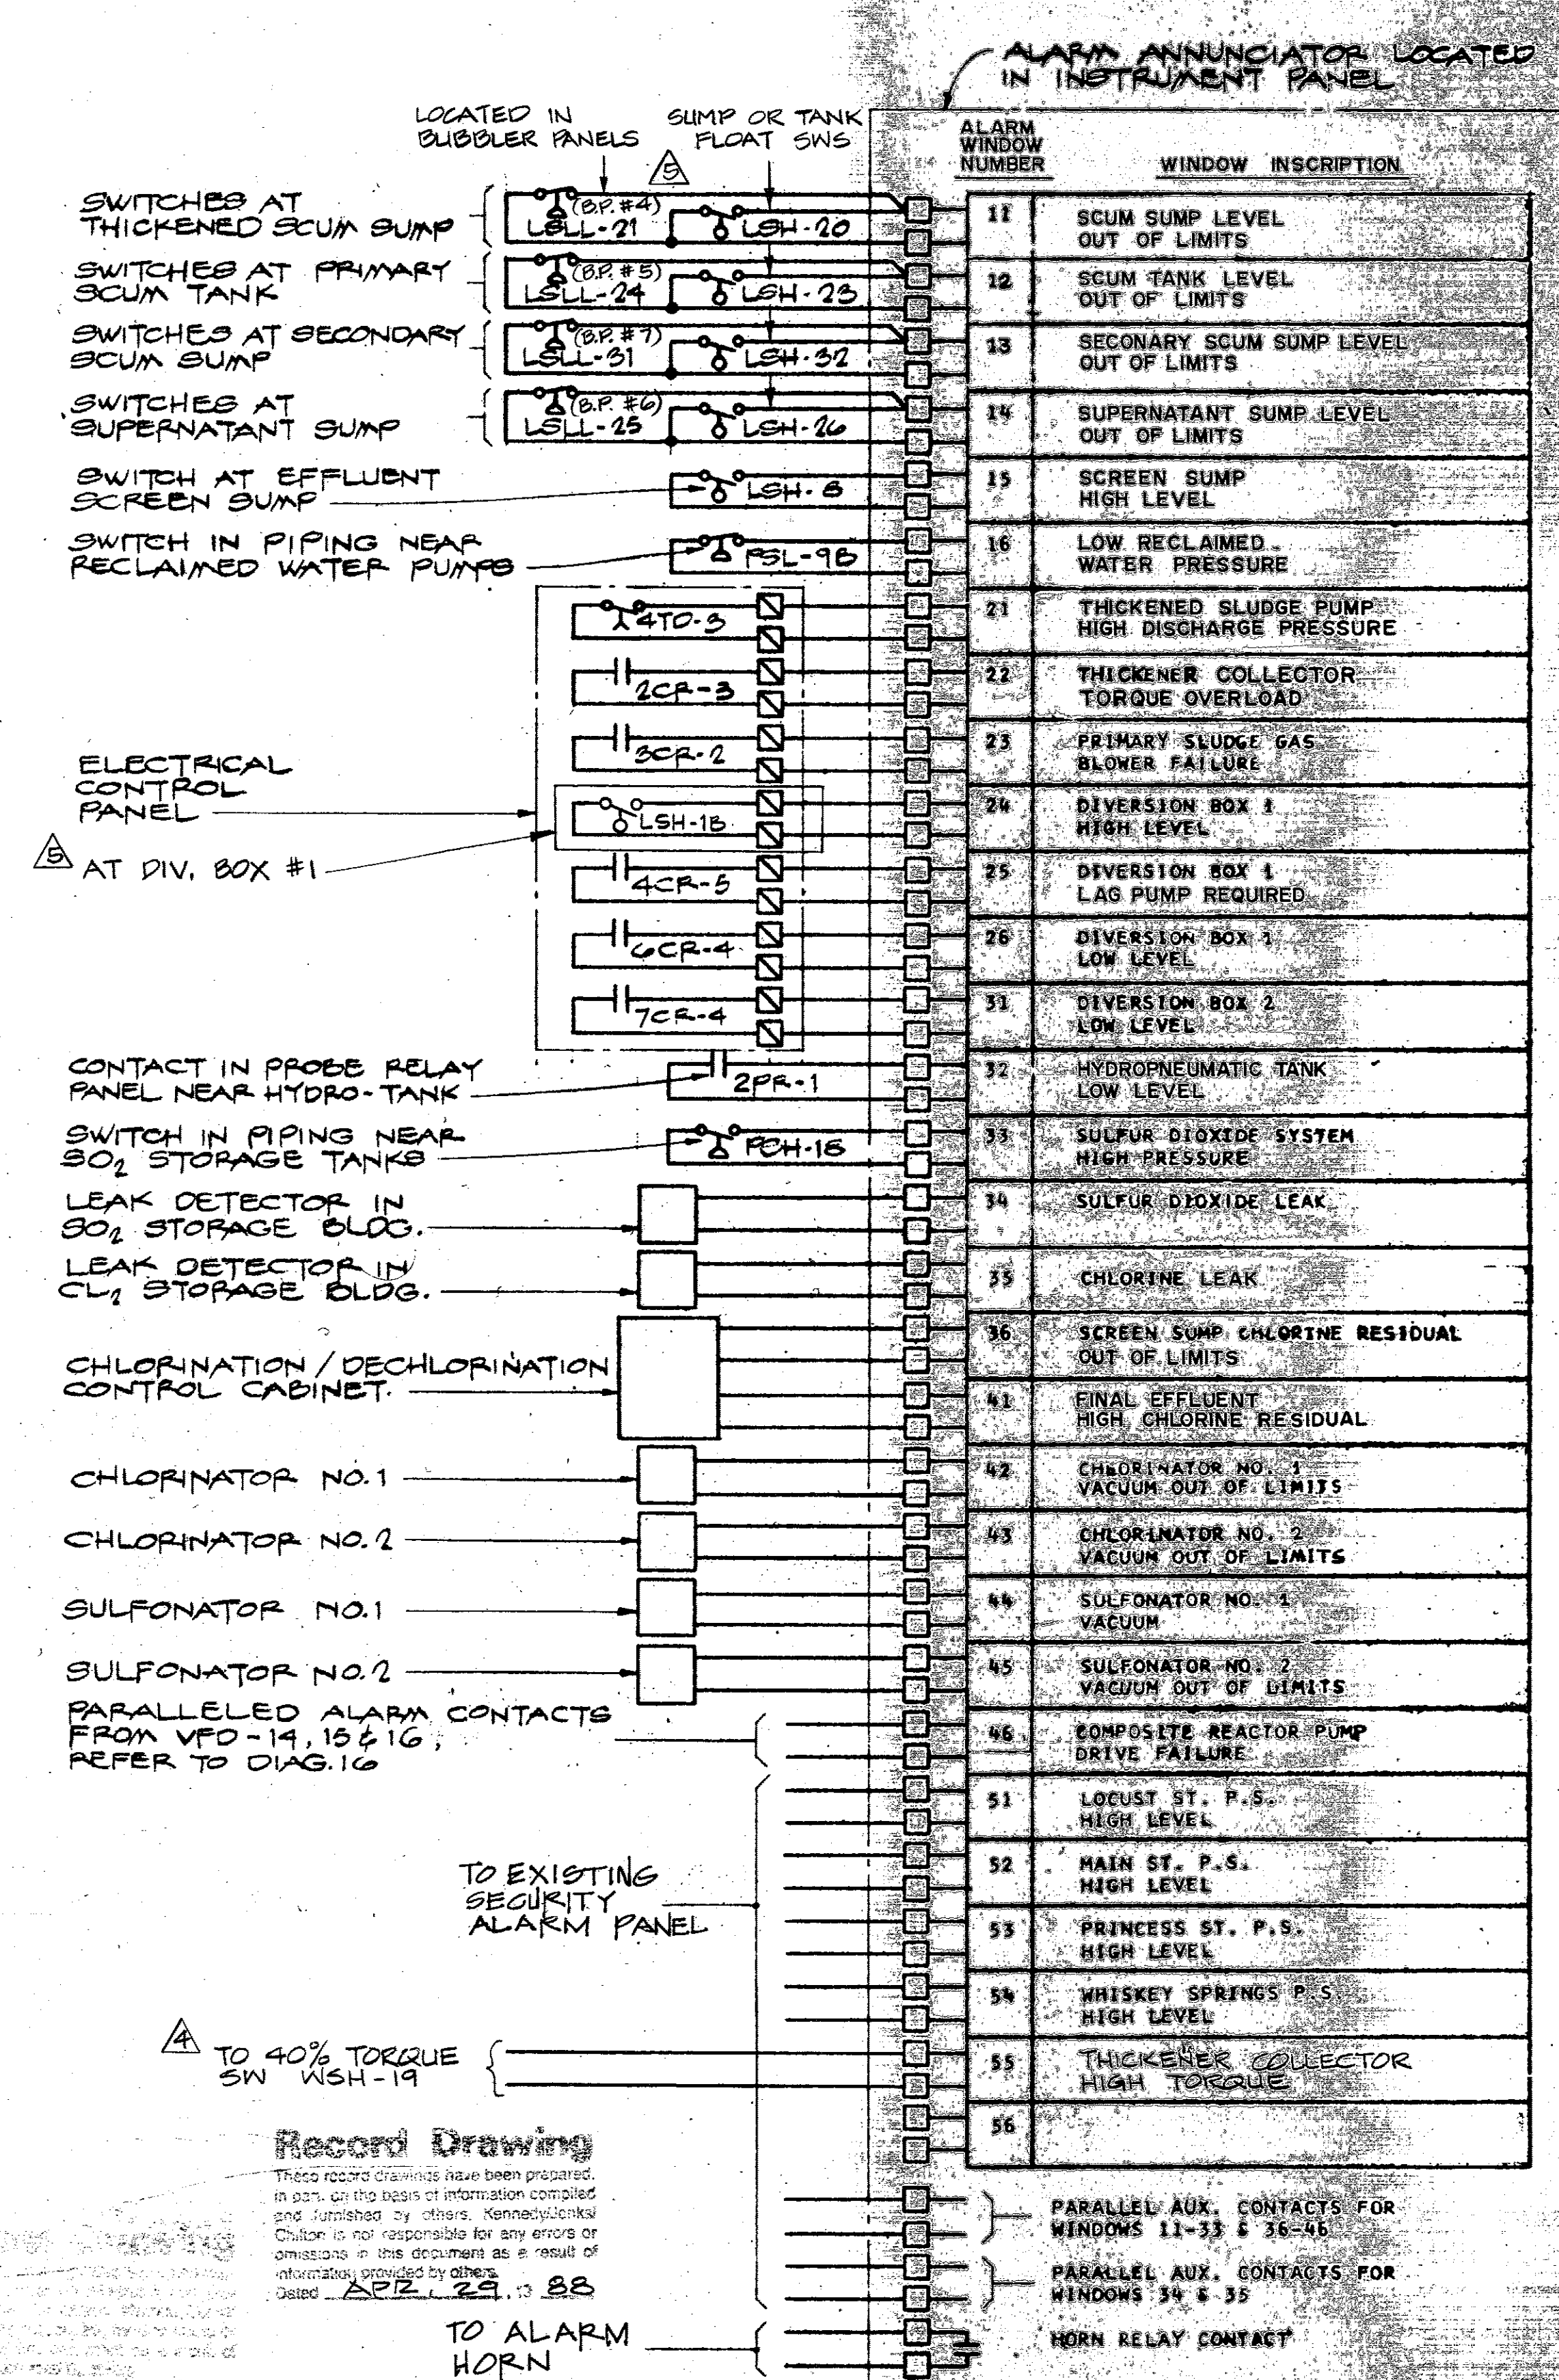

Record Drawing
These record drawings have been prepared, in part, on the basis of information compiled and furnished by others. Kennedy/Jenks & Associates is not responsible for any errors or omissions in this document as a result of information provided by others.
Dated: APR 29, 1988

DIAGRAM 20
ALARM ANNUNCIATOR

CLARIFICATION

Symbol	Description
△	CO NO. 56
△	CO NO. 25
△	FIELD CHANGE
△	FIELD TERMINAL NOS. ADDED

Reference Information and Notes:


- PROVIDE MEANS FOR LOCKING IN THE "OFF" POSITION

Wastewater Plant Improvements C-06-2464
Seasalt - Marin City Sanitary District

Designed: RDS	Drawn: WL	Checked: JWS	Date: 1/29/81
Submitted: <i>Walter J. Hoffman</i>		Approved: <i>J. Paul J. Owen</i>	

ELEMENTARY DIAGRAMS 16-20

Scale: NONE	Job No: 0112
Sheet: E-17	

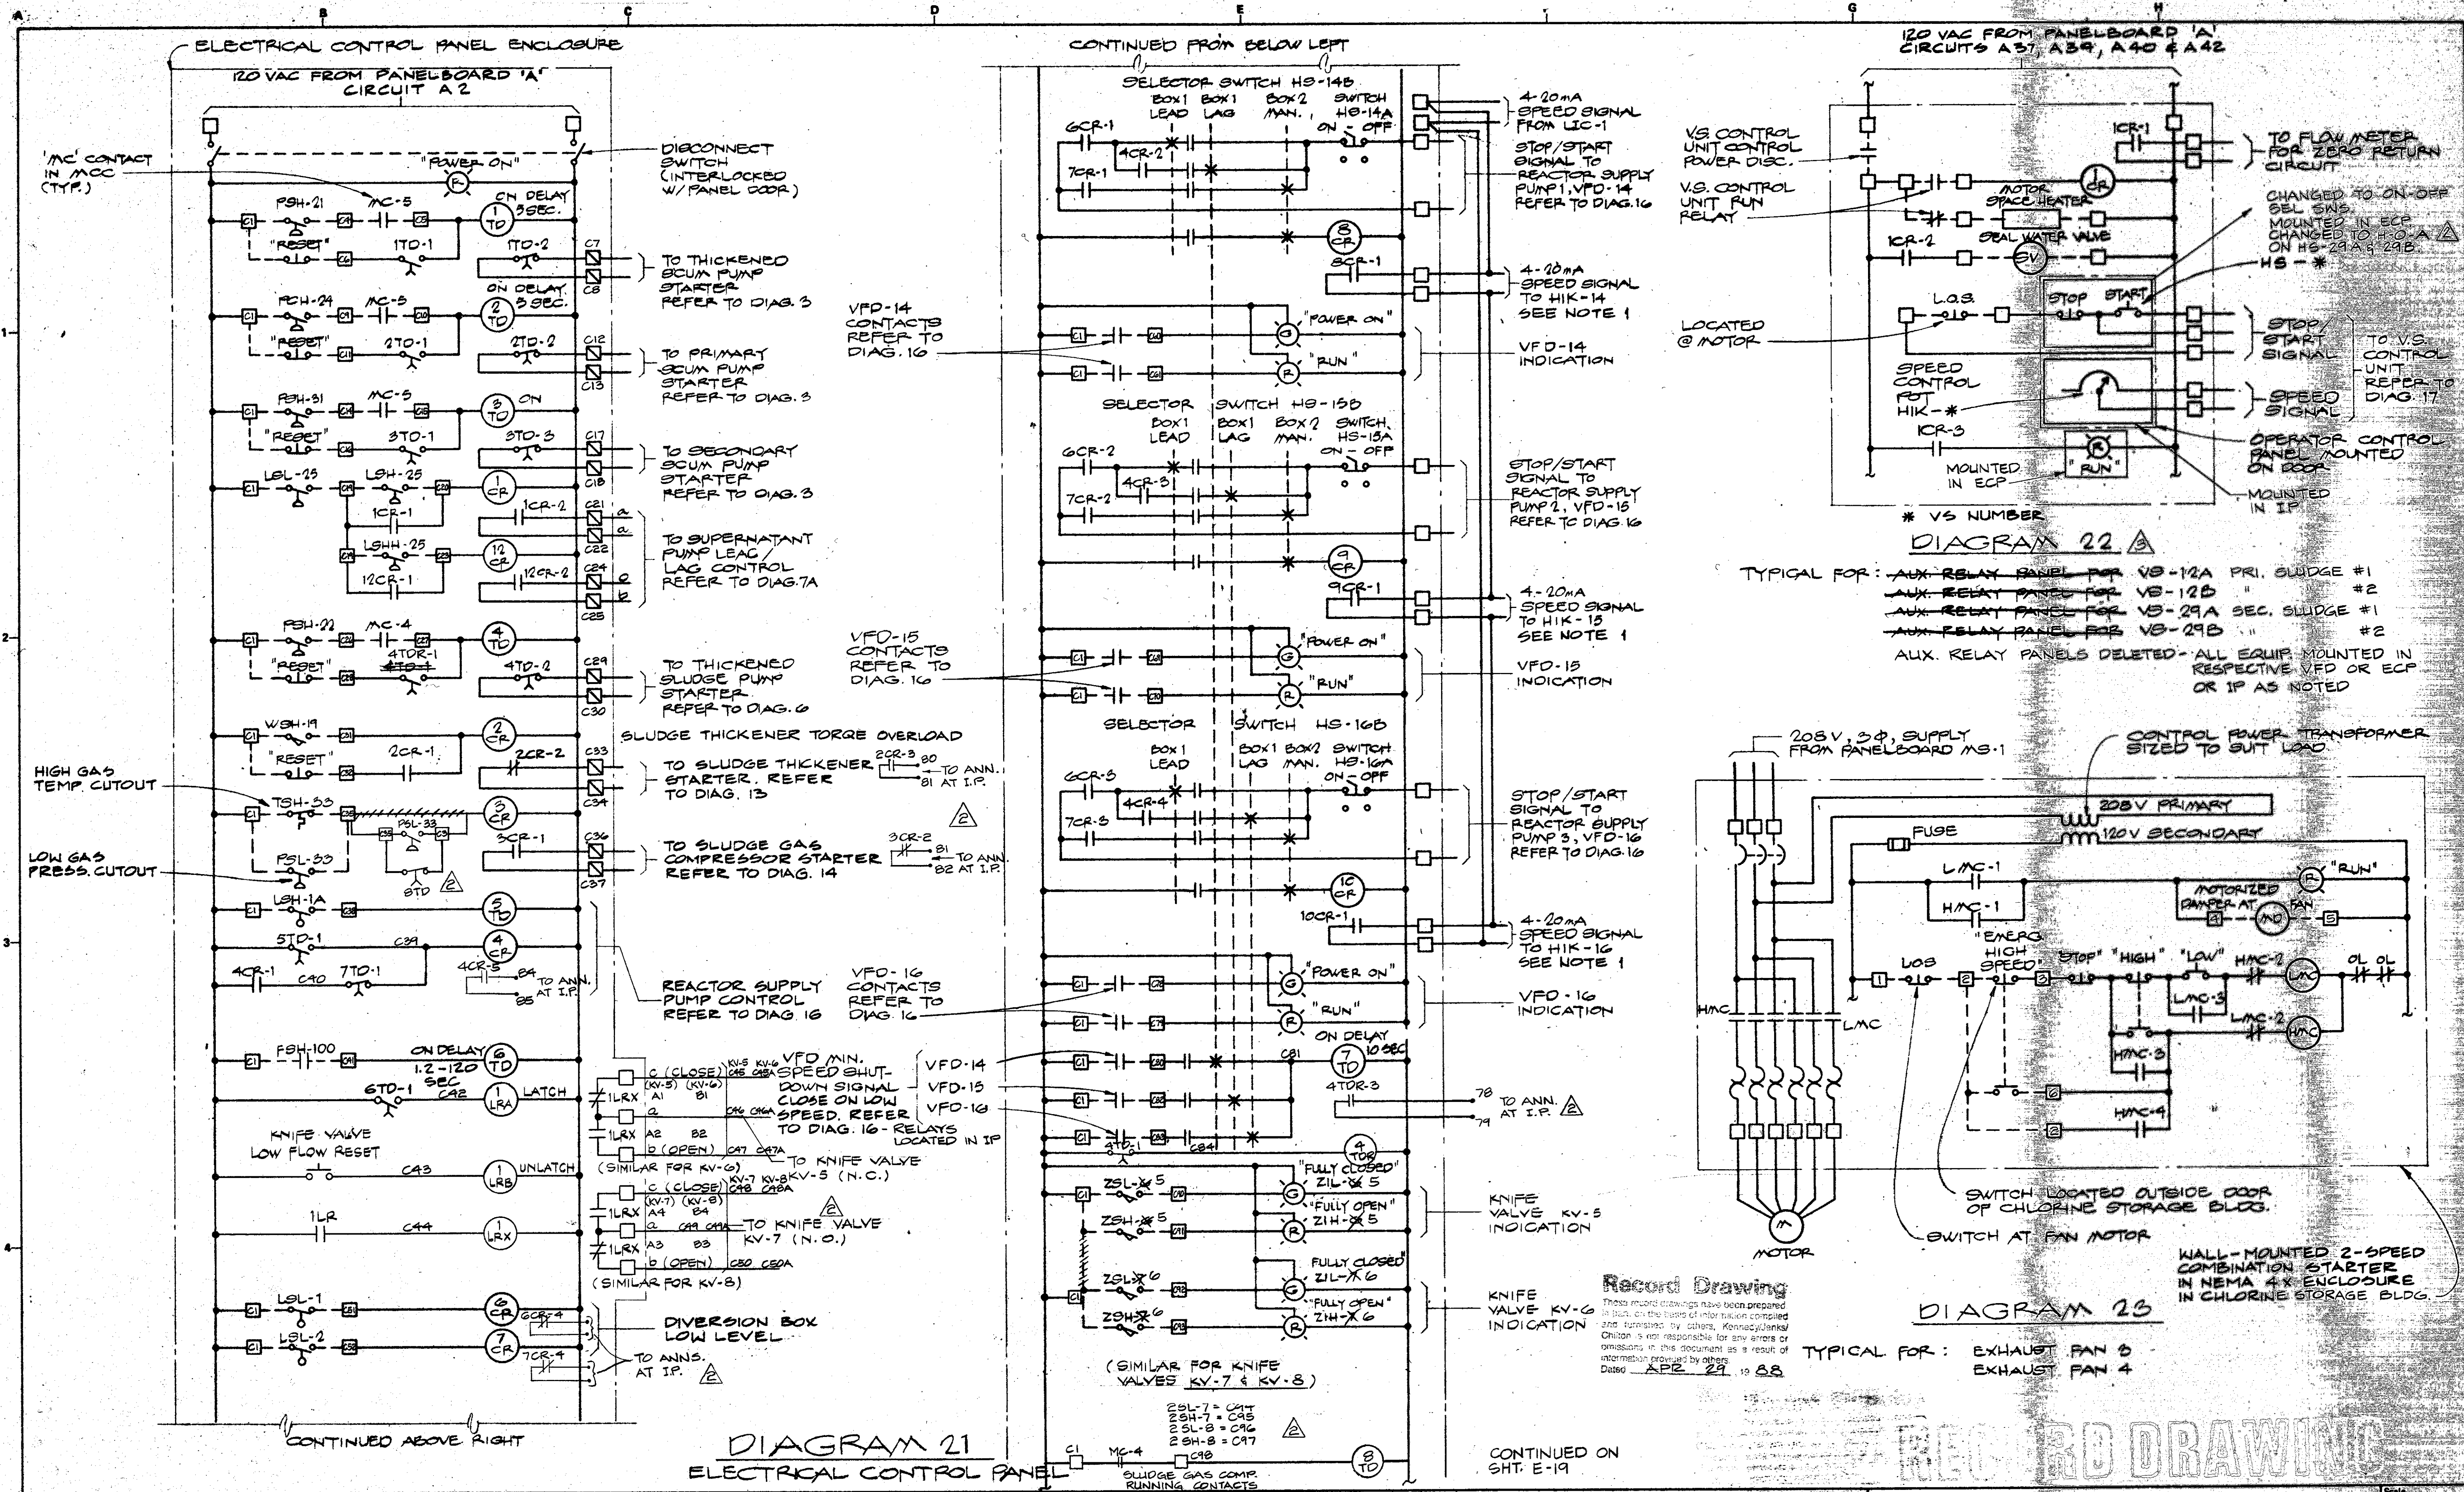

208/120 VOLTS, 3 PHASE, 4 WIRE				225 AMP BUS		80 AMP MAIN CIRCUIT BREAKER				MOUNTING: SURFACE			
CKT. NO.	DESCRIPTION	CONNECTED VOLT-AMPS			TRIP AMPS/ POLES	CKT. NO.	DESCRIPTION	CONNECTED VOLT-AMPS			TRIP AMPS/ POLES		
		A	B	C				A	B	C			
1	LUNCH ROOM REFRIGERATOR	236			15/1	2	AIR HANDLING UNIT	1127			/1		
3	LUNCH ROOM ELECTRIC RANGE		4730		70/2	4	TOILET & SHOWER EXH. FAN		162		15/1		
5	LUNCH ROOM ELECTRIC RANGE			4730		6	CONTROL RM. EXH. FAN			667	15/1		
7	LAB REFRIGERATOR	600			15/1	8	LAB FUME HOOD & EXH. FAN	910			15/1		
9	LAB INCUBATOR		600	Δ	15/1	10	FEED & ANAL. RM. EXH. FAN		230		15/1		
11	AIR COMPRESSOR DRYER Δ			2250	25/1	12	FEED RM. EMERG. EXH. FAN & DAMPER			850	15/1		
13	OPERATOR WRENCH RECEP.TS. Δ	1320			25/1	14	EQUIP. RM. EXH. FAN - EAST	667			15/1		
15	SAMPLE PUMP 3 SPARE Δ		830		15/1	16	EQUIP. RM. EXH. FAN - WEST		667		15/1		
17	SAMPLE PUMP 4 Δ			830	15/1	18	AIR DRYER ROOF LIGHT Δ			120	15/1		
19	SAMPLE PUMP 5 Δ	830			15/1	20	SPARE AIR COMPRESSOR X				15/2		
21	SAMPLE PUMP 6 Δ		830		15/1	22	SPARE Δ				15/2		
23	SPACE				20/1	24	SPACE				1P		
25	SPACE				1P	26	SPACE				1P		
27	SPACE				1P	28	SPACE				1P		
29	SPACE				1P	30	SPACE				1P		
SUBTOTALS		2986	6990	7810				2704	1059	1637			
PHASE TOTALS		A: 5690 B: 8049 C: 9447											
TOTAL VOLT-AMPS		23,186											


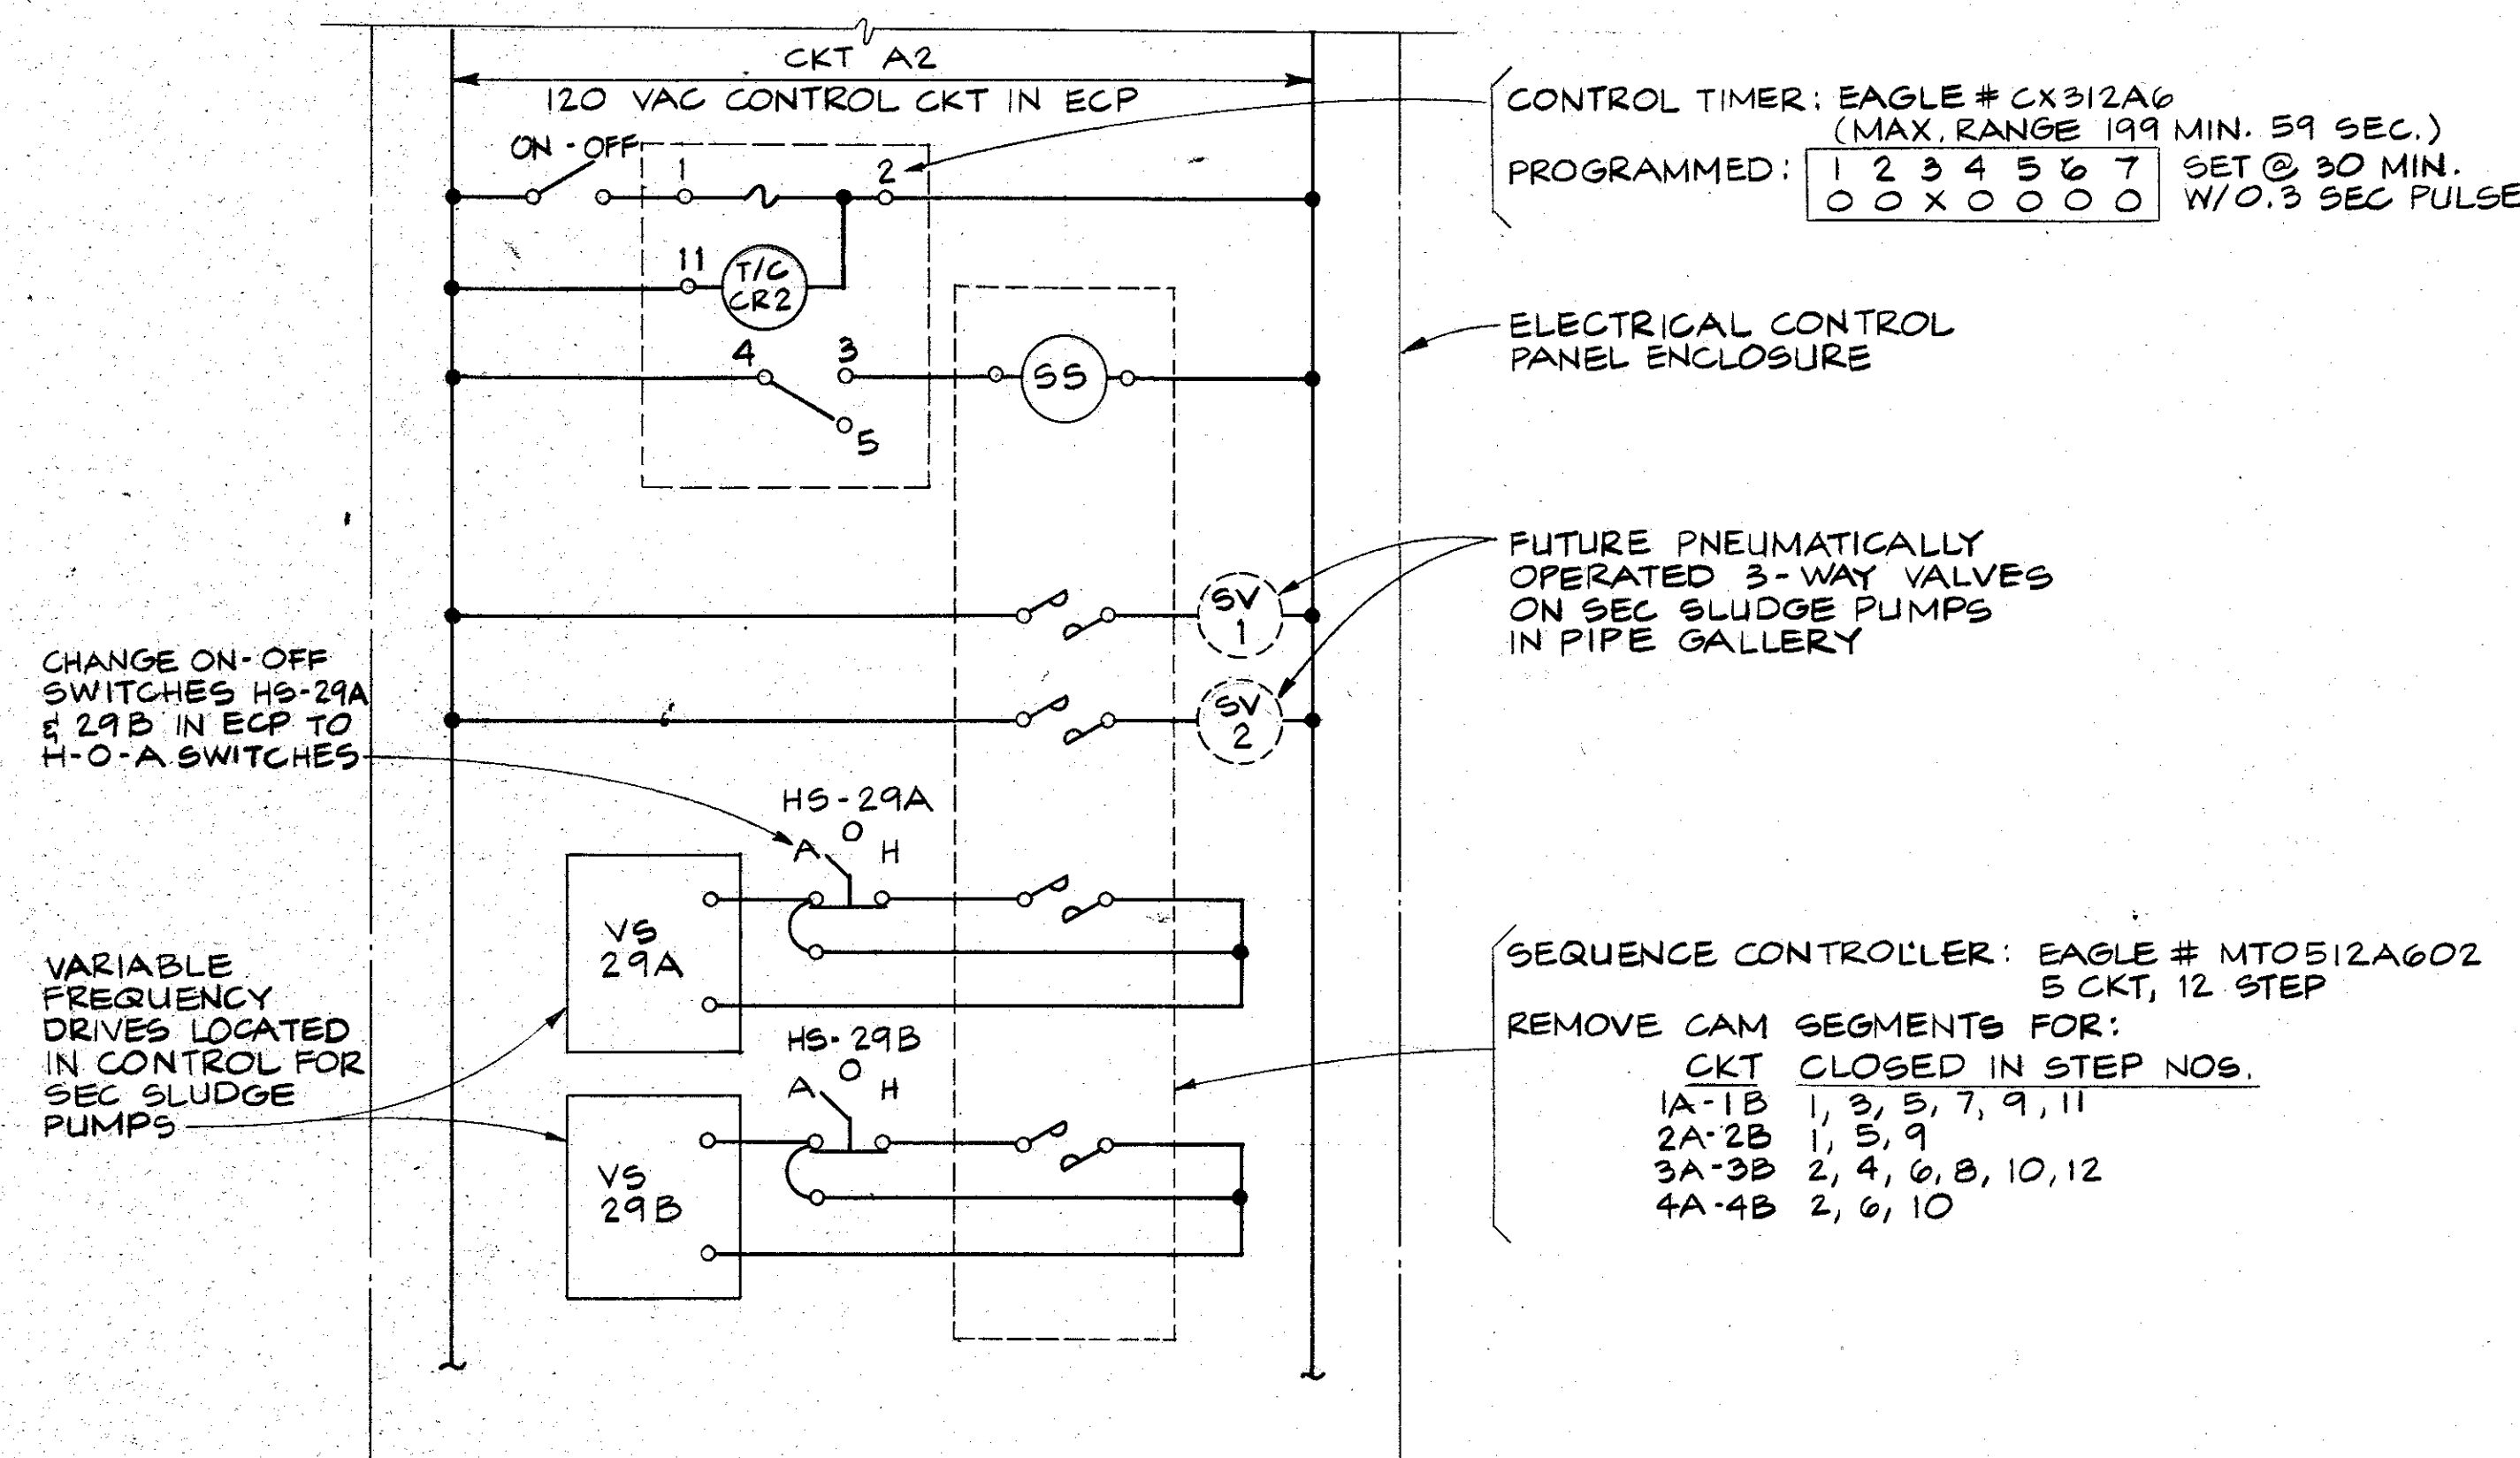


DIAGRAM 21 (CONT.)
SECONDARY SLUDGE PUMP CONTROL

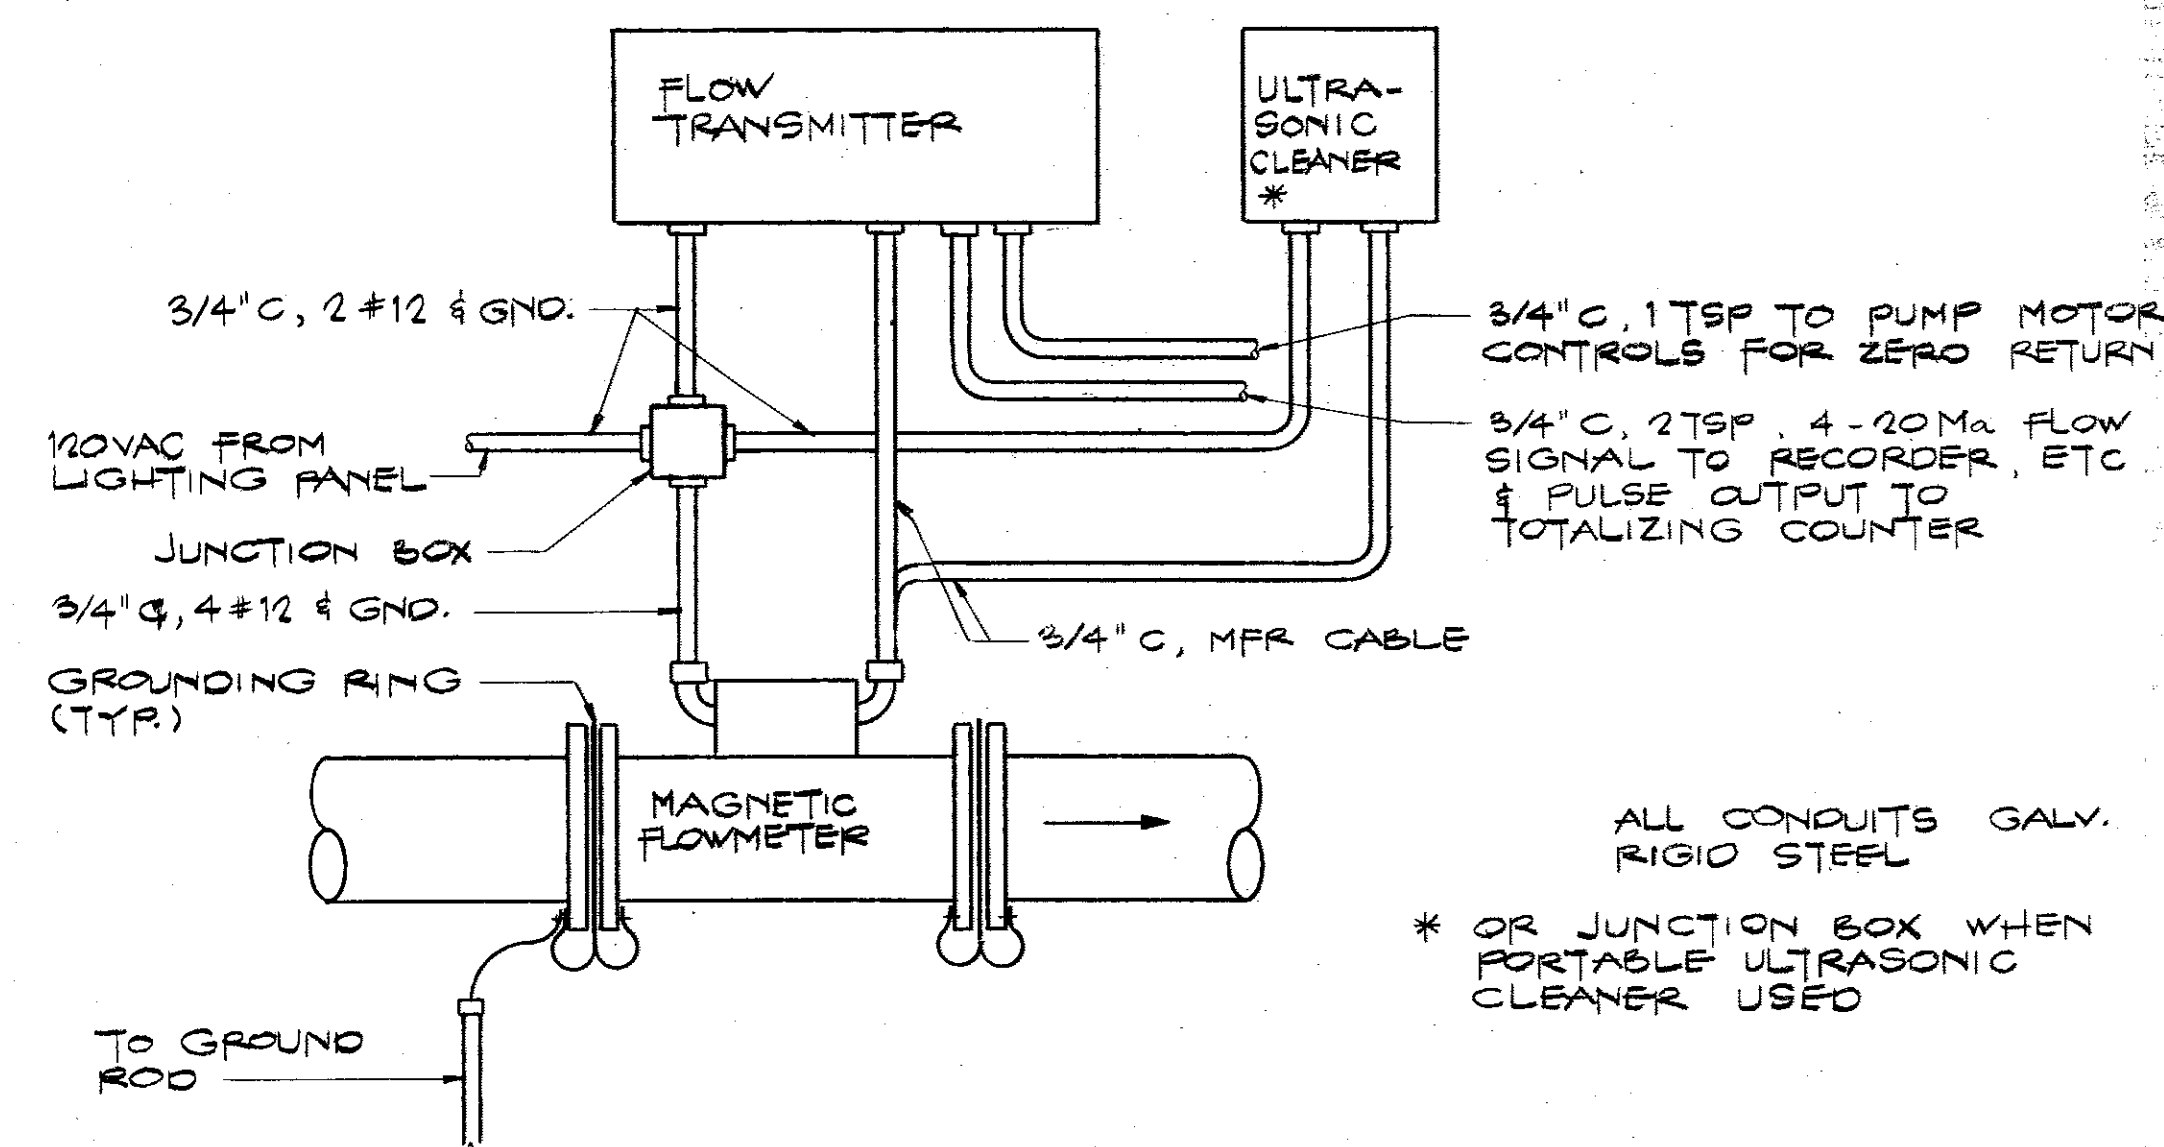


MAGNETIC FLOWMETER CONDUIT & WIRING CONNECTIONS DETAIL

RECORD DRAWING

FIELD CHANGE CO. NO. 57 CLARIFICATION	Reference Information and Notes:			Record Drawing These record drawings have been prepared, in part, on the basis of information compiled and furnished by others. Kennedy/Jenks/Orlison is not responsible for any errors or omissions in this document as a result of information provided by others. Date: APR 29 1988	Designed: JWS Drawn: VD Checked: JWS Date: 1-29-81	Wastewater Plant Improvements Sausalito - Marin City Sanitary District Kennedy/Jenks Engineers Submitted: [Signature] Approved: [Signature]	San Francisco C-06-2464	Scale: NONE Job No.: 0112 Sheet: E-19
	Revised: [] Description: [] Submit: [] App'd: [] Date: []	SCHEDULE & DETAILS						

INSTRUMENT LEGEND				
FIRST LETTER	INITIATING VARIABLE	MODIFIER	SUCCEEDING LETTERS	OUTPUT FUNCTIONS
A	ANALYSIS			ALARM
B	CONDUCTIVITY			CONTROL
C	POTENTIAL (VOLTS)	DIFFERENTIAL		PRIMARY ELEMENT
D	FLOW RATE	RATIO		INDICATE
E	HAND (MANUALLY)			CONTROL STATION
F	POWER			LIGHT (PILOT)
G	TIME/TIME SCHEDULE			
H	LEVEL			
I	STATUS			
J	PRESSURE			
K	QUANTITY	INTEGRATE/TOTAL		
L	SPEED/FREQUENCY			RECORD/PRINT/RECEIVE
M	TEMPERATURE			SWITCH
N	WEIGHT/FORCE/TORQUE			TRANSMIT
O	TELEMETRY			VALVE
P	SIGNAL			ISOLATE
Q	POSITION			RELAY/COMPUTE
R				DRIVE/ACTUATE
S				
T				
U				
V				
W				
X				
Y				
Z				

INSTRUMENT TAG NUMBERS

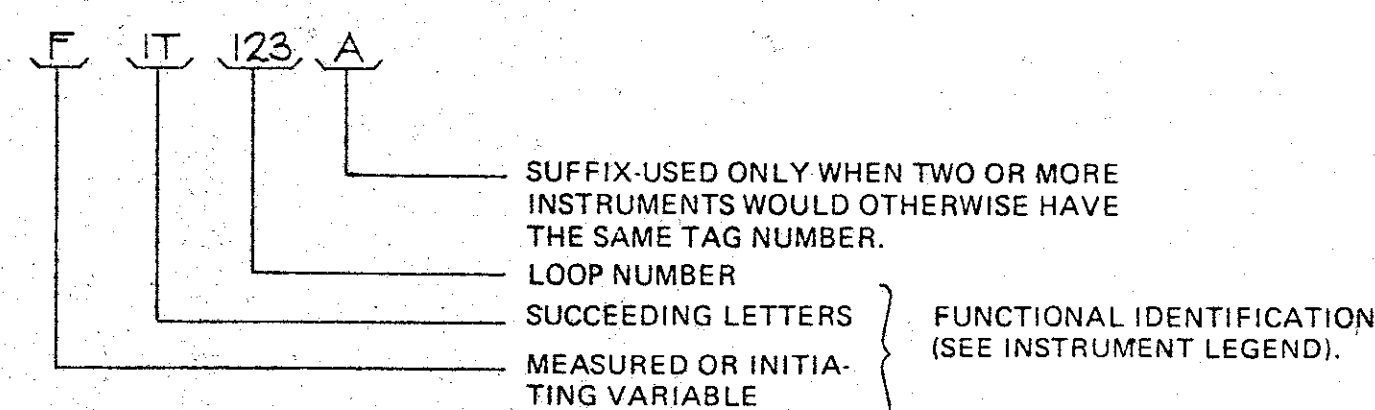

SYMBOLS FOR INSTRUMENTS

GRAPHIC SYMBOL	DESCRIPTION
	INSTRUMENT (SCHEMATIC DIAGRAMS)
	INSTRUMENT MOUNTED IN PROCESS FLOW LINE
	INSTRUMENT MOUNTED ON FACE OF PANEL 12A
	INSTRUMENT MOUNTED BEHIND PANEL 12A
	MULTI-FUNCTION INSTRUMENT

FUNCTION DESIGNATION FOR HARDWIRED RELAYS AND CONTROLLERS

SYMBOL	FUNCTION
Σ	ADD OR TOTALIZE (ADD AND SUBTRACT)
Δ	SUBTRACT
$\pm, +, -$	BIAS
AVG	AVERAGE
$\times$	MULTIPLY
$\div$	DIVIDE
$\sqrt{\quad}$	EXTRACT SQUARE ROOT
$\times^n$	RAISE TO POWER
$f(x)$	CHARACTERIZE
$ H $	BOOST AND ISOLATE
$\square$	HIGHEST VALUE SELECTION
$\square$	LOWEST VALUE SELECTION
REV	REVERSE
E/P, P/I (TYPICAL)	FOR INPUT/OUTPUT CONVERTERS USING THE FOLLOWING SIGNALS:
E	VOLTS
H	HYDRAULIC
I	CURRENT
P	PNEUMATIC
R	RESISTANCE
A	ANALOG
D	DIGITAL

P	PROPORTIONAL CONTROL ACTION
I	INTEGRAL CONTROL ACTION
O	ON/OFF CONTROL ACTION
Δ I-O	ON/OFF CONTROL ACTION WITH DIFFERENTIAL GAP
T/H	TRACK AND HOLD

SYMBOLS FOR PRIMARY SENSING ELEMENTS

SYMBOL	DESCRIPTION
	VENTURI TUBE OR FLOW NOZZLE
	FLUME
	WEIR
	TURBINE OR PROPELLER-TYPE
	ORIFICE PLATE
	UNCLASSIFIED PRIMARY FLOW ELEMENT WITH INTEGRAL TRANSMITTER (e.g. MAGNETIC TARGET OR MASS FLOW METERS).

INSTRUMENT LINE SYMBOLS

SYMBOL	DESCRIPTION
	PROCESS FLOW LINE
	PNEUMATIC SIGNAL
	ELECTRICAL SIGNAL (ANALOG)
	ELECTRICAL SIGNAL (DISCRETE)
	HYDRAULIC SIGNAL
	CONNECTOR
	MECHANICAL CONNECTION OR LINKAGE
A _g	AIR SUPPLY
E ₅	ELECTRICAL SUPPLY (120 VAC)
E ₂₄	ELECTRICAL SUPPLY (24 VDC)
	Lines CROSSING (NO CONNECTION)
	Lines JOINING
	DIRECTION OF FLOW

SYMBOLS FOR CONTROL VALVE ACTUATORS

SYMBOL	DESCRIPTION
	DIAPHRAGM, SPRING-OPERATED
	CYLINDER, SINGLE-ACTING
	CYLINDER, DOUBLE-ACTING
	HAND ACTUATOR
	ELECTRO-HYDRAULIC ACTUATOR
	SOLENOID
	MOTOR

MISCELLANEOUS DEVICES

SYMBOL	DESCRIPTION
	VARIABLE SPEED PUMP
	PURGE DEVICE
	RUPTURE DISC FOR PRESSURE RELIEF
	THERMOMETER WELL
	SPECIAL RECEPTACLE

FUNCTION DESIGNATION AND ABBREVIATIONS

PCP	PROCESS CONTROL PANEL
MCC	MOTOR CONTROL CENTER
MCP	MAIN CONTROL PANEL
CP	CONTROL PANEL
CS	CONTROL STATION
SP	SET POINT
GP	GRAPHIC PANEL
ECP	ELECTRICAL CONTROL PANEL
	GENERALIZED SYMBOL FOR INTERLOCK LOGIC PROVIDED BY ELECTRICAL NUMBER IS AN ELEMENTARY DIAGRAM NUMBER SHOWN ON THE ELECTRICAL DRAWINGS.
ARP	AUX. RELAY PANEL
IP	INSTRUMENT PANEL
AA	ALARM ANNUNCIATOR
HOA	HAND-OFF-AUTO

NOTES


FOR SPECIFIC INSTRUMENT DESIGNATIONS, REFER TO GENERAL INSTRUMENT SCHEDULE IN SPECIFICATION SECTION 17000.

FOR INSTRUMENT TYPES AND CALIBRATION, REFER TO INDIVIDUAL INSTRUMENT SCHEDULES AT REAR OF SPECIFIC INSTRUMENT SPECIFICATION SECTION.


Record Drawing
This record drawing has been prepared in accordance with the requirements of the San Francisco Public Utilities Commission and is not to be used for any other purpose without the written consent of the San Francisco Public Utilities Commission.

INSTRUMENT SYMBOLS AND IDENTIFICATION


Reference Information and Notes: FOR CONTROL VALVE SYMBOLS SEE MECHANICAL DRAWINGS				Designed: JCN Drawn: PG Checked: WJS Date: 1/20/81		Wastewater Plant Improvements C-06-2464 Sausalito - Marin City Sanitary District Kennedy/Jenks Engineers Submitted: 1/20/81 Approved: [Signature] C9370		San Francisco Scale: NONE Job No.: 0112 Sheet: I-1	
Revised	Description	Submit	Appr'd	Date	Refer to Tracing for Latest Revision				

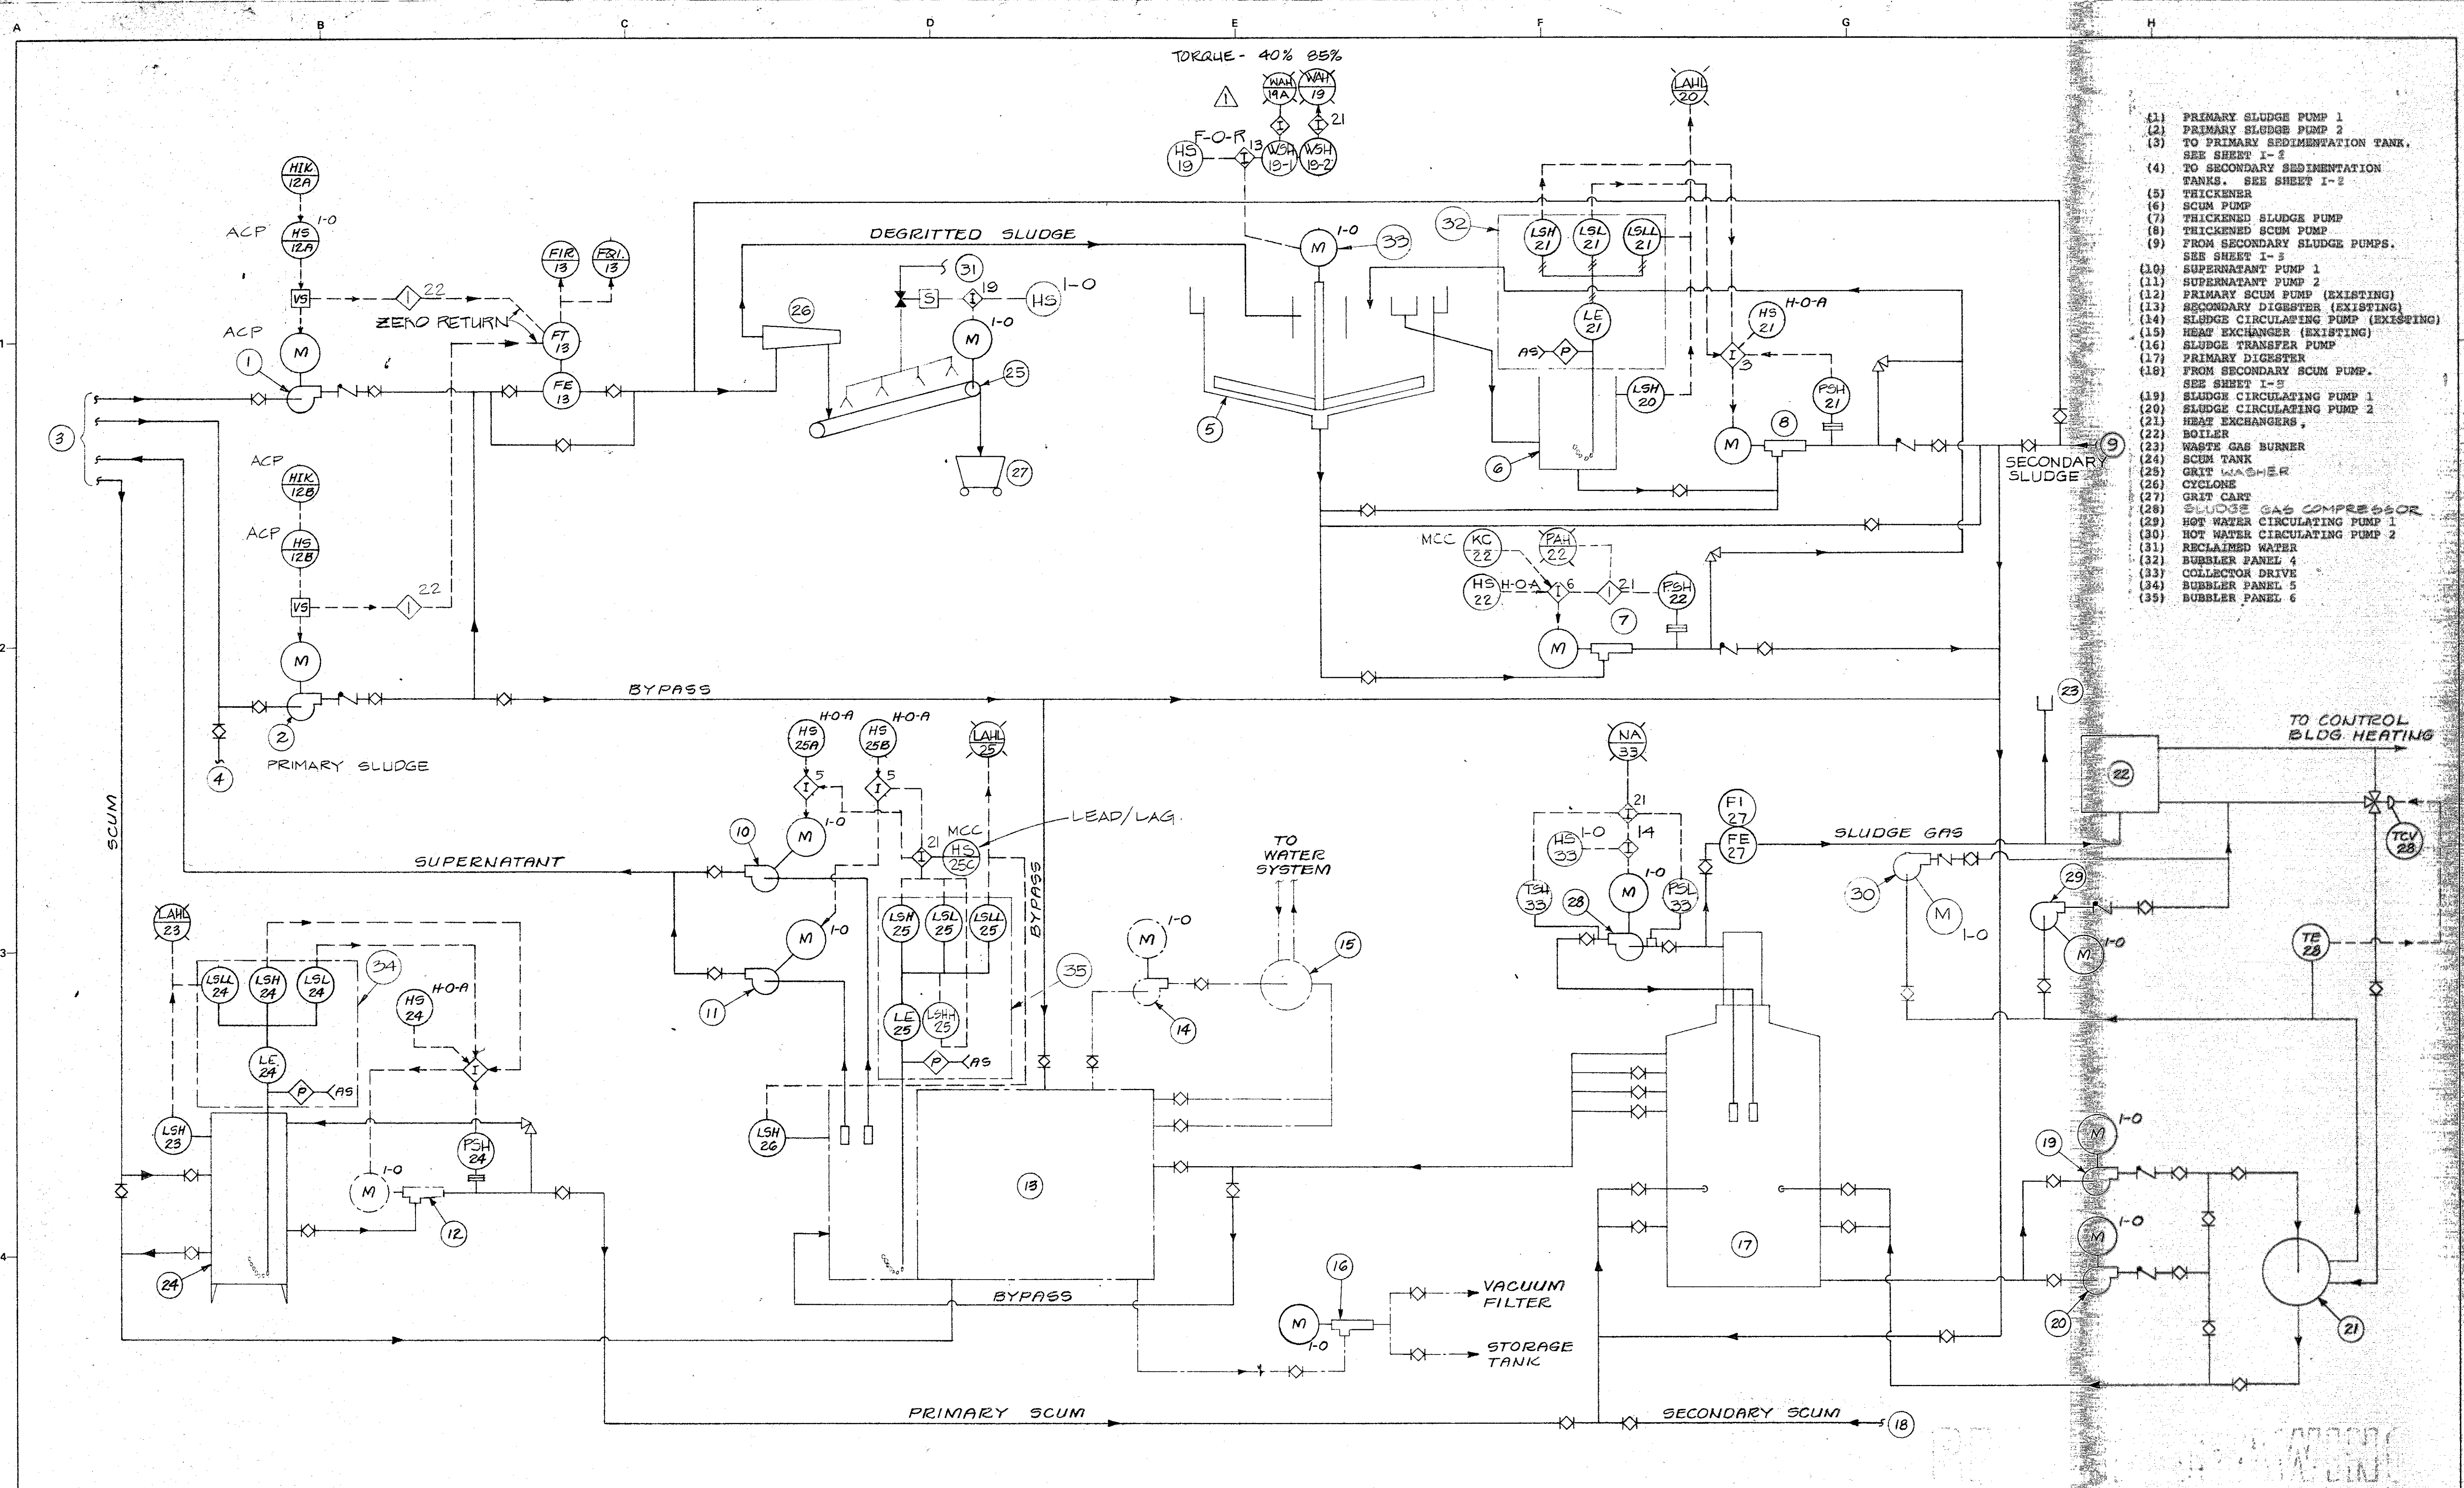

CO NO. 56 Revised _____ Description _____ Submit _____ App'd _____ Date _____ Refer to Tracing for Latest Revision		Reference Information and Notes: Record Drawing These record drawings have been prepared, in part, on the basis of information compiled and furnished by others. Kennedy/Jenks & Associates is not responsible for any errors or omissions in this document as a result of information provided by others. Dated <u>APR 29, 1988</u>		Designed <u>RDS/JN</u> Drawn <u>AM</u> Checked <u>JWS</u> Date <u>1/29/81</u>		Wastewater Plant Improvements C-06-2464 Sausalito - Marin City Sanitary District Kennedy/Jenks Engineers Submitted: <u>Walter E. Hamman</u> C9370 Approved: <u>[Signature]</u>		PROCESS & INSTRUMENTATION DIAGRAM 3 Scale: NONE Job No.: 0112 Sheet: I-4	
---	--	--	--	--	--	--	--	---	--

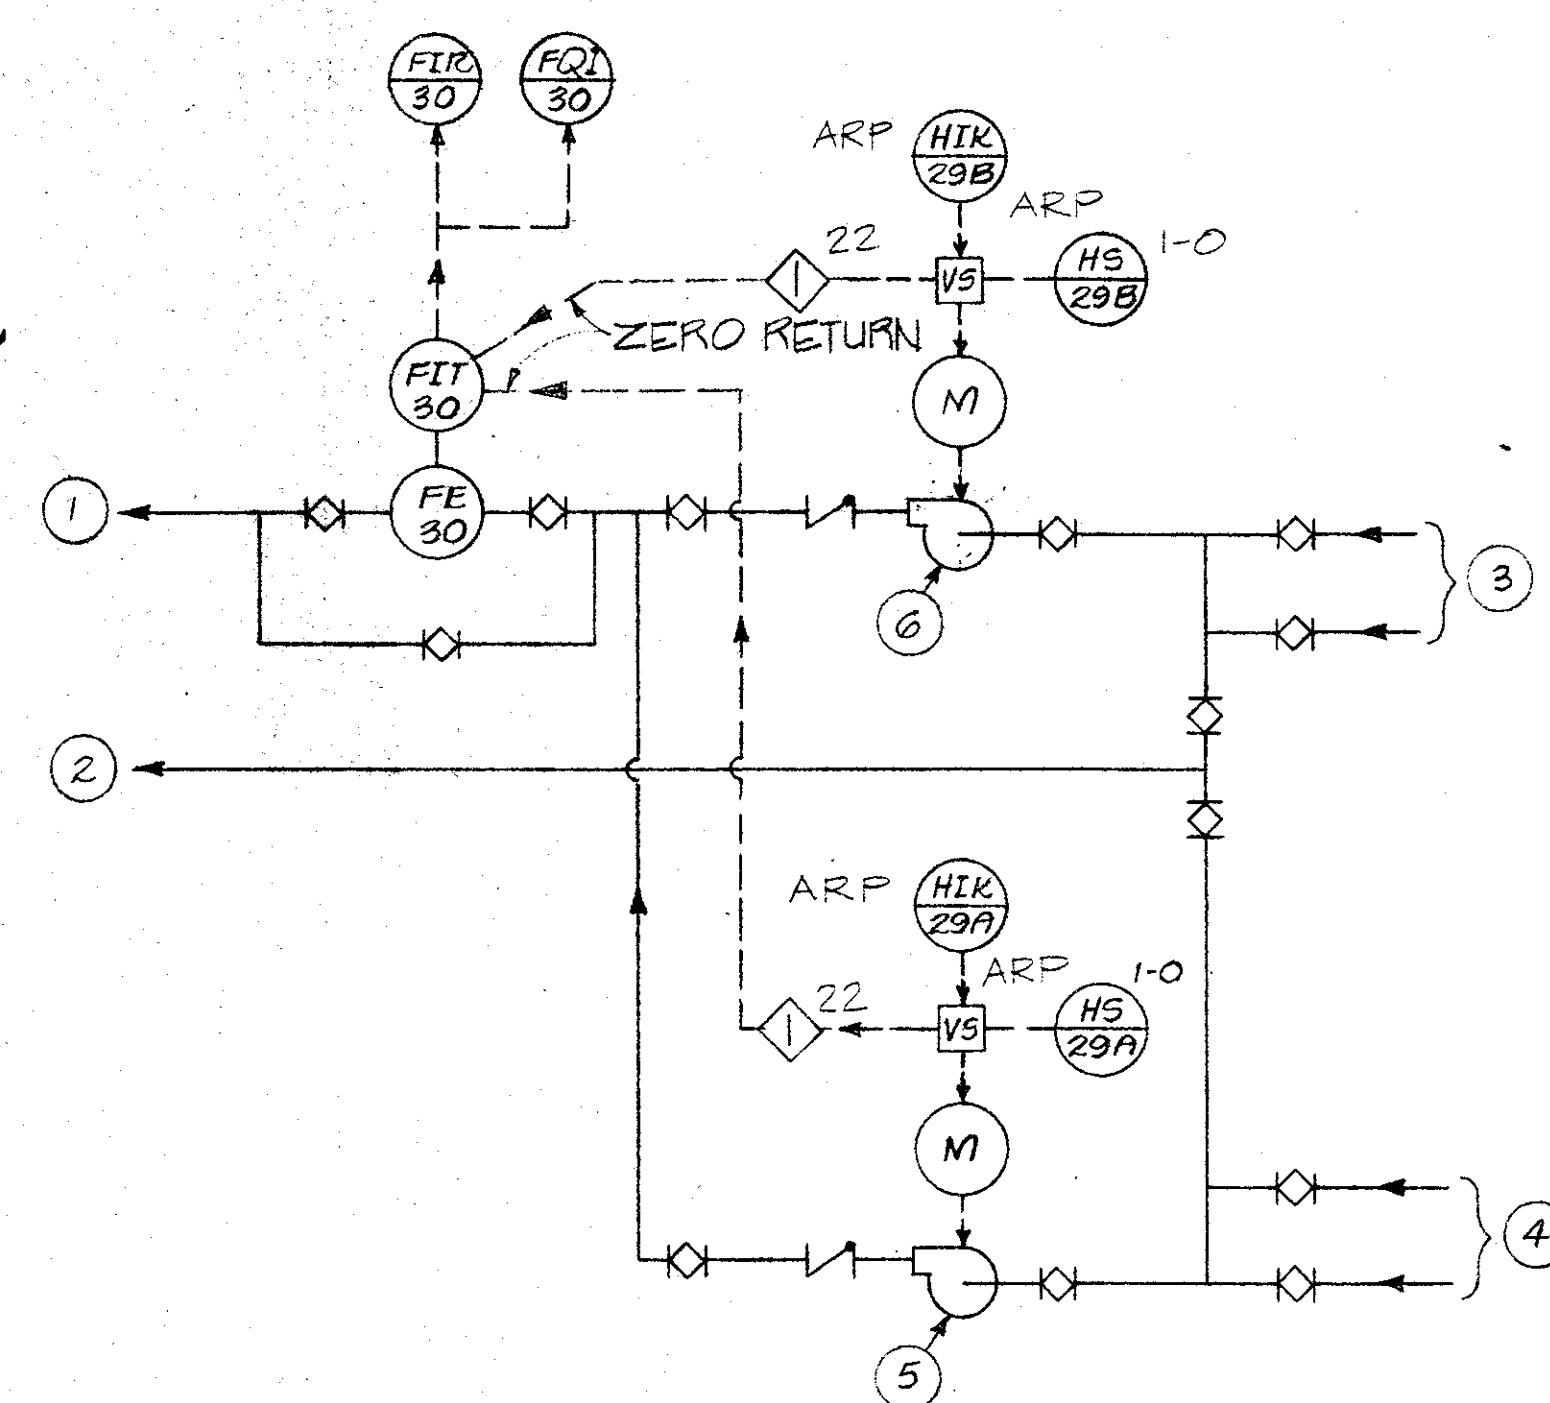

SECONDARY SLUDGE SYSTEM

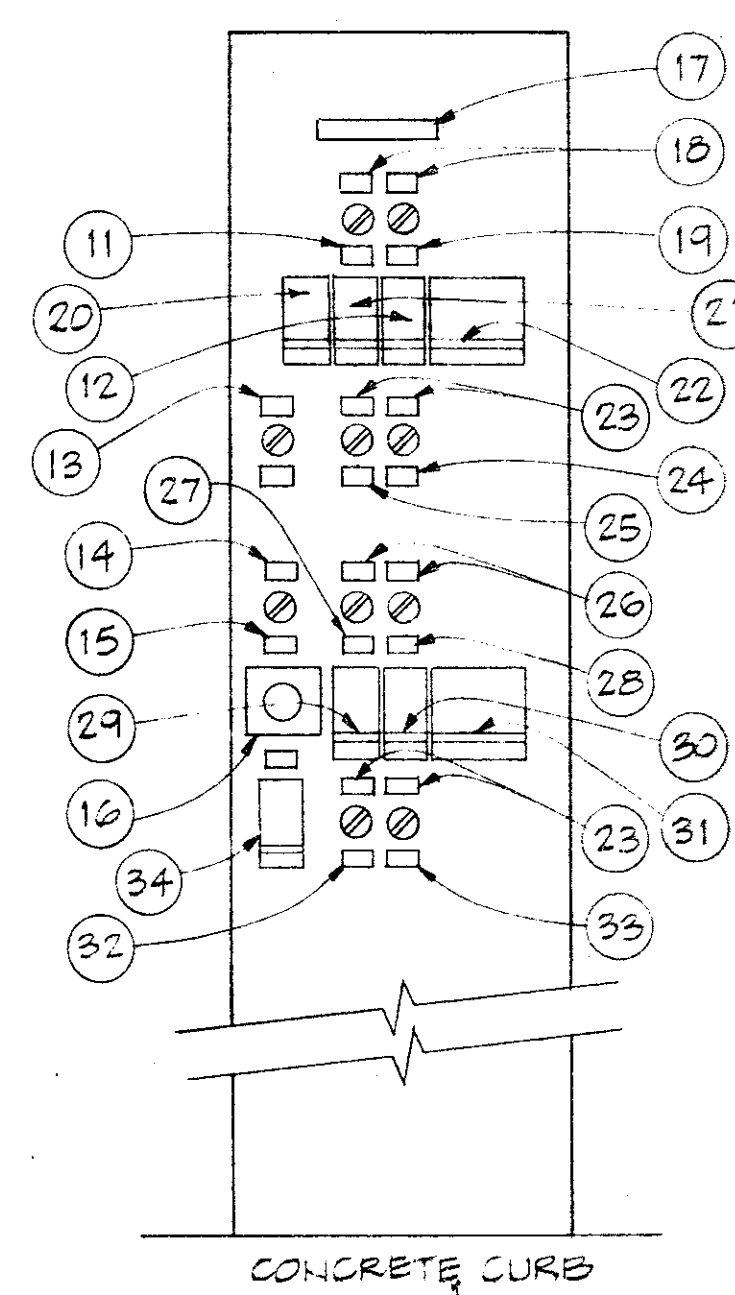


CHLORINATION/DECHLORINATION
CONTROL PANEL
FRONT ELEVATION
SCALE: NONE

- (1) TO CYCLONE, SEE SHEET 1-4
- (2) TO PRIMARY SLUDGE PUMP 2, SEE SHEET 1-4
- (3) TO SECONDARY SEDIMENTATION TANK 2, SEE SHEET 1-2
- (4) TO SECONDARY SEDIMENTATION TANK 1, SEE SHEET 1-2
- (5) SECONDARY SLUDGE PUMP 1
- (6) SECONDARY SLUDGE PUMP 2
- (7) SECONDARY SCUM PUMP
- (8) SECONDARY SCUM PUMP
- (9) TO PRIMARY DIGESTER, SEE SHEET 1-4
- (10) BUBBLER PANEL 7
- (11) CHLORINATOR 1
- (12) CHLORINE RESIDUAL CONTROLLER AIC 17
- (13) ANALYZER 1 - ANALYZER 2
- (14) AUTO-OFF PRE-DECHLORINATION POST-DECHLORINATION
- (15) DECHLORINATION CONTROL SELECTOR
- (16) DECHLORINATION REPEAT CYCLE TIMER KIC 18
- (17) CHLORINATION/DECHLORINATION CONTROL PANEL
- (18) LEAD-LAG
- (19) CHLORINATOR 2
- (20) CHLORINATOR 1 DOSAGE
- (21) CHLORINATOR 2 DOSAGE
- (22) PRE-DECHLORINATION CHLORINE RESIDUAL RECORDER AIR 17
- (23) OFF-ON
- (24) CHLORINATOR 2 ABNORMAL VACUUM ALARM BYPASS
- (25) CHLORINATOR 1 ABNORMAL VACUUM ALARM BYPASS
- (26) LEAD-LAG
- (27) SULFATOR 1
- (28) SULFATOR 2
- (29) SULFATOR 1 DOSAGE
- (30) SULFATOR 2 DOSAGE
- (31) PRE/POST DECHLORINATION CHLORINE
- (32) SULFATOR 1 ABNORMAL VACUUM ALARM BYPASS
- (33) SULFATOR 2 ABNORMAL VACUUM ALARM BYPASS

(34) SULFATOR CONTROL RATIO ADJUST
APY-12


* CONTROLLER MODULE REMOVED IN FIELD
TERMINAL CAN REMAINS. ⚠

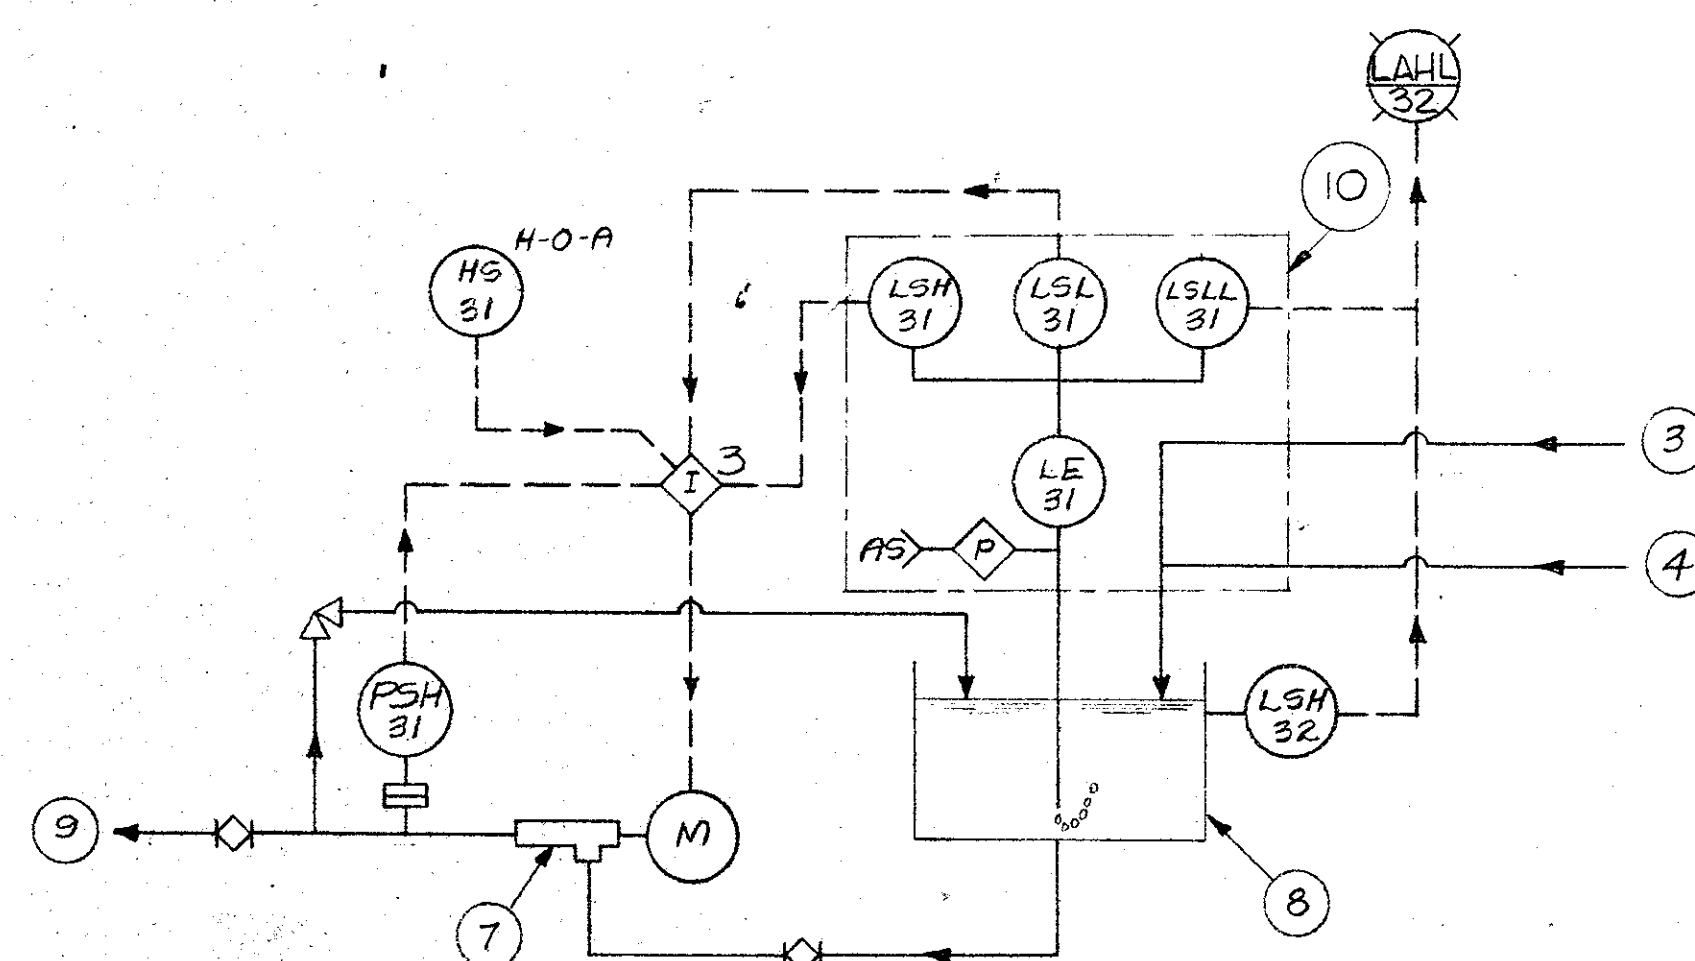

SECONDARY SCUM SYSTEM

FIELD CHANGE Revised _____ Description _____ Submit _____ App'd _____ Date _____ Refer to Tracing for Latest Revision		Reference Information and Notes: Record Drawing These record drawings have been prepared, in part, on the basis of information compiled and furnished by others. Kennedy/Jenks/Chilton is not responsible for any errors or omissions in this document as a result of information provided by others. Dated <u>APR 21 1981</u> by <u>BE</u>		Designed <u>RDE/JIN</u> Drawn <u>AM</u> Checked <u>JWS</u> Date <u>1/29/81</u>		Wastewater Plant Improvements C-06-2464 Sausalito - Marin City Sanitary District Kennedy/Jenks Engineers San Francisco Submitted: <u>Walter F. Johnson</u> 08370 Approved: <u>Robert J. Owens</u>		Scale <u>NONE</u> Job No. <u>0112</u> Sheet <u>I-5</u> of _____	
--	--	---	--	---	--	--	--	--	--

PROCESS 8 INSTRUMENTATION
DIAGRAM 4

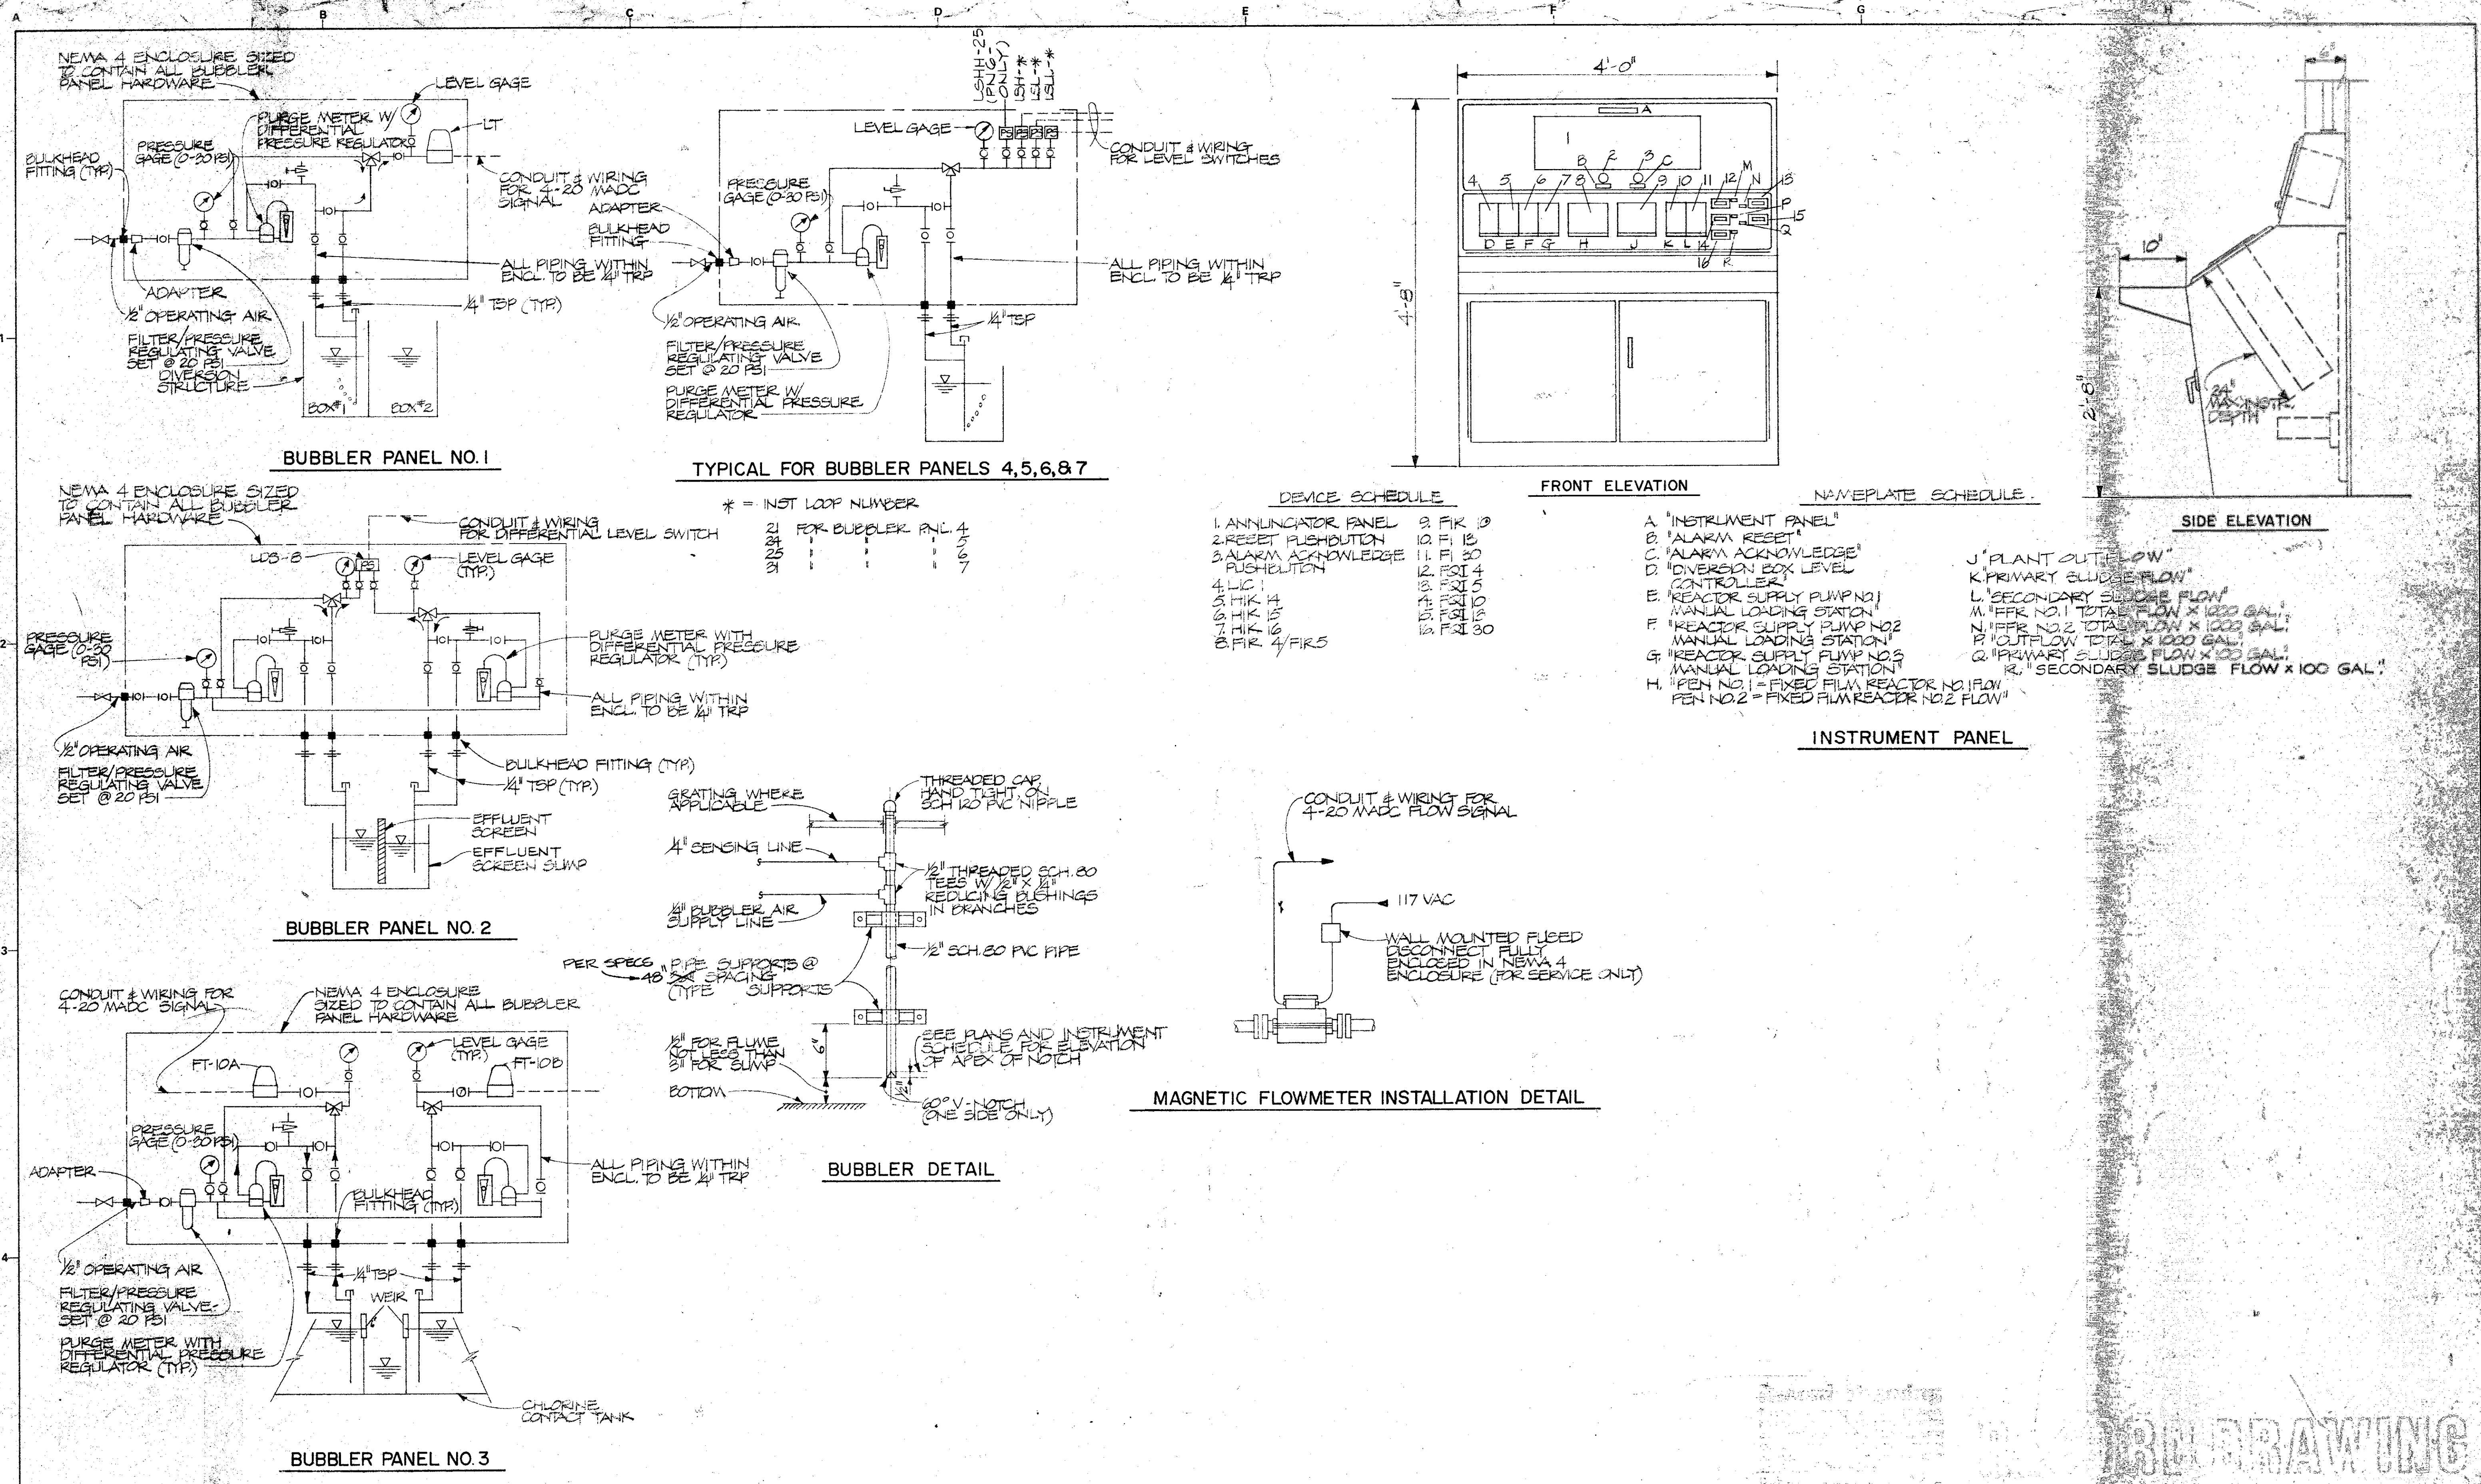

Reference Information and Notes:				Designed RDC/JN		Wastewater Plant Improvements C-06-2464		Scale NONE	
Drawn AYS				Checked JWS		Sausalito - Marin City Sanitary District		Job No. -0112	
Date 1/29/31				Submitted Walter J. Gorman		San Francisco		Sheet I-6	
Revised				Description		Submit		Appr'd	
Date				Refer to Training for Latest Revision					

Record Drawing

These record drawings have been prepared, in part, on the basis of information submitted and furnished by others. Kennedy/Jenks Engineers is not responsible for any errors or omissions in this document as a result of information provided by others.

Dated APR 24 1931

Kennedy/Jenks Engineers

Submitted: Walter J. Gorman © 9370

Approved: K. J. Gorman

PANEL LAYOUT & DETAILS