
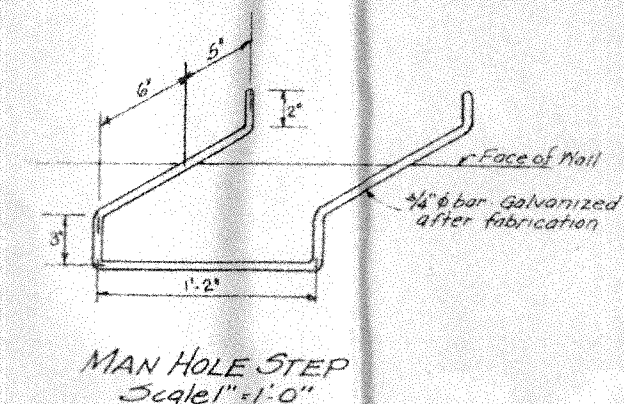
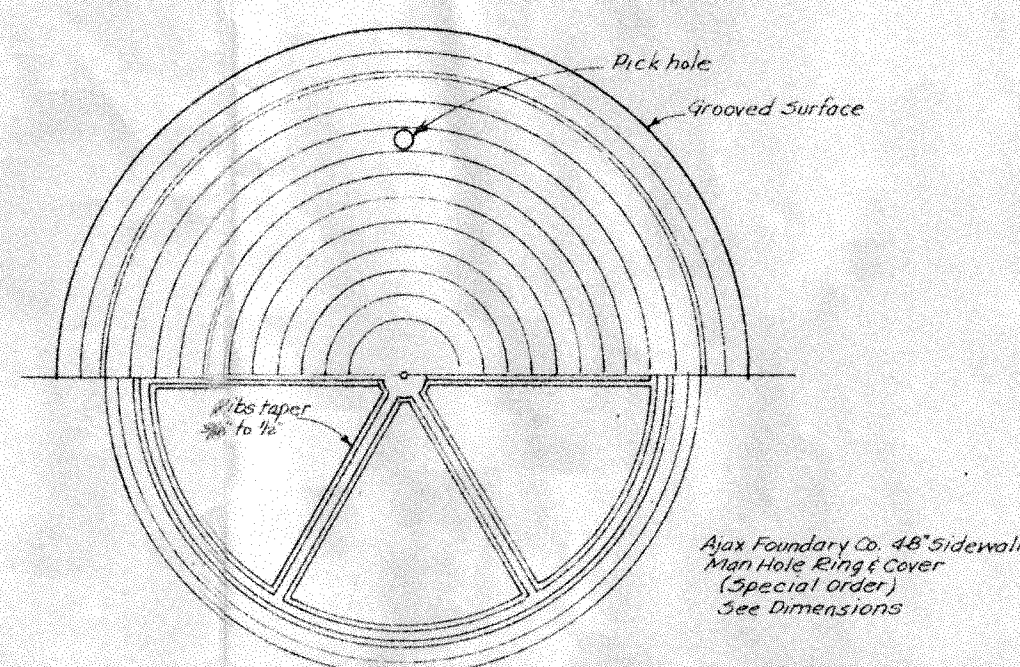
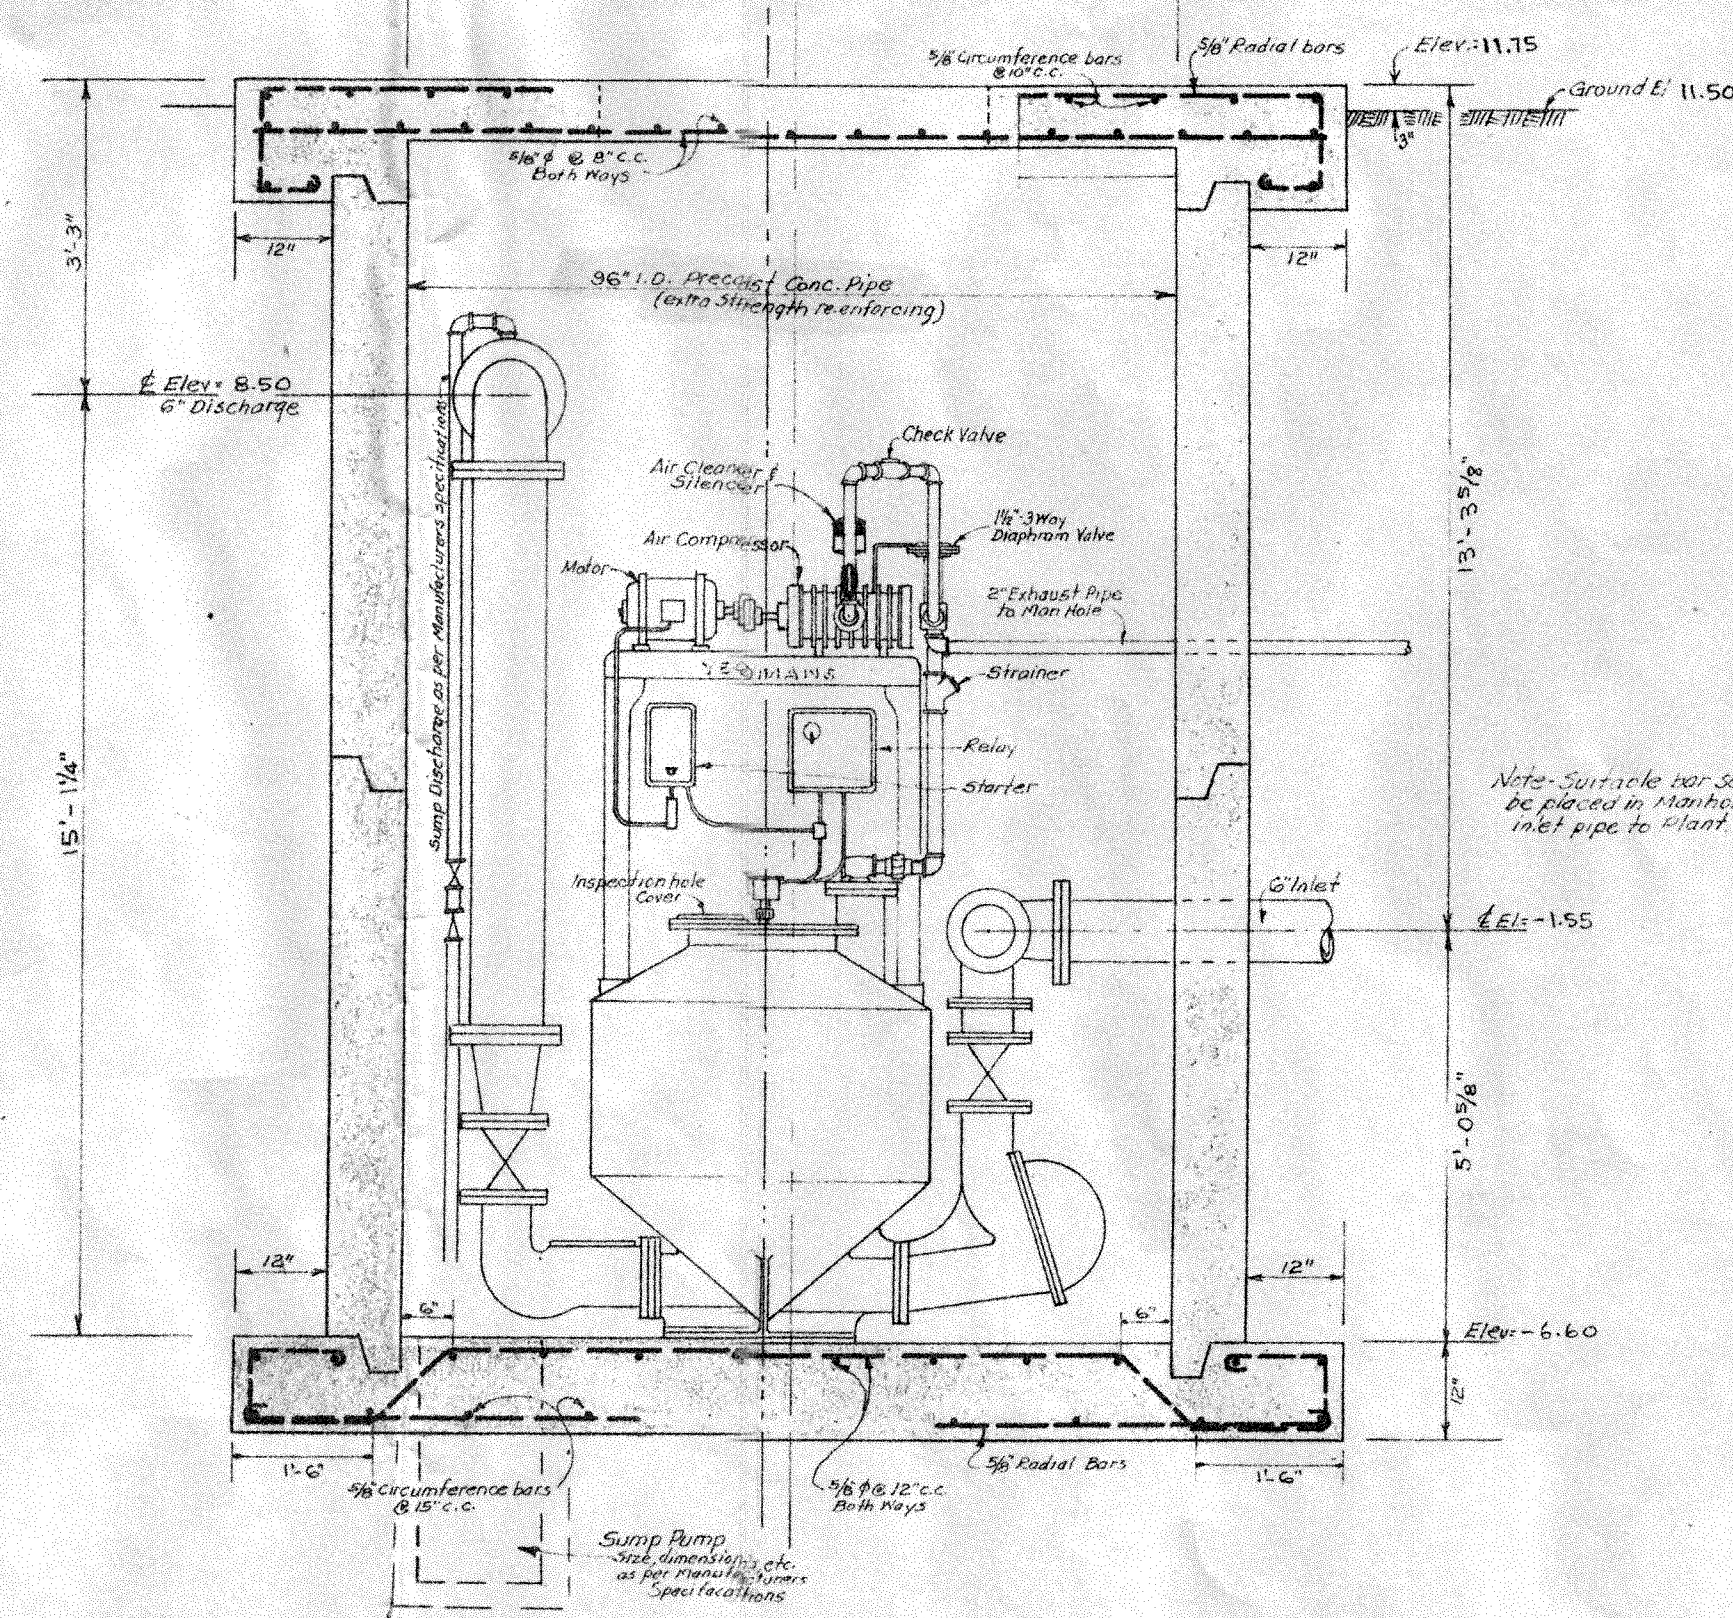
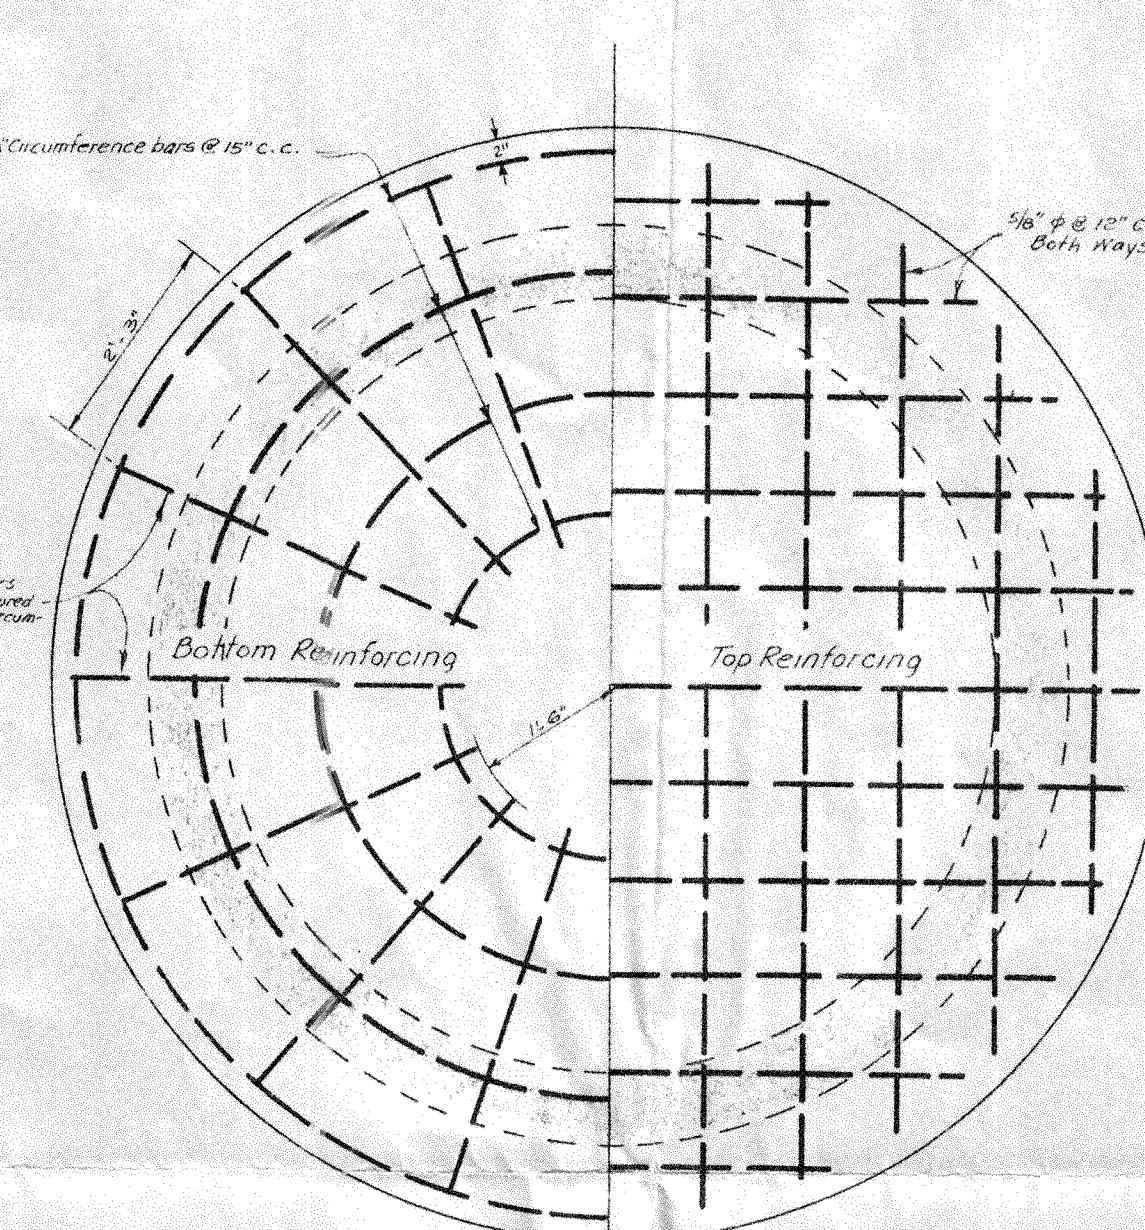
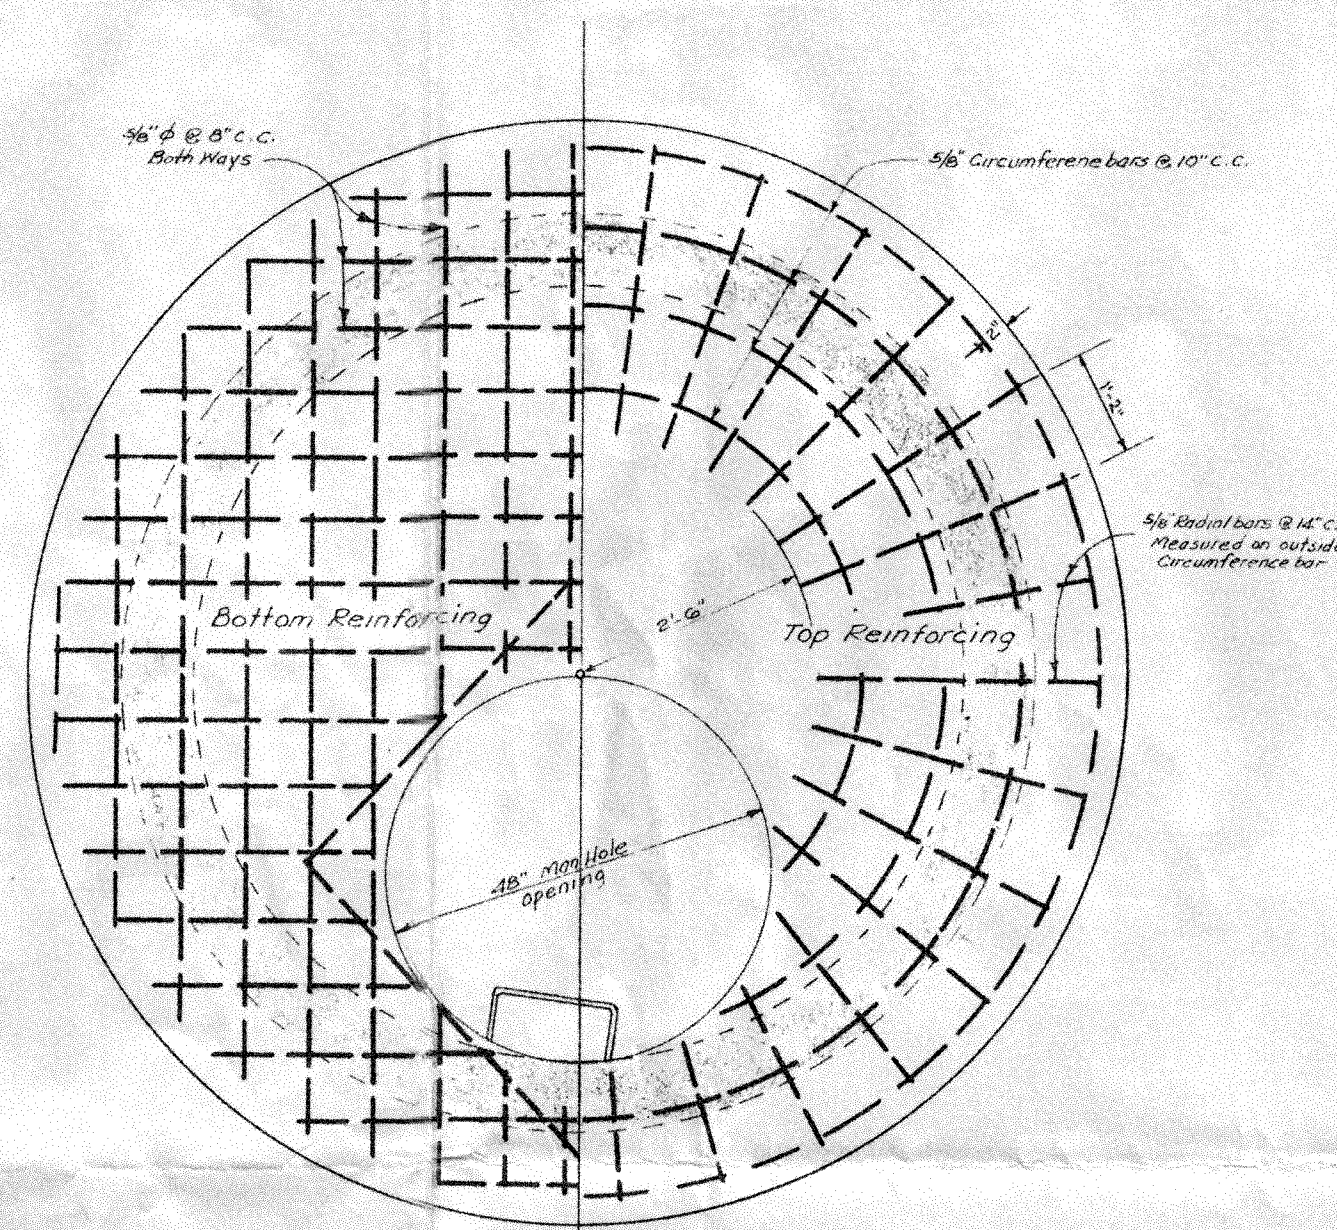


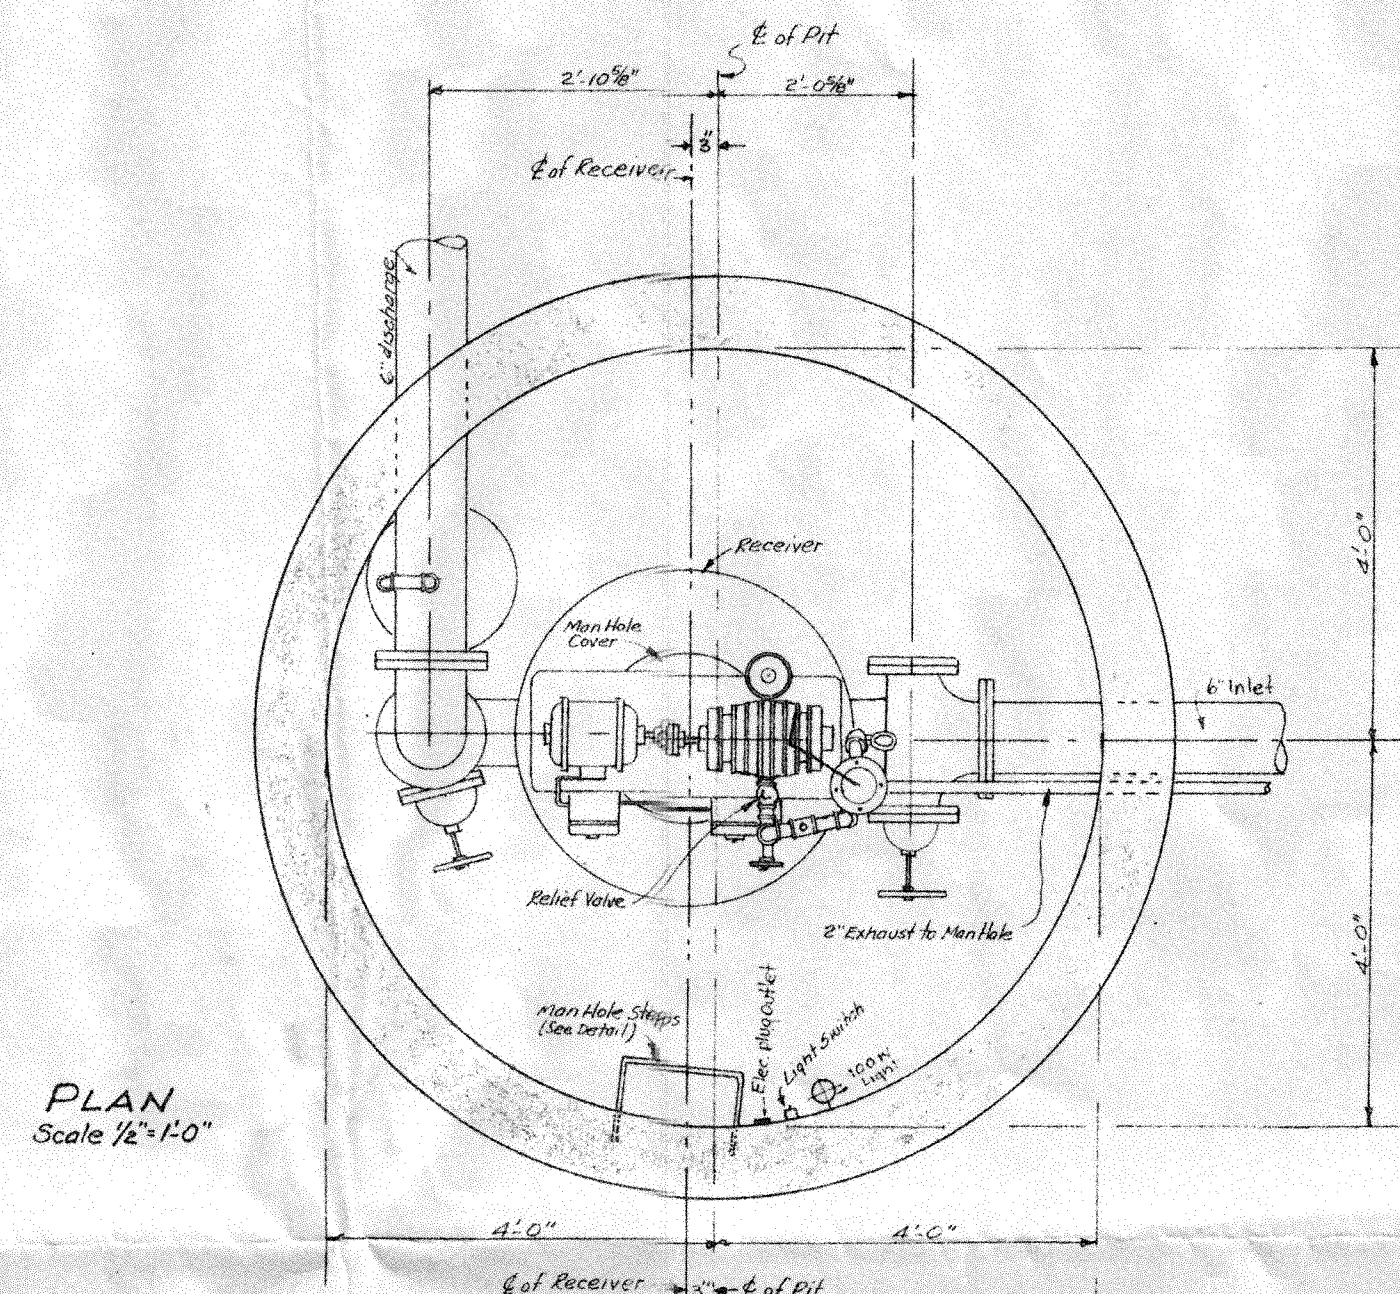

This is Scotty's P.S. with a Flygt Pump not shown

PLANS BROUGHT UP TO DATE MAY 1957
AS BUILT AND COMPLETED

PLAN OF PUMPING PLANT AT COLOMA ST.

SAUSALITO-MARIN COUNTY CALIFORNIA
SAUSALITO-MARIN CITY SANITARY DIST.
J.C. OGLESBY DISTRICT ENGINEER

NOVEMBER 1955

J.C. Oglesby