




# SAUSALITO - MARIN CITY SANITARY DISTRICT

## TREATMENT AND WET WEATHER FLOW UPGRADE


### PROJECT NO. 0055-006

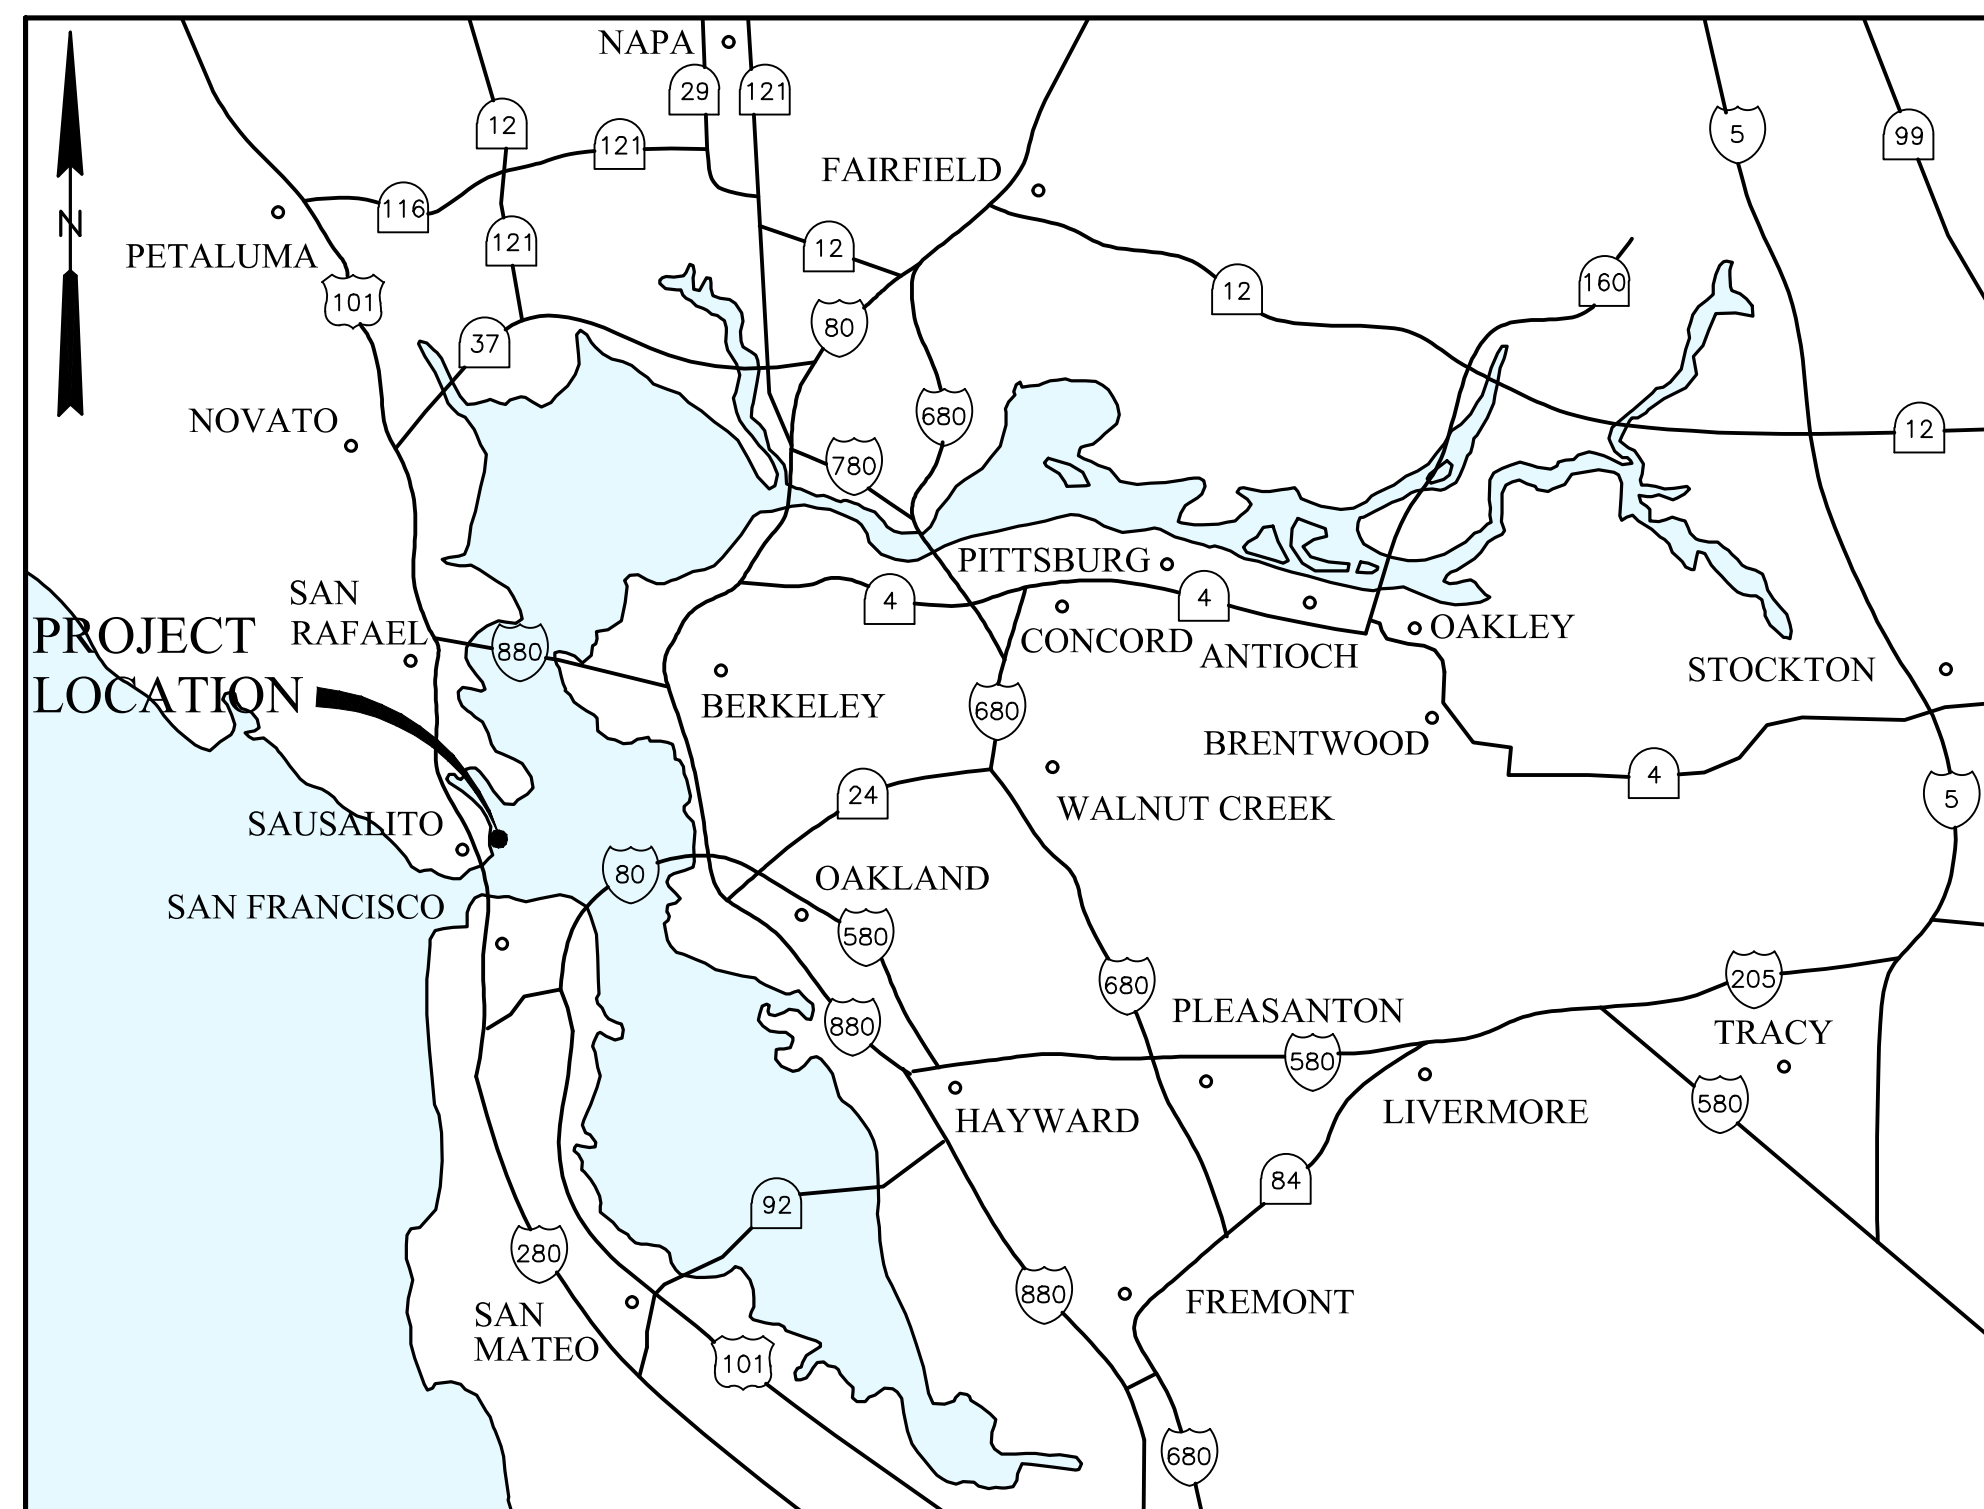

VICINITY MAP  
NTS

CONTRACT  
DRAWINGS  
VOLUME 3 (2 of 2)  
JULY 2022


RECORD  
DRAWINGS

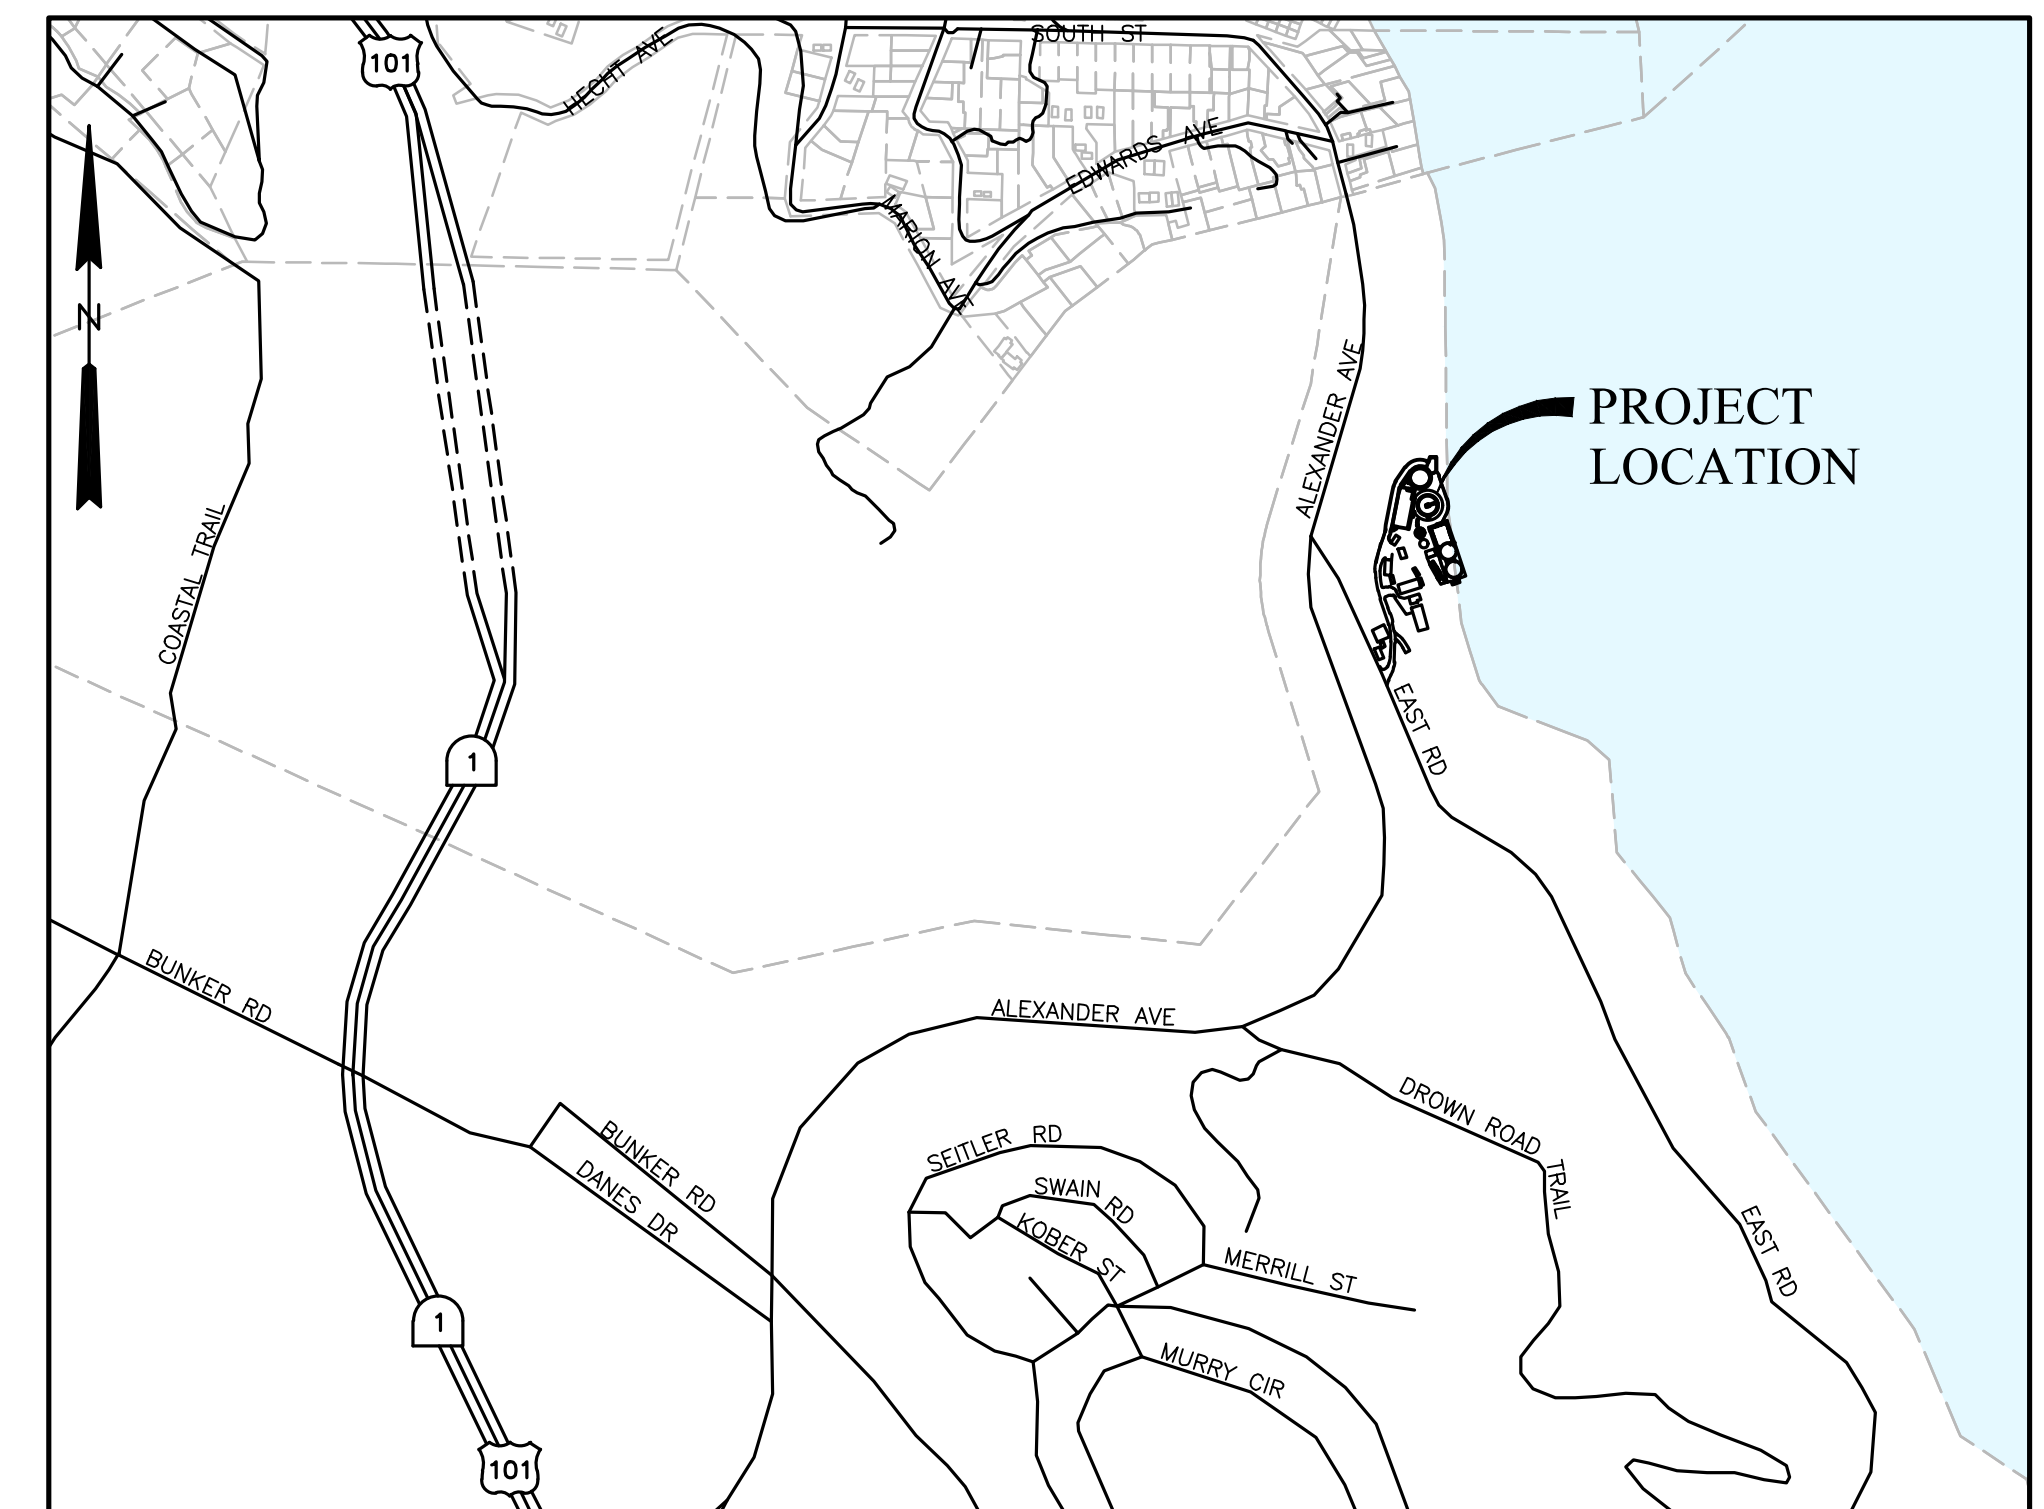

LOCATION MAP  
SCALE: 1"=2000'

FILENAME: 0055-006-Cover 8-01-22 11:28am cto XREFS: | cto

**RECORD DRAWING**  
THIS RECORD DRAWING HAS BEEN PREPARED FROM THE ORIGINAL CONTRACT DOCUMENTS SIGNED AND SEALED BY THE RESPONSIBLE ENGINEER OF RECORD. ADDITIONAL INFORMATION HAS BEEN PROVIDED BY OTHERS TO REPRESENT AS-CONSTRUCTED CONDITION AND IS SHOWN ON THESE RECORD DRAWINGS. THE RESPONSIBLE ENGINEER OF RECORD CANNOT VERIFY THE ACCURACY OF THE AS-CONSTRUCTED CONDITION INFORMATION REPRESENTED ON THE RECORD DRAWINGS.

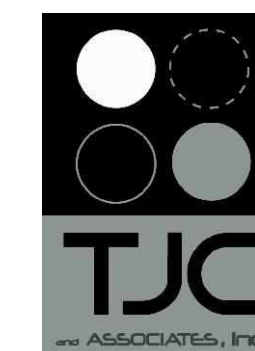

# INDEX OF DRAWINGS

Sheet No.	Dwg. No.	Drawing Title	Sheet No.	Dwg. No.	Drawing Title	Sheet No.	Dwg. No.	Drawing Title
<b>GENERAL</b>			<b>STRUCTURAL</b>			<b>ELECTRICAL</b>		
1		COVER, VICINITY MAP AND LOCATION MAP	79	S-1	GENERAL NOTES	165	E-1	LEGEND AND GENERAL NOTES
2	G-1	INDEX OF DRAWINGS	80	S-2	GENERAL NOTES	166	E-2	MAIN SINGLE-LINE DIAGRAM MCC HW ELEVATION
3	G-2	ABBREVIATIONS AND SYMBOLS	81	S-3	ABBREVIATIONS & STANDARD DETAILS	167	E-3	MCC-HW SINGLE-LINE DIAGRAM
4	G-3	OVERALL PROCESS FLOW SCHEMATIC	82	S-4	STANDARD DETAILS	168	E-4	FFR SUPPLY PUMPS MODIFICATIONS
5	G-4	DESIGN CRITERIA	83	S-5	STANDARD DETAILS	169	E-5	FILTER FEED PUMP CONTROL CONTROL SCHEMATIC & PANEL
6	G-5	HYDRAULIC PROFILE	84	S-6	STANDARD DETAILS	170	E-6	CONTROL SCHEMATIC DIAGRAMS SHEET 1 OF 4
7	G-6	PIPE SCHEDULE AND LEGENDS	85	S-7	STANDARD DETAILS	171	E-7	CONTROL SCHEMATIC DIAGRAMS SHEET 2 OF 4
8	G-7	EXISTING SITE PLAN	86	S-8	STANDARD DETAILS	172	E-8	CONTROL SCHEMATIC DIAGRAMS SHEET 3 OF 4
9	G-8	STAGING AREA LOCATIONS	87	S-9	STANDARD DETAILS	173	E-9	CONTROL SCHEMATIC DIAGRAMS SHEET 4 OF 4 AND PANEL BOARD SCHEDULE
<b>DEMOLITION</b>			88	S-10	STANDARD DETAILS	174	E-10	CONTROL ONE-LINE DIAGRAMS SHEET 1 OF 2
10	D-1	DEMOLITION LEGEND AND NOTES	89	S-11	STANDARD DETAILS	175	E-11	CONTROL ONE-LINE DIAGRAMS SHEET 2 OF 2
11	D-2	OVERALL SITE DEMOLITION PLAN	90	S-12	STANDARD DETAILS	176	E-12	SCADA PLC WIRING DIAGRAMS PLC-HW SHEET 1 OF 4
12	D-3	DEMOLITION ENLARGED PLAN	91	S-13	STANDARD DETAILS	177	E-13	SCADA PLC WIRING DIAGRAMS PLC-HW SHEET 2 OF 4
13	D-4	ENERGY DISSIPATION STRUCTURE DEMOLITION DETAILS	92	S-14	STANDARD DETAILS	178	E-14	SCADA PLC WIRING DIAGRAMS PLC-HW SHEET 3 OF 4
14	D-5	EXISTING PRIMARY CLARIFIER DEMOLITION PLAN - 1	93	S-15	STANDARD DETAILS	179	E-15	SCADA PLC WIRING DIAGRAMS PLC-HW SHEET 4 OF 4
15	D-6	EXISTING PRIMARY CLARIFIER DEMOLITION PLAN - 2	94	S-16	MISCELLANEOUS STAIRS	180	E-15A	SCADA PLC WIRING DIAGRAMS PLC-GEN SHEET 1 OF 2
16	D-7	DEWATERING BUILDING DEMOLITION PLAN	95	S-17	STAIR SECTIONS	181	E-15B	SCADA PLC WIRING DIAGRAMS PLC-GEN SHEET 2 OF 2
17	D-8	DEWATERING BUILDING DEMOLITION SECTIONS	96	S030-1	VIEWING AREA	182	E-16	SCADA PLC WIRING DIAGRAM INTERNAL POWER DISTRIBUTION
18	D-9	DIESEL TANK AND GAS PURIFIER DEMOLITION	97	S100-1	EQ BASIN - FOUNDATION PLAN EL 4.17	183	E-17	CABLE AND CONDUIT SCHEDULE SHEET 1 OF 3
19	D-10	MISC DEMOLITION DETAILS	98	S100-2	HEADWORKS/EQ BASIN FOUNDATION PLAN EL 29.50	184	E-18	CABLE AND CONDUIT SCHEDULE SHEET 2 OF 3
20	D300-1	FFR PUMP DEMOLITION PLAN	99	S100-3	HEADWORKS/EQ BASIN INTERMEDIATE PLAN EL 42.50	185	E-19	CABLE AND CONDUIT SCHEDULE SHEET 3 OF 3
21	D300-2	FFR MEDIA DEMOLITION PLAN	100	S100-4	HEADWORKS/EQ BASIN TOP PLAN EL 44.50	186	E-20	LIGHTING FIXTURE SCHEDULE AND LIGHTING CONTROL AND EYEWASH CONTROL PANEL
22	D300-3	FFR MEDIA DEMOLITION SECTIONS	101	S100-5	HEADWORKS/EQ BASIN SECTION A	187	E-21	FIRE ALARM - ELECTRICAL ROOM
23	D300-4	FFR PIPING DEMOLITION SECTIONS	102	S100-6	HEADWORKS/EQ BASIN SECTION B	188	E-22	CONSTRUCTION DETAILS SHEET 1 OF 3
24	D400-1	SAND FILTERS DEMOLITION PLAN & SECTIONS - 1	103	S100-7	HEADWORKS/EQ BASIN SECTIONS C & D	189	E-23	CONSTRUCTION DETAILS SHEET 2 OF 3
25	D400-2	SAND FILTERS DEMOLITION PLAN & SECTIONS - 2	104	S100-8	HEADWORKS/EQ BASIN SECTIONS E & F	190	E-24	CONSTRUCTION DETAILS SHEET 3 OF 3
26	D400-3	SAND FILTERS DEMOLITION DETAILS	105	S100-9	HEADWORKS/EQ BASIN SECTIONS G & H	191	E-25	PARTIAL SITE PLAN - THICKENER, SEC. DIGESTER & GEN. BLDG.
27	D600-1	UTILITY WATER PUMP STATION DEMOLITION PLAN	106	S100-10	HEADWORKS/EQ BASIN SECTIONS J & K	192	E-26	ELECT. SEQUENCE OF WORK AND TEMP. POWER DURING CONSTRUCTION
28	D600-2	SAMPLE PUMP NO. 5 DEMOLITION PLAN AND DETAILS	107	S100-11	HEADWORKS/EQ BASIN SECTIONS & DETAILS	193	E-27	TYPICAL CONSTRUCTION DETAILS SHEET 1 OF 3
<b>CIVIL</b>			108	S200-1	PRIMARY CLARIFIER NO. 2 FOUNDATION AND TOP PLANS	194	E-28	TYPICAL CONSTRUCTION DETAILS SHEET 2 OF 3
29	C-1	CIVIL LEGEND & NOTES	109	S200-2	PRIMARY CLARIFIER NO. 2 SECTIONS AND DETAIL	195	E-29	TYPICAL CONSTRUCTION DETAILS SHEET 3 OF 3
30	C-2	CIVIL STANDARD DETAILS - 1	110	S400-1	EFFLUENT FILTERS PLAN	196	E-30	UTILITY WATER PUMP CONTROL DIAGRAM AND CONTROL PANEL
31	C-3	CIVIL STANDARD DETAILS - 2	111	S400-2	EFFLUENT FILTERS SECTIONS	197	E-31	EXISTING MCC-P1 MODIFICATIONS AND RECYCLE PUMPS
32	C-4	CIVIL STANDARD DETAILS - 3	112	S400-3	MISCELLANEOUS STAIRS	198	E-32	UTILITY WATER PUMP DETAIL, RECYCLE PUMP DETAIL AND PLC-6 MODIFICATIONS
33	C-5	CIVIL STANDARD DETAILS - 4	<b>MECHANICAL</b>			199	E-33	EXISTING MAIN PLANT PLC MODIFICATIONS
34	C-6	CIVIL STANDARD DETAILS - 5	113	M-1	MECHANICAL LEGEND AND SCHEDULE	200	E-34	EXISTING PLC-6 MODIFICATIONS
35	C-7	CIVIL STANDARD DETAILS - 6	114	M-2	MECHANICAL STANDARD DETAILS - 2	201	E100-1	OVERALL SITE PLAN
36	C-8	CIVIL STANDARD DETAILS - 7	115	M-3	MECHANICAL STANDARD DETAILS - 3	202	E100-2	HEADWORKS ELECTRICAL PARTIAL ENLARGED SITE PLAN
37	C-9	CIVIL MISCELLANEOUS DETAILS	116	M-4	MECHANICAL STANDARD DETAILS - 4	203	E100-3	HEADWORKS/GRIT AND EQ BASIN TOP PLAN - POWER AND SIGNAL
38	C-20	TEMPORARY INFLUENT SEWER PLAN	117	M-5	MECHANICAL STANDARD DETAILS - 5	204	E100-4	HEADWORKS/GRIT & EQ BASIN CROSS SECTION DETAIL
39	C-21	TEMPORARY UTILITIES PLAN	118	M-6	MECHANICAL STANDARD DETAILS - 6	205	E100-5	HEADWORKS/GRIT & EQ BASIN BOTTOM PLAN - POWER AND SIGNAL
40	C100-1	CIVIL SITE GRADING AND PAVING OVERALL PLAN	119	M-7	MECHANICAL STANDARD DETAILS - 7	206	E100-6	EQUALIZATION CROSS SECTION LIGHTING ELEVATION DETAIL
41	C100-2	CIVIL SITE GRADING AND PAVING PLAN - 1	120	M-8	MECHANICAL STANDARD DETAILS - 8	207	E100-7	ELECTRICAL ENLARGED PLAN, MCC ROOM - POWER, LIGHTING AND SIGNAL
42	C100-3	CIVIL SITE GRADING AND PAVING PLAN - 2	121	M-9	MECHANICAL STANDARD DETAILS - 9	208	E200-1	PRIMARY SLUDGE/SCUM PUMPS PARTIAL PLAN AND SECTION
43	C100-4	TEMPORARY STAIRS	122	M-10	MECHANICAL STANDARD DETAILS - 10	209	E300-1	FIXED FILM REACTOR MODIFICATIONS PLAN - POWER AND SIGNAL
44	C110-1	GEOTECHNICAL SOIL NAIL UPPER WALL PROFILES	123	M-20	ODOR CONTROL SCHEMATIC	210	E400-1	EFFLUENT FILTERS PLAN - POWER AND SIGNAL
45	C110-2	GEOTECHNICAL SOIL NAIL LOWER WALL PROFILES	124	M100-1	OVERALL SITE PLAN	<b>INSTRUMENTATION AND CONTROLS</b>		
46	C110-3	SOIL NAIL ADMIN WALL PROFILE	125	M100-2	HEADWORKS AND EQ BASIN FOUNDATION PLAN	211	I-1	INSTRUMENTATION LEGEND AND GENERAL NOTES
47	C110-4	GEOTECHNICAL SOIL NAIL WALL DETAILS	126	M100-3	HEADWORKS AND EQ BASIN LOWER PLAN EL 25.0	212	I-2	INSTRUMENTATION SYMBOLS AND NOTES
48	C200-1	CIVIL YARD PIPING PLAN	127	M100-4	HEADWORKS AND EQ BASIN PLAN EL 43.0	213	I-3	SCADA SYSTEM BLOCK DIAGRAM
49	C200-2	PIPE PROFILES - 1	128	M100-5	HEADWORKS AND EQ BASIN TOP PLAN	214	I-4	INSTRUMENTATION TYPICAL DETAILS SHEET 1 OF 2
50	C200-3	PIPE PROFILES - 2	129	M100-6	HEADWORKS AND EQ BASIN ENLARGED PLAN AT EL 43.00	215	I-5	INSTRUMENTATION TYPICAL DETAILS SHEET 2 OF 2
51	C200-4	INFLUENT SEWER TEMPORARY BYPASS PLAN AND SECTIONS	130	M100-7	HEADWORKS/PRIMARY - SECTION 1	216	I100-1	P&ID HEADWORKS OVERVIEW
<b>CATHODIC PROTECTION</b>			131	M100-8	HEADWORKS - SECTION 1	217	I100-2	P&ID SCREENING HANDLING AND TURNTABLE
52	CP-1	CORROSION CONTROL DETAILS	132	M100-9	HEADWORKS - SECTION 2	218	I100-3	P&ID GRIT HANDLING INSTRUMENTATION
53	CP-2	CORROSION CONTROL DETAILS	133	M100-10	HEADWORKS - SECTION 3	219	I100-4	P&ID EQUALIZATION INSTRUMENTATION
54	CP-3	CONCRETE REPAIR AND LINING DETAILS	134	M100-11	HEADWORKS - SECTION 4	220	I100-5	P&ID FERRIC CHLORIDE SYSTEM AND DIESEL FUEL TANK
55	CP-4	CONCRETE REPAIR AND LINING DETAILS	135	M100-12	HEADWORKS - SECTION 5	221	I200-1	P&ID PRIMARY CLARIFIER #2 AND SLUDGE/SCUM PUMPING
56	CP-5	CONCRETE REPAIR AND LINING DETAILS	136	M100-13	HEADWORKS - SECTION 6	222	I300-1	P&ID FIXED FILM REACTOR SUPPLY PUMPING
<b>ARCHITECTURAL</b>			137	M100-14	HEADWORKS - SECTION 7	223	I400-1	P&ID TERTIARY FILTER PUMPING
57	A100-1	HEADWORKS/GRIT AND EQ BASIN ARCHITECTURAL FLOOR PLAN	138	M100-15	HEADWORKS - SECTION 8	224	I400-2	P&ID TERTIARY FILTER PACKAGES
58	A100-2	HEADWORKS/GRIT AND EQ BASIN ARCHITECTURAL FLOOR PLAN	139	M100-16	HEADWORKS - SECTION 9	225	I500-1	P&ID RECYCLE PUMP STATION
59	A100-3	HEADWORKS/GRIT AND EQ BASIN ARCHITECTURAL ELEVATIONS	140	M100-17	HEADWORKS - SECTION 10	226	I600-1	P&ID UTILITY WATER PUMP STATION
60	A100-4	HEADWORKS/GRIT AND EQ BASIN ARCHITECTURAL ELEVATIONS	141	M100-18	HEADWORKS DETAILS	<b>SELECT REFERENCE DRAWINGS (AVAILABLE IN ELECTRONIC PDF FORMAT ONLY)</b>		
61	A100-5	HEADWORKS/GRIT AND EQ BASIN SECTIONS AND DETAILS	142	M110-1	ILLUSTRATIVE ISOMETRIC VIEWS - 1	1952		SMCSD SEWAGE PUMPING AND TREATMENT WORKS
62	A100-6	HEADWORKS/GRIT AND EQ BASIN SCHEDULES AND DETAILS	143	M110-2	ILLUSTRATIVE ISOMETRIC VIEWS - 2	1972		SMCSD WASTE TREATMENT AND DISPOSAL FACILITIES
63	A200-1	PRIMARY CLARIFIER ARCHITECTURAL ELEVATIONS	144	M110-3	ILLUSTRATIVE ISOMETRIC VIEWS - 3	1988		SMCSD WASTEWATER PLANT IMPROVEMENTS C-06-2464 RECORD DRAWINGS
<b>LANDSCAPING</b>			145	M200-1	PRIMARY CLARIFIER NO. 2 - TOP PLAN	1990		SMCSD WASTEWATER PLANT IMPROVEMENTS EFFLUENT FILTERS
64	L1	LANDSCAPE CONSTRUCTION AND PLANTING PLAN	146	M200-2	PRIMARY CLARIFIER NO. 2 - BOTTOM PLAN	1997		SMCSD BEACH FORCEMAIN REPLACEMENT
65	L1-1	PLANTING PLAN	147	M200-3	PRIMARY CLARIFIER SECTION	2008		SMCSD SLUDGE DEWATERING PROJECT
66	L1-2	IRRIGATION PLAN	148	M200-4	PRIMARY CLARIFIER DETAILS - 1			
67	L1-3	IRRIGATION PLAN	149	M200-5	PRIMARY CLARIFIER DETAILS - 2			
68	L10-1	TREE REMOVAL PLAN	150	M200-6	SCUM PIT AND EFFLUENT BOX PARTIAL PLAN AND SECTIONS			
69	L10-2	TREE REMOVAL PLAN	151	M210-1	PRIMARY SLUDGE/SCUM PUMPS - PARTIAL PLAN AND SECTIONS			
70	L10-3	TREE PRESERVATION PLAN	152	M210-2	PRIMARY SLUDGE/SCUM PUMPS - PARTIAL PLAN AND SECTIONS			
71	L10-4	TREE PRESERVATION PLAN	153	M300-1	FFR PUMP PLAN AND SECTION			
72	L20-1	WALL ELEVATION	154	M300-2	DIVERSION BOX PLAN AND SECTION			
73	L20-2	WALL ELEVATION	155	M300-3	FIXED FILM REACTOR SECTION			
74	L20-3	WALL ELEVATION	156	M400-1	EFFLUENT FILTERS FOUNDATION PLAN			
75	L20-4	CONSTRUCTION DETAILS	157	M400-2	EFFLUENT FILTERS INTERMEDIATE PLAN			
76	L20-5	CONSTRUCTION DETAILS	158	M400-3	EFFLUENT FILTERS TOP PLAN			
77	L20-6	PLANTING DETAILS	159	M400-4	EFFLUENT FILTERS SECTIONS			
78	L30-1	IRRIGATION DETAILS	160	M400-5	EFFLUENT FILTERS SECTIONS			
			161	M400-6	EFFLUENT FILTERS SECTIONS			
			162	M500-1	RECYCLE BOX PLAN AND SECTIONS			
			163	M600-1	UTILITY WATER PUMP STATION PLAN AND SECTION			
			164	M600-2	UTILITY WATER PUMP STATION SECTION			

FILENAME: 0055-006-G-1 8-01-22 11:27am cto || XREFS: X-SMCSO-TBLK | cto

**RECORD DRAWING**  
 THIS RECORD DRAWING HAS BEEN PREPARED FROM THE ORIGINAL CONTRACT DOCUMENTS SIGNED AND SEALED BY THE RESPONSIBLE ENGINEER OF RECORD. ADDITIONAL INFORMATION HAS BEEN PROVIDED BY OTHERS TO REPRESENT AS-CONSTRUCTED CONDITION AND IS SHOWN ON THESE RECORD DRAWINGS. THE RESPONSIBLE ENGINEER OF RECORD CANNOT VERIFY THE ACCURACY OF THE AS-CONSTRUCTED CONDITION INFORMATION REPRESENTED ON THE RECORD DRAWINGS.

0" = 1"  
 VERIFY SCALES -  
 BARS IS ONE INCH  
 LONG ON FULL  
 SIZE DRAWING.  
 IF NOT ONE INCH  
 LONG ON THIS  
 DRAWING, ADJUST  
 SCALES ACCORDINGLY



REV	DATE	BY	APVD	DESCRIPTION

DESIGNED	M. TAKEMOTO	SUBMITTED: MARK TAKEMOTO RMC PROJECT ENGINEER CE-64369
DRAWN	S. JUNG	
CHECKED	M. NAKAMOTO	APPROVED: STEVE CLARY RMC ENGINEER CE-30318




TREATMENT AND WET WEATHER FLOW UPGRADE		DWG NO	G-1
INDEX OF DRAWINGS		SHEET NO	2 OF 226
		PROJ NO	055-006
		DATE	JULY 2022


## ABBREVIATIONS

<p>⊙ AT AB ANCHOR BOLT, AGGREGATE BASE ABC AGGREGATE BASE COURSE (CALTRANS CLASS 2 AGGREGATE BASE) ABS ACRYLONITRILE-BUTADIENE-STYRENE AC ASBESTOS CEMENT, ASPHALTIC CONCRETE AC/HR AIR CHANGES PER HOUR ACI AMERICAN CONCRETE INSTITUTE ADH ADHESIVE ANCHOR BOLT ADJ ADJACENT, ADJUSTABLE AISC AMERICAN INSTITUTE OF STEEL CONSTRUCTION AL ALUMINUM ALT ALTERNATE ANSI AMERICAN NATIONAL STANDARDS INSTITUTE APPROX APPROXIMATE ARCH ARCHITECTURAL ARV AIR RELEASE VALVE AUX AUXILIARY AWG AMERICAN WIRE GAGE AWT ADVANCED WASTE TREATMENT</p> <p>BC BOLT CIRCLE, BEGIN CURVE BD BOARD BF BLIND FLANGE, BOTTOM FLAT BFV BUTTERFLY VALVE BGS BELOW GROUND SURFACE BLDG BUILDING BM BENCH MARK, BEAM BO BLOWOFF BOT BOTTOM BRG BEARING BS BUTT STRAP BV BALL VALVE BVC BEGINNING OF VERTICAL CURVE</p> <p>C CHANNEL (BEAM) CAV COMBINATION AIR AND VACUUM VALVE CB CATCH BASIN CDF CONTROLLED DENSITY FILL CFM CUBIC FEET PER MINUTE CFS CUBIC FEET PER SECOND CHEM CHEMICAL CIP CAST IRON PIPE CIRC CIRCUMFERENTIAL CJ CONSTRUCTION JOINT CLR CLEAR CLS CHLORINE SOLUTION HYPOCHLORITE CLSM CONTROLLED LOW STRENGTH MATERIAL CL CENTERLINE CMP CORRUGATED METAL PIPE CMU CONCRETE MASONRY UNIT CO CLEANOUT COL COLUMN COMP COMPRESSOR(S) CONC CONCRETE, CONCENTRIC COND CONDUIT CONN CONNECTION CONT CONTINUOUS COORD COORDINATE CPLG COUPLING CPVC CHLORINATED POLYVINYL CHLORIDE CT CERAMIC TILE CTD CENTERED CTJ CONTROL JOINT CTR CENTER CTS CORROSION TEST STATION C TO C CENTER TO CENTER CU CUBIC CU FT CUBIC FOOT CU IN CUBIC INCH CU YD CUBIC YARD CV CHECK VALVE °C DEGREE CELSIUS</p> <p>d PENNY (NAIL SIZE) D DRAIN DBL DOUBLE DET DETAIL DFT DRY FILM THICKNESS DI DROP INLET, DUCTILE IRON DIA DIAMETER DIAG DIAGONAL DIP DUCTILE IRON PIPE DIR DIRECTION DN DOWN DWG DRAWING</p>	<p>E EAST EA EACH EC END CURVE ECB EROSION CONTROL BLANKET ECC ECCENTRIC EF EACH FACE, EXHAUST FAN EL, ELEV ELEVATION ELEC ELECTRIC, ELECTRICAL ELL ELLOW ENGR ENGINEER EO EMERGENCY OVERFLOW EP EDGE OF PAVEMENT EQ EQUAL EQPT EQUIPMENT EQ SP EQUALLY SPACED, EQUAL SPACES ESMT EASEMENT EVC END OF VERTICAL CURVE EW EACH WAY EWEF EACH WAY, EACH FACE EXC EXCAVATE EXH EXHAUST EXP EXPOSED EXP JT EXPANSION JOINT EXST EXISTING</p> <p>FA FOUL AIR FAB FABRICATION FC FLEXIBLE COUPLING FCA FLANGED COUPLING ADAPTER FCO FLOOR CLEAN OUT FD FLOOR DRAIN FDS FINAL DIGESTED SLUDGE FDN FOUNDATION FE FLANGED END, FINAL EFFLUENT FEXT FIRE EXTINGUISHER FF FINISH FLOOR FG FINISH GRADE FHY FIRE HYDRANT FI FILTER INFLUENT FIGURE FIGURE FL FLOOR FLW LINE FLG FLANGE FLH FLAT HEAD FLTR FILTER FM FORCE MAIN FO FIBER OPTIC FOC FACE OF CONCRETE, FIBER OPTIC CABLE FOCC FIBER OPTIC CABLE CONDUIT FOR FUEL OIL RETURN FOS FUEL OIL SUPPLY FRP FIBERGLASS REINFORCED PLASTIC FT FOOT OR FEET FTG FOOTING FUT FUTURE FWD FORWARD °F DEGREE FAHRENHEIT</p> <p>GA GAGE GAL GALLON GALV GALVANIZED GC GROOVED COUPLING GCO GRADE CLEAN OUT GE GROOVED END GL GLASS GPD GALLONS PER DAY GPH GALLONS PER HOUR GPM GALLONS PER MINUTE GSP GALVANIZED STEEL PIPE GV GATE VALVE GVL GRAVEL</p> <p>HD HUB DRAIN HDG HOT DIP GALVANIZED HDPE HIGH DENSITY POLYETHYLENE, HDPE PIPE HDR HEADER HDW HARDWARE HGT HEIGHT HM HOLLOW METAL HORIZ HORIZONTAL HP HORSEPOWER HR HOSE RACK, HANDRAIL, HOUR HV HOSE VALVE HWR HOT WATER RETURN HWS HOT WATER SUPPLY H2E HOOK TWO ENDS</p>	<p>JT JOINT</p> <p>KIP THOUSAND POUNDS KW KILOWATT</p> <p>L ANGLE LENGTH LAB LABORATORY LAV LAVATORY LB POUNDS LB/CU FT POUNDS PER CUBIC FOOT LF LINEAR FEET LONG LONGITUDINAL LP LOW PRESSURE LR LONG RADIUS LT LEFT</p> <p>MAG MAGNETIC MATL MATERIAL MAX MAXIMUM MCC MOTOR CONTROL CENTER MECH MECHANICAL MFR MANUFACTURER MGD MILLION GALLONS PER DAY MH MANHOLE MIN MINIMUM MISC MISCELLANEOUS MJ MECHANICAL JOINT ML MIXED LIQUOR MLCSP MORTAR LINED AND COATED STEEL PIPE MSNRY MASONRY MO MASONRY OPENING MITER METER MTR MILL TYPE STEEL PIPE MTS MAXIMUM WATER SURFACE</p> <p>N NORTH NIC NOT IN CONTRACT NO. NUMBER NPT NATIONAL PIPE THREAD NTS NOT TO SCALE</p> <p>OC ON CENTER OD OUTSIDE DIAMETER OF OUTSIDE FACE, OVERFLOW OSD OPEN SITE DRAIN OPNG OPENING OZ OUNCE</p> <p>PC POINT OF CURVE PCC PORTLAND CEMENT CONCRETE, POINT OF COMPOUND CURVATURE PCO PRESSURE CLEANOUT PD PUMPED DRAIN PE PLAIN END PH POTHOLE PI POINT OF INTERSECTION PL PLASTIC, PROPERTY LINE, PLATE PL PLATE (STEEL) PLYWD PLYWOOD PRC POINT OF REVERSE CURVE PREFAB PREFABRICATED PRESS. PRESSURE PRI PRIMARY PROP PROPERTY PSF POUNDS PER SQUARE FOOT PS PUMP STATION PSI POUNDS PER SQUARE INCH PSIG POUNDS PER SQUARE INCH, GAUGE PT POINT, POINT OF TANGENCY PV PLUG VALVE PVC POLYVINYL CHLORIDE PLASTIC, PVC PIPE PVMT PAVEMENT</p> <p>R RADIUS RAS RETURN ACTIVATED SLUDGE RCP REINFORCED CONCRETE PIPE RD ROOF DRAIN, ROAD RDCR REDUCER RDW REDWOOD RECIRC RECIRCULATION REF REFER OR REFERENCE REINF REINFORCED, REINFORCING, REINFORCE REQD REQUIRED RM ROOM RO ROUGH OPENING RPVC REINFORCED POLYVINYL CHLORIDE RSFM RAW SEWAGE FORCE MAIN RSU RETURN SUPERNATANT RT RIGHT RTN RETURN RV ROOF VENT RW RECYCLED WATER R/W RIGHT-OF-WAY</p>	<p>SCFM STANDARD CUBIC FEET PER MINUTE SCH SCHEDULE SD STORM DRAIN, SOAP DISPENSER SE SECONDARY EFFLUENT SEC SECONDARY SECT SECTION SHT SHEET SIT SIMILAR SL, SLP SLOPE SNP SAMPLE SOLN SOLUTION SP SPACE OR SPACES SPEC SPECIFICATIONS SPLY SUPPLY SQ SQUARE SQ FT SQUARE FOOT SQ IN SQUARE INCH SS SANITARY SEWER SST STAINLESS STEEL STA STATION STD STANDARD STL STEEL, STEEL PIPE STR STRAIGHT STRL STRUCTURAL STRUCT STRUCTURE SUSP SUSPEND SWD STORM WATER DRAIN SYMM SYMMETRICAL</p> <p>T TANGENT LENGTH TAN. TANGENT TBG TUBING TBM TEMPORARY BENCH MARK T&amp;B TOP AND BOTTOM TOP OF CURB TDH TOTAL DYNAMIC HEAD TECH TECHNICAL TEL TELEPHONE TEMP TEMPERATURE TF TOP FACE, TOP FLAT T&amp;G TONGUE AND GROOVE THD THREAD THK THICK THRU THROUGH TOS TOP OF SLOPE, TOP OF STEEL TP TURNING POINT TRANSF TRANSFORMER TRANSV TRANSVERSE TW TOP OF WALL TYP TYPICAL</p> <p>UBC UNIFORM BUILDING CODE UD UNDERDRAIN UNO UNLESS NOTED OTHERWISE USA UNDERGROUND SERVICES ALERT UW UTILITY WATER</p> <p>V VENT, VOLT, VALVE VAC VACUUM VAR VARIOUS VC VERTICAL CURVE VERT VERTICAL VPI VERTICAL POINT OF INTERSECTION VTR VENT THRU ROOF</p> <p>W WIDE FLANGE (BEAM), WEST, WATER W/ WITH WAS WASTE ACTIVATED SLUDGE WC WATER CLOSET WH WATER HEATER WM WATER METER WP WORK POINT WS WATER SURFACE, WATER STOP W SH ST WEATHERING SHEET STEEL WSP WELDED STEEL PIPE WT WEIGHT WTR WATER WW WASHWATER WWF WELDED WIRE FABRIC</p> <p>YD YARD</p>
---	--	---	---

## SECTION AND DETAIL IDENTIFICATION

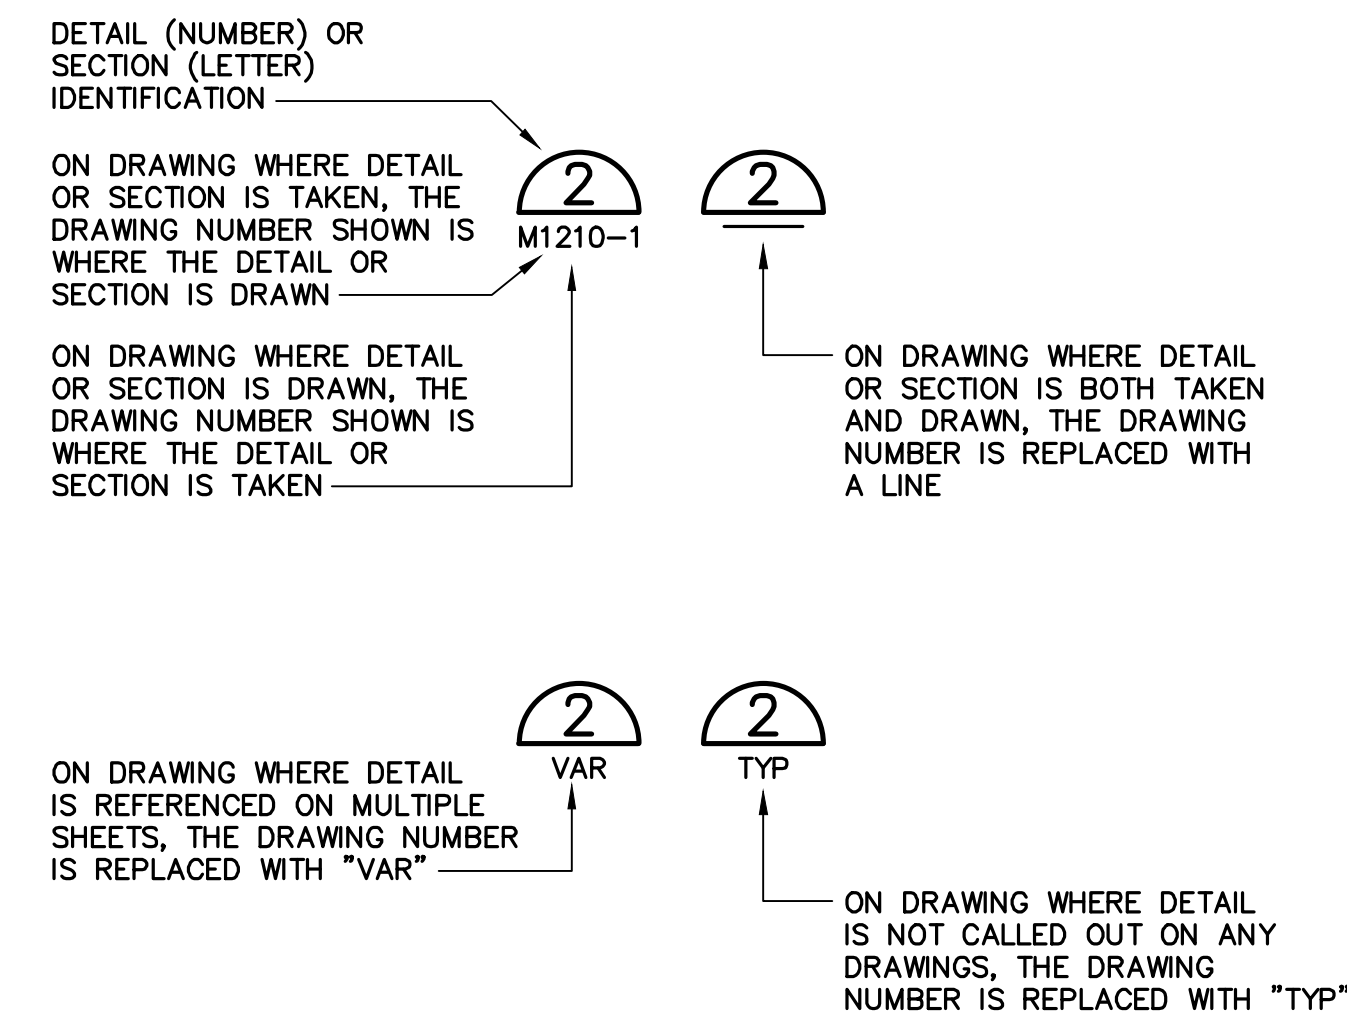

## STANDARD DETAIL IDENTIFICATION

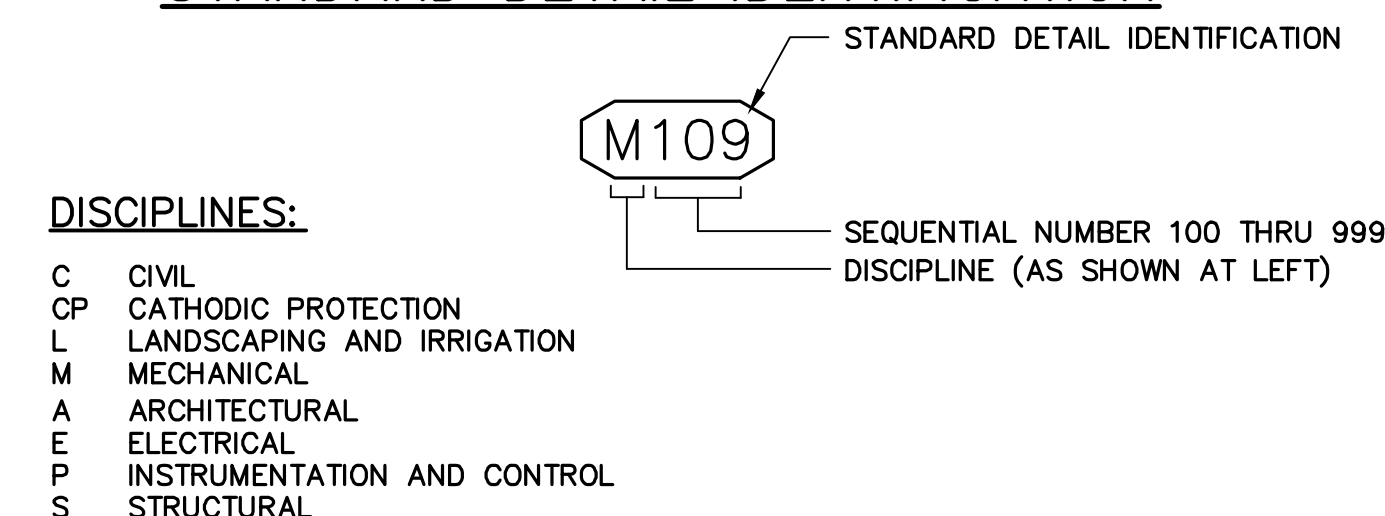


**NOTE:**  
STANDARD DETAIL IDENTIFICATIONS ARE SHOWN ON THE PLANS AND ON THE STANDARD DETAIL DRAWINGS. THERE IS NO SPECIFIC CROSS REFERENCING OF DRAWINGS. STANDARD DETAILS ARE INTENDED TO BE TYPICAL AND SHALL APPLY TO ALL SIMILAR SITUATIONS OCCURRING ON THIS PROJECT, WHETHER OR NOT THEY ARE REFERENCED TO IN EACH APPLICABLE LOCATION. CONSULT THE ENGINEER FOR REVIEW OF THE USE OF STANDARD DETAILS PRIOR TO BIDDING.

- NOTES:**
- THIS IS A STANDARD ABBREVIATION SHEET. SOME ABBREVIATIONS THAT APPEAR ON THIS SHEET ARE NOT USED ON THIS PROJECT.
  - FOR PROCESS FLUID ABBREVIATIONS SEE SHEET G-6.

FILENAME: 0055-006-G-2 8-01-22 11:27am cto XREFS: X-SMCSB-TBLK | cto

**RECORD DRAWING**  
THIS RECORD DRAWING HAS BEEN PREPARED FROM THE ORIGINAL CONTRACT DOCUMENTS SIGNED AND SEALED BY THE RESPONSIBLE ENGINEER OF RECORD. ADDITIONAL INFORMATION HAS BEEN PROVIDED BY OTHERS TO REPRESENT AS-CONSTRUCTED CONDITION AND IS SHOWN ON THESE RECORD DRAWINGS. THE RESPONSIBLE ENGINEER OF RECORD CANNOT VERIFY THE ACCURACY OF THE AS-CONSTRUCTED CONDITION INFORMATION REPRESENTED ON THE RECORD DRAWINGS.

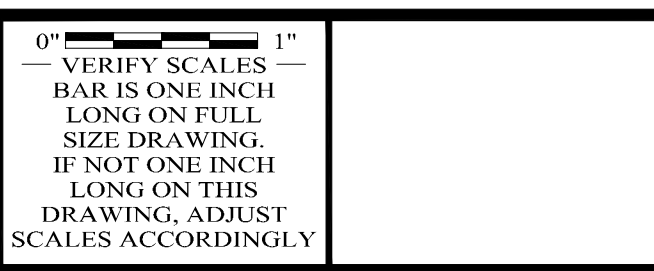

REV	DATE	BY	APVD	DESCRIPTION
	07/22	CT	TV	RECORD DRAWING

DESIGNED M. TAKEMOTO	DRAWN S. JUNG	CHECKED M. NAKAMOTO
----------------------	---------------	---------------------








SUBMITTED: MARK TAKEMOTO RMC PROJECT ENGINEER CE-64369	APPROVED: STEVE CLARY RMC ENGINEER CE-30318
---	--



TREATMENT AND WET WEATHER FLOW UPGRADE
ABBREVIATIONS AND SYMBOLS

DWG NO G-2	SHEET NO 3 OF 226
PROJ NO 055-006	DATE JULY 2022

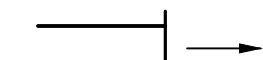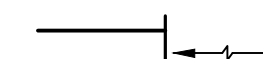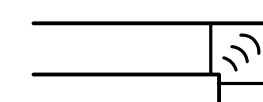**VENTILATION SYMBOLS**

-  SUPPLY DUCT (SECTION)
-  INTAKE, RETURN, OR EXHAUST DUCT (SECTION)
-  WALL REGISTER OR GRILLE (SUPPLY)
-  WALL REGISTER OR GRILLE (RETURN AND EXHAUST)
-  TURNING VANES
-  SOUND ATTENUATED DUCT
-  FLEXIBLE CONNECTION

**MECHANICAL EQUIPMENT LEGEND**

- P PUMP
- CP CENTRIFUGAL PUMP
- TP TURBINE PUMP
- PP PROGRESSIVE CAVITY PUMP
- SP SAMPLE PUMP
- V VALVE
- CV CHECK VALVE
- BV BUTTERFLY VALVE
- GV GATE VALVE
- PV PLUG VALVE
- DV DIAPHRAM VALVE
- OV SOLENOID VALVE
- MX MIXER
- ME PROCESS EQUIPMENT
- FE FLOW ELEMENT (METER)
- LE LEVEL ELEMENT
- G GATE
- T TANK
- B BLOWER
- SC SCREEN
- H HOIST/CRANE
- AH AIR HANDLER
- AC AIR CONDITIONER
- EF EXHAUST FAN
- SF SUPPLY FAN
- LCP LOCAL CONTROL PANEL
- MCC MOTOR CONTROL CENTER
- LP LIGHTING PANEL
- UV ULTRA VIOLET EQUIPMENT

**EQUIPMENT NUMBERING CONVENTION**

UV-1513-30 EQUIPMENT NUMBER TAG

**FLOW STREAM IDENTIFICATION**

SEE DWG G-6 FOR PROCESS FLUID SCHEDULE

**PIPING SCHEDULE**

SEE PIPING SCHEDULE ON DWG G-6.

**VALVE SCHEDULE**

SEE SPEC SECTION 15200 FOR VALVE SCHEDULE.


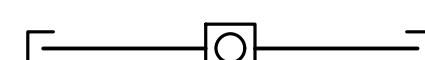

**PUMP SCHEDULE**

SEE INDIVIDUAL PUMP SPEC SECTIONS FOR PUMP SCHEDULE.

**GATE SCHEDULE**

SEE SPEC SECTION 15250 FOR GATE SCHEDULE.

**GATE SYMBOLS**

-  SLUICE GATE
-  SLIDE GATE
-  STOP GATE

**RECORD DRAWING**

THIS RECORD DRAWING HAS BEEN PREPARED FROM THE ORIGINAL CONTRACT DOCUMENTS SIGNED AND SEALED BY THE RESPONSIBLE ENGINEER OF RECORD. ADDITIONAL INFORMATION HAS BEEN PROVIDED BY OTHERS TO REPRESENT AS-CONSTRUCTED CONDITION AND IS SHOWN ON THESE RECORD DRAWINGS. THE RESPONSIBLE ENGINEER OF RECORD CANNOT VERIFY THE ACCURACY OF THE AS-CONSTRUCTED CONDITION INFORMATION REPRESENTED ON THE RECORD DRAWINGS.

0" = 1" VERIFY SCALES — BAR IS ONE INCH LONG ON FULL SIZE DRAWING. IF NOT ONE INCH LONG ON THIS DRAWING, ADJUST SCALES ACCORDINGLY



REV	DATE	BY	APVD	DESCRIPTION
1	07/22	CT	TV	RECORD DRAWING

DESIGNED M. TAKEMOTO  
DRAWN S. JUNG  
CHECKED M. NAKAMOTO

SUBMITTED: MARK TAKEMOTO  
RMC PROJECT ENGINEER CE-64369


APPROVED: STEVE CLARY  
RMC ENGINEER CE-30318



TREATMENT AND WET WEATHER FLOW UPGRADE  
**MECHANICAL LEGEND AND SCHEDULES**

DWG NO M-1  
SHEET NO 113 OF 226  
PROJ NO 055-006  
DATE JULY 2022

I:\PROJECTS\2022\0722\07220722\07220722.dwg: X-SMCSO-TBLK 11/05/22

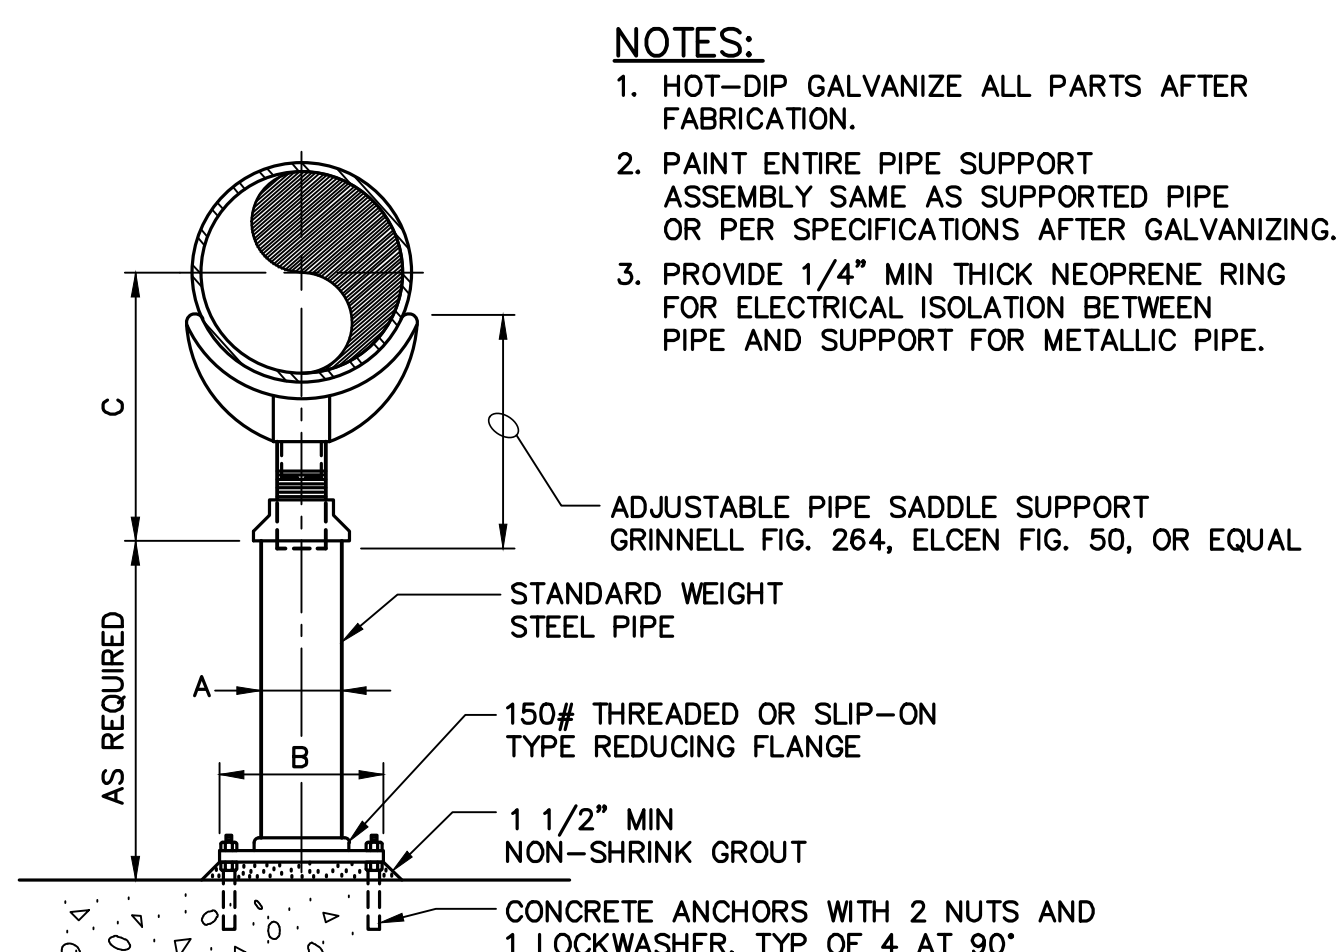


- NOTES:**
- HOT-DIP GALVANIZE ALL PARTS AFTER FABRICATION.
  - PAINT ENTIRE PIPE SUPPORT ASSEMBLY SAME AS SUPPORTED PIPE OR PER SPECIFICATIONS AFTER GALVANIZING.
  - PROVIDE 1/4" MIN THICK NEOPRENE RING FOR ELECTRICAL ISOLATION BETWEEN PIPE AND SUPPORT FOR METALLIC PIPE.

DIMENSIONS IN INCHES


PIPE SIZE	A	B	C MIN	C MAX
2 1/2	2 7/8	9	8	13
3	2 7/8	9	8 1/4	13 1/4
3 1/2	2 7/8	9	8 1/2	13 1/2
4	3 1/2	9	9 1/4	14
5	3 1/2	9	10	14 3/4
6	3 1/2	9	10 1/2	15 1/4
8	3 1/2	9	11 3/4	16 1/2
10	3 1/2	9	13 1/2	18 1/4
12	3 1/2	9	15	19 3/4
14	4 1/2	11	16 1/4	20 3/4
16	4 1/2	11	17 3/4	22 1/4

**ADJUSTABLE PIPE SUPPORT** (M100) NTS

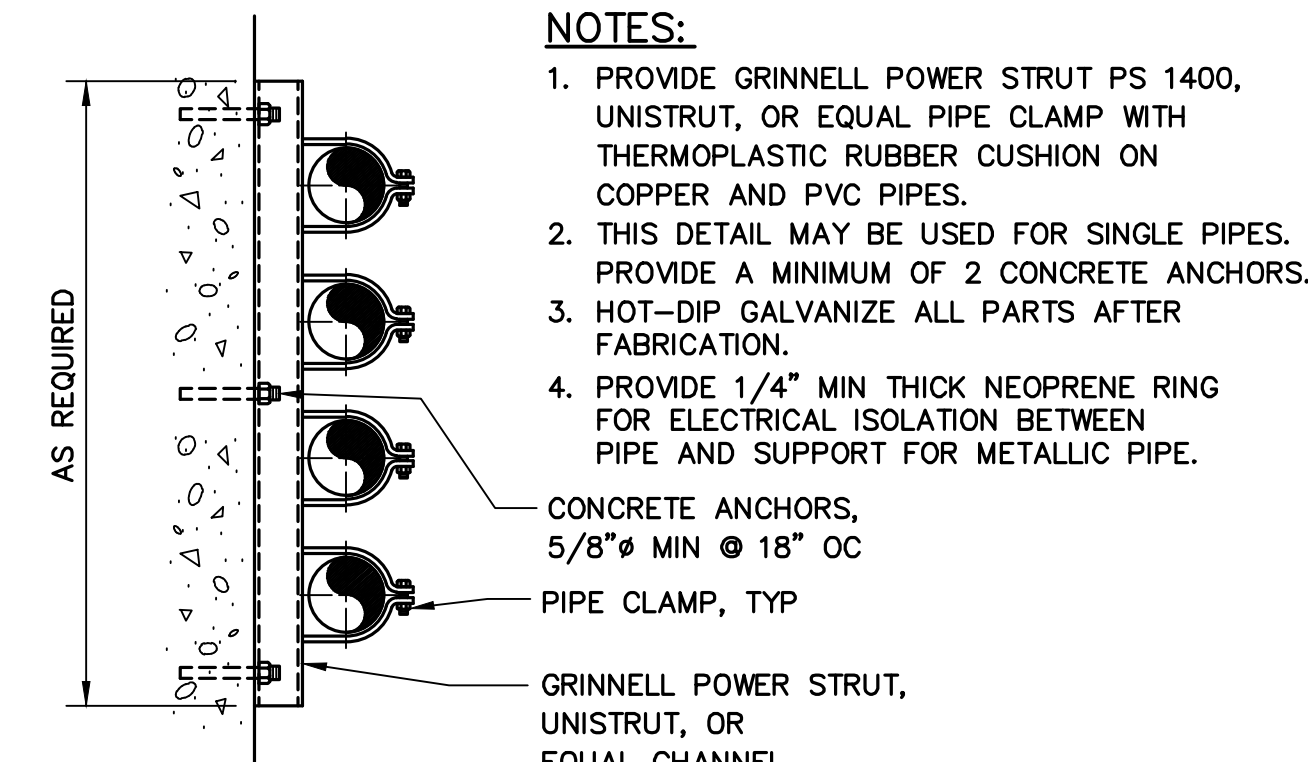


- NOTES:**
- PROVIDE GRINNELL POWER STRUT PS 1400, UNISTRUT, OR EQUAL PIPE CLAMP WITH THERMOPLASTIC RUBBER CUSHION ON COPPER AND PVC PIPES.
  - THIS DETAIL MAY BE USED FOR SINGLE PIPES. PROVIDE A MINIMUM OF 2 CONCRETE ANCHORS.
  - HOT-DIP GALVANIZE ALL PARTS AFTER FABRICATION.
  - PROVIDE 1/4" MIN THICK NEOPRENE RING FOR ELECTRICAL ISOLATION BETWEEN PIPE AND SUPPORT FOR METALLIC PIPE.

**WALL TYPE PIPE SUPPORT** (M104) NTS

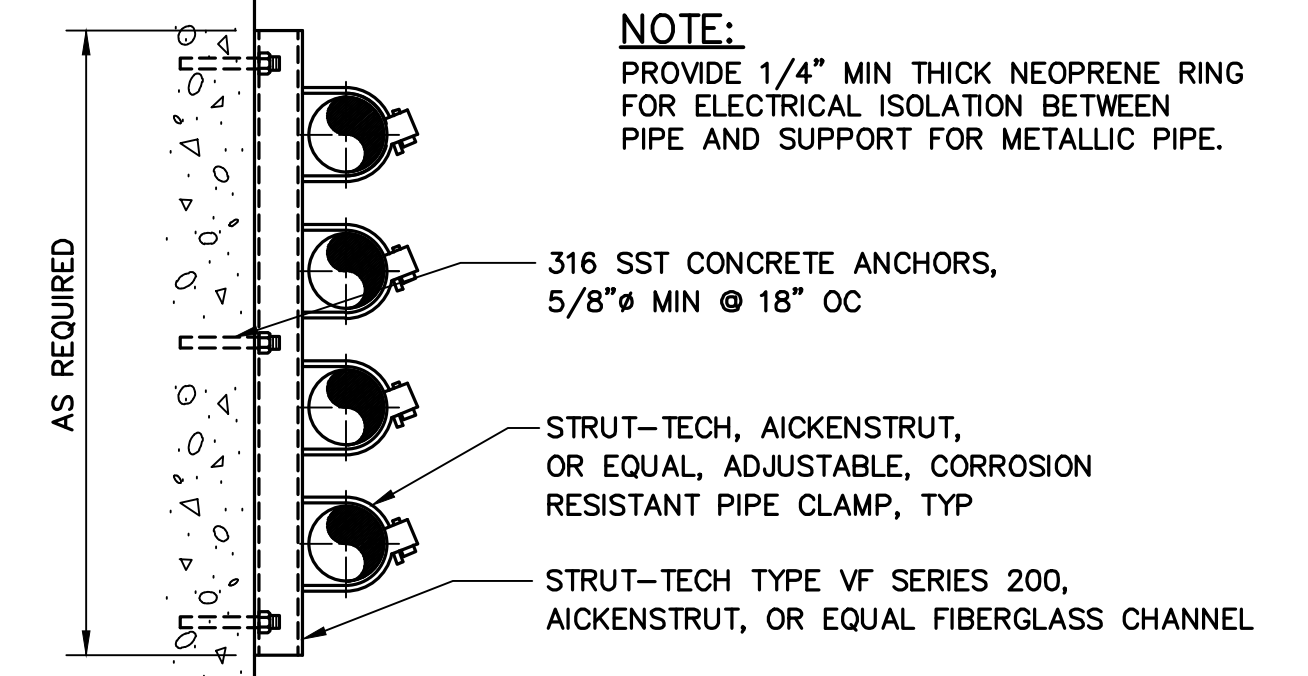


- NOTE:**
- PROVIDE 1/4" MIN THICK NEOPRENE RING FOR ELECTRICAL ISOLATION BETWEEN PIPE AND SUPPORT FOR METALLIC PIPE.

**CORROSION RESISTANT WALL TYPE PIPE SUPPORT** (M106) NTS

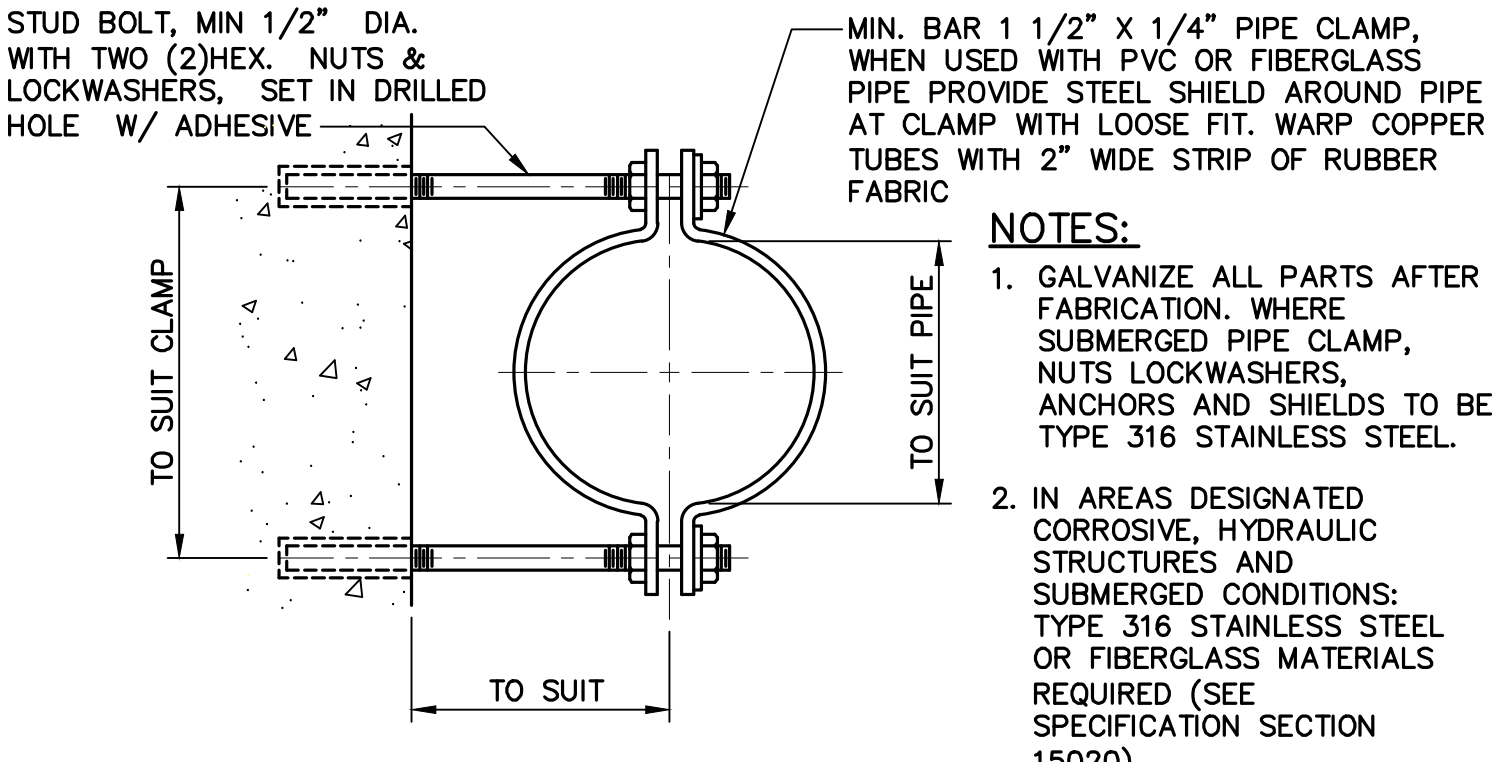


- NOTES:**
- GALVANIZE ALL PARTS AFTER FABRICATION. WHERE SUBMERGED PIPE CLAMP, NUTS LOCKWASHERS, ANCHORS AND SHIELDS TO BE TYPE 316 STAINLESS STEEL.
  - IN AREAS DESIGNATED CORROSIVE, HYDRAULIC STRUCTURES AND SUBMERGED CONDITIONS: TYPE 316 STAINLESS STEEL OR FIBERGLASS MATERIALS REQUIRED (SEE SPECIFICATION SECTION 15020).

**PIPE CLAMP DETAIL** (M111) NTS

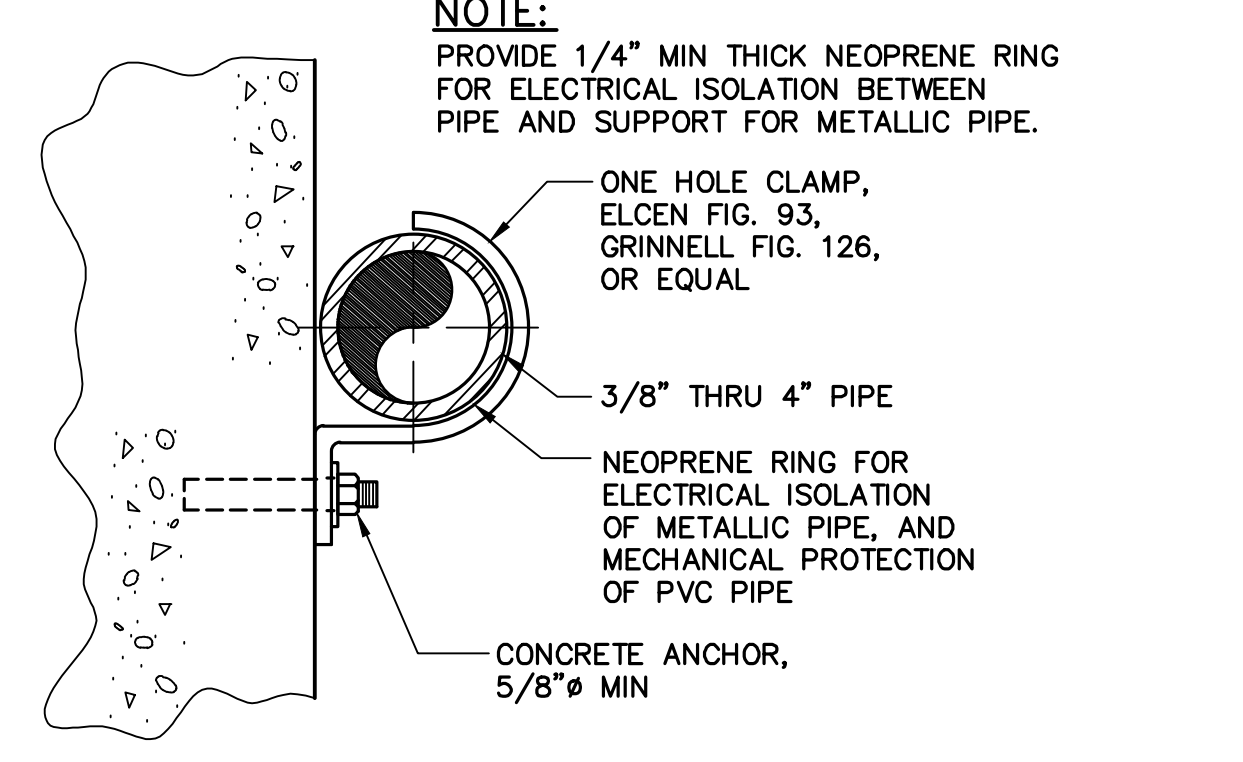


**PIPE SUPPORT** (M114) NTS

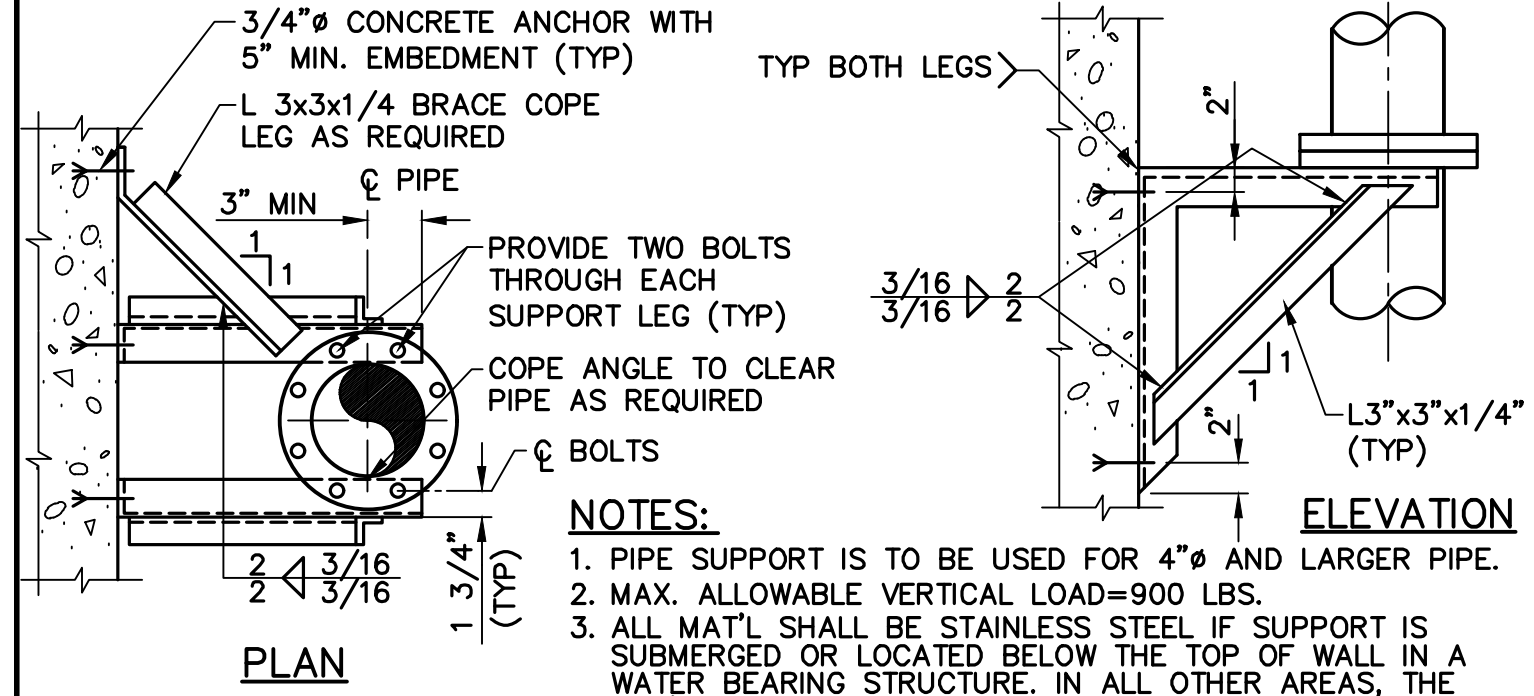


- NOTES:**
- PIPE SUPPORT IS TO BE USED FOR 4" AND LARGER PIPE.
  - MAX. ALLOWABLE VERTICAL LOAD=900 LBS.
  - ALL MAT'L SHALL BE STAINLESS STEEL IF SUPPORT IS SUBMERGED OR LOCATED BELOW THE TOP OF WALL IN A WATER BEARING STRUCTURE. IN ALL OTHER AREAS, THE MAT'L SHALL BE HOT-DIP GAL. STEEL UNLESS OTHERWISE INDICATED ON THE DRAWINGS.
  - FIELD PAINT GALVANIZED STEEL PER THE SPECIFICATIONS.


**PIPE SUPPORT** (M115) NTS

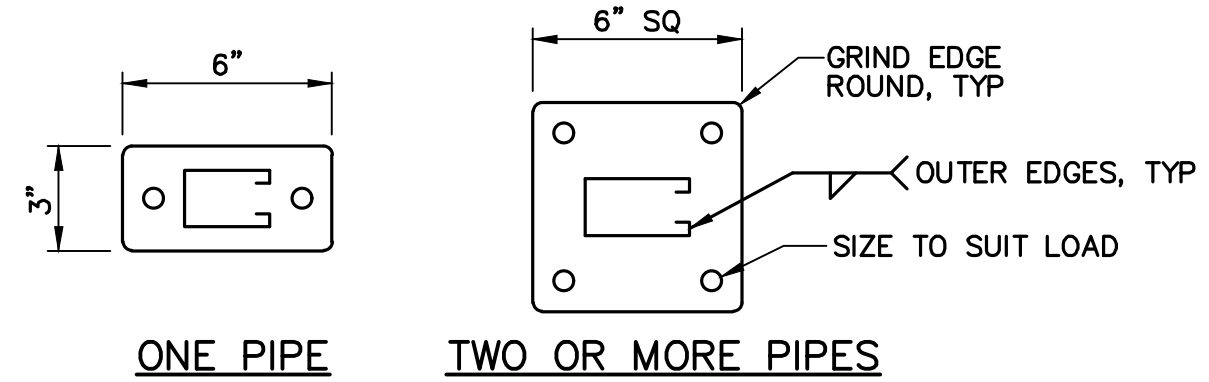


- NOTES:**
- PROVIDE GRINNELL POWER STRUT PS 1400, UNISTRUT, OR EQUAL PIPE CLAMP WITH THERMOPLASTIC RUBBER CUSHION ON COPPER AND PVC PIPES.
  - MAXIMUM PIPE SIZE IS 4".
  - HOT-DIP GALVANIZE ALL PARTS AFTER FABRICATION.
  - PROVIDE 1/4" MIN THICK NEOPRENE RING FOR ELECTRICAL ISOLATION BETWEEN PIPE AND SUPPORT FOR METALLIC PIPE.

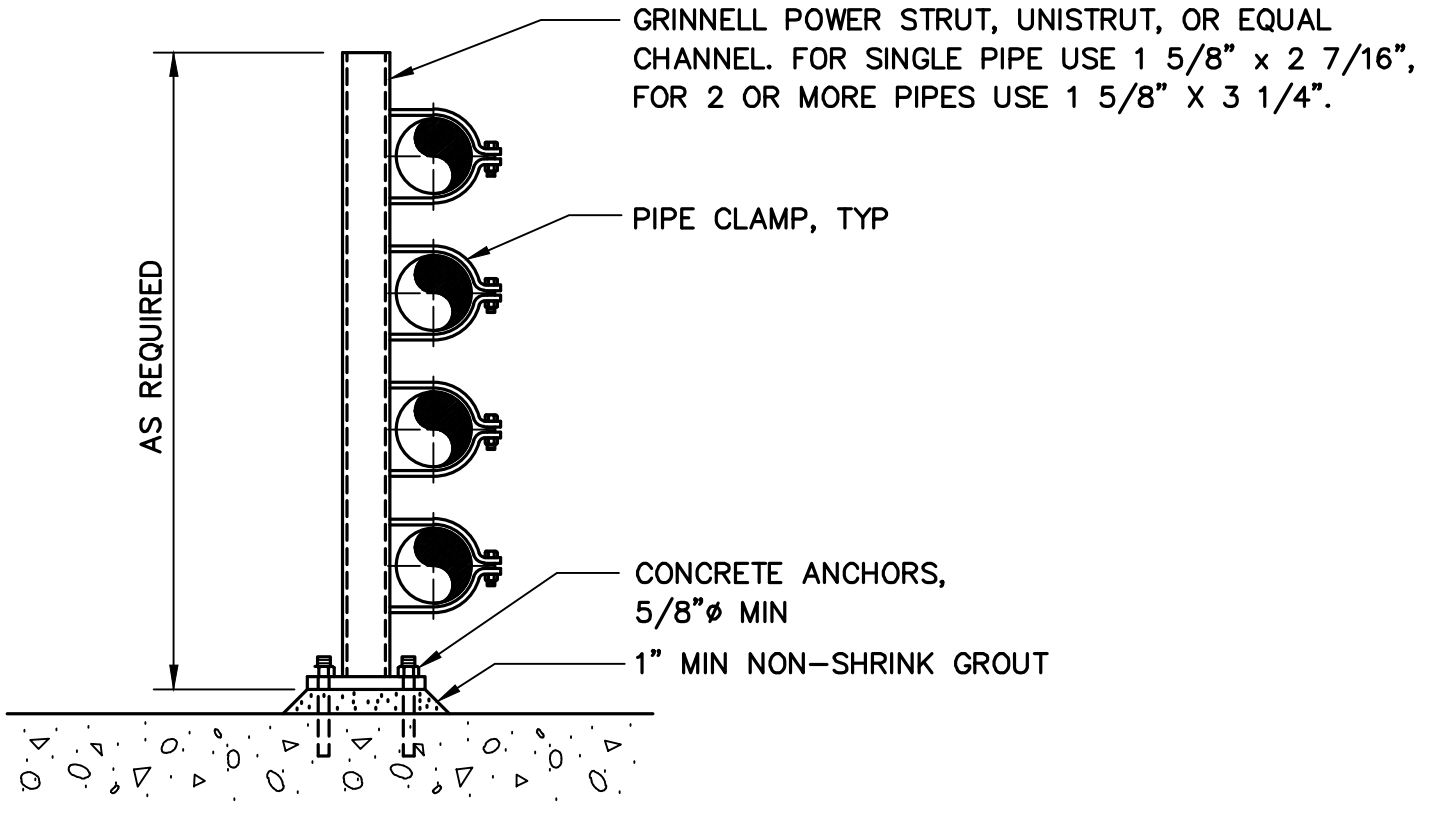

**PIPE STANCHION** (M102) NTS


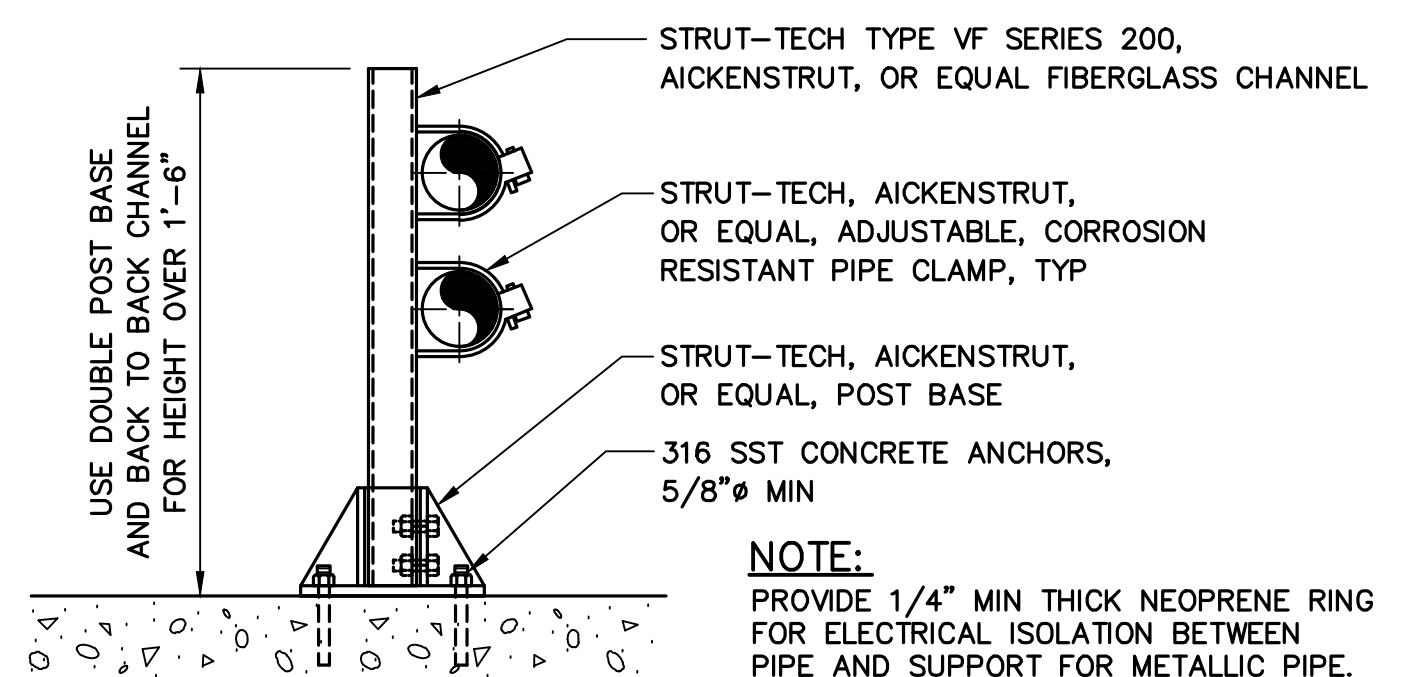


**CORROSION RESISTANT PIPE STANCHION** (M108) NTS

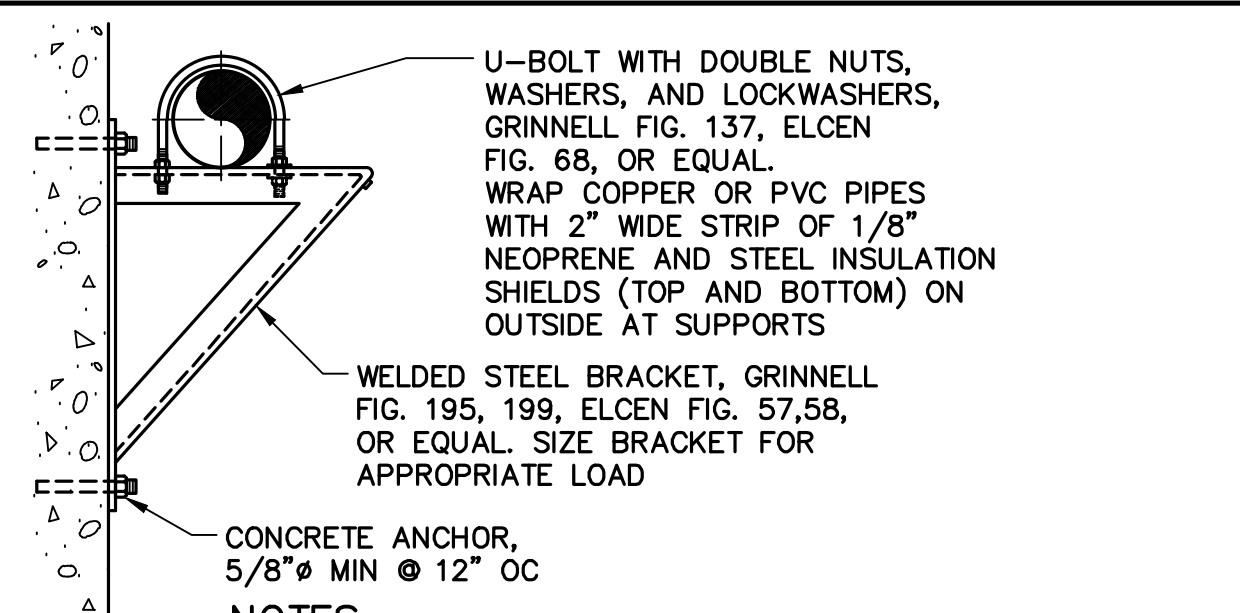

- NOTES:**
- HOT-DIP GALVANIZE ALL PARTS AFTER FABRICATION.
  - PROVIDE 1/4" MIN THICK NEOPRENE RING FOR ELECTRICAL ISOLATION BETWEEN PIPE AND SUPPORT FOR METALLIC PIPE.

**PIPE BRACKET** (M110) NTS

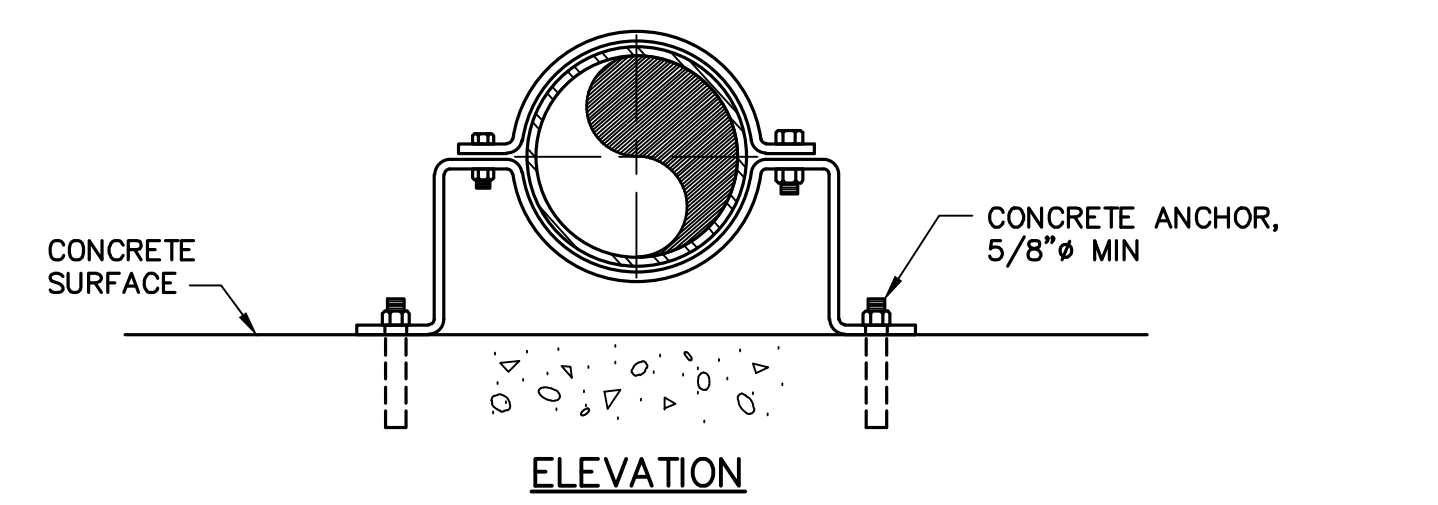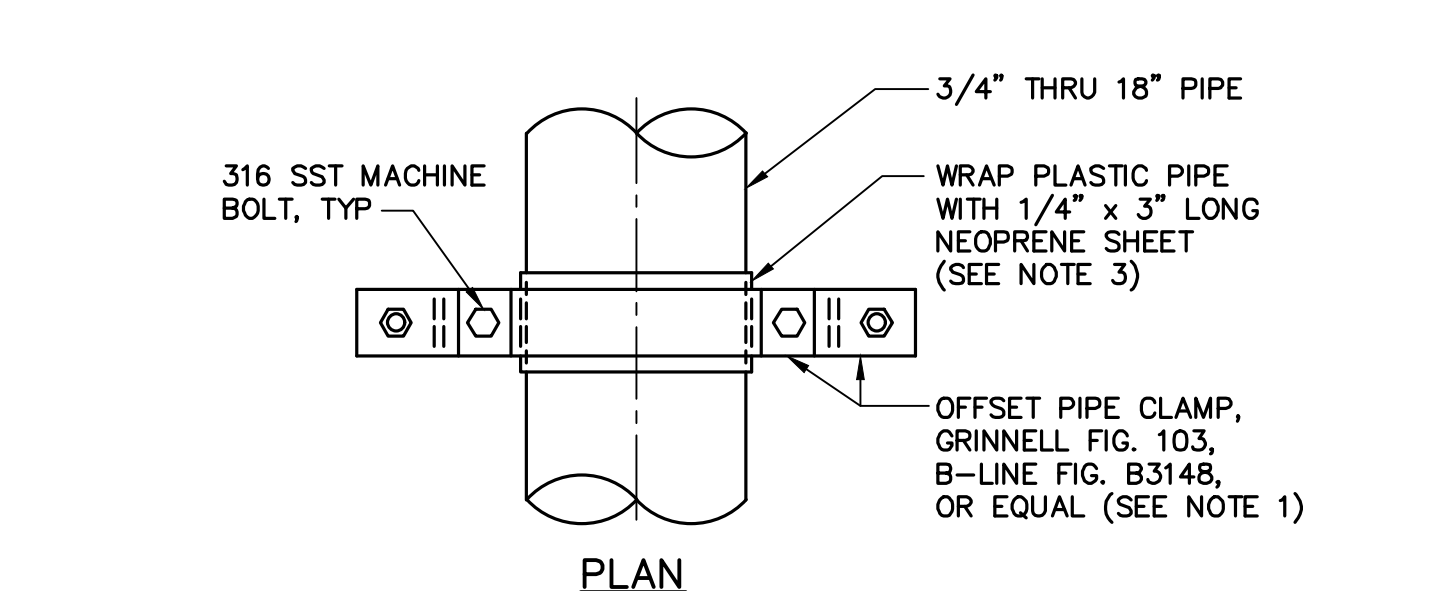

- NOTES:**
- HOT-DIP GALVANIZE ALL PARTS AFTER FABRICATION. WHERE PIPE SUPPORT IS SUBMERGED, LOCATED BELOW THE TOP OF WALL IN A WATER BEARING STRUCTURE, PIPE CLAMP SHALL BE 316 STAINLESS STEEL.
  - PROVIDE 1/4" MIN THICK NEOPRENE RING FOR ELECTRICAL ISOLATION BETWEEN PIPE AND SUPPORT FOR METALLIC PIPE.
  - PROVIDE 1/4" MIN THICK NEOPRENE RING FOR ELECTRICAL ISOLATION BETWEEN PIPE AND SUPPORT FOR METALLIC PIPE.

**PIPE SUPPORT** (M112) NTS

FILENAME: 0055-006-M-2 8-01-22 11:28am cto XREFS: X-SMCSO-TBLK ICS

**RECORD DRAWING**  
THIS RECORD DRAWING HAS BEEN PREPARED FROM THE ORIGINAL CONTRACT DOCUMENTS SIGNED AND SEALED BY THE RESPONSIBLE ENGINEER OF RECORD. ADDITIONAL INFORMATION HAS BEEN PROVIDED BY OTHERS TO REPRESENT AS-CONSTRUCTED CONDITION AND IS SHOWN ON THESE RECORD DRAWINGS. THE RESPONSIBLE ENGINEER OF RECORD CANNOT VERIFY THE ACCURACY OF THE AS-CONSTRUCTED CONDITION INFORMATION REPRESENTED ON THE RECORD DRAWINGS.

0" = 1"  
VERIFY SCALES - BAR IS ONE INCH LONG ON FULL SIZE DRAWING. IF NOT ONE INCH LONG ON THIS DRAWING, ADJUST SCALES ACCORDINGLY







REV	DATE	BY	APVD	DESCRIPTION
▲	07/22	CT	TV	RECORD DRAWING

DESIGNED M. TAKEMOTO  
DRAWN S. JUNG  
CHECKED M. NAKAMOTO

SUBMITTED: MARK TAKEMOTO  
RMC PROJECT ENGINEER CE-64369  
APPROVED: STEVE CLARY  
RMC ENGINEER CE-30318



TREATMENT AND WET WEATHER FLOW UPGRADE  
MECHANICAL STANDARD DETAILS - 2  
DWG NO M-2  
SHEET NO 114 OF 226  
PROJ NO 055-006  
DATE JULY 2022

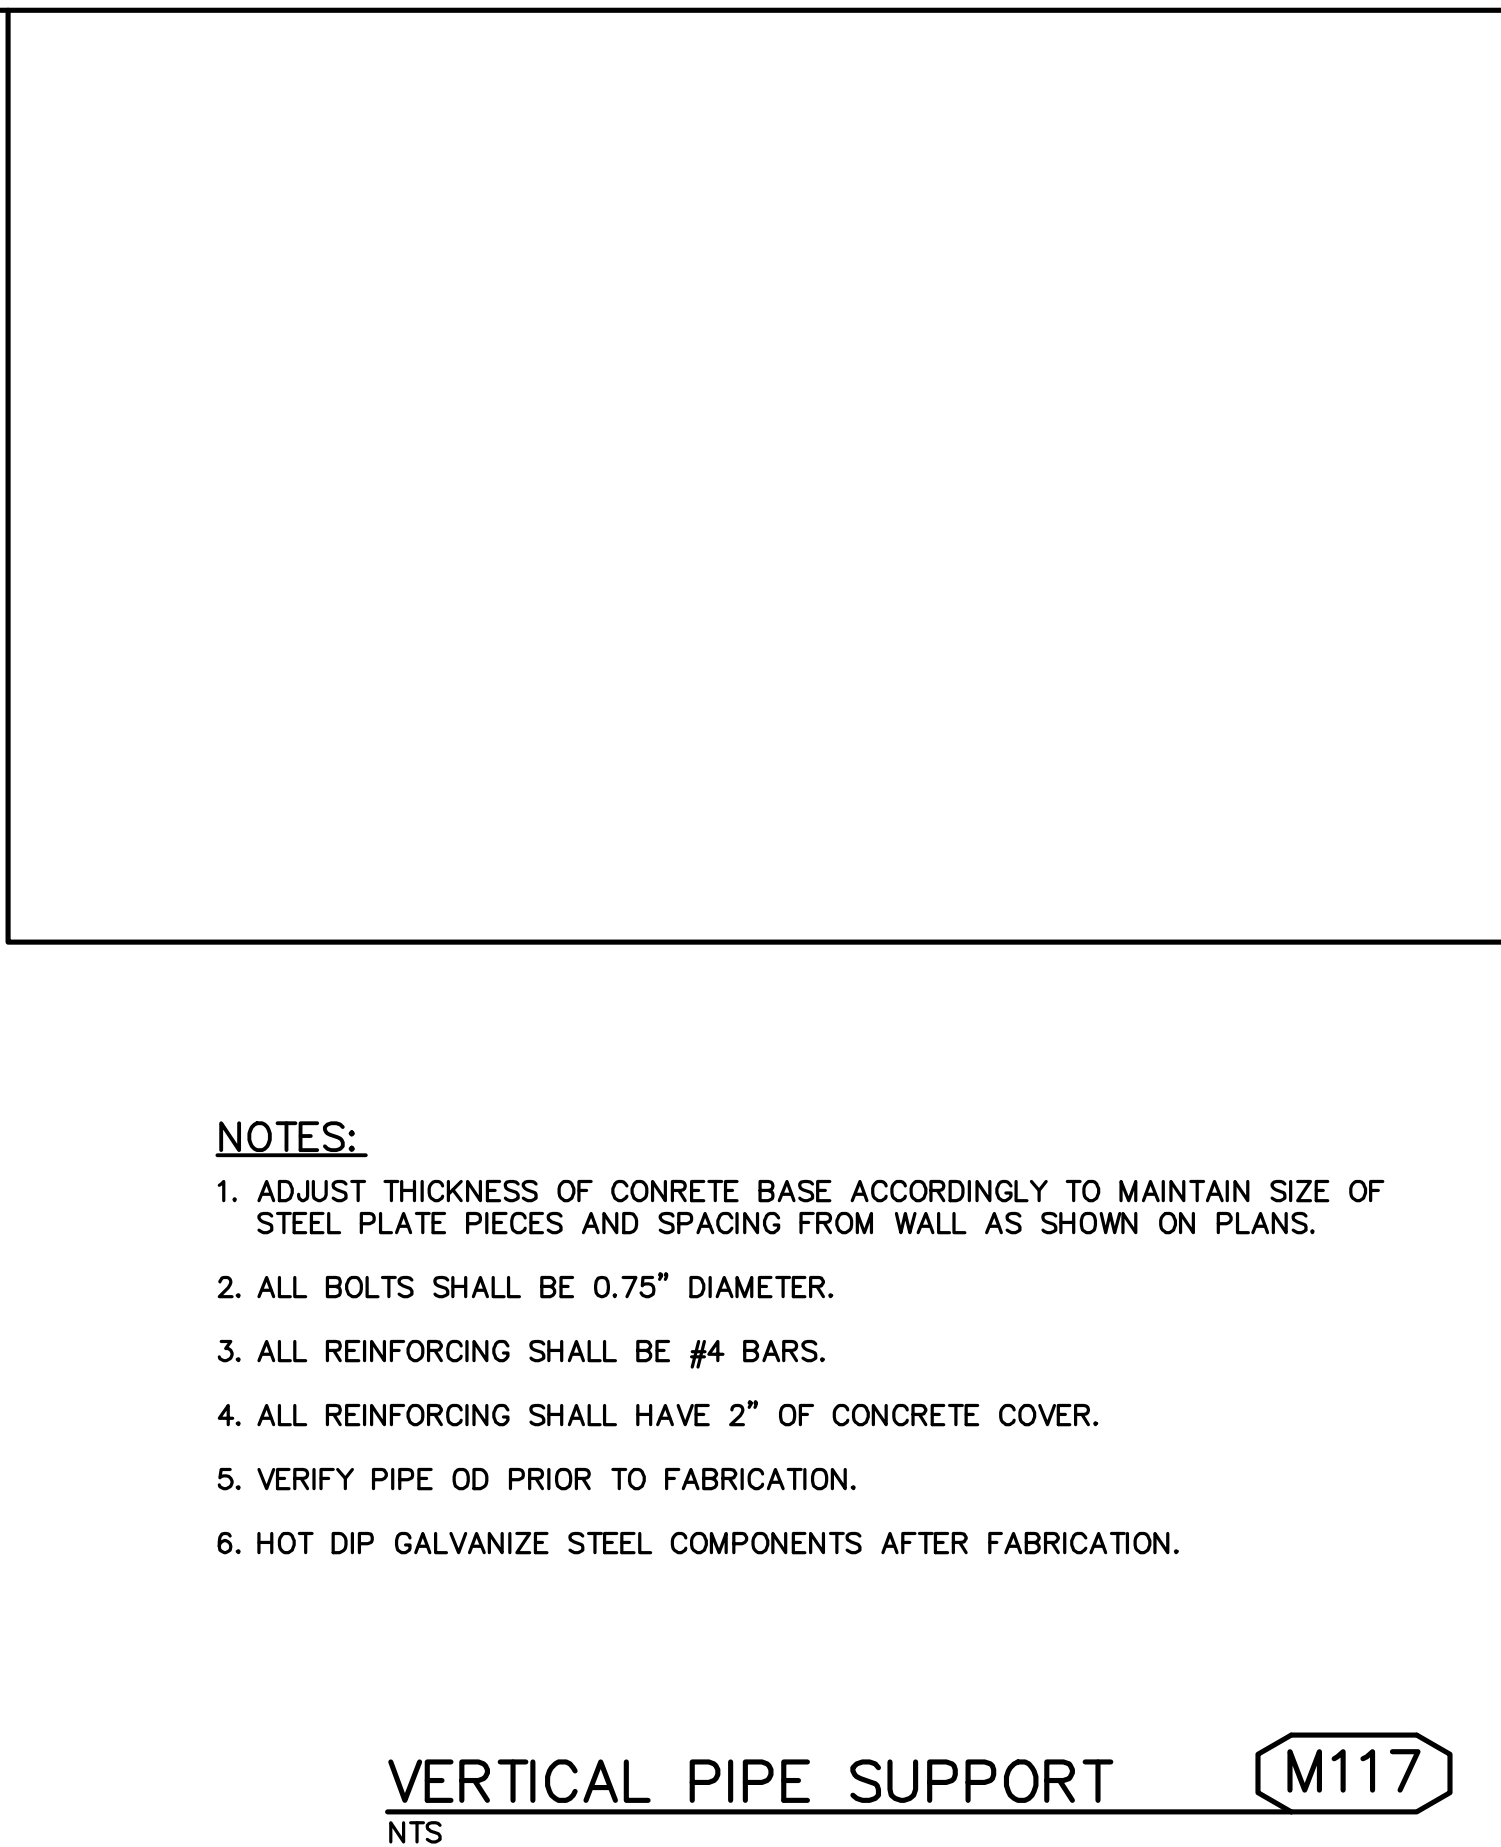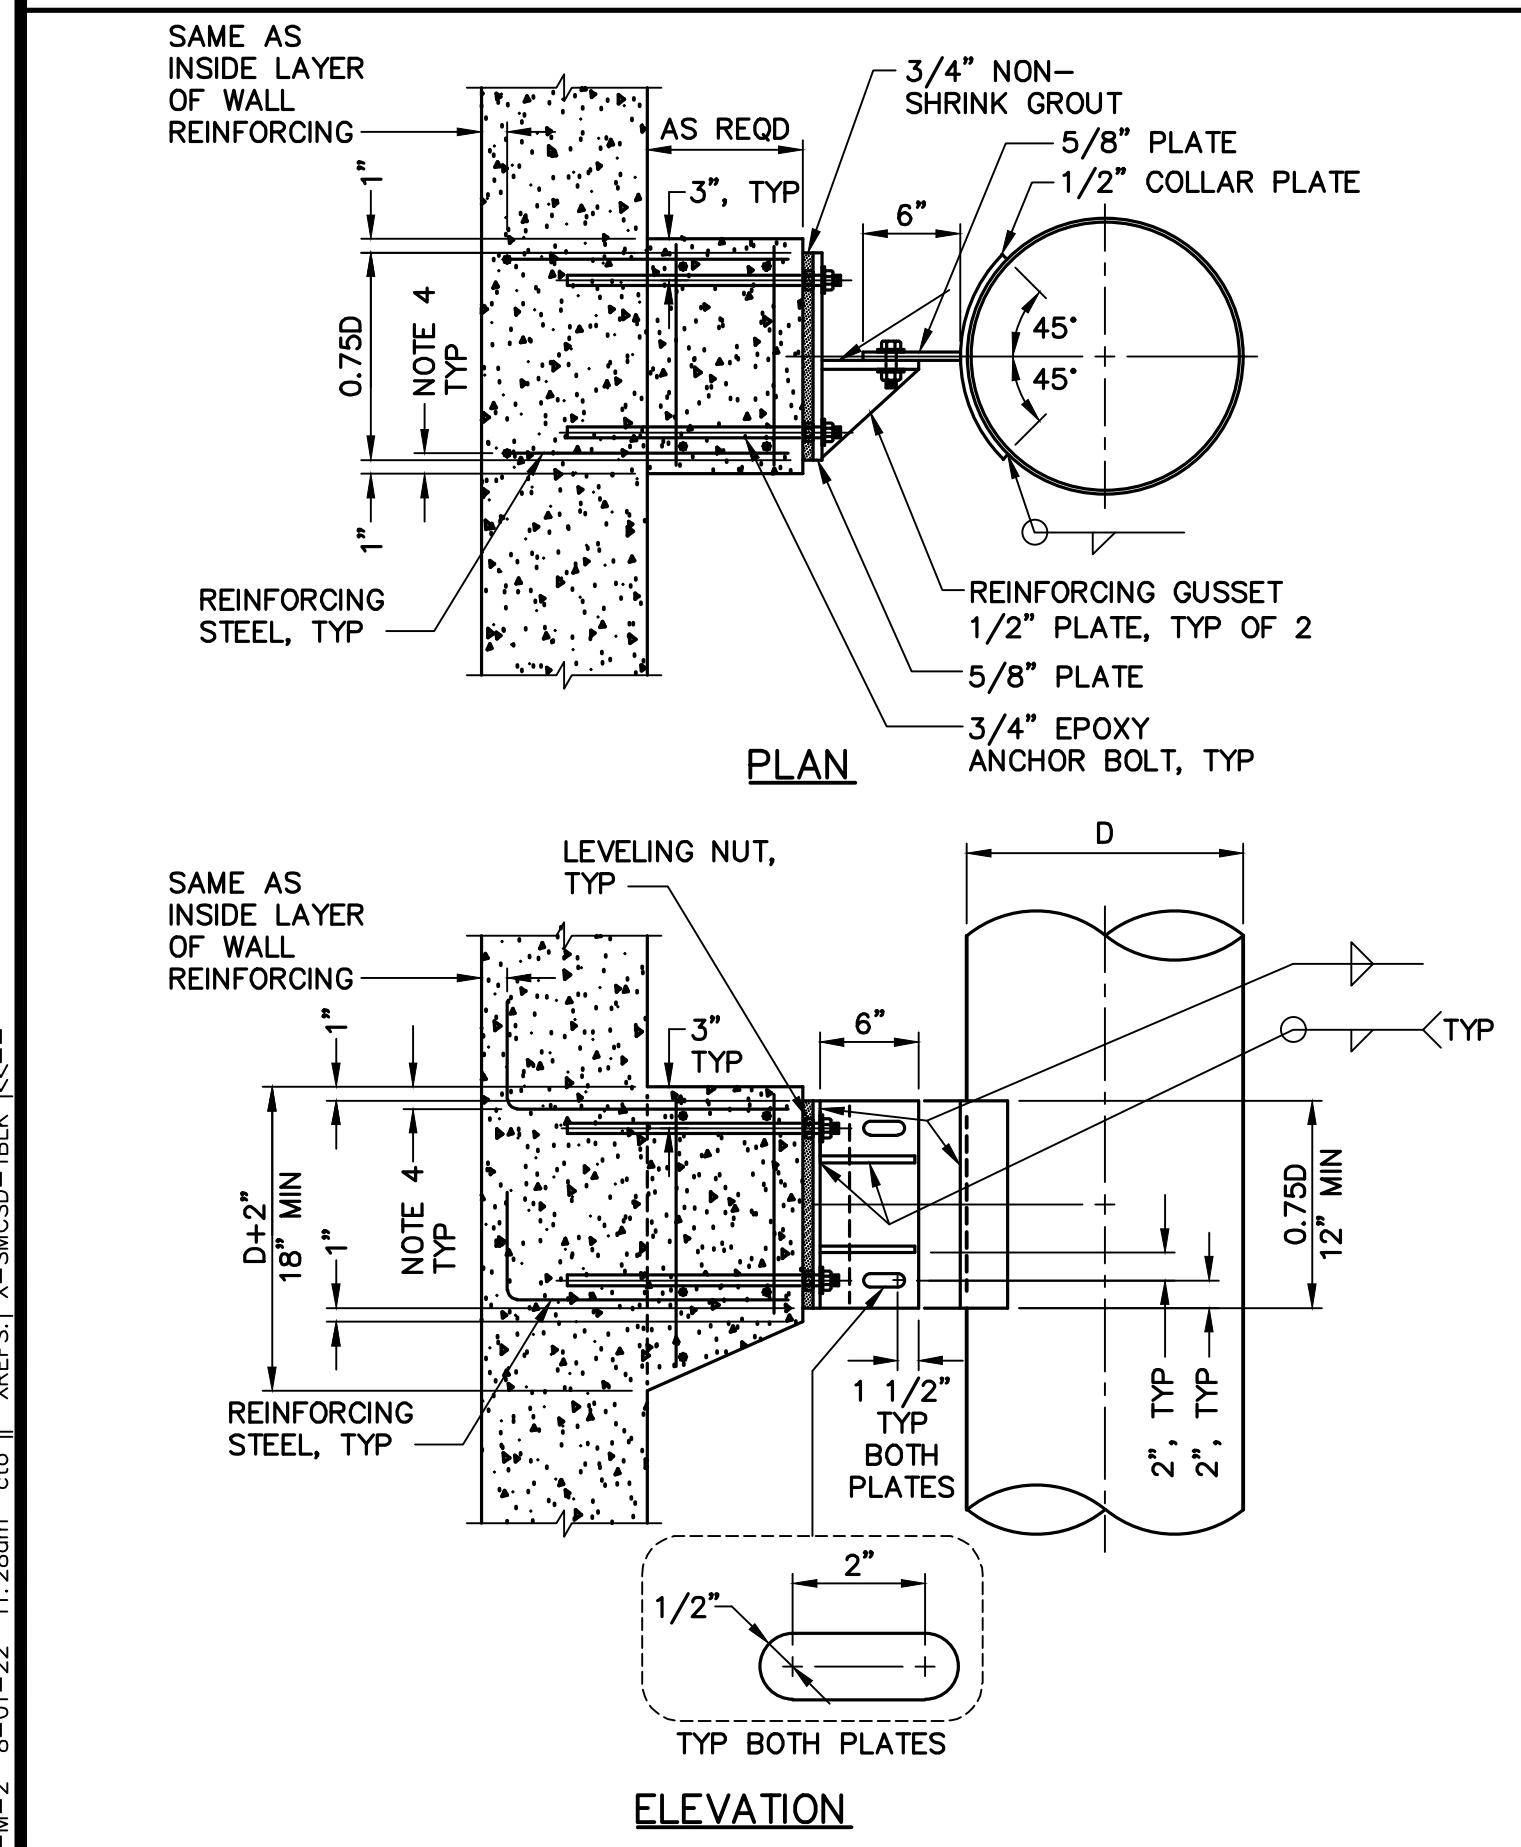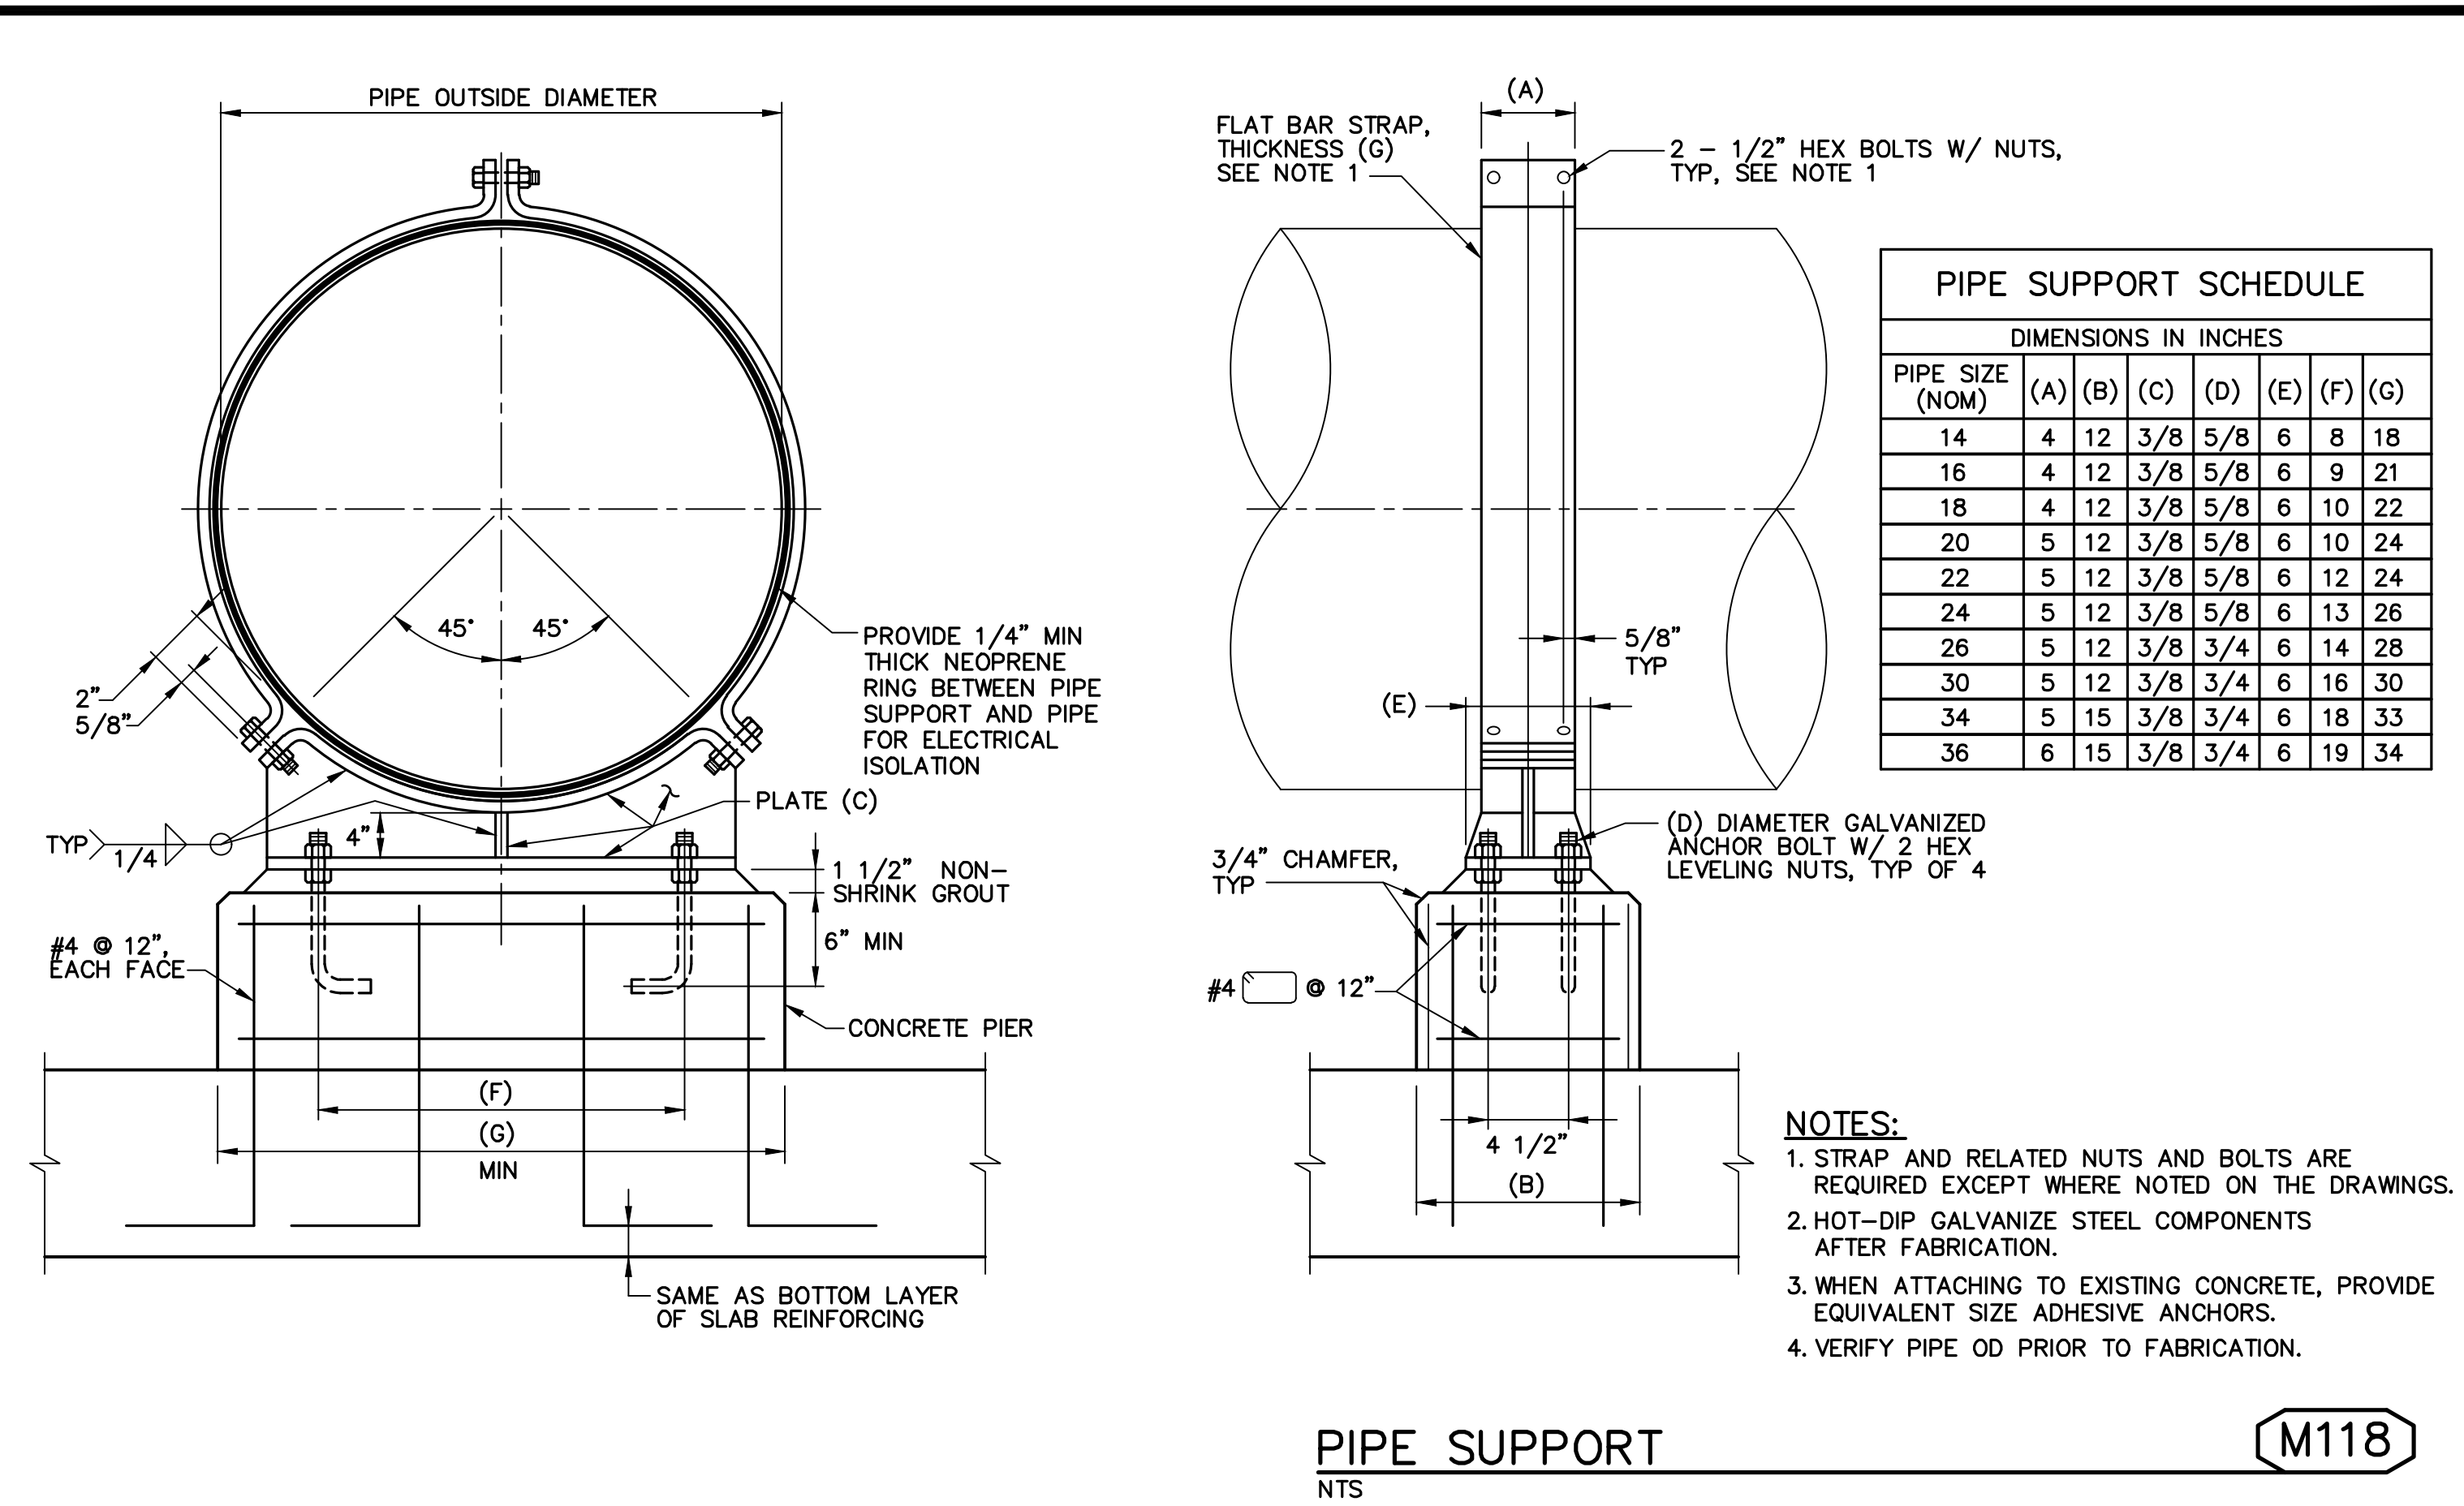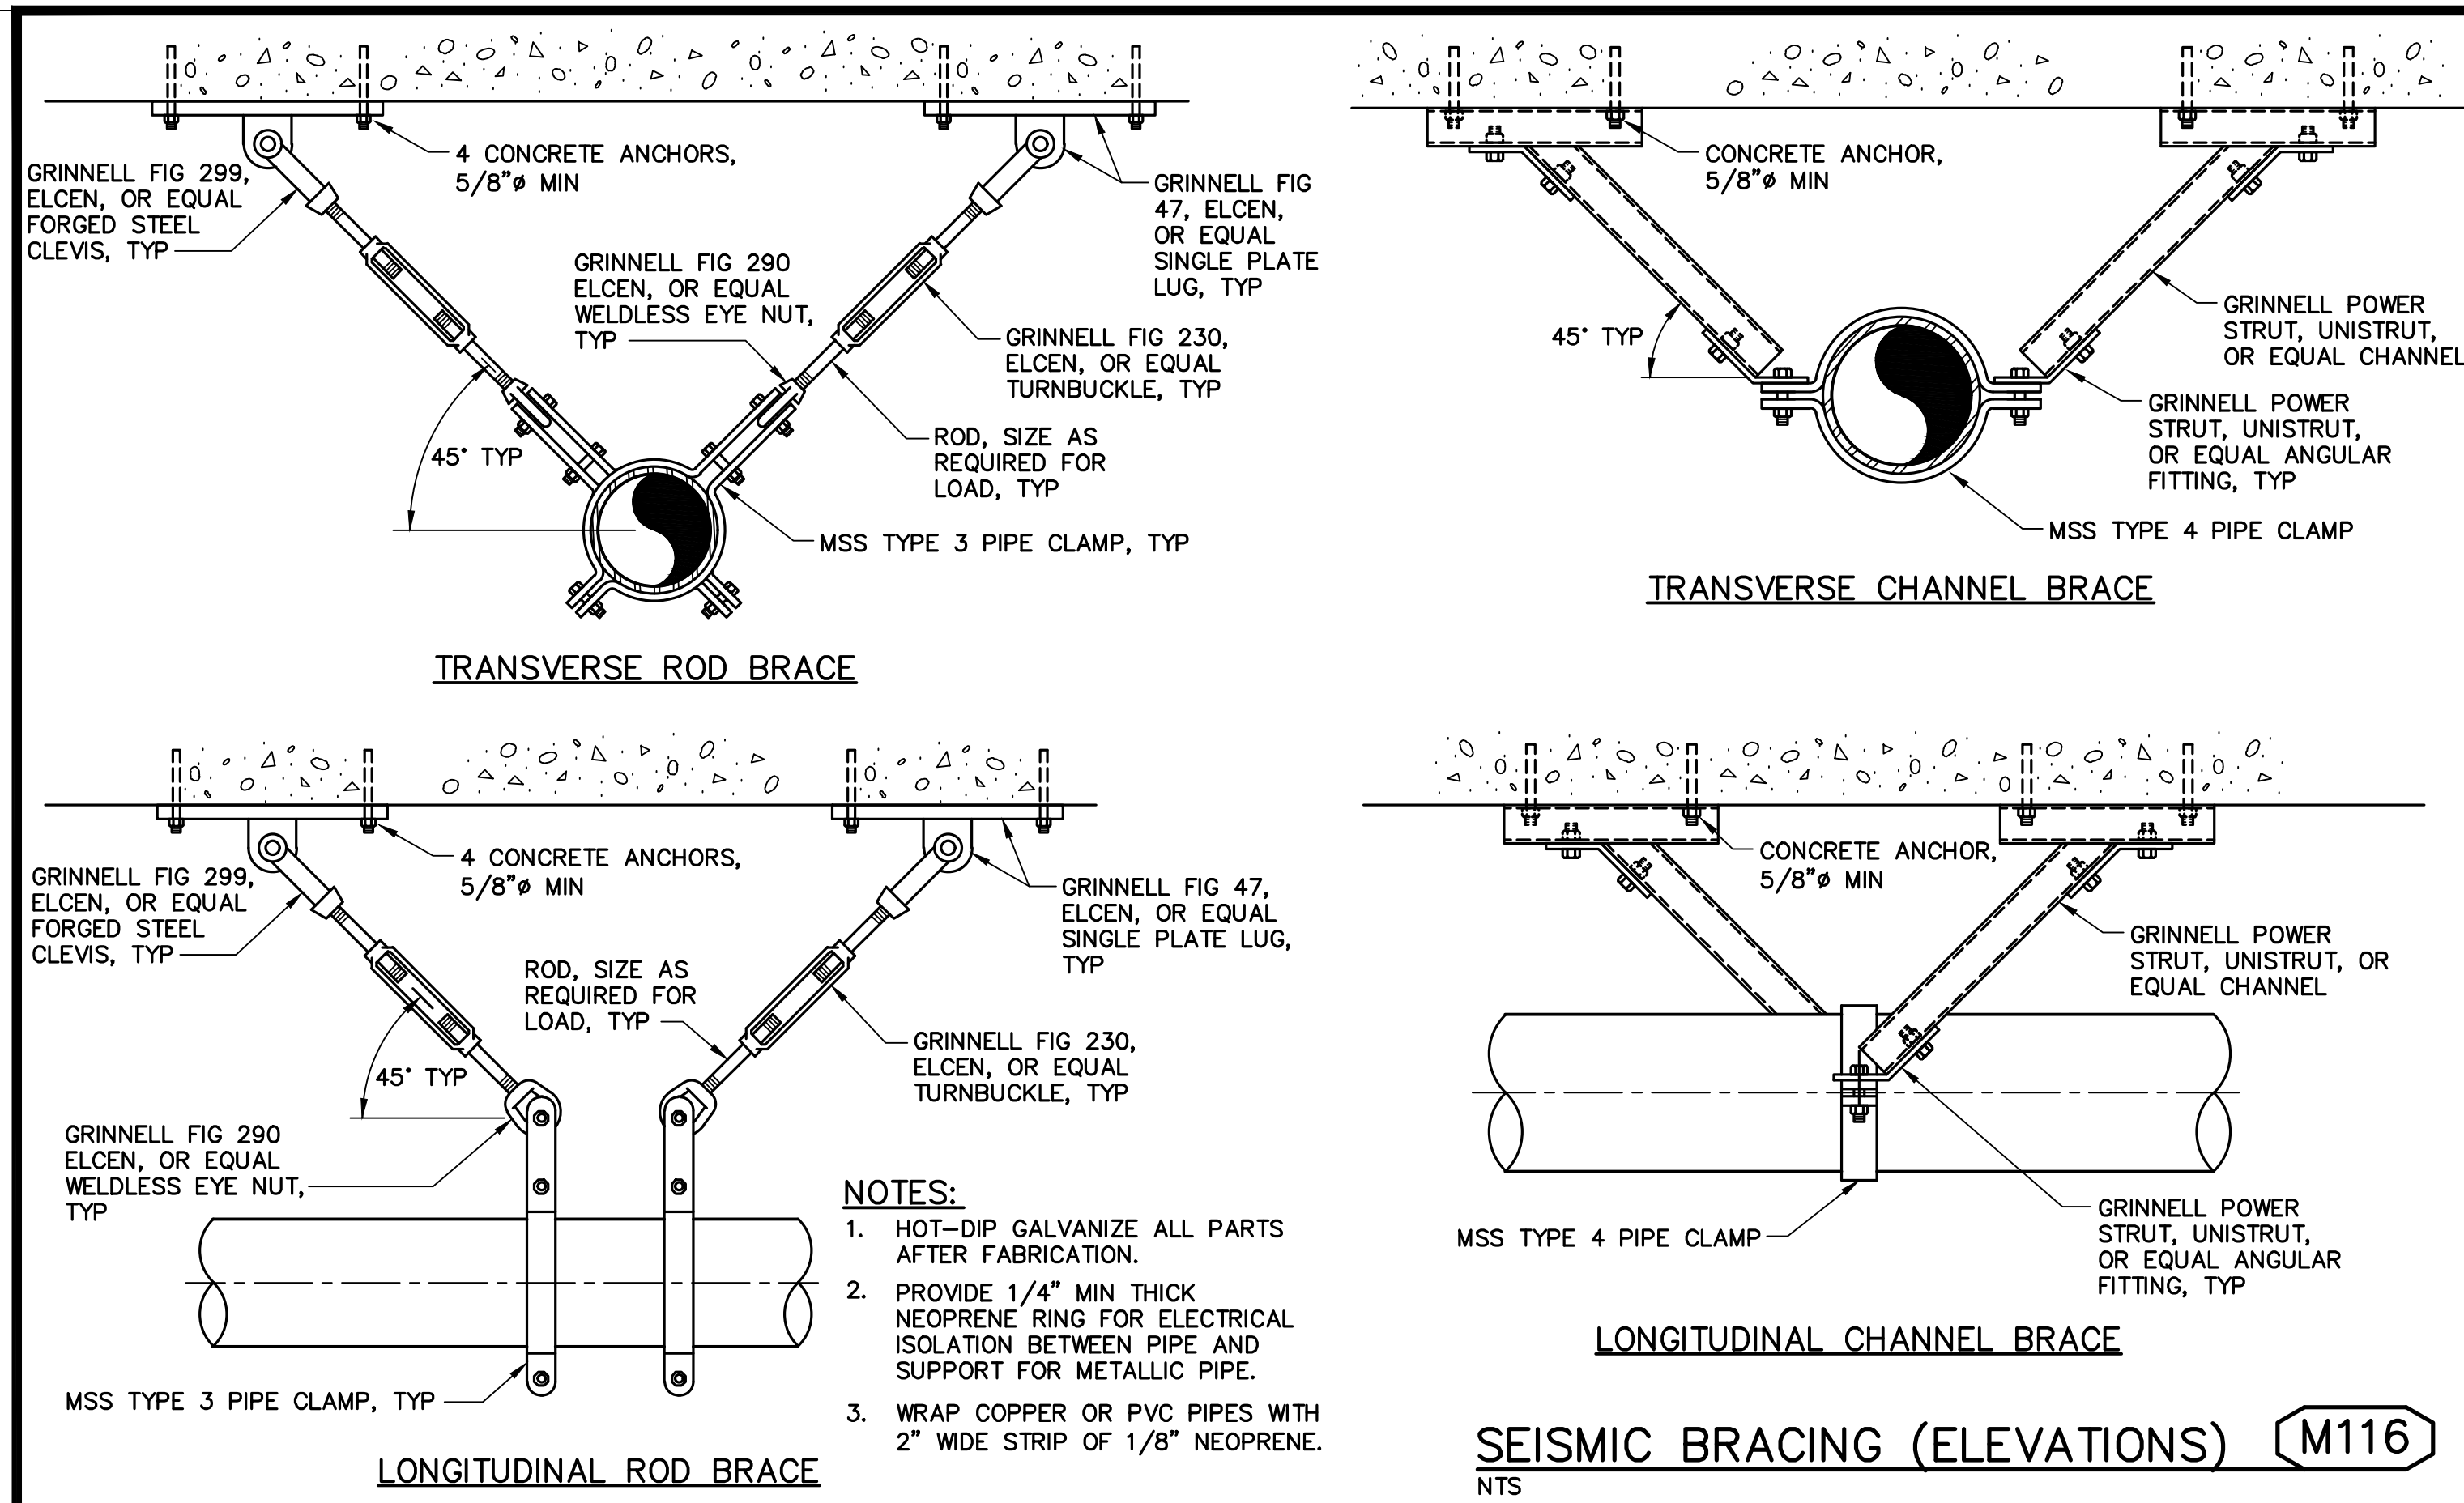

**RECORD DRAWING**  
 THIS RECORD DRAWING HAS BEEN PREPARED FROM THE ORIGINAL CONTRACT DOCUMENTS SIGNED AND SEALED BY THE RESPONSIBLE ENGINEER OF RECORD. ADDITIONAL INFORMATION HAS BEEN PROVIDED BY OTHERS TO REPRESENT AS-CONSTRUCTED CONDITION AND IS SHOWN ON THESE RECORD DRAWINGS. THE RESPONSIBLE ENGINEER OF RECORD CANNOT VERIFY THE ACCURACY OF THE AS-CONSTRUCTED CONDITION INFORMATION REPRESENTED ON THE RECORD DRAWINGS.

0" = 1"  
 VERIFY SCALES — BAR IS ONE INCH LONG ON FULL SIZE DRAWING. IF NOT ONE INCH LONG ON THIS DRAWING, ADJUST SCALES ACCORDINGLY



REV	DATE	BY	APVD	DESCRIPTION
1	07/22	CT	TV	RECORD DRAWING


DESIGNED M. TAKEMOTO  
 DRAWN S. JUNG  
 CHECKED M. NAKAMOTO

SUBMITTED: MARK TAKEMOTO  
 RMC PROJECT ENGINEER CE-64369  
 APPROVED: STEVE CLARY  
 RMC ENGINEER CE-30318




TREATMENT AND WET WEATHER FLOW UPGRADE  
 MECHANICAL STANDARD DETAILS - 3  
 DWG NO M-3  
 SHEET NO 115 OF 226  
 PROJ NO 055-006  
 DATE JULY 2022


FILENAME: 0055-006-M-2\_8-01-22\_11:28am.ctb XREFS: X-SMCS00-TBLK.ccb

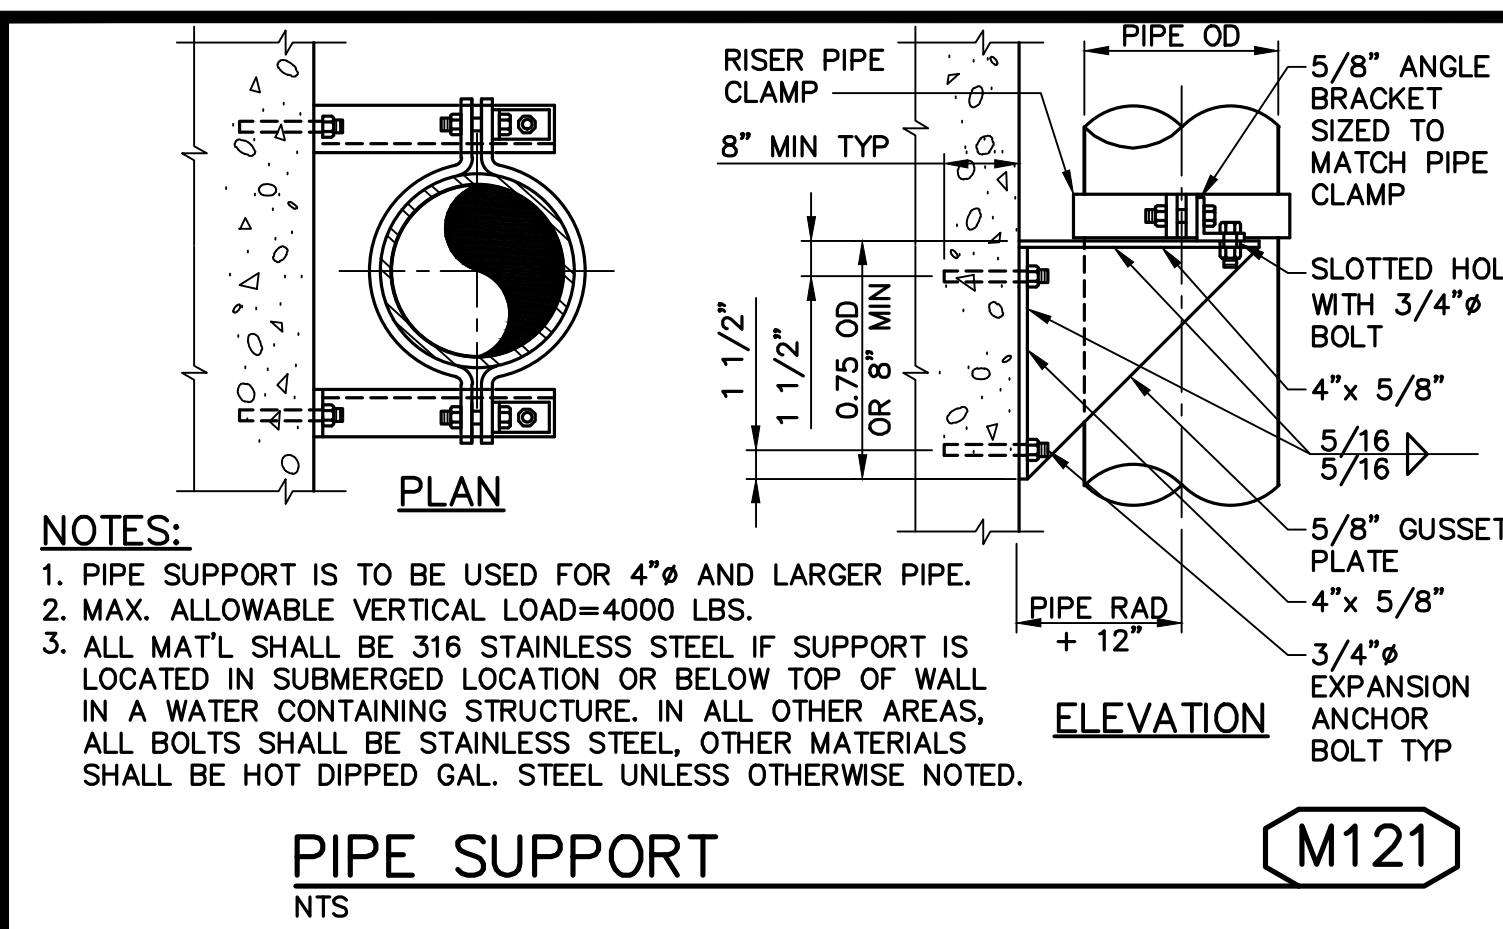


**PIPE SUPPORT** M121  
NTS

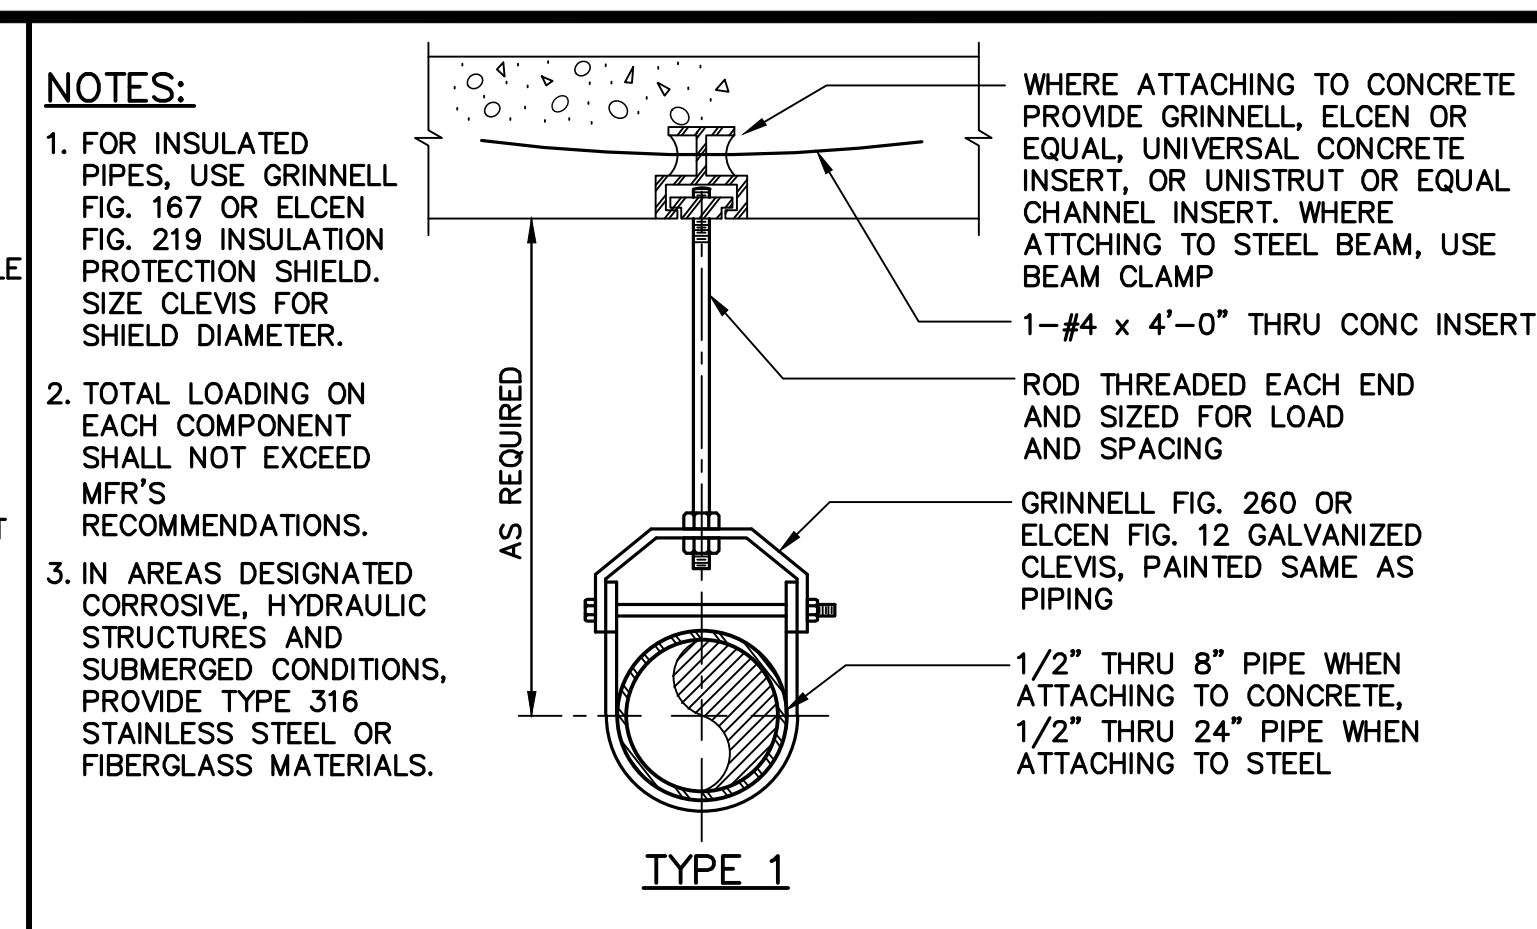


**TYPE 1**

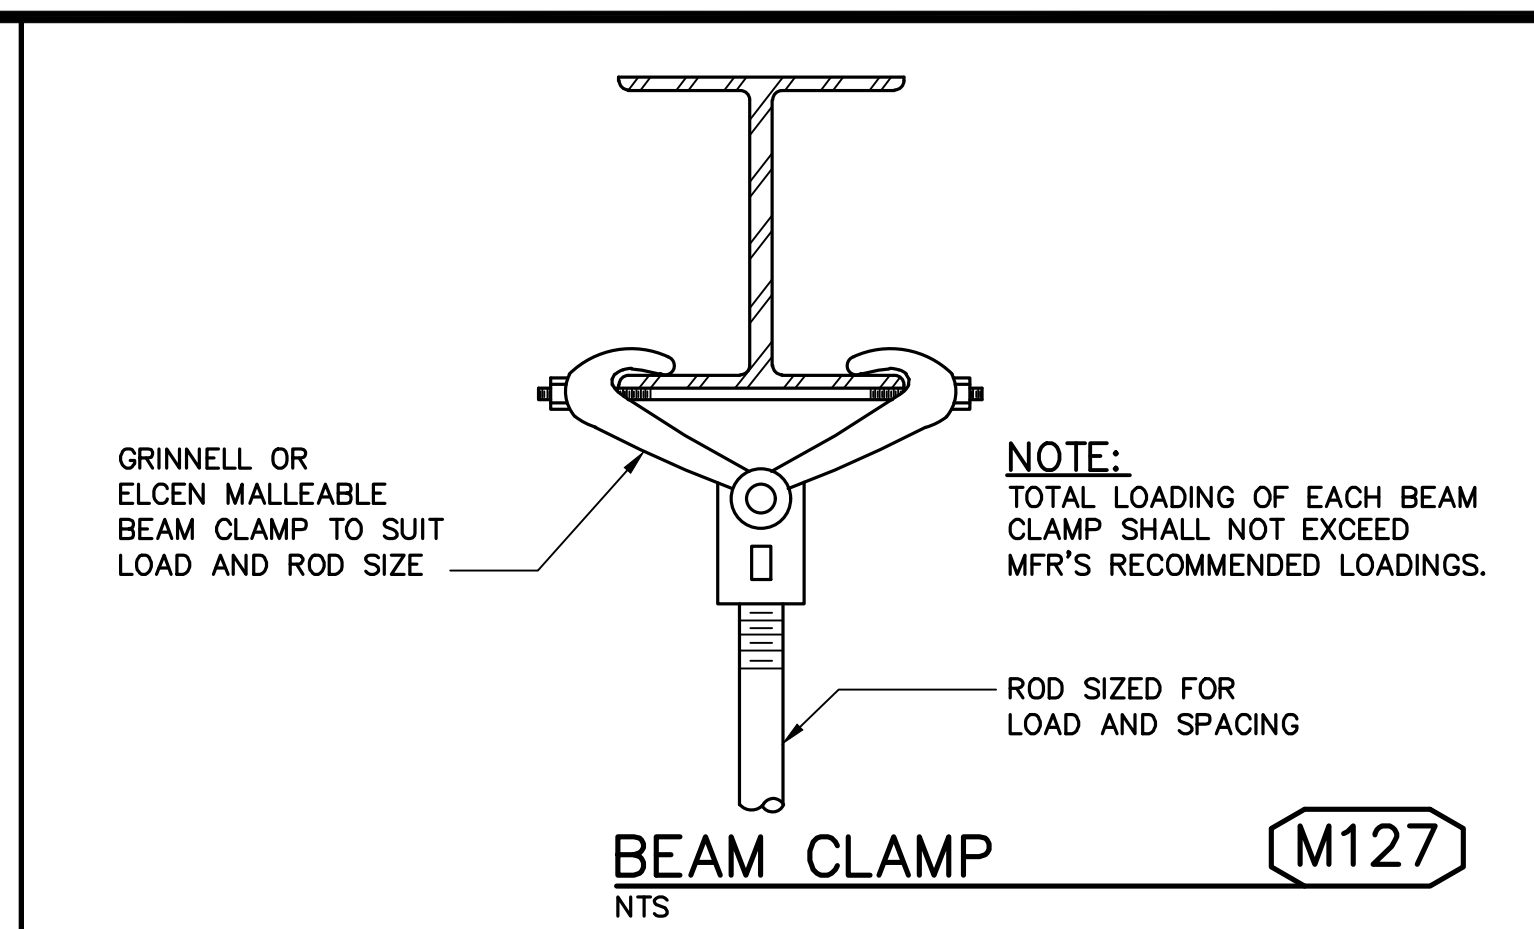


**BEAM CLAMP** M127  
NTS

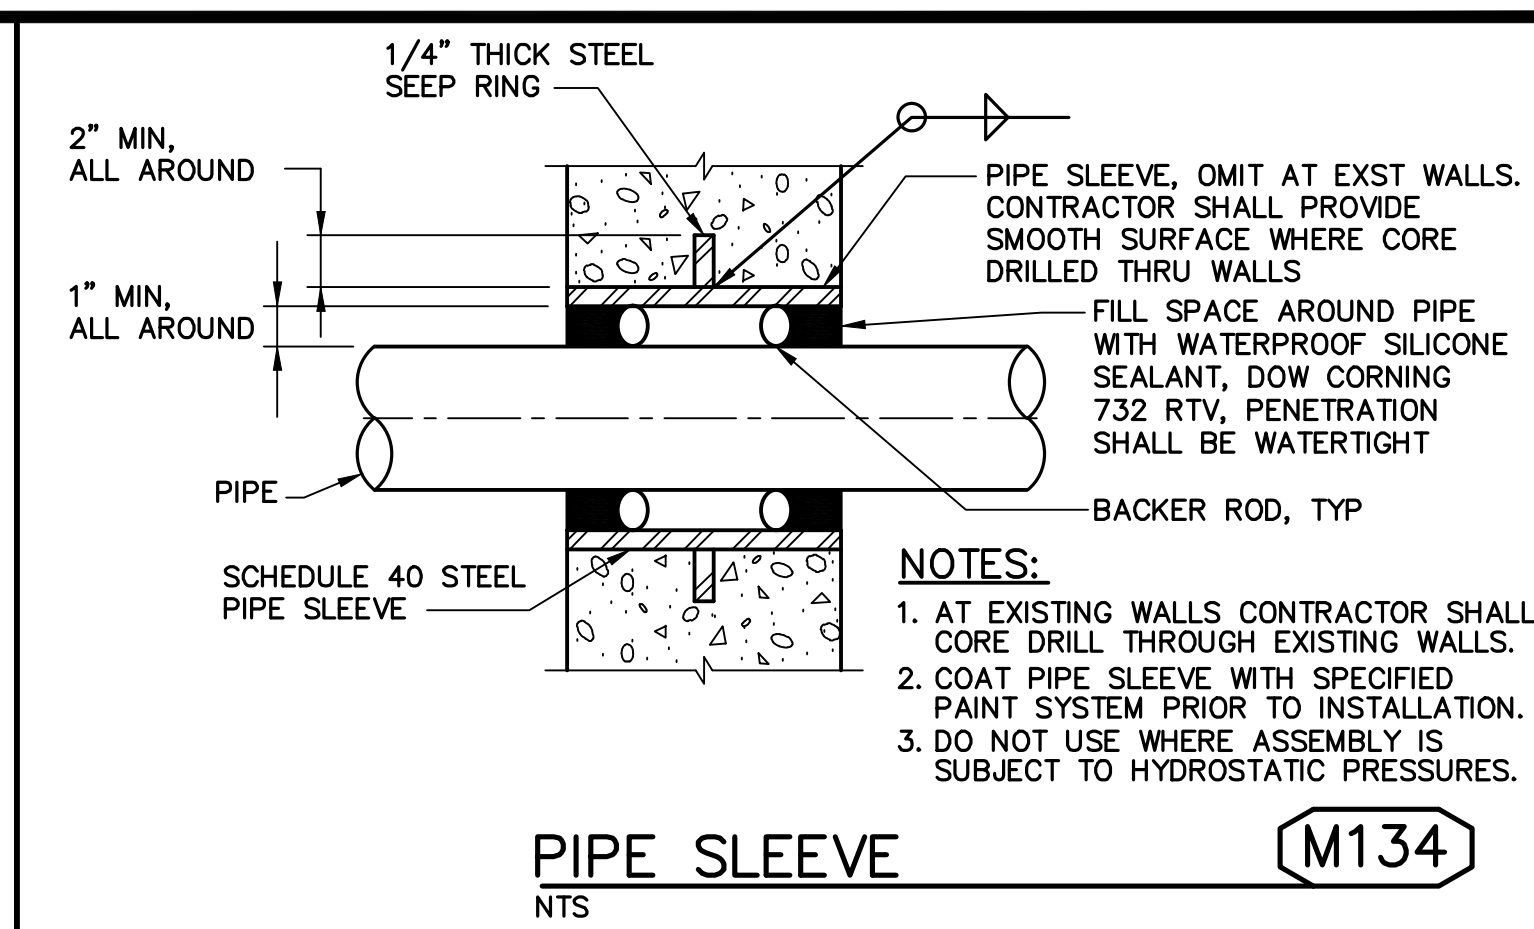


**PIPE SLEEVE** M134  
NTS

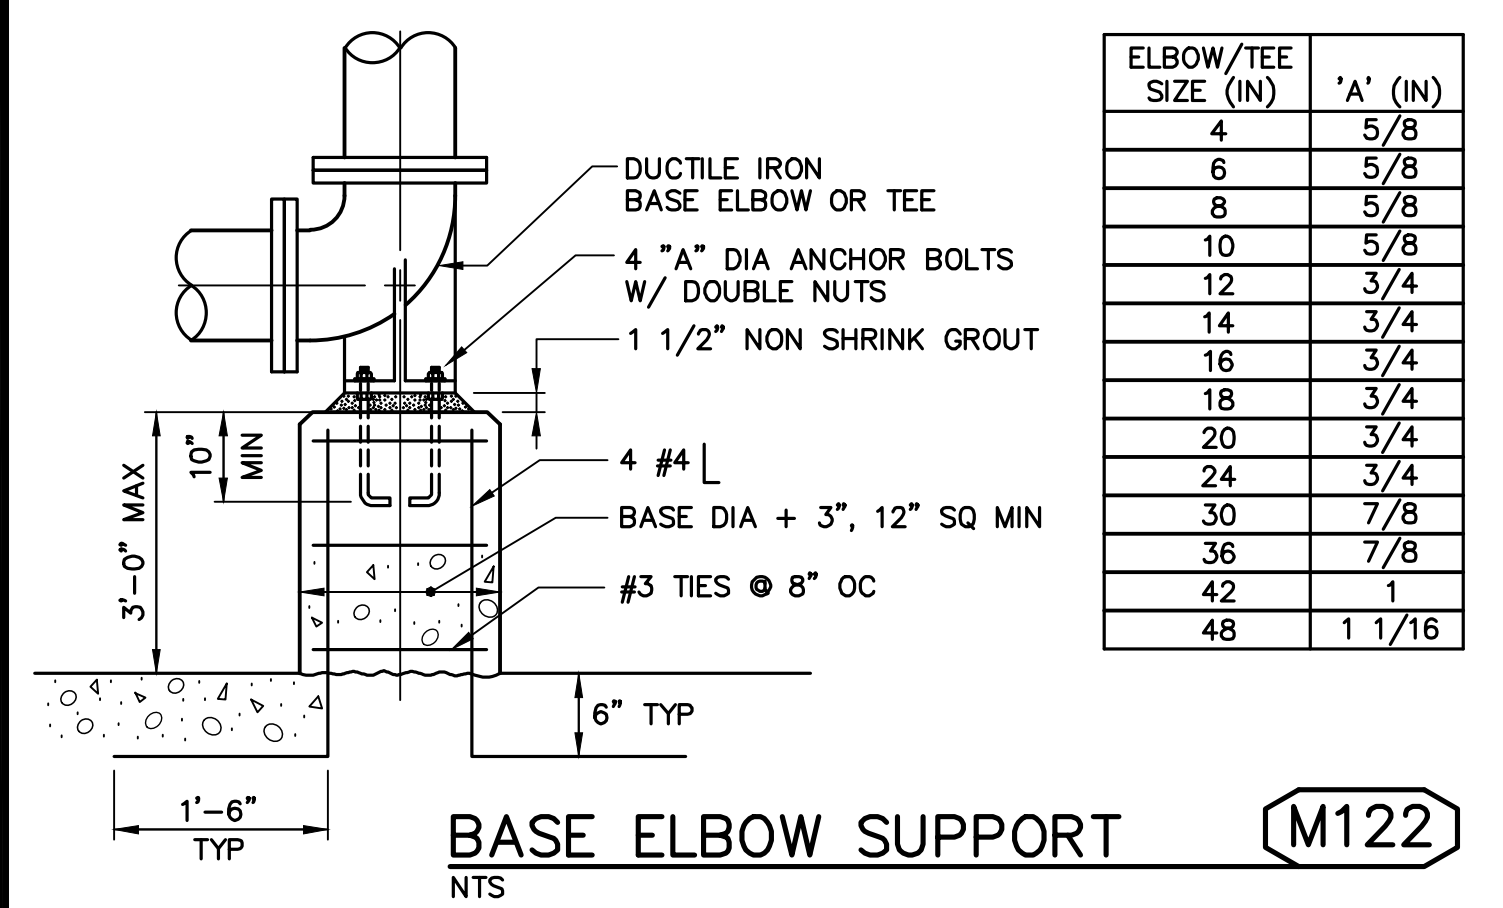


**BASE ELBOW SUPPORT** M122  
NTS

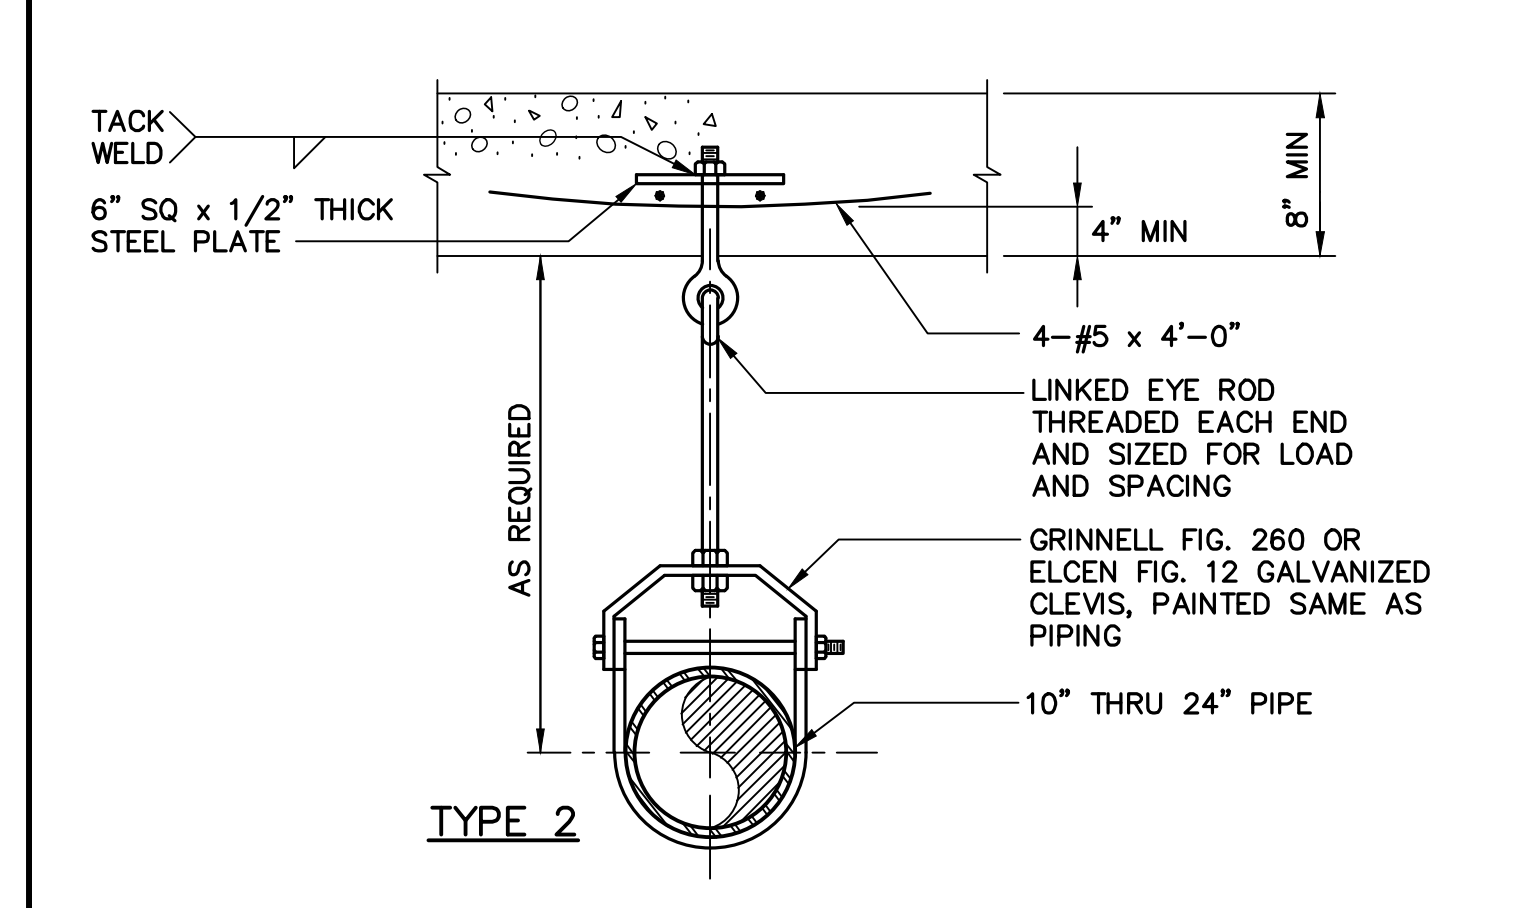

**TYPE 2**

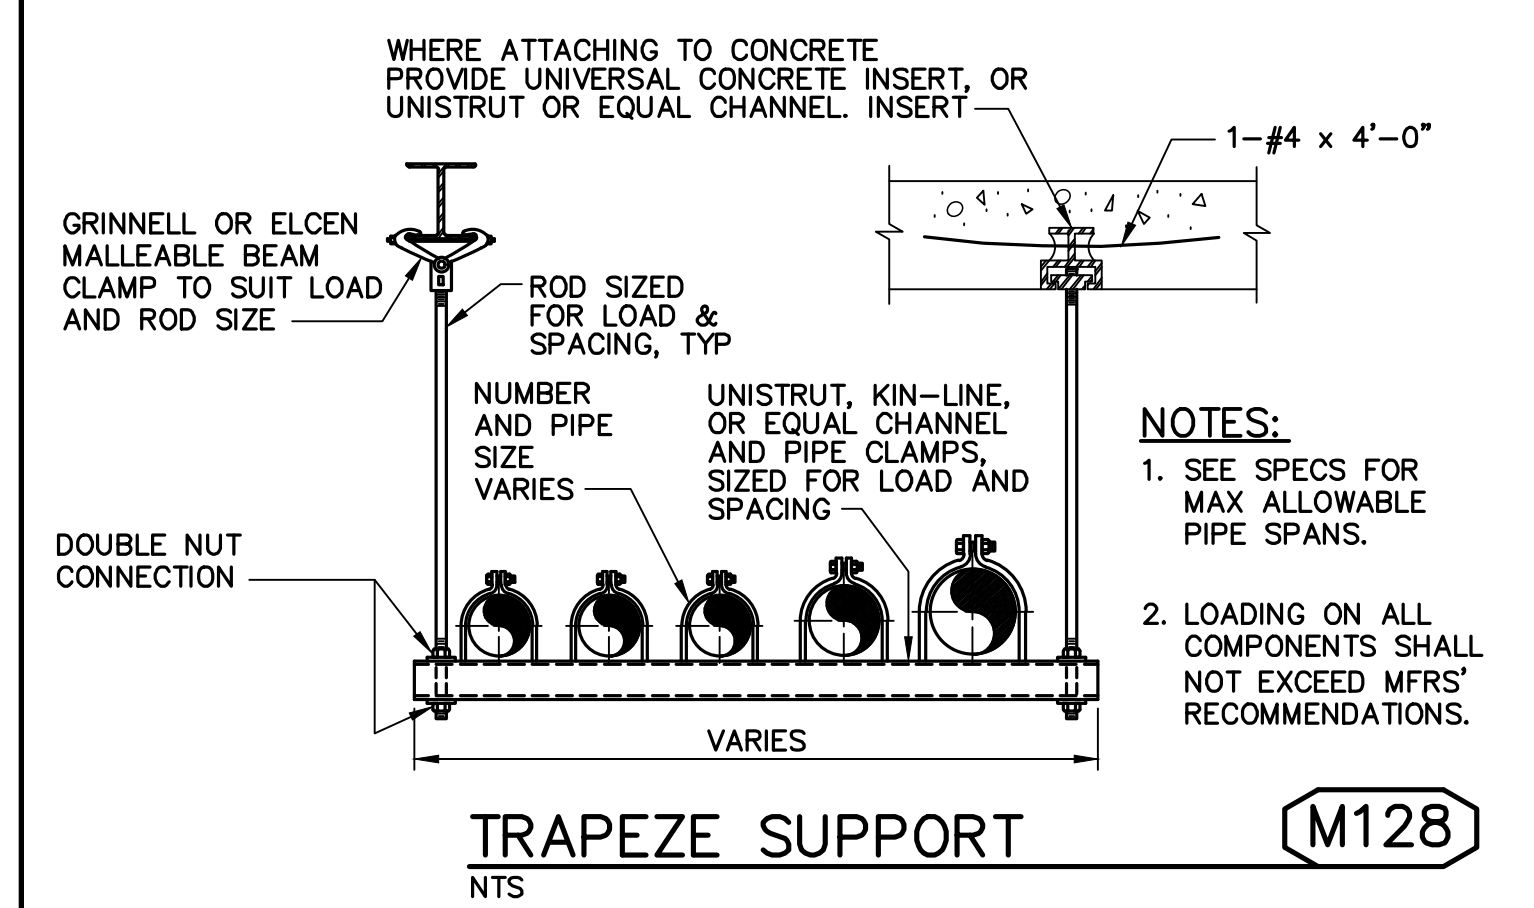


**TRAPEZE SUPPORT** M128  
NTS

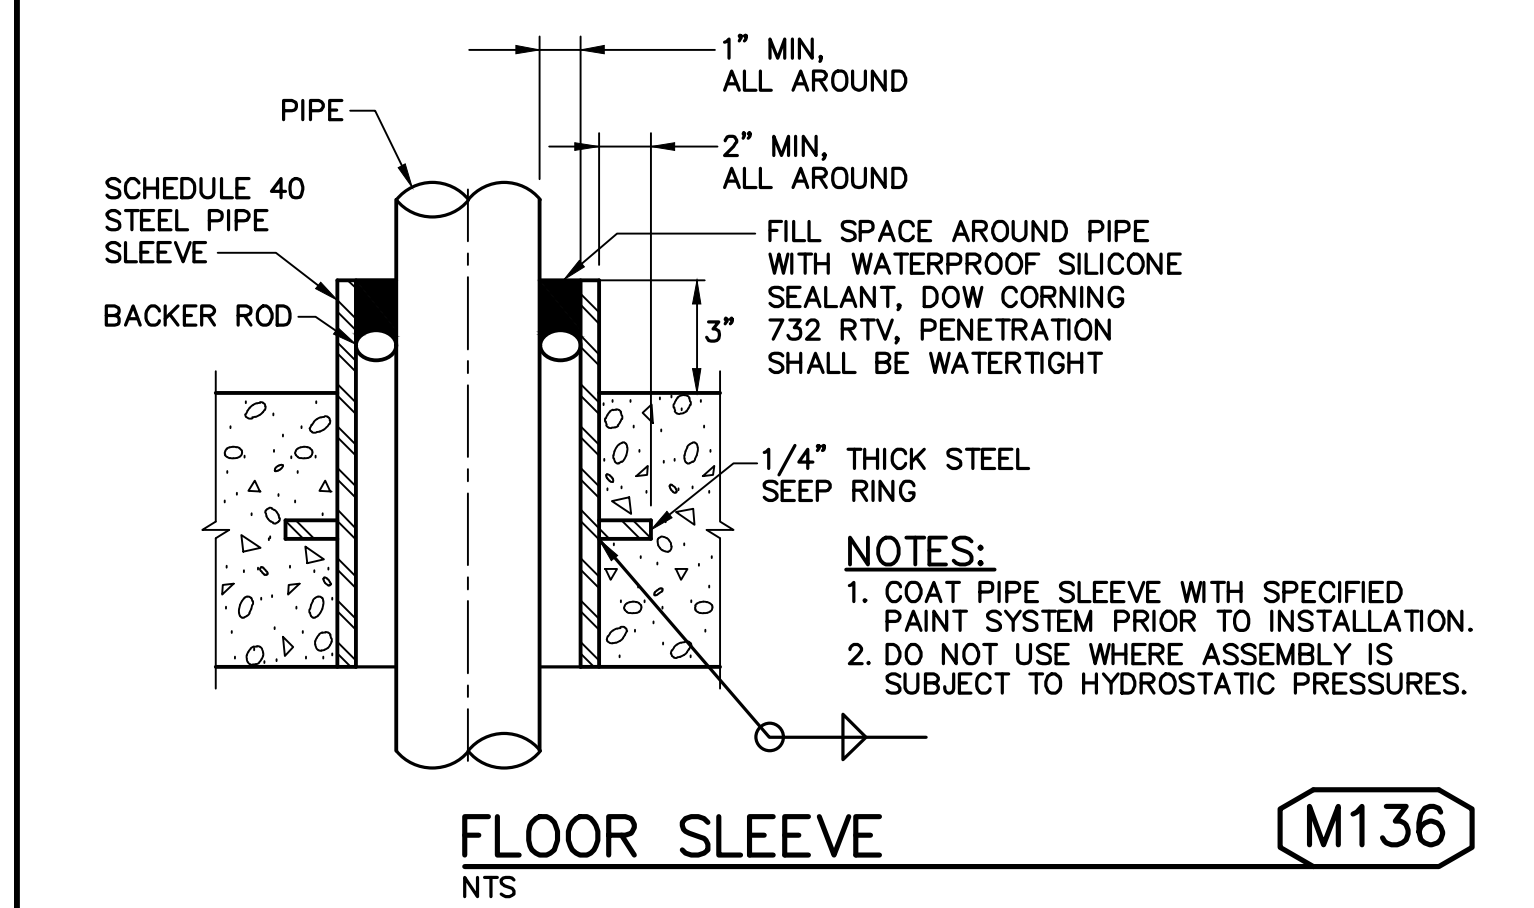


**FLOOR SLEEVE** M136  
NTS




**TYPE 3**  
**PIPE HANGER** M125  
NTS

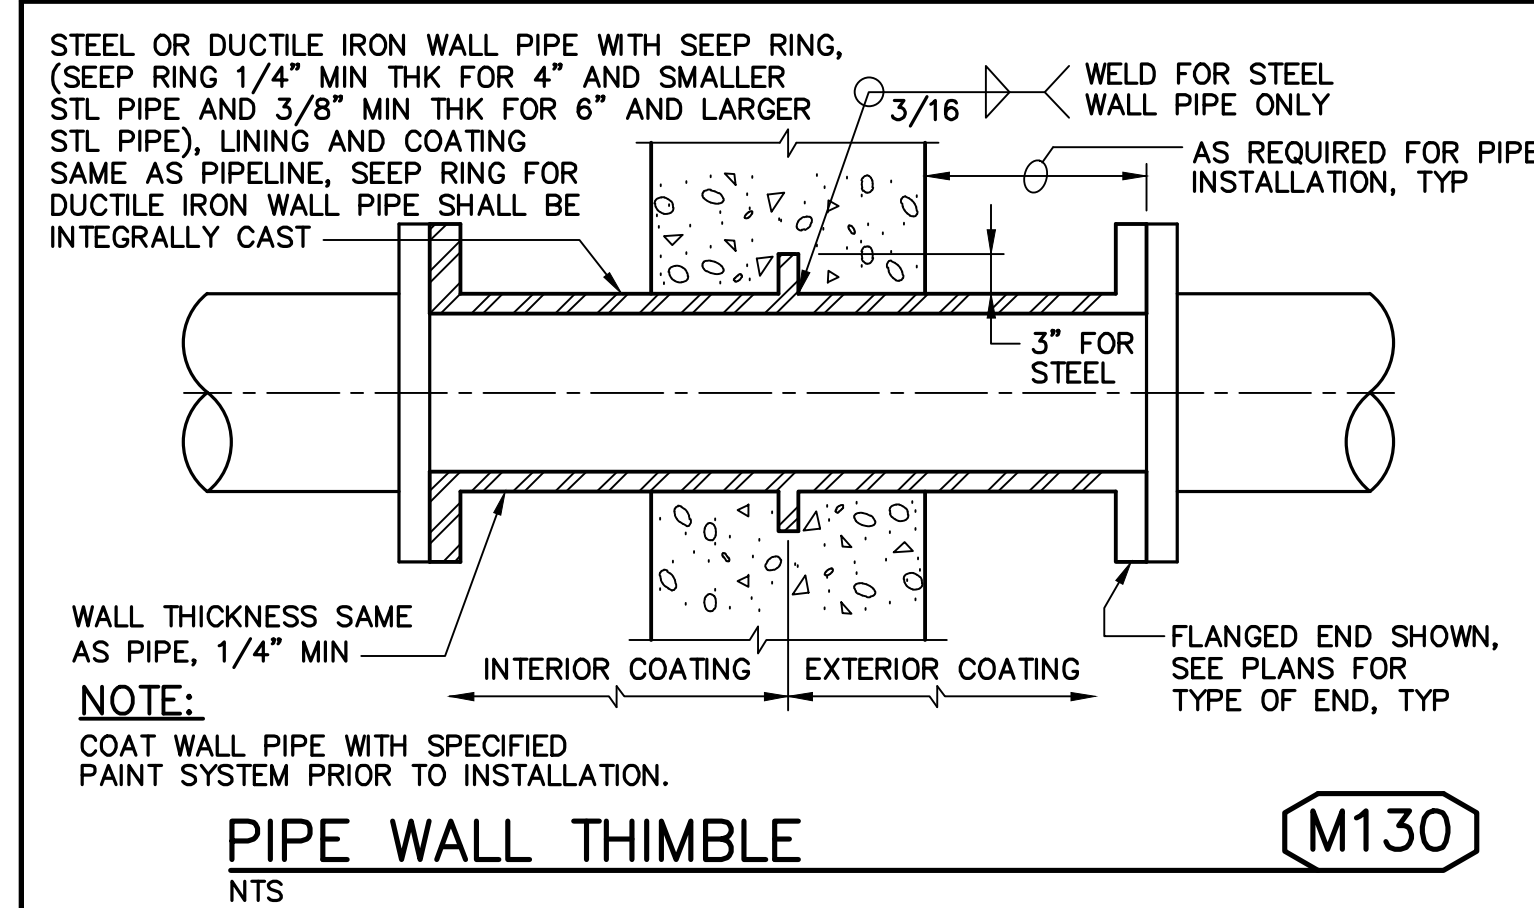


**PIPE WALL THIMBLE** M130  
NTS

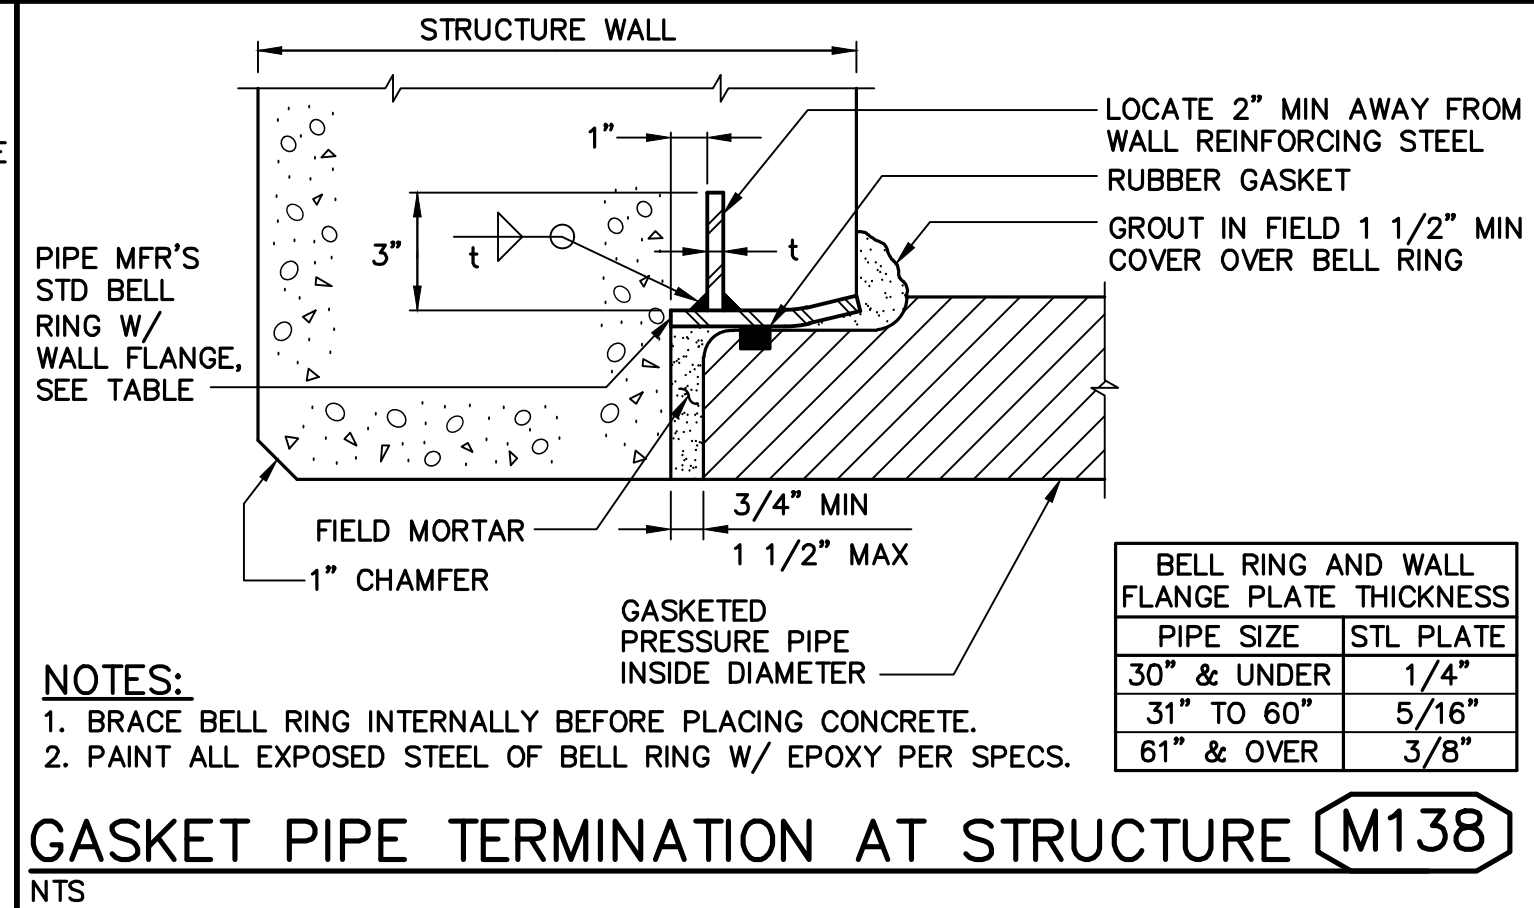


**GASKET PIPE TERMINATION AT STRUCTURE** M138  
NTS

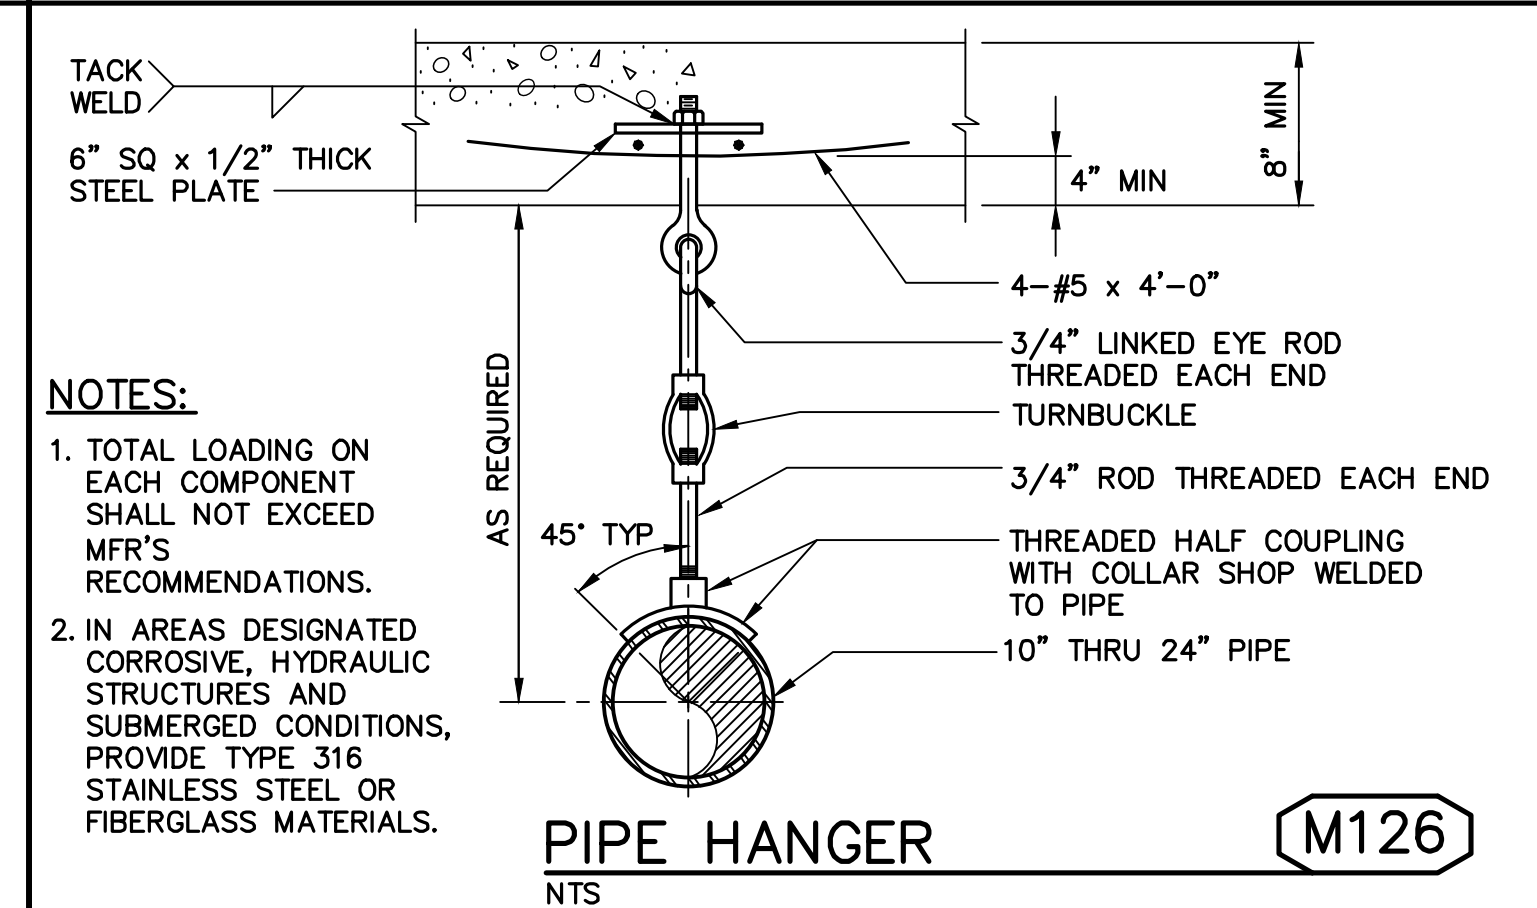

**PIPE HANGER** M126  
NTS

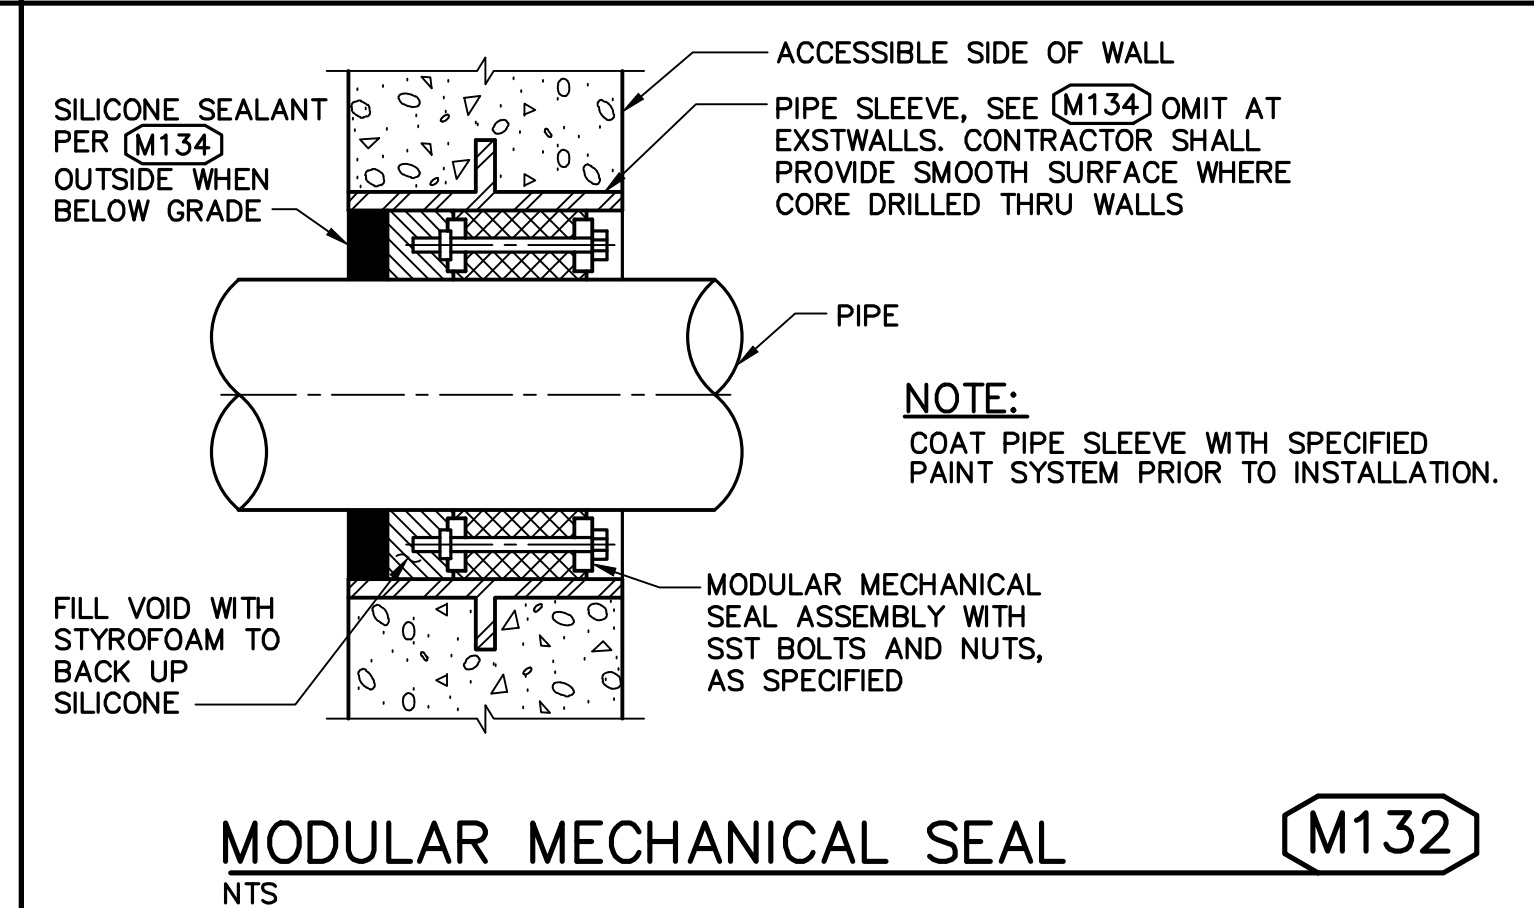

**MODULAR MECHANICAL SEAL** M132  
NTS

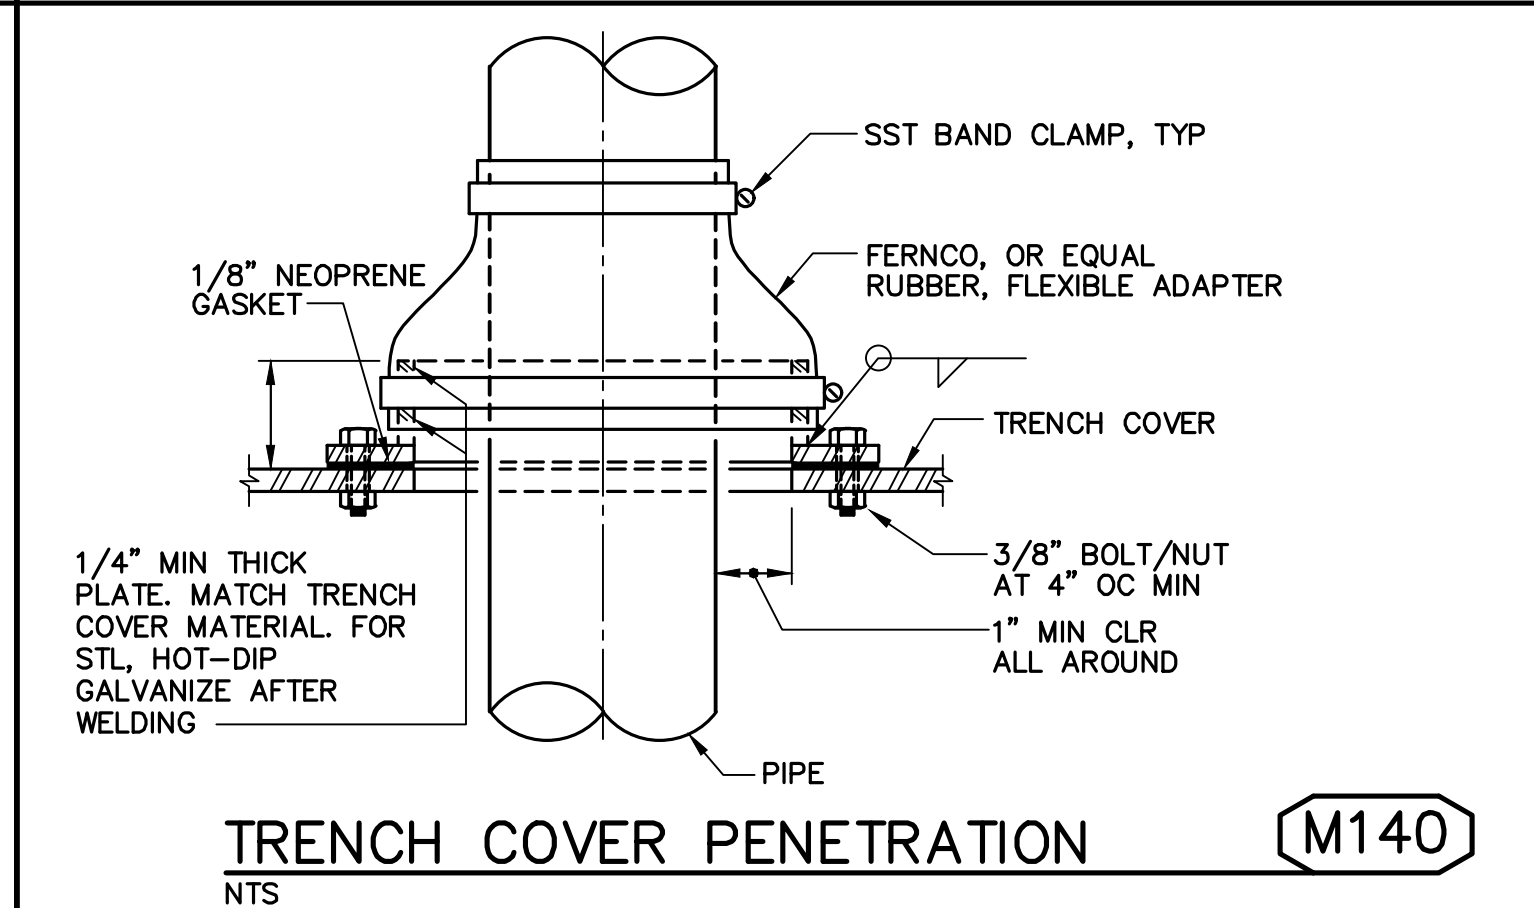

**TRENCH COVER PENETRATION** M140  
NTS

**RECORD DRAWING**  
 THIS RECORD DRAWING HAS BEEN PREPARED FROM THE ORIGINAL CONTRACT DOCUMENTS SIGNED AND SEALED BY THE RESPONSIBLE ENGINEER OF RECORD. ADDITIONAL INFORMATION HAS BEEN PROVIDED BY OTHERS TO REPRESENT AS-CONSTRUCTED CONDITION AND IS SHOWN ON THESE RECORD DRAWINGS. THE RESPONSIBLE ENGINEER OF RECORD CANNOT VERIFY THE ACCURACY OF THE AS-CONSTRUCTED CONDITION INFORMATION REPRESENTED ON THE RECORD DRAWINGS.

0" = 1" = 1"  
 VERIFY SCALES — BAR IS ONE INCH LONG ON FULL SIZE DRAWING. IF NOT ONE INCH LONG ON THIS DRAWING, ADJUST SCALES ACCORDINGLY

DESIGNED	M. TAKEMOTO
DRAWN	S. JUNG
CHECKED	M. NAKAMOTO
APPROVED	STEVE CLARY

REV	DATE	BY	APVD	DESCRIPTION
	07/22	CT	TV	RECORD DRAWING

DESIGNED: M. TAKEMOTO  
 DRAWN: S. JUNG  
 CHECKED: M. NAKAMOTO  
 APPROVED: STEVE CLARY

SUBMITTED: MARK TAKEMOTO  
 RMC PROJECT ENGINEER CE-64369


RMC ENGINEER CE-30318

TREATMENT AND WET WEATHER FLOW UPGRADE


**MECHANICAL STANDARD DETAILS - 4**

DWG NO: M-4  
 SHEET NO: 116 OF 226  
 PROJ NO: 055-006  
 DATE: JULY 2022


FILENAME: 0055-006-M-2\_8-01-22\_11:28am.ctb XREFS: X-SMCSO-TBLK ICS

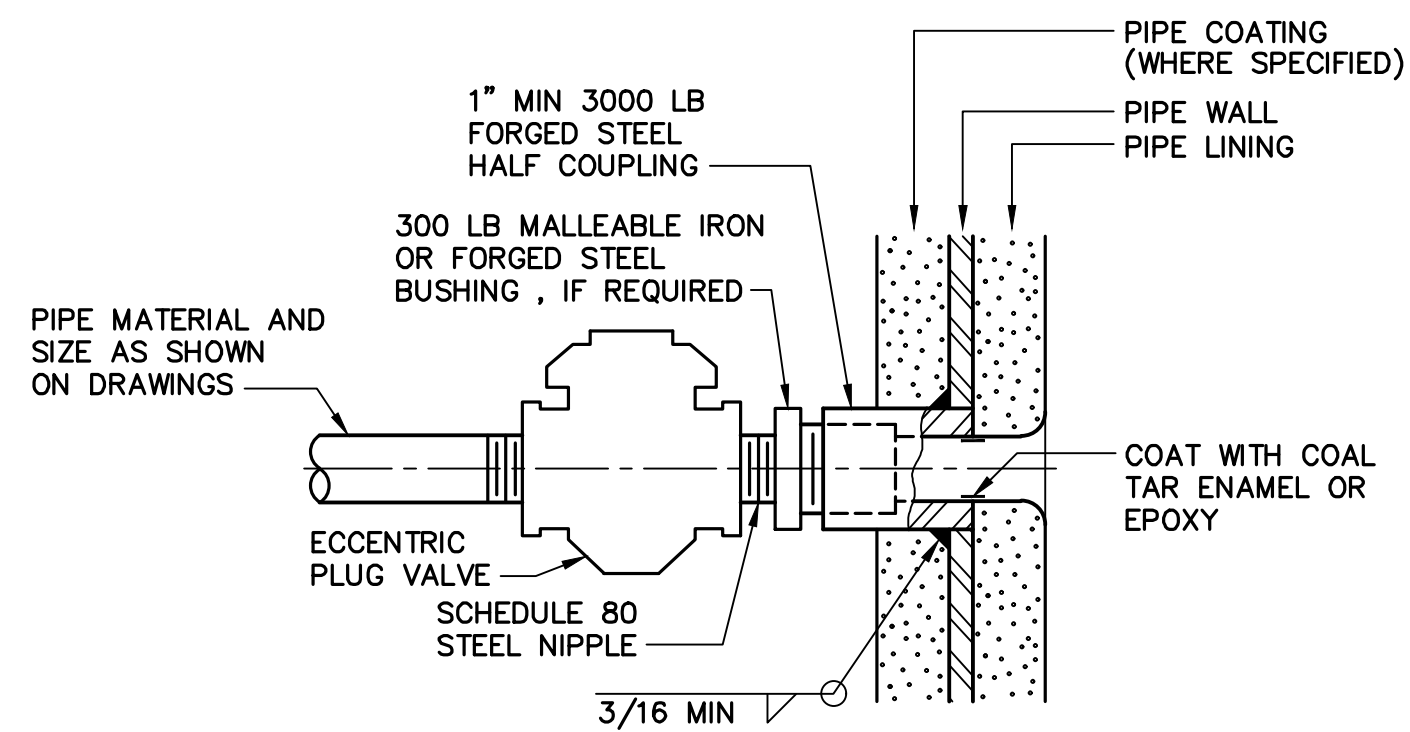


**2" AND SMALLER PIPE CONNECTION** M150  
NTS

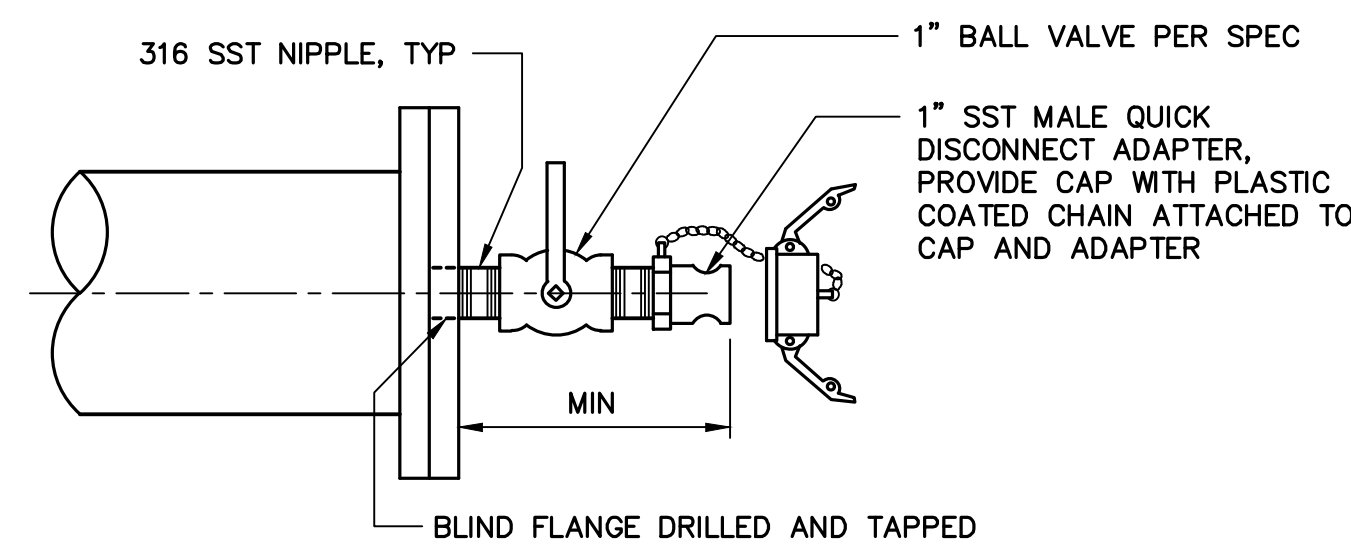


**FLUSHING CONNECTION** M156  
NTS

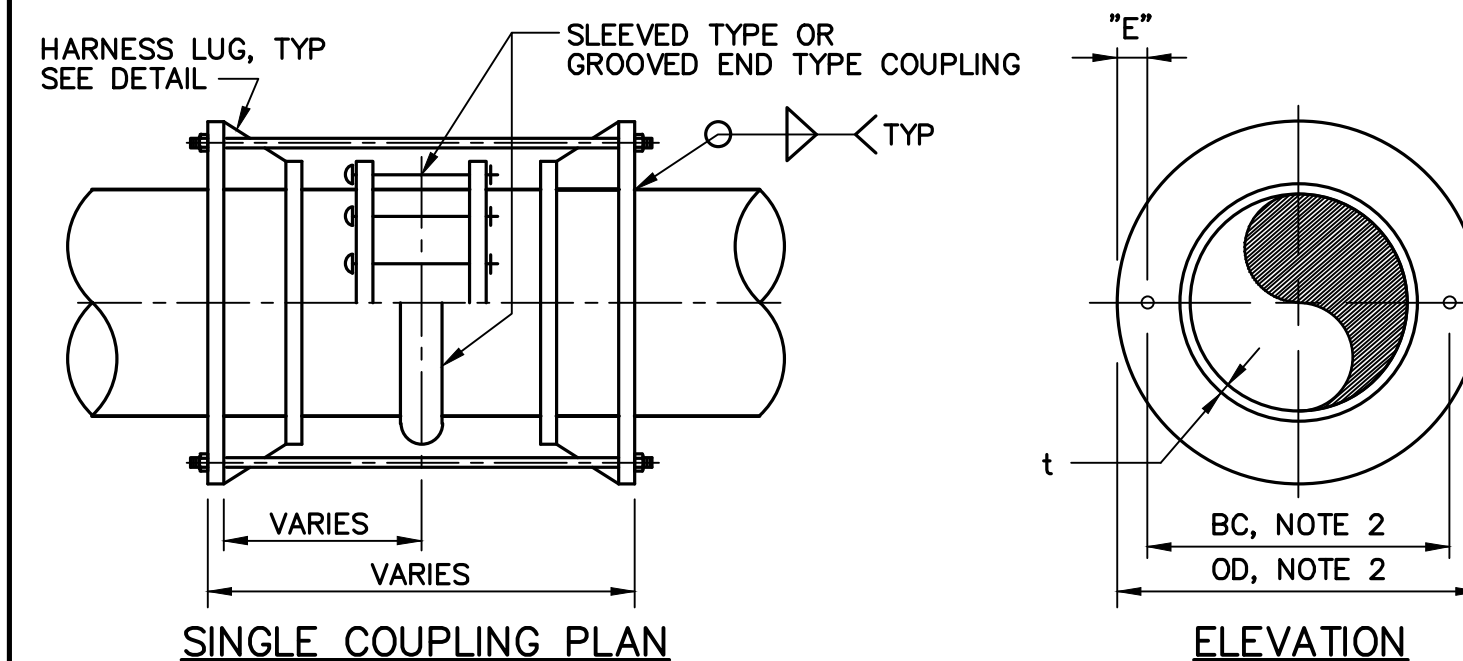

**SINGLE COUPLING PLAN** ELEVATION

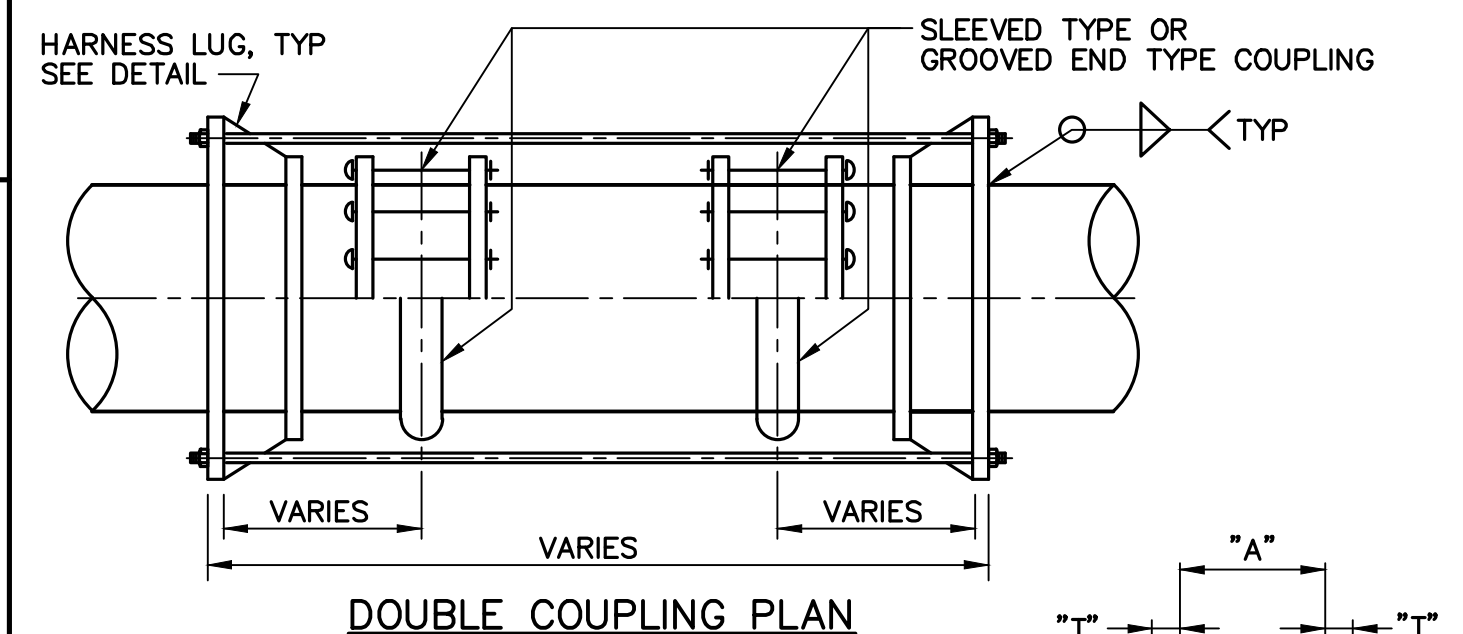

**DOUBLE COUPLING PLAN**

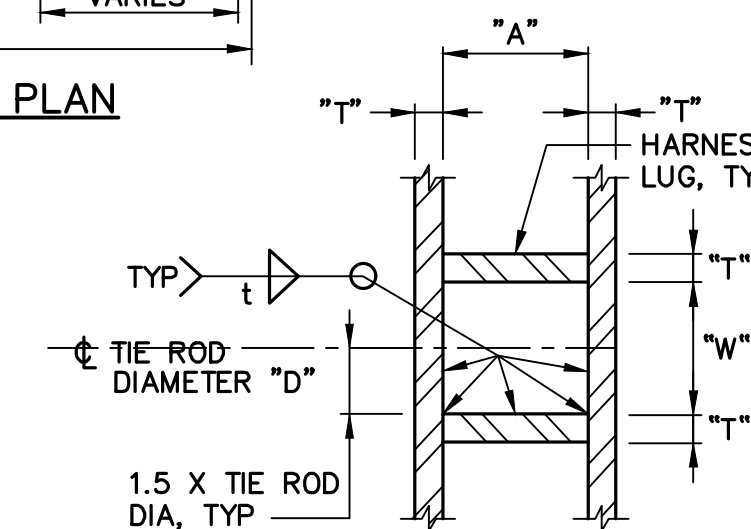


STEEL PIPE HARNESS SET SCHEDULE										
PIPE DESCRIPTION	MAX TEST PRESSURE (PSIG)	DIMENSIONS IN INCHES								
		PIPE CYLINDER OD (SEE NOTE 6)	T	A	W	E	D	BACK PLATE OD	FRONT PLATE OD	NO. TIE RODS
< 12"	160	-	0.38	5.00	1.38	3.00	0.63	-	-	4
12-18"	35	-	0.38	5.00	1.38	3.00	0.63	-	-	2
24"	25	35.13	0.38	5.00	1.50	3.13	0.63	-	-	4
30"	35	31.13	0.38	5.00	1.38	3.00	0.63	-	-	4
36"	10	37.13	0.38	5.00	1.38	3.00	0.63	-	-	4
42"	10	-	0.38	5.00	1.38	3.00	0.63	-	-	4
48"	10	-	0.38	5.00	1.38	3.00	0.63	-	-	4
48"	35	-	0.38	5.00	1.38	3.00	0.63	-	-	4


**NOTES:**

- WELD SIZE SHALL BE MINIMUM REQUIRED BY AMERICAN WELDING SOCIETY, MINIMUM TO MATCH PIPE WALL.
- BOLT CIRCLE AND OD SHALL BE SIZED TO ENSURE 1/2" MIN AND 1" MAX CLEARANCE TO COUPLING.
- SMALLER STIFFENER PLATE SHALL BE 2" HIGH EXCEPT WHEN BOLT DIAMETER EXCEEDS 1", THEN PLATE SHALL BE 2 1/2" HIGH.
- USE THIS DETAIL FOR ONE END OF TIE RODS WHERE THE OPPOSITE END OF TIE RODS IS ATTACHED TO A FLANGE OR A RESTRAINED FLANGE COUPLING ADAPTER.
- PROVIDE INSULATING SLEEVE AND WASHERS WHERE ELECTRICAL ISOLATION IS REQUIRED. REFER TO CATHODIC PROTECTION, YARD PIPING, AND MECHANICAL DRAWINGS.
- CONTRACTOR SHALL VERIFY PIPE OD PRIOR TO HARNESS FABRICATION.
- HARNESS SHALL SPAN PAIRS OF MECHANICAL SLEEVE COUPLINGS WHERE INDICATED.
- FOR PIPE MATERIAL OTHER THAN STEEL, CONTRACTOR SHALL PROVIDE EQUIVALENT HARNESSING ACCEPTABLE TO THE ENGINEER.
- WHERE 4 TIE RODS ARE REQUIRED, STRADDLE HORIZONTAL AND VERTICAL CENTERLINES UNLESS OTHERWISE REQUIRED.


**THRUST RESTRAINT HARNESS** M160  
NTS

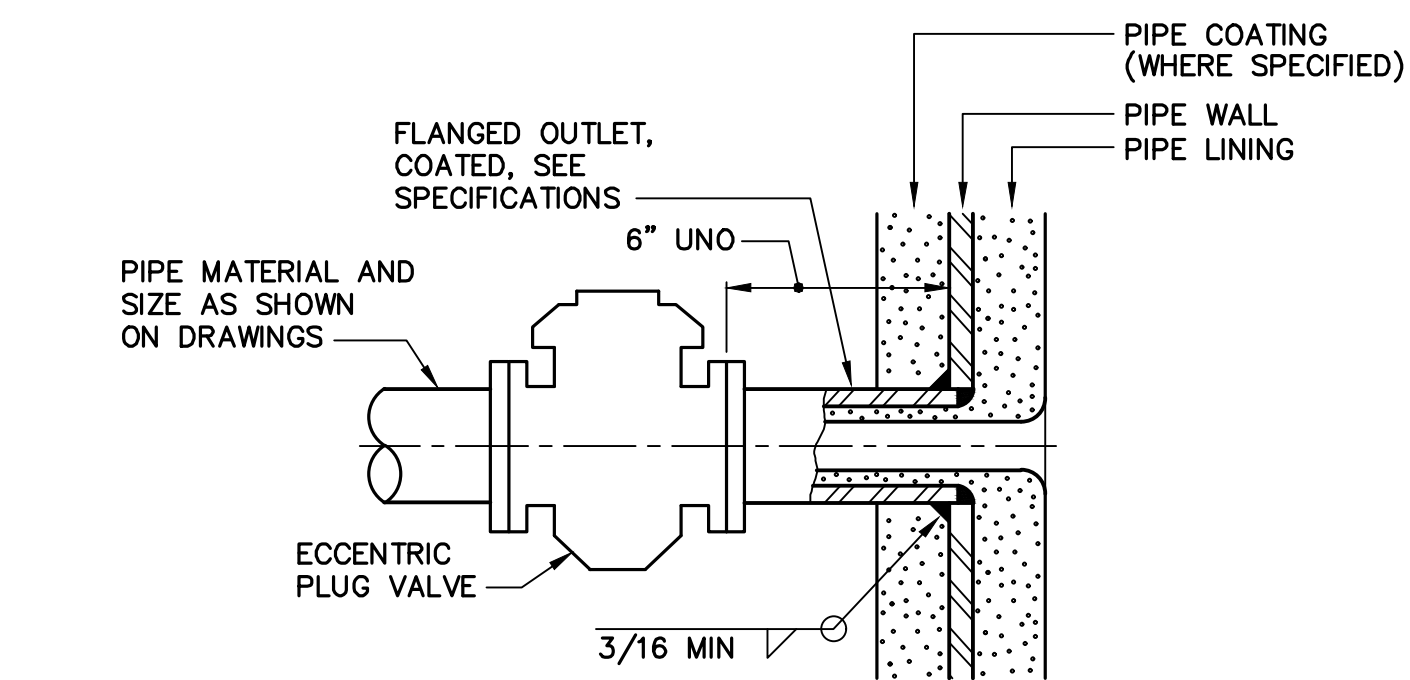


**3" AND LARGER PIPE CONNECTION** M152  
NTS

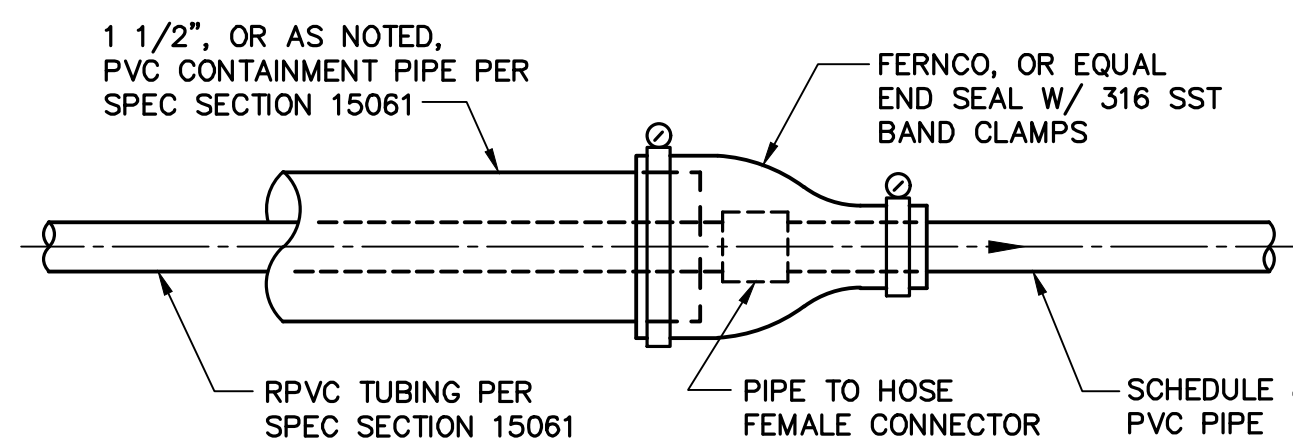

**DOUBLE/SINGLE WALL PIPE TRANSITION** M158  
NTS

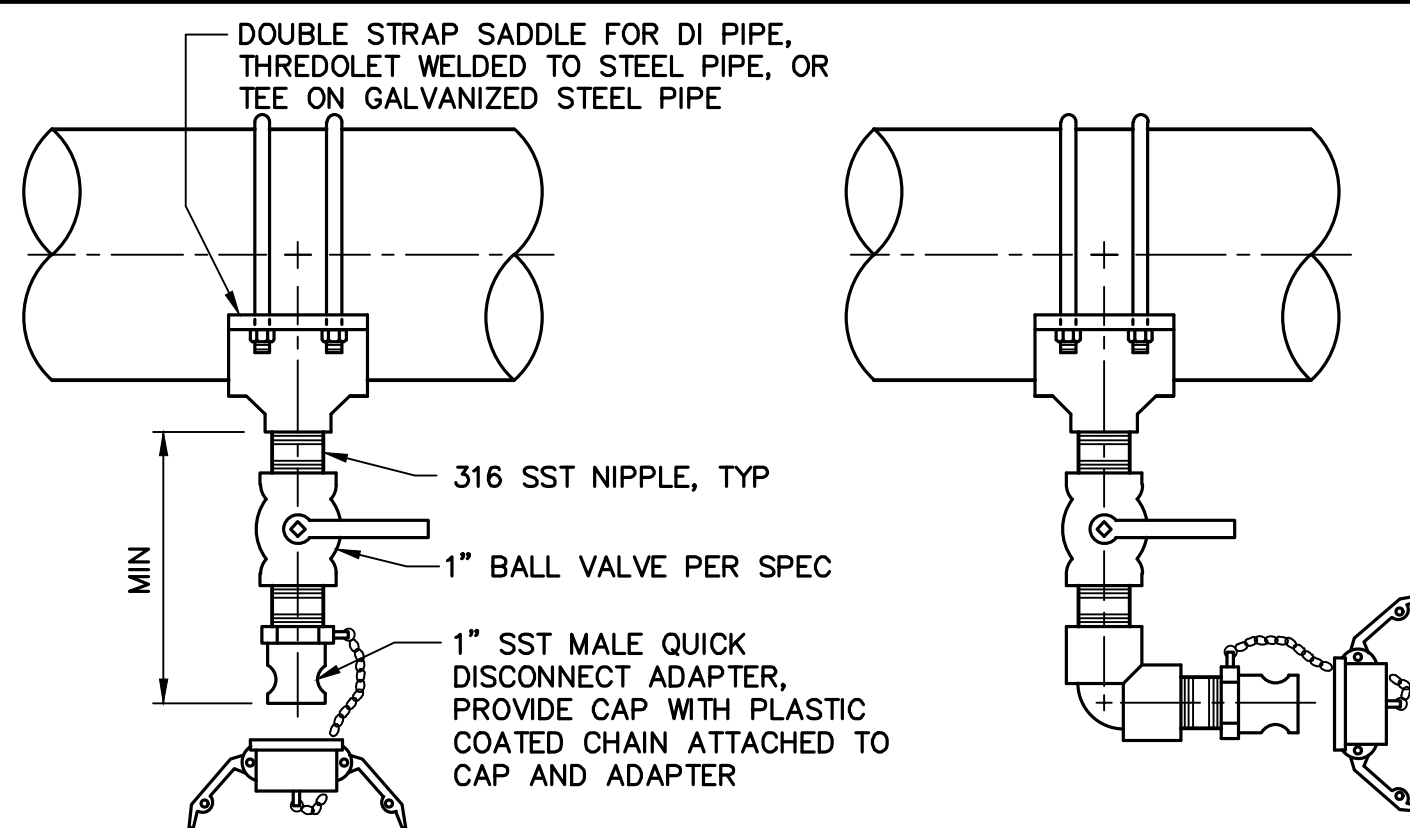

**ELEVATION FOR FERROUS METAL PIPING**


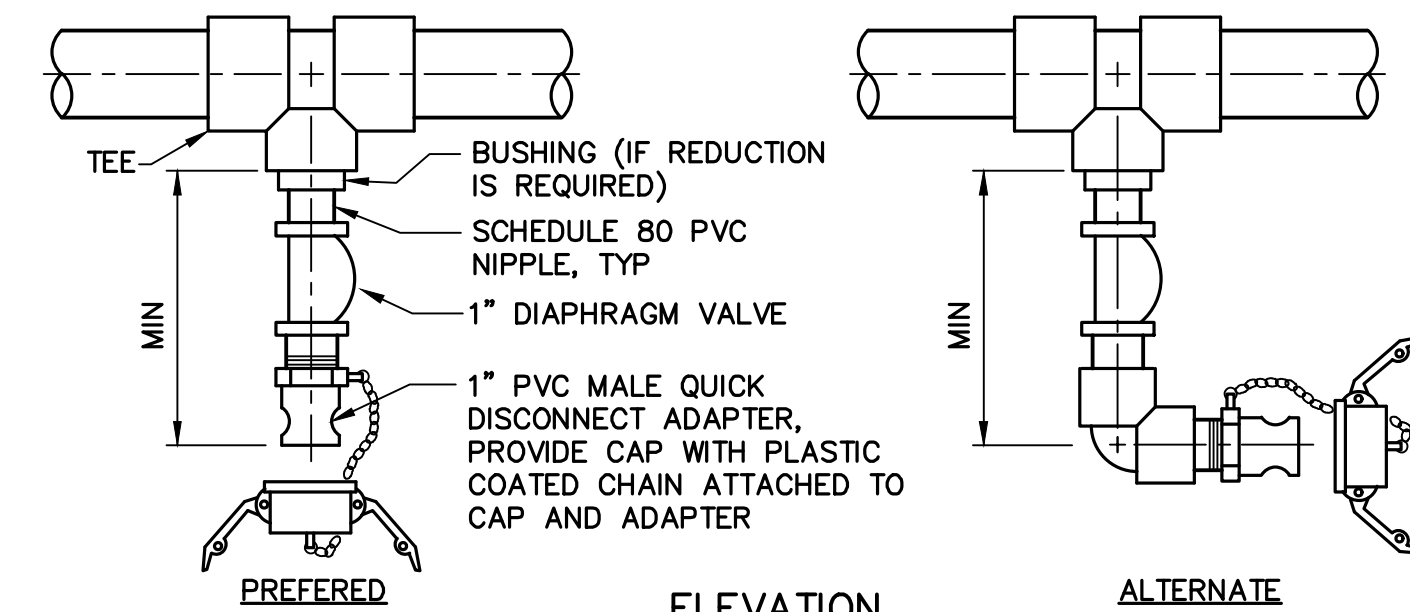


**ELEVATION FOR PVC PIPING**

**NOTE:**

FOR LINE SIZES SMALLER THAN 1", VALVE AND ADAPTER SIZES SHALL MATCH LINE SIZE.

**FLUSHING/DRAIN CONNECTION** M154  
NTS

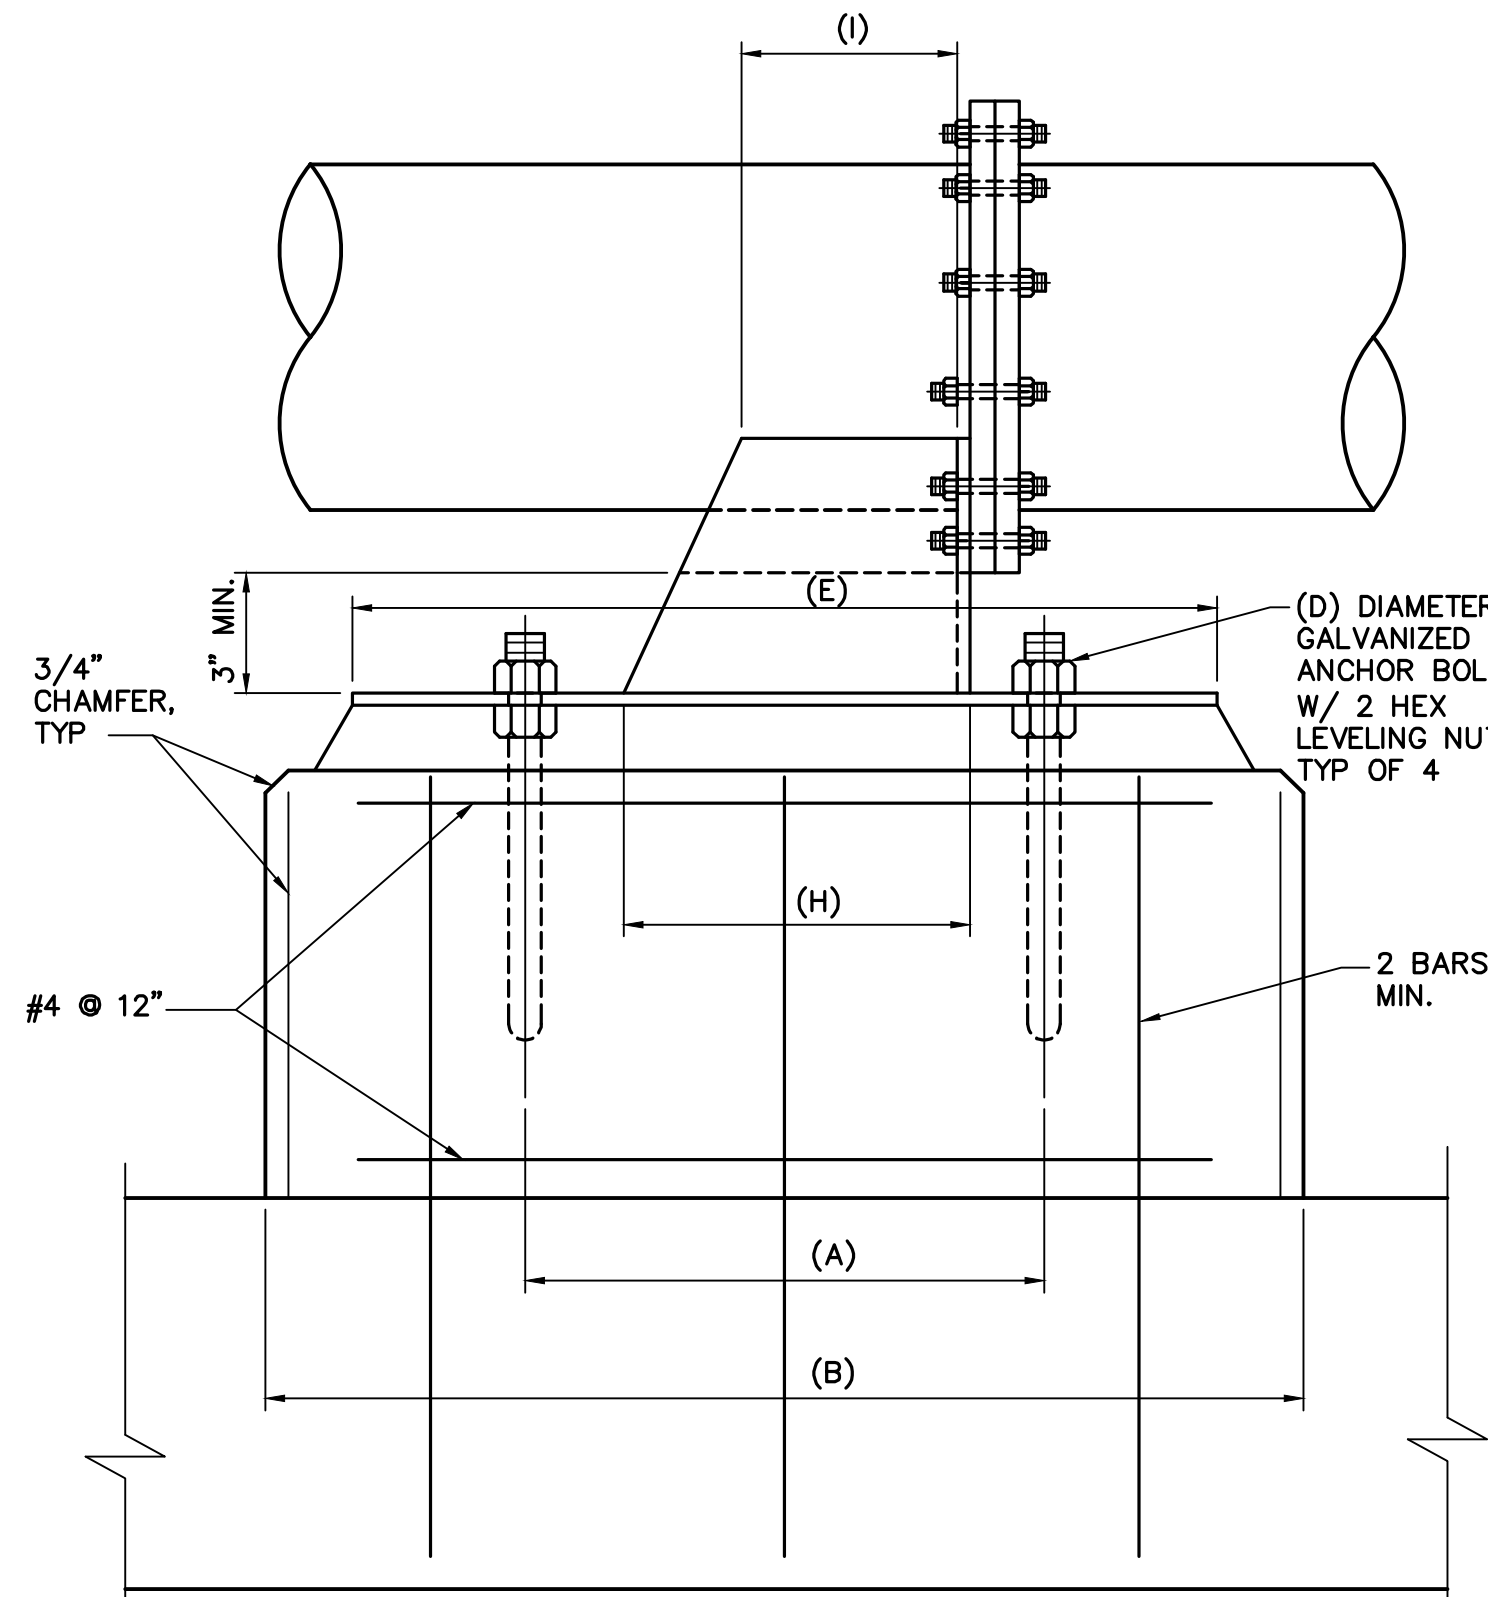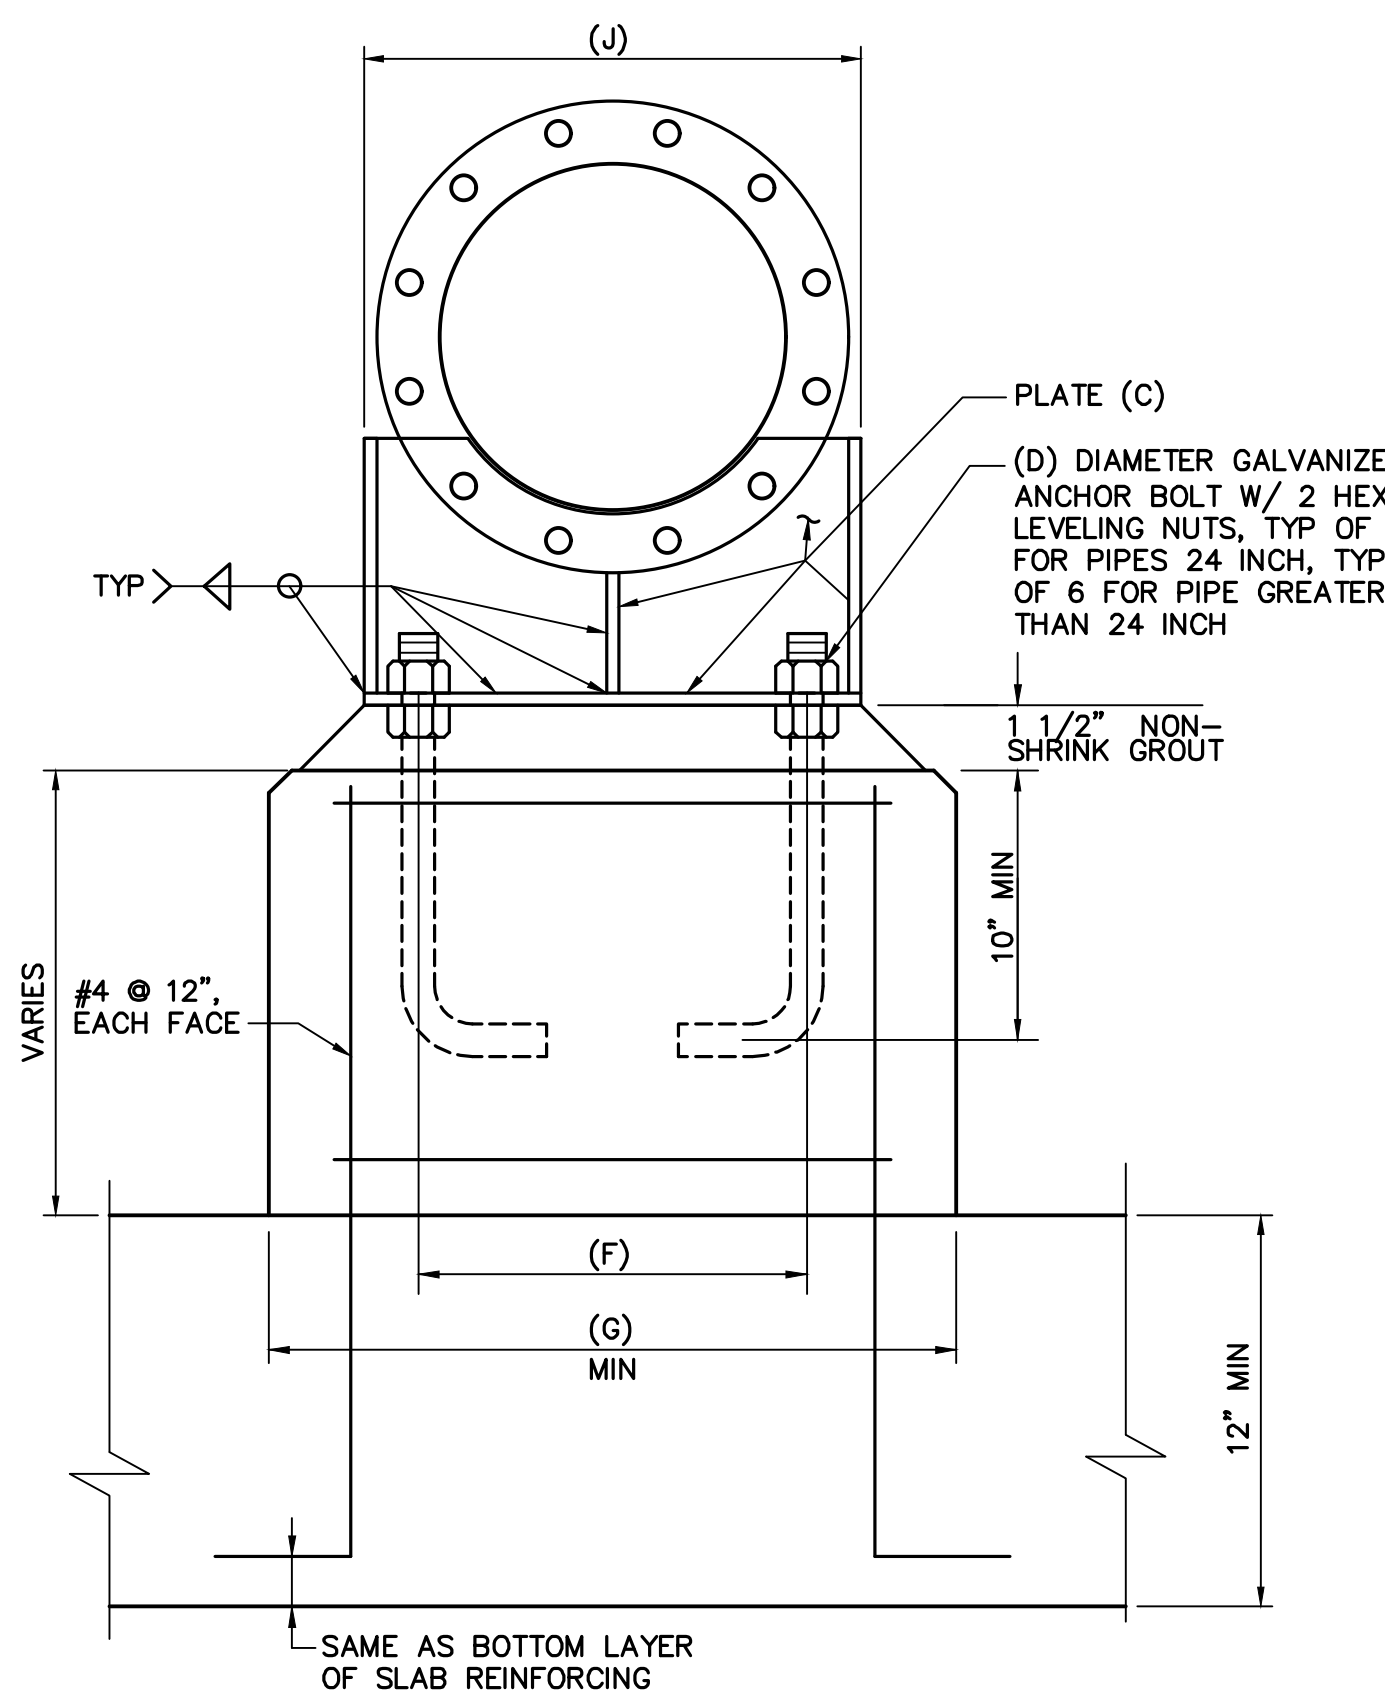

PIPE SUPPORT SCHEDULE										
PIPE SIZE (NOM)	DIMENSIONS IN INCHES									
	(A)	(B)	(C)	(D)	(E)	(F)	(G)	(H)	(I)	(J)
8	12	24	1/2	3/4	20	9	16	8	5	12
16	16	24	1/2	3/4	20	21	25	12	4	21
18	19	30	1/2	3/4	26	23	26	15	5	22
30	24	40	3/4	1 1/4	36	36	40	20	6	36

**NOTES:**

- HOT-DIP GALVANIZE STEEL COMPONENTS AFTER FABRICATION.
- WHEN ATTACHING TO EXISTING CONCRETE, PROVIDE EQUIVALENT SIZE ADHESIVE ANCHORS.
- VERIFY PIPE OD PRIOR TO FABRICATION.

**EXPOSED PIPE THRUST RESTRAINT** M161  
NTS

**RECORD DRAWING**  
THIS RECORD DRAWING HAS BEEN PREPARED FROM THE ORIGINAL CONTRACT DOCUMENTS SIGNED AND SEALED BY THE RESPONSIBLE ENGINEER OF RECORD. ADDITIONAL INFORMATION HAS BEEN PROVIDED BY OTHERS TO REPRESENT AS-CONSTRUCTED CONDITION AND IS SHOWN ON THESE RECORD DRAWINGS. THE RESPONSIBLE ENGINEER OF RECORD CANNOT VERIFY THE ACCURACY OF THE AS-CONSTRUCTED CONDITION INFORMATION REPRESENTED ON THE RECORD DRAWINGS.

0" = 1" VERIFY SCALES - BAR IS ONE INCH LONG ON FULL SIZE DRAWING. IF NOT ONE INCH LONG ON THIS DRAWING, ADJUST SCALES ACCORDINGLY



REV	DATE	BY	APVD	DESCRIPTION
▲	07/22	CT	TV	RECORD DRAWING

DESIGNED M. TAKEMOTO  
DRAWN S. JUNG  
CHECKED M. NAKAMOTO



SUBMITTED: MARK TAKEMOTO  
RMC PROJECT ENGINEER CE-64369  
APPROVED: STEVE CLARY  
RMC ENGINEER CE-30318



TREATMENT AND WET WEATHER FLOW UPGRADE  
MECHANICAL STANDARD DETAILS - 5


DWG NO M-5  
SHEET NO 117 OF 226  
PROJ NO 055-006  
DATE JULY 2022

TIE ROD SCHEDULE		MAXIMUM TEST PRESSURE					
PIPE SIZE (NOM IN)	MINIMUM STEEL PIPE WALL THICKNESS (IN) (NOTE 5)	25 PSIG		50 PSIG		100 PSIG	
		NUMBER REQUIRED	DIAMETER (IN)	NUMBER REQUIRED	DIAMETER (IN)	NUMBER REQUIRED	DIAMETER (IN)
6	3/16	2	5/8	2	5/8	2	5/8
8	3/16	2	5/8	2	5/8	2	5/8
10	3/16	2	5/8	2	5/8	2	5/8
12	3/16	2	5/8	2	5/8	2	5/8
14	3/16	2	5/8	2	5/8	2	3/4
16	3/16	2	5/8	2	5/8	2	3/4
18	1/4	2	5/8	2	5/8	2	7/8
20	1/4	2	5/8	2	3/4	2	7/8

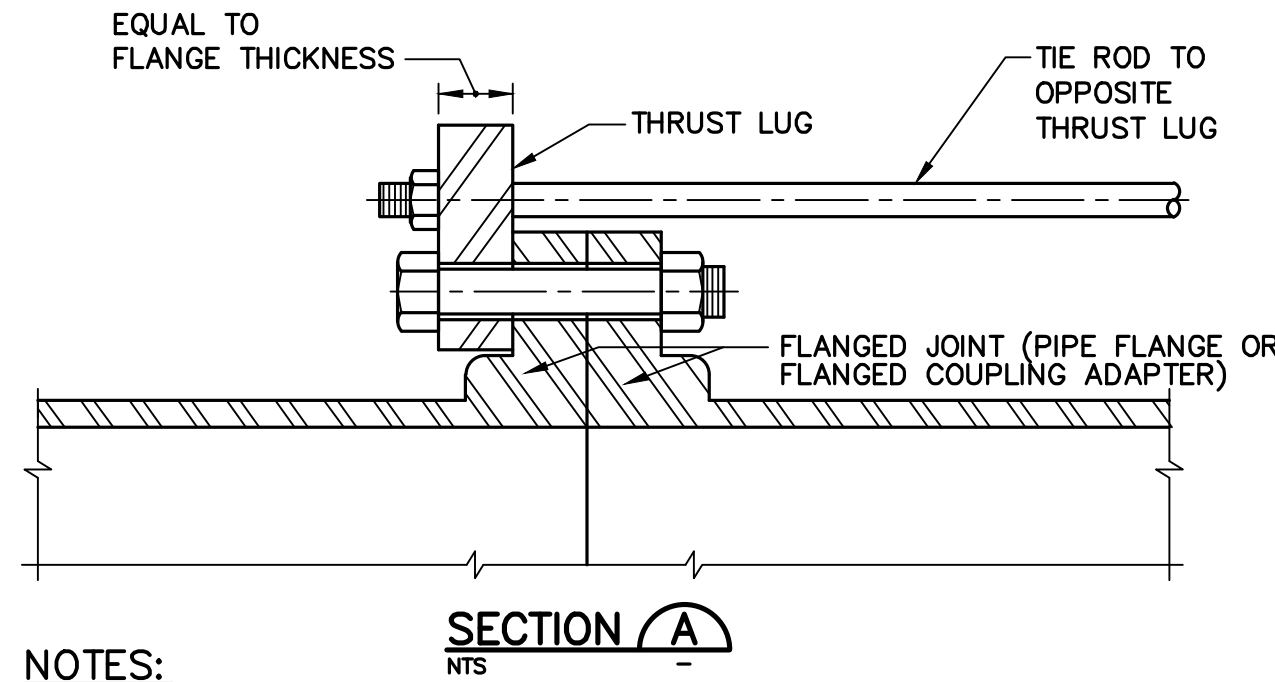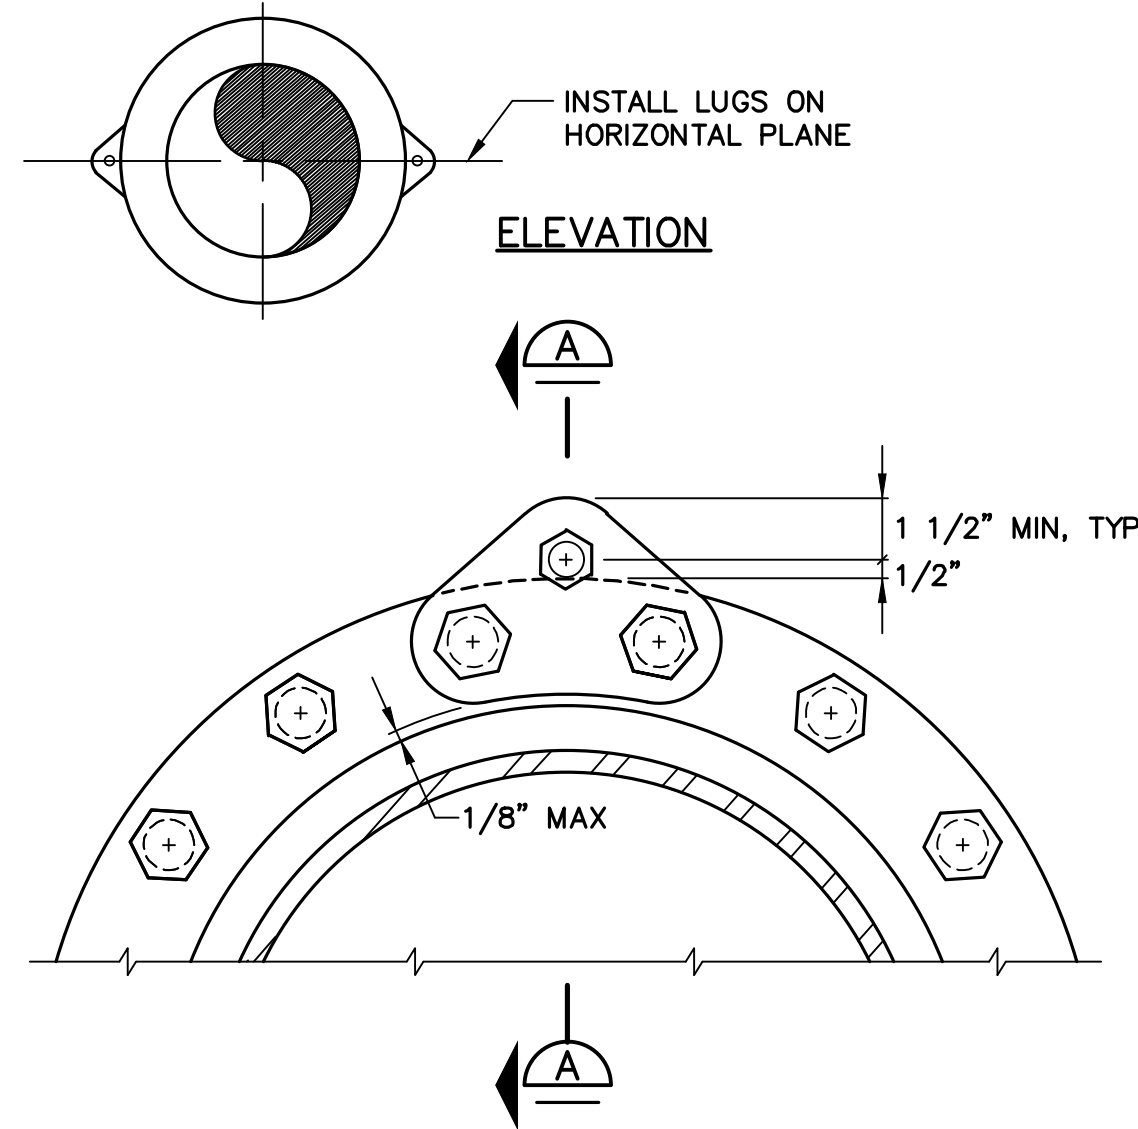


- NOTES:**
1. PLATE: ASTM A283 GRADE D.
  2. TIE RODS: ASTM A193 GRADE B7.
  3. NUTS: ASTM A194 GRADE 2H.
  4. INSTALL TIE RODS IN HORIZONTAL PLANE.
  5. INCREASE STEEL PIPE WALL THICKNESS TO TIE ROD SCHEDULE MINIMUM THICKNESS IF SPECIFIED PIPE WALL THICKNESS IS LESS. IF INCREASING IS REQUIRED, INCREASE FROM FLANGE TO 2'-0" MINIMUM FROM FLANGE.
  6. THIS DETAIL SHALL BE USED WHERE FCA IS ADJACENT TO OTHER FCA OR FLANGES. CONNECT TIE RODS FROM LUGS AT FCA TO LUGS AT ADJACENT FCA OR FLANGES. WHERE ADJACENT FCA OR FLANGE IS NOT PRESENT, INSTALL THRUST HARNESS PER DETAIL (M160).
  7. TIGHTEN TIE ROD NUTS ALTERNATELY AND EQUALLY TO ALIGN EVENLY AND TO PROVIDE EQUAL STRESS ON ALL TIE RODS WHEN SUBJECT TO OPERATING PRESSURES. NUTS SHALL BE TIGHTENED SNUG. THREADS SHALL PROTRUDE 1/2" MINIMUM FROM NUTS AFTER TIGHTENING. PEEN THREADS AFTER TIGHTENING TO LOCK NUTS IN PLACE.

**THRUST RESTRAINT FOR FLEXIBLE COUPLING OR FLANGE COUPLING ADAPTER** (M162)  
NTS

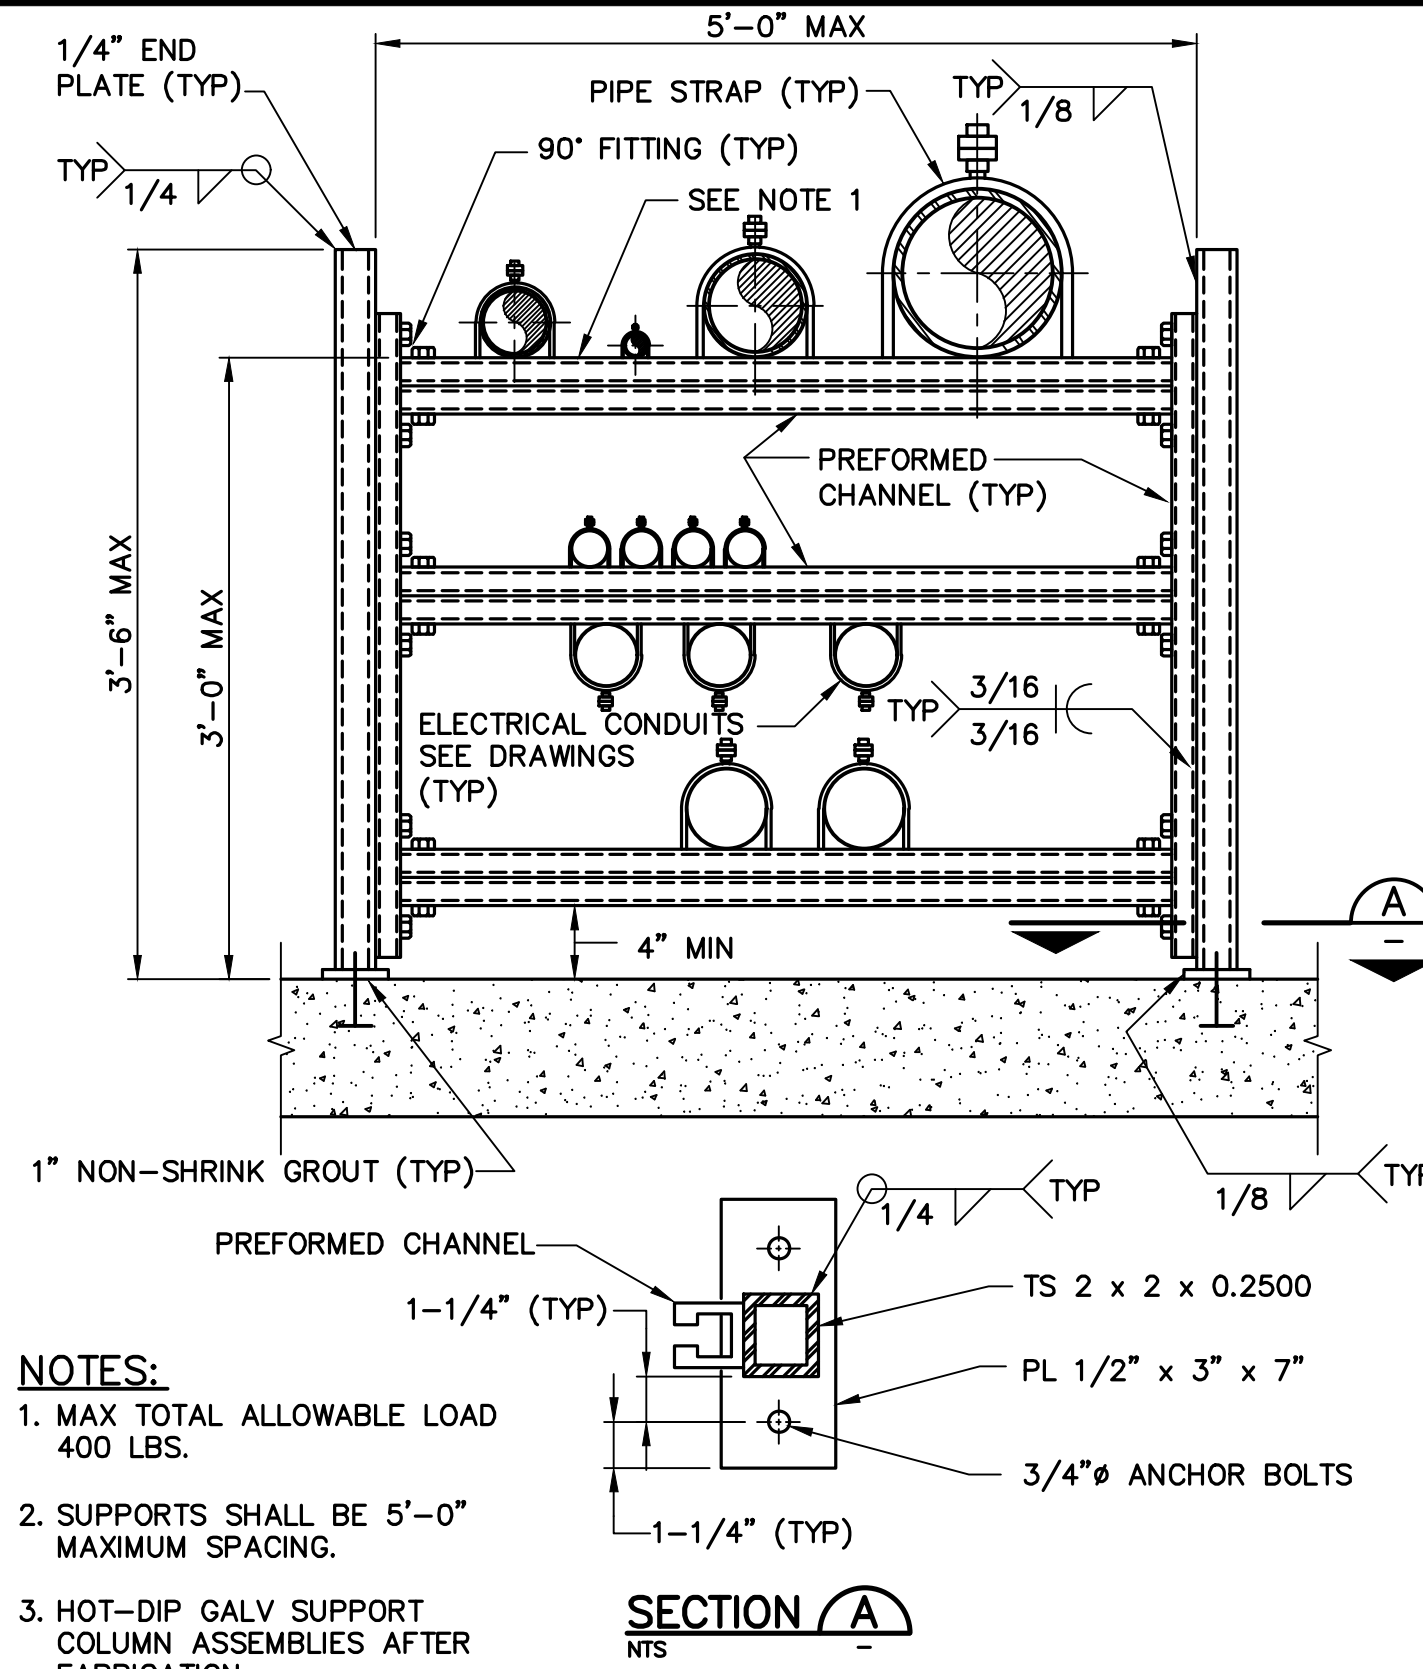


- NOTES:**
1. MAX TOTAL ALLOWABLE LOAD 400 LBS.
  2. SUPPORTS SHALL BE 5'-0" MAXIMUM SPACING.
  3. HOT-DIP GALV SUPPORT COLUMN ASSEMBLIES AFTER FABRICATION.

**PIPE RACK** (M164)  
NTS

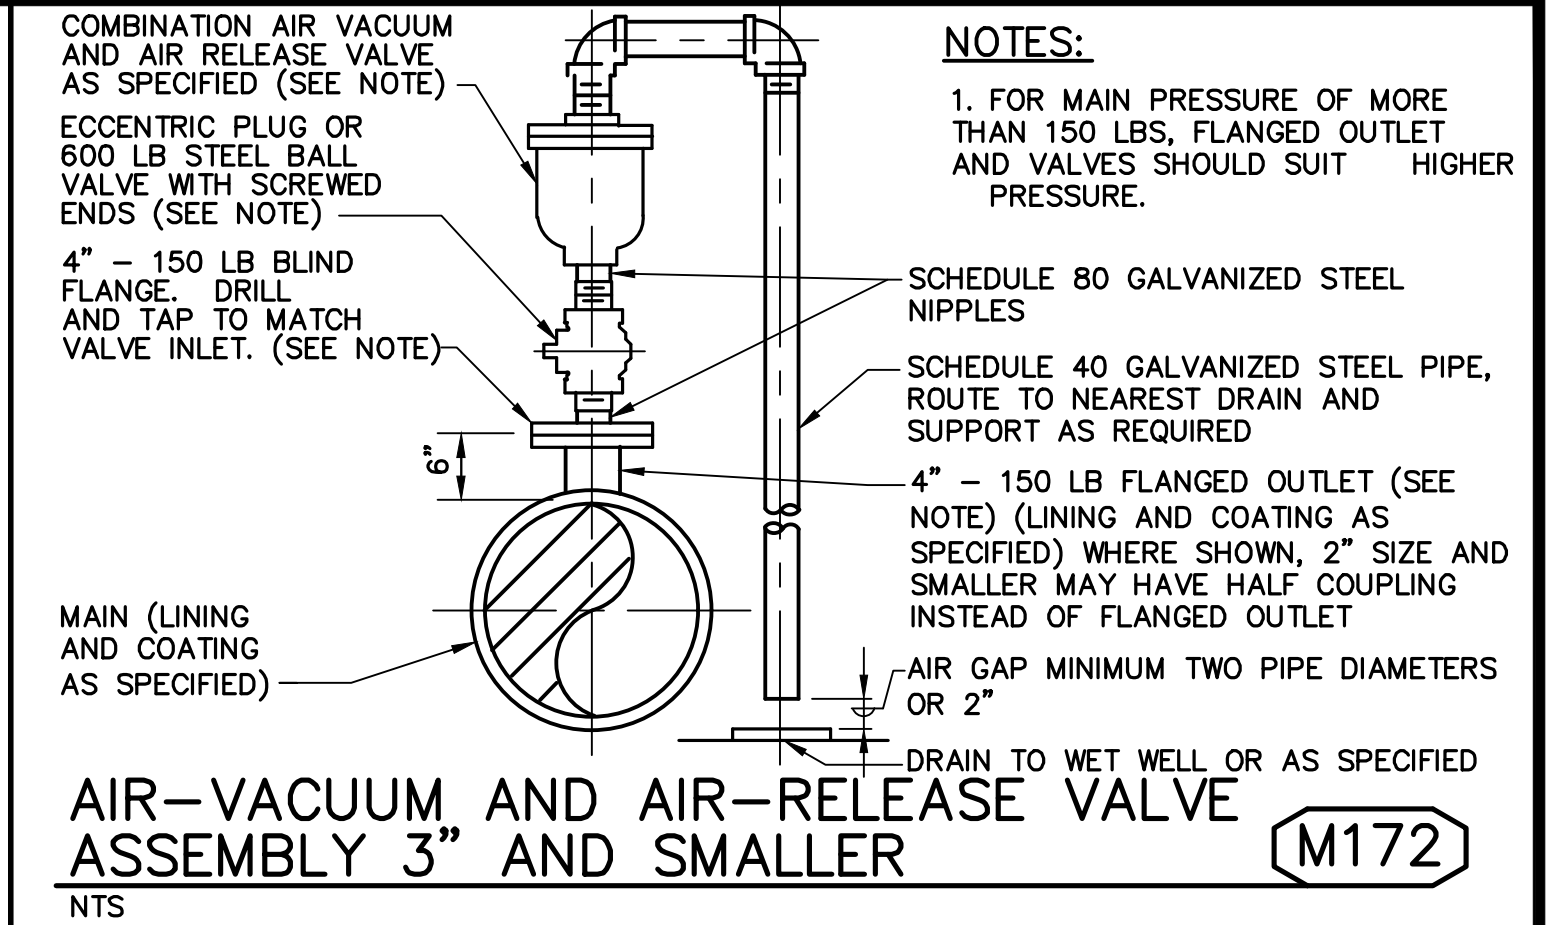


**AIR-VACUUM AND AIR-RELEASE VALVE ASSEMBLY 3" AND SMALLER** (M172)  
NTS

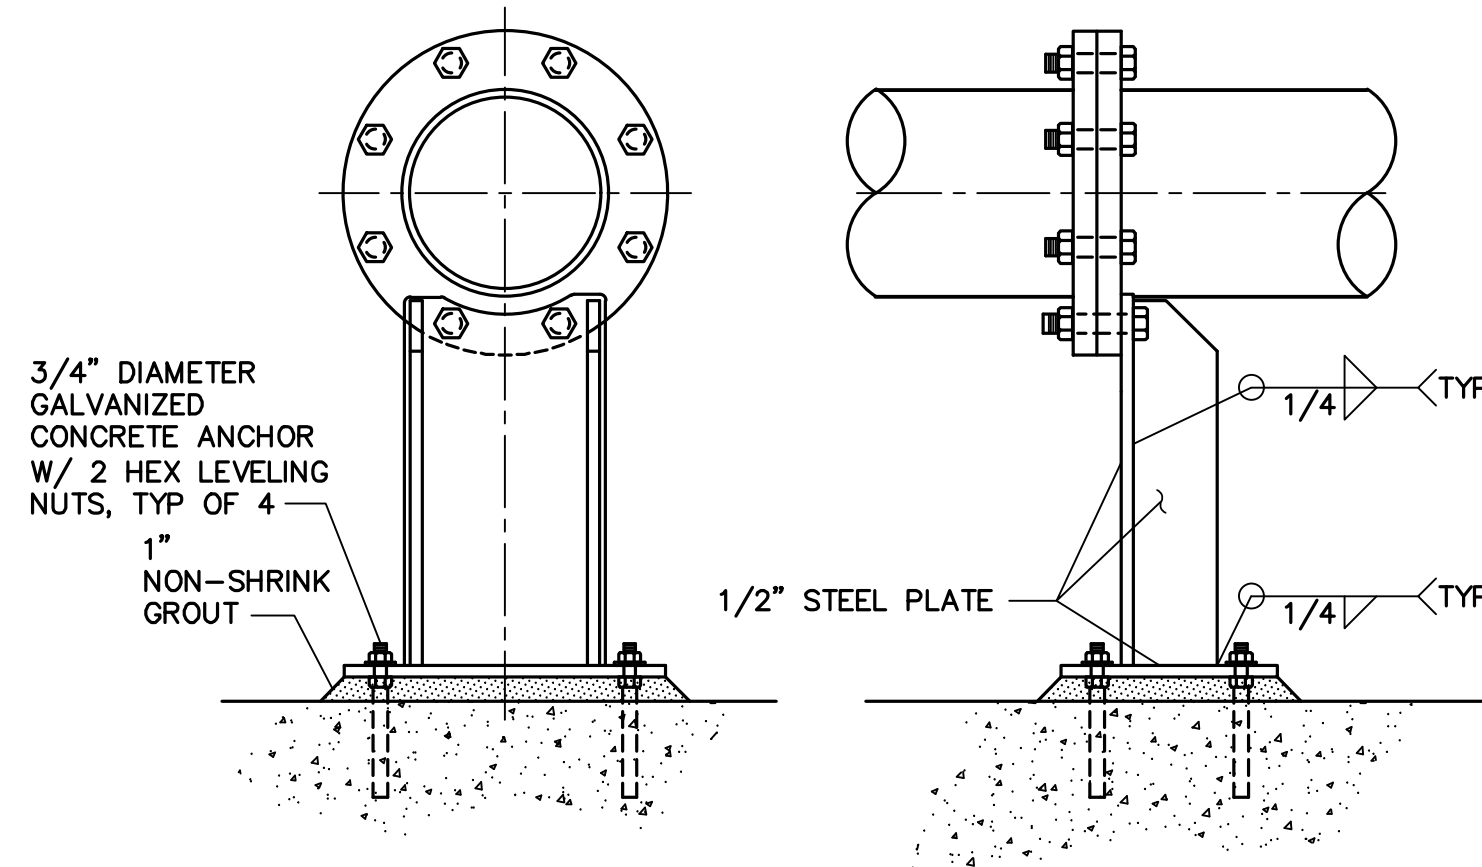

- NOTES:**
1. HOT-DIP GALVANIZE STEEL COMPONENTS AFTER FABRICATION.
  2. WHEN ATTACHING TO EXISTING CONCRETE, PROVIDE EQUIVALENT SIZE ADHESIVE ANCHORS.
  3. VERIFY PIPE OD PRIOR TO FABRICATION.

**PIPE SUPPORT 4" THRU 8"** (M163)  
NTS

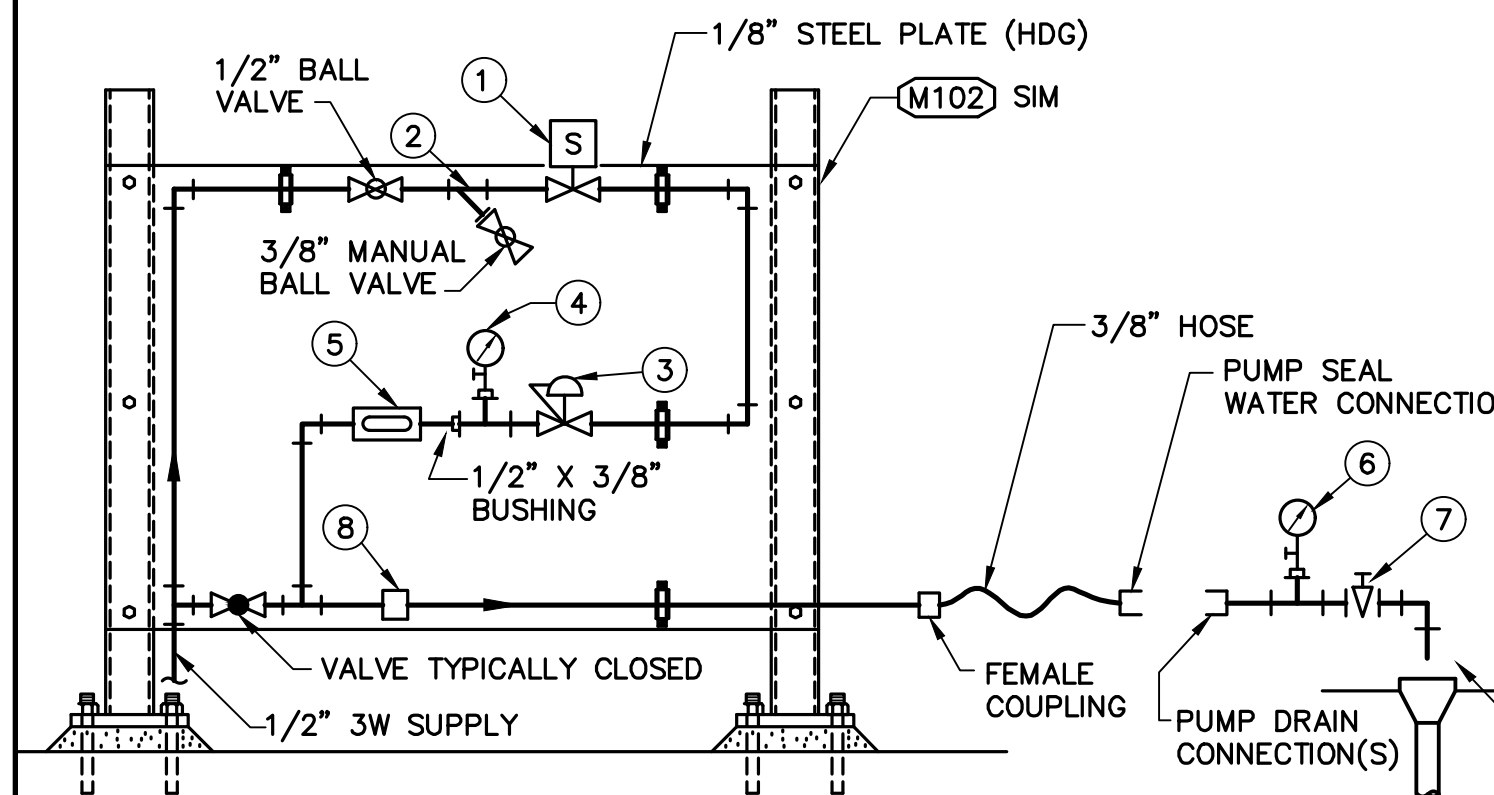

- 1 SOLENOID VALVE, SEE P&ID
- 2 WYE STRAINER
- 3 1/2" PRESSURE REGULATOR SET OUTLET PRESSURE AS RECOMMENDED BY PUMP MFR. FOR CLARIFIER EQUIPMENT, COORDINATE WITH MFR.
- 4 PRESSURE GAUGE, RANGE AS REQUIRED BY PUMP MFR (REQUIRED ONLY FOR SINGLE MECHANICAL SEAL AND PACKING TYPE PUMP SEALS)
- 5 3/8" SIGHT GLASS (REQUIRED FOR MECHANICAL SEAL ONLY)
- 6 PRESSURE GAUGE, RANGE AS REQUIRED BY PUMP MFR (REQUIRED FOR DOUBLE MECHANICAL PUMP SEALS ONLY)
- 7 1/2" NEEDLE VALVE (REQUIRED FOR DOUBLE MECHANICAL PUMP SEALS ONLY)
- 8 FLOW SWITCH (FSL)

- NOTES:**
1. PIPING CONFIGURATION IS SHOWN SCHEMATICALLY. CONTRACTOR SHALL CONFIGURE AS REQUIRED.
  1. ALTERNATE CONFIGURATION. ASSEMBLY SHALL BE WALL MOUNTED, IF SPECIFIED.

**SEAL WATER ASSEMBLY** (M170)  
NTS

FILENAME: 0055-006-M-2\_8-01-22\_11:28am.ctb XREFS: X-SMCS0-TBLK.ctb

**RECORD DRAWING**  
THIS RECORD DRAWING HAS BEEN PREPARED FROM THE ORIGINAL CONTRACT DOCUMENTS SIGNED AND SEALED BY THE RESPONSIBLE ENGINEER OF RECORD. ADDITIONAL INFORMATION HAS BEEN PROVIDED BY OTHERS TO REPRESENT AS-CONSTRUCTED CONDITION AND IS SHOWN ON THESE RECORD DRAWINGS. THE RESPONSIBLE ENGINEER OF RECORD CANNOT VERIFY THE ACCURACY OF THE AS-CONSTRUCTED CONDITION INFORMATION REPRESENTED ON THE RECORD DRAWINGS.

0" = 1" — VERIFY SCALES — BAR IS ONE INCH LONG ON FULL SIZE DRAWING. IF NOT ONE INCH LONG ON THIS DRAWING, ADJUST SCALES ACCORDINGLY




REV	DATE	BY	APVD	DESCRIPTION
▲				
▲				
▲				
▲	07/22	CT	TV	RECORD DRAWING


DESIGNED	M. TAKEMOTO	SUBMITTED	MARK TAKEMOTO
DRAWN	S. JUNG		RMC PROJECT ENGINEER CE-64369
CHECKED	M. NAKAMOTO	APPROVED	STEVE CLARY
			RMC ENGINEER CE-30318




TREATMENT AND WET WEATHER FLOW UPGRADE	DWG NO	M-6
MECHANICAL STANDARD DETAILS - 6	SHEET NO	118 OF 226
	PROJ NO	055-006
	DATE	JULY 2022

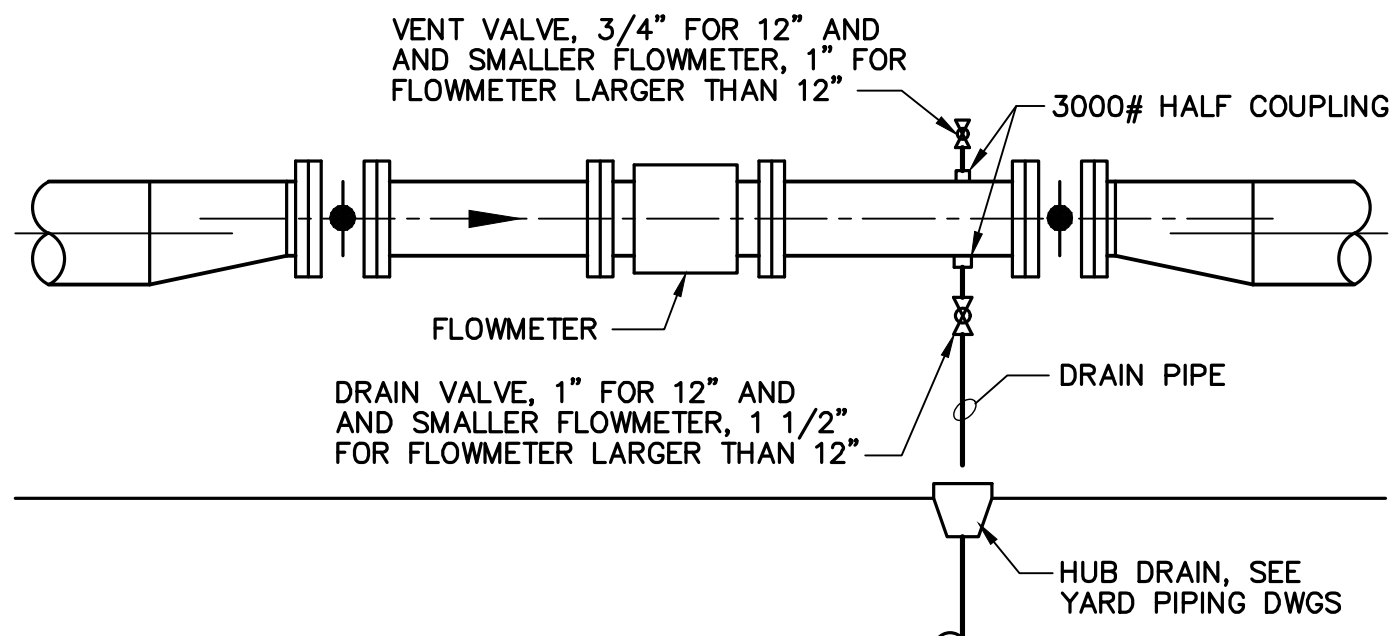


**FLOWMETER VENT/DRAIN** (M214)  
NTS

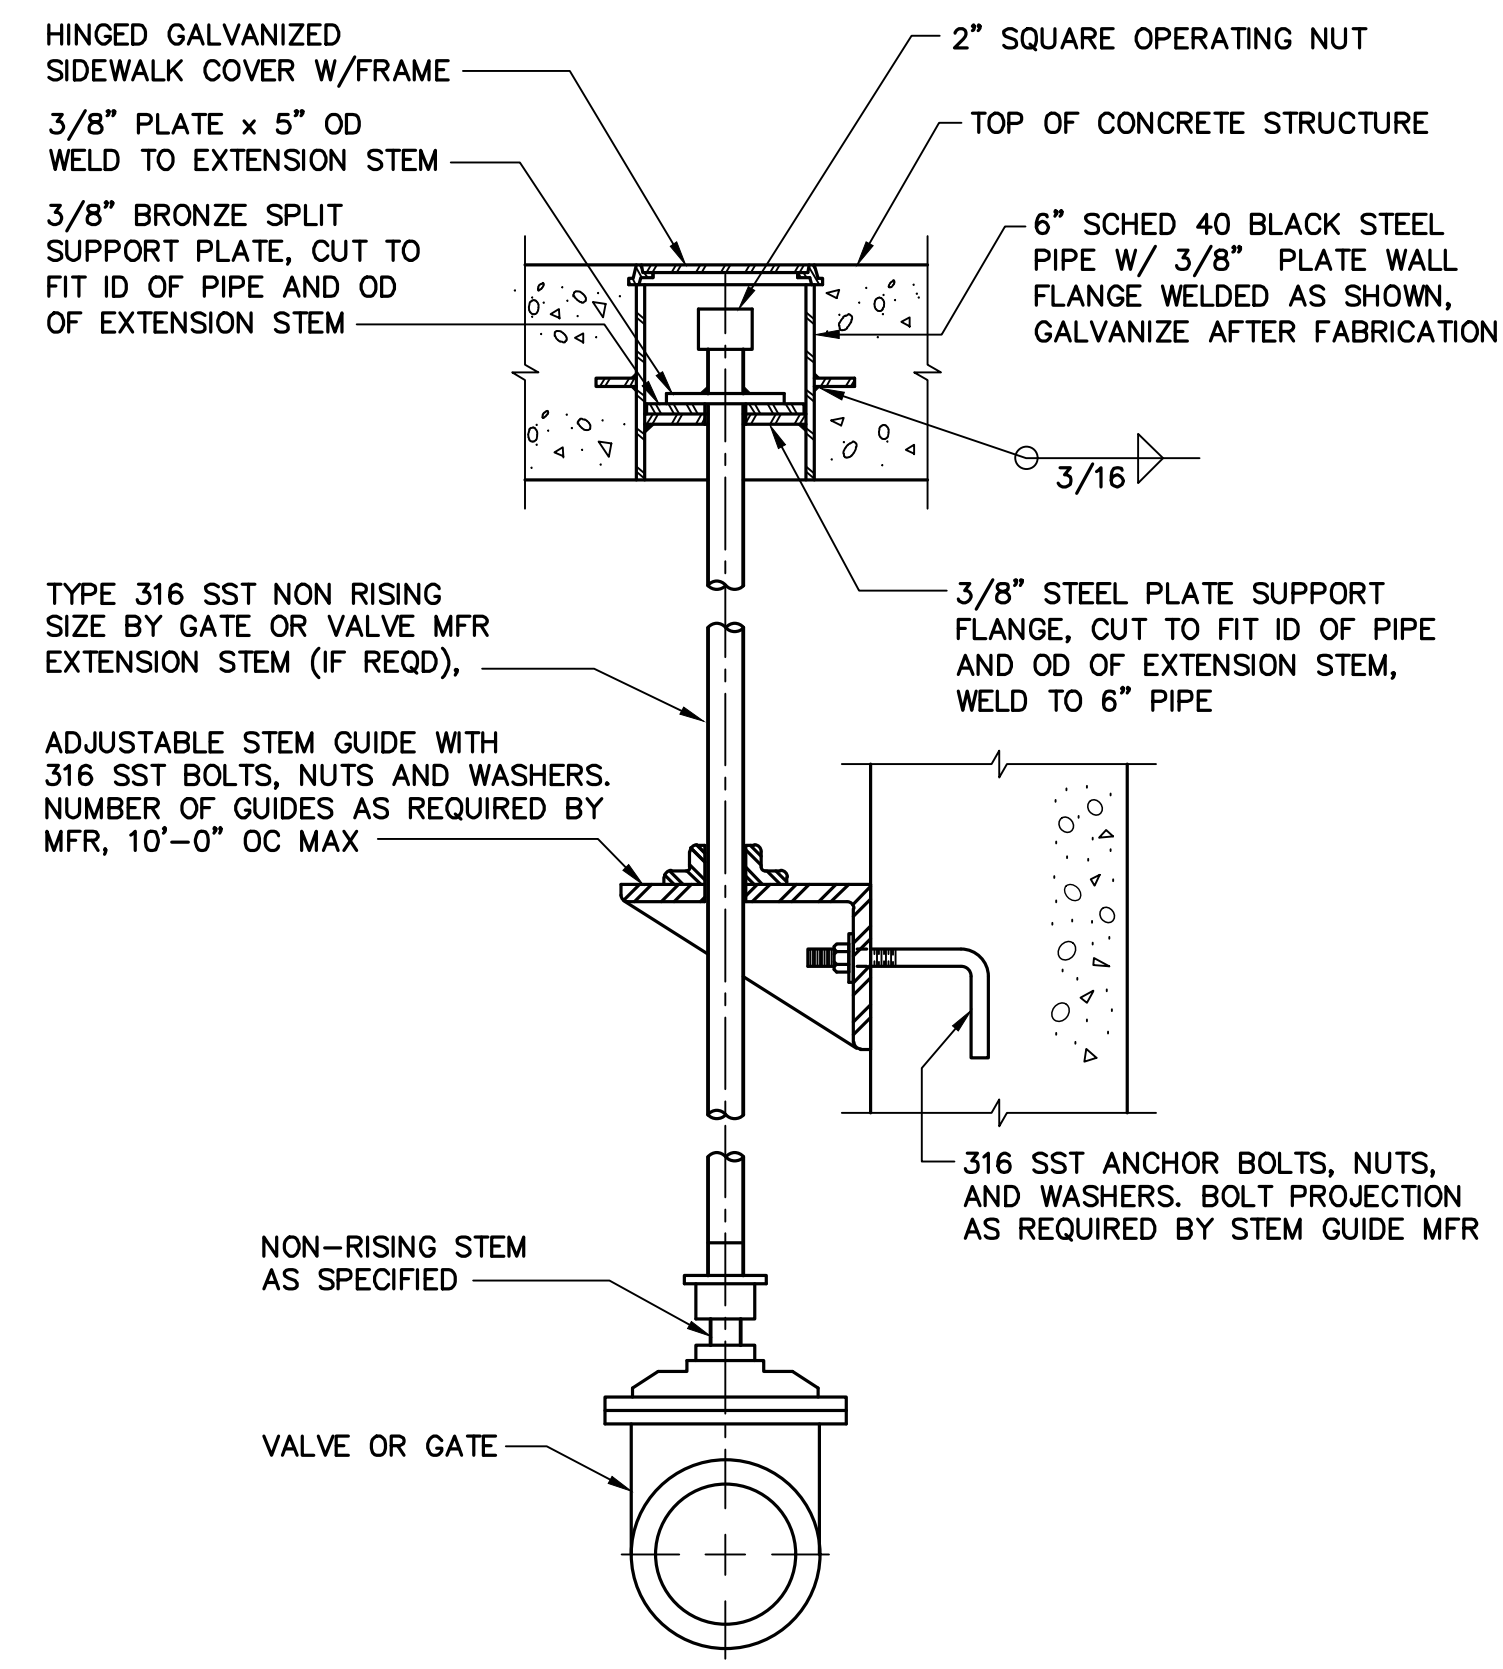

**FLOOR BOX OPERATOR** (M230)  
NTS

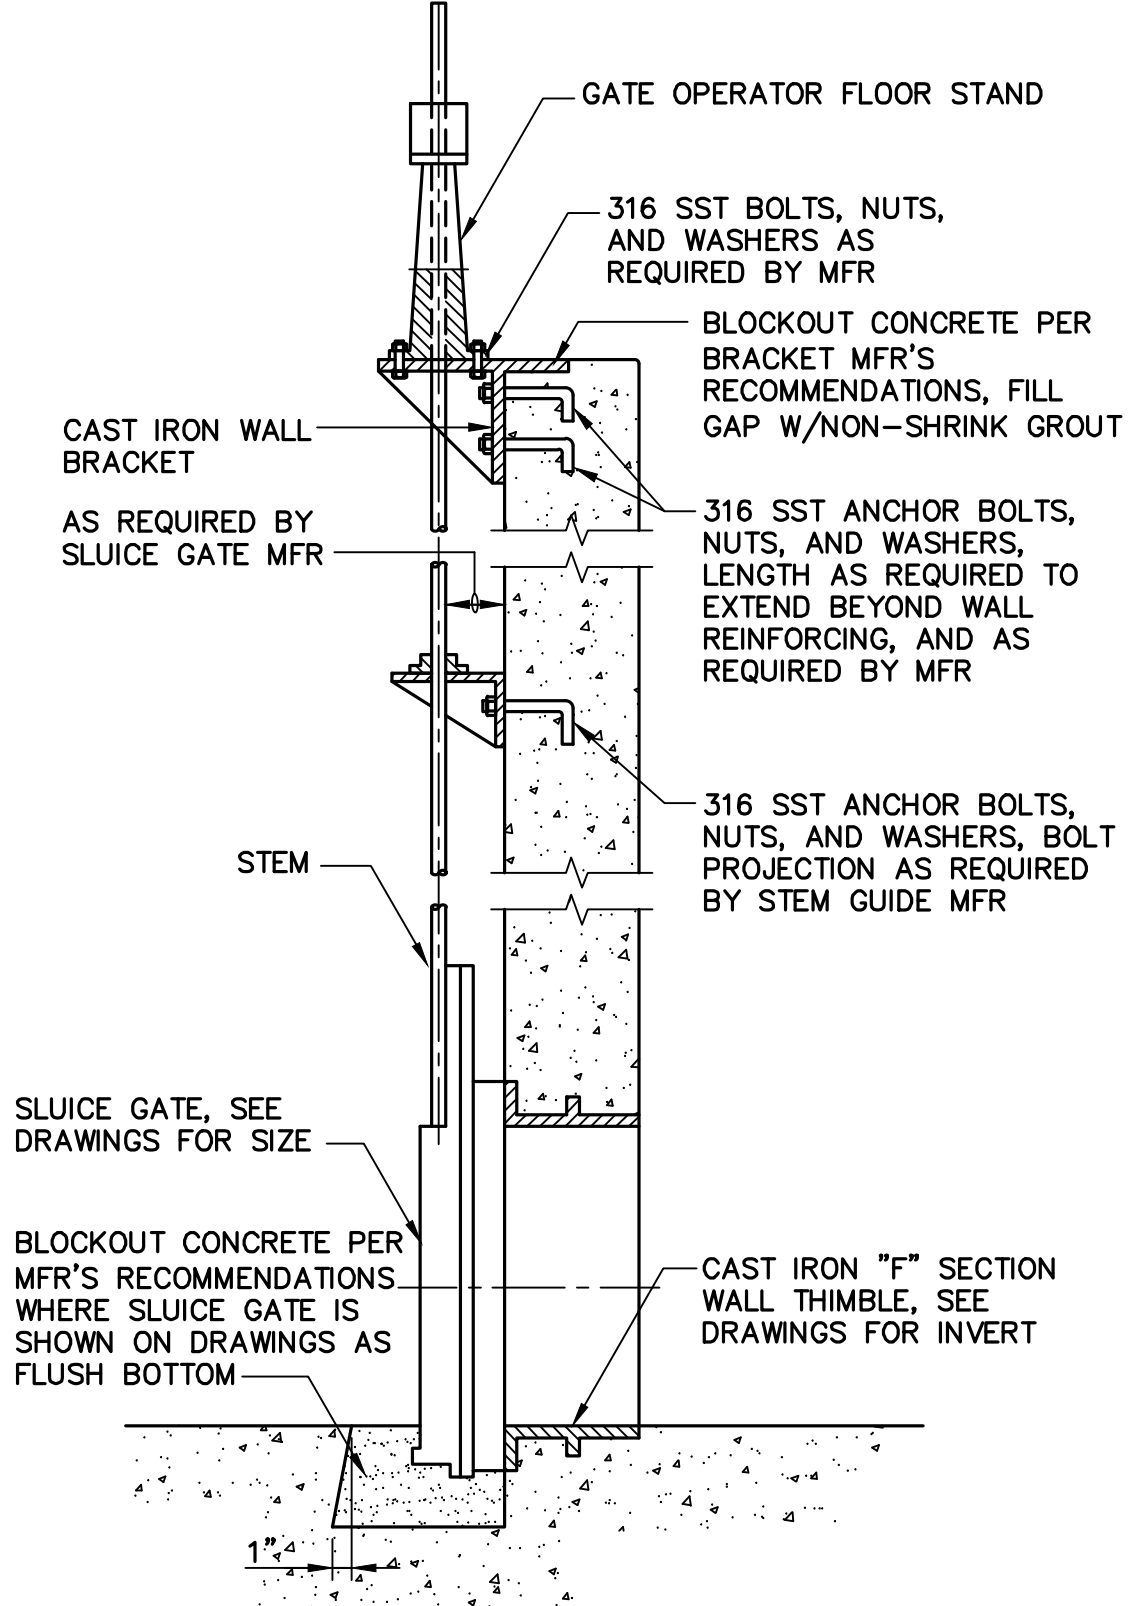


**WALL BRACKET**

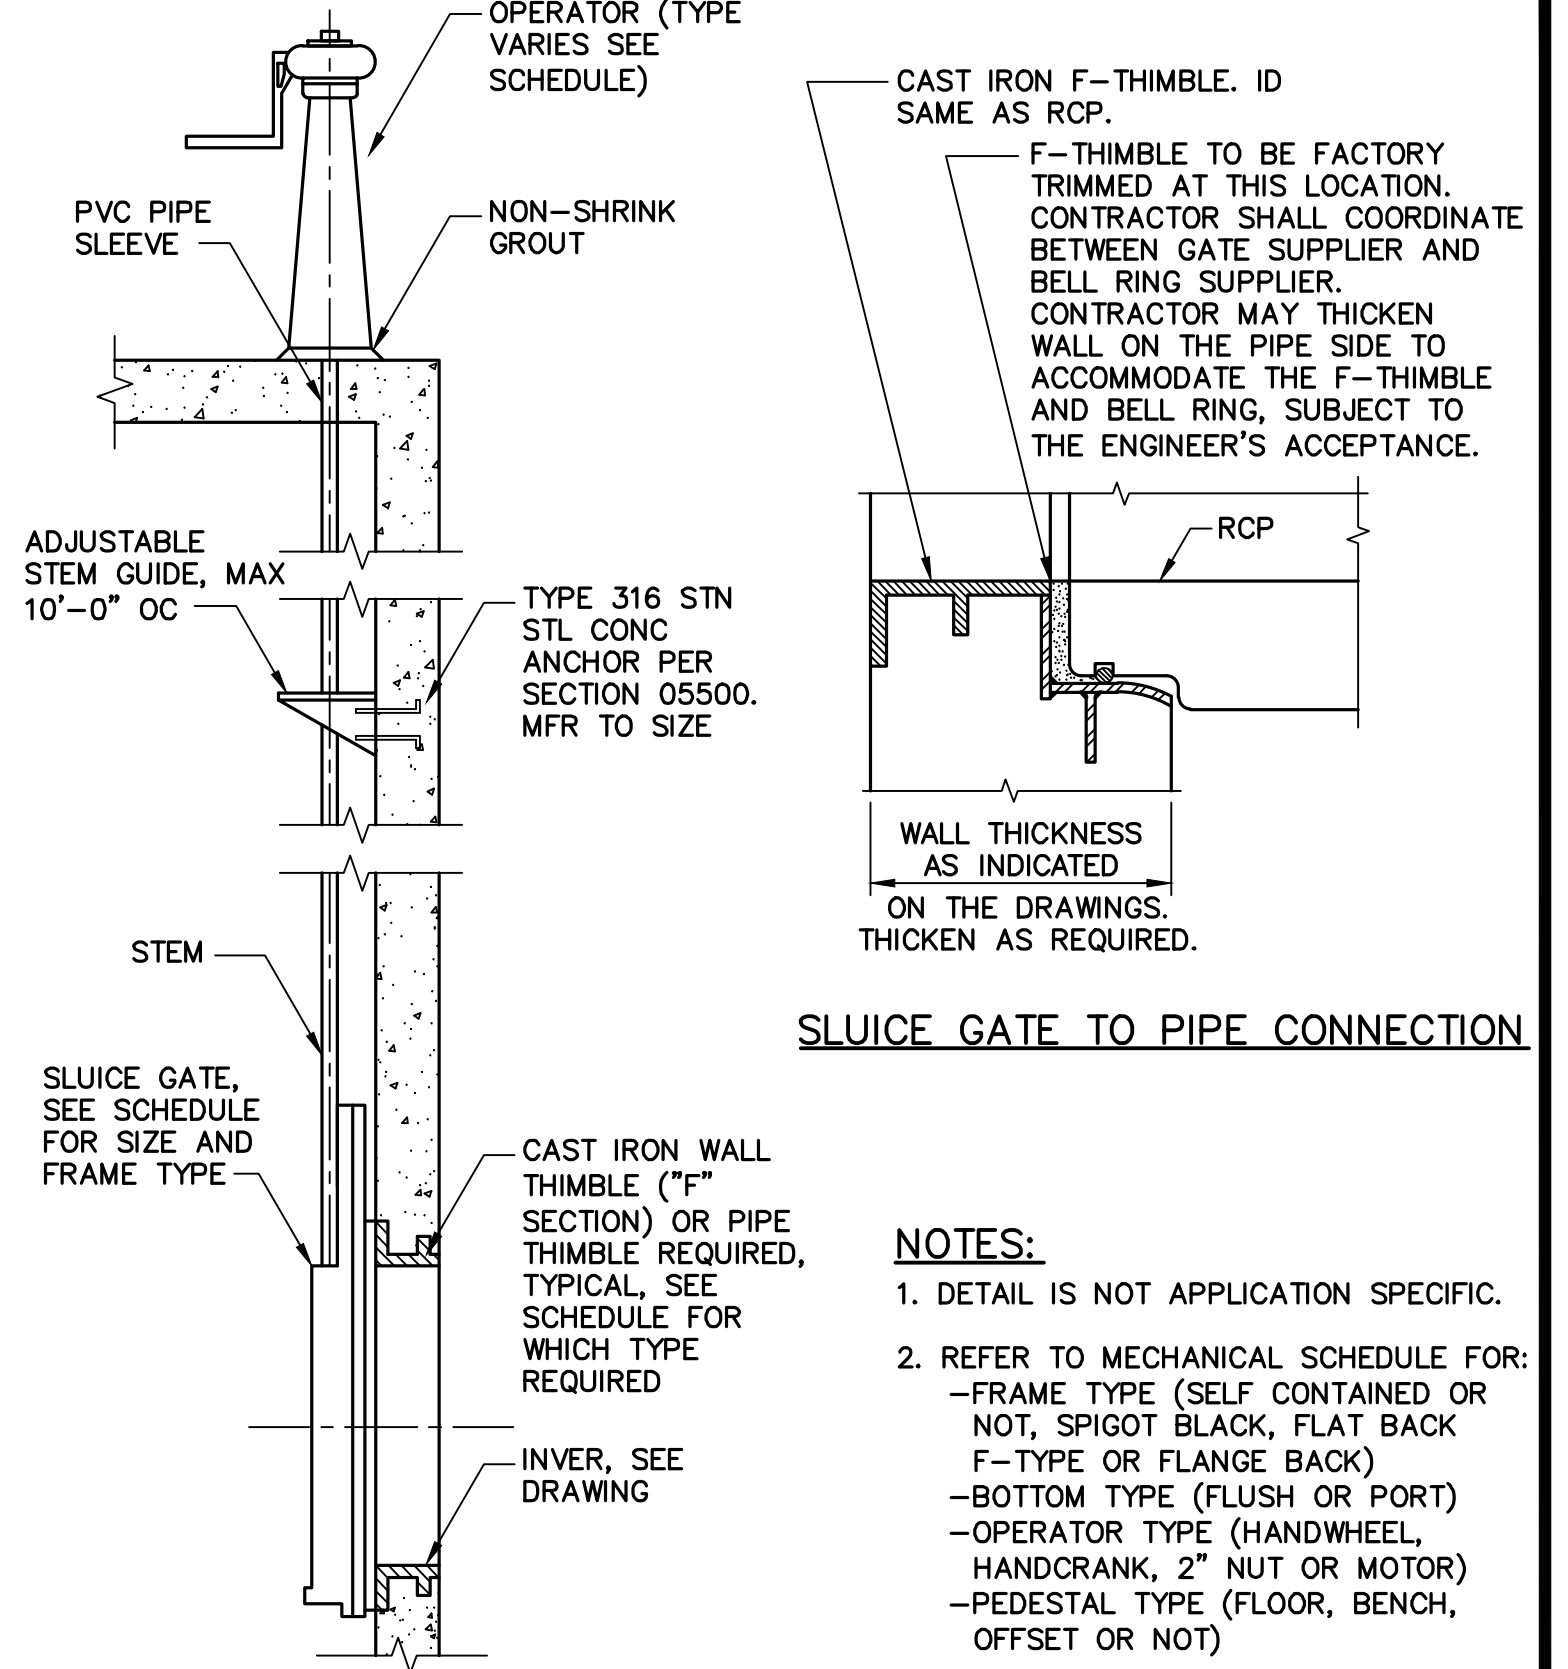

**SLUICE GATE TO PIPE CONNECTION**

- NOTES:**
- DETAIL IS NOT APPLICATION SPECIFIC.
  - REFER TO MECHANICAL SCHEDULE FOR:
    - FRAME TYPE (SELF CONTAINED OR NOT, SPIGOT BACK, FLAT BACK F-TYPE OR FLANGE BACK)
    - BOTTOM TYPE (FLUSH OR PORT)
    - OPERATOR TYPE (HANDWHEEL, HANDCRANK, 2" NUT OR MOTOR)
    - PEDESTAL TYPE (FLOOR, BENCH, OFFSET OR NOT)


**SLUICE GATE** (M250)  
NTS

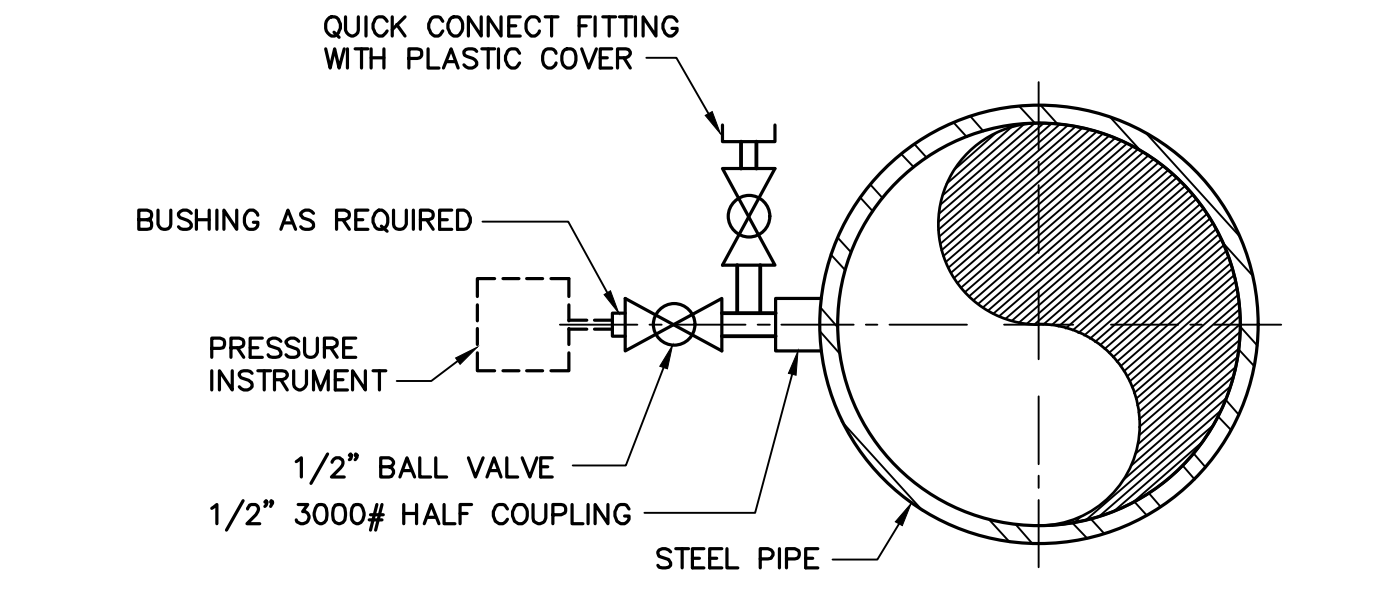


**PRESSURE INSTRUMENT CONNECTION** (M218)  
NTS




**MUD VALVE** (M233)  
NTS

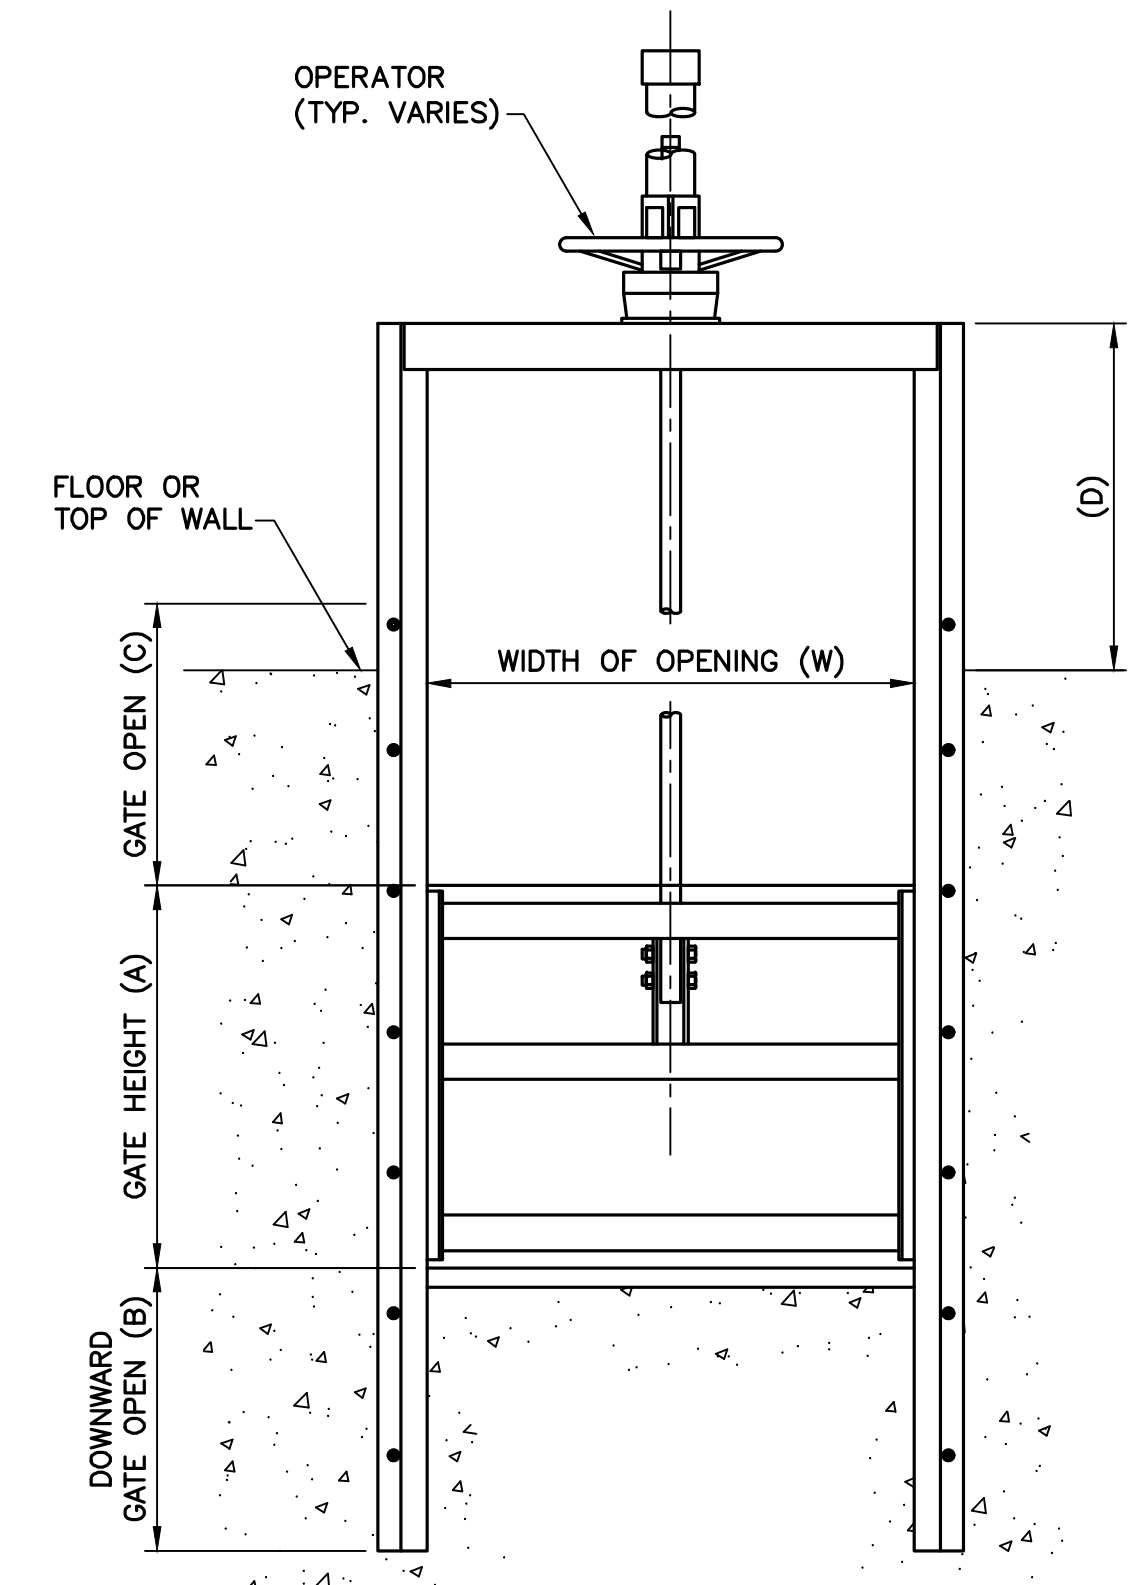

**CHAIN ACTUATED VALVE OPERATOR** (M234)  
NTS

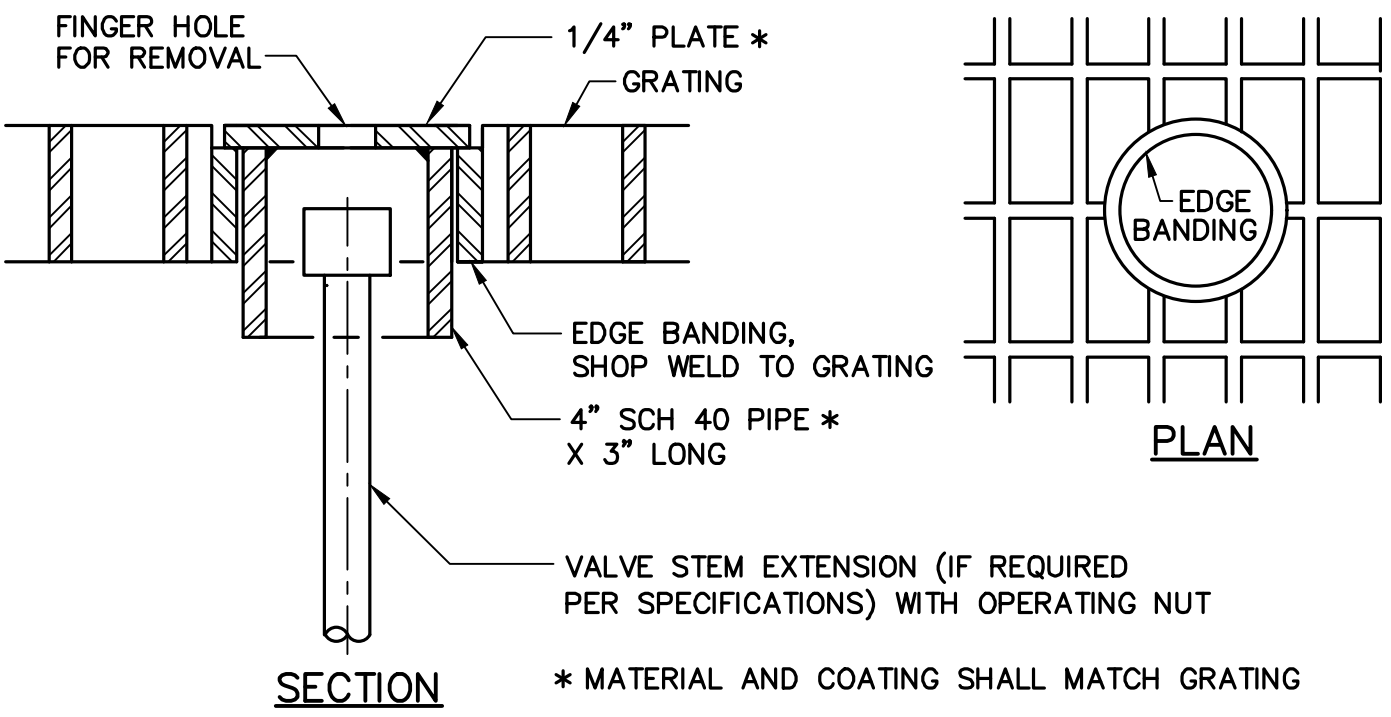

**OPERATING NUT ACCESS OPENING** (M232)  
NTS

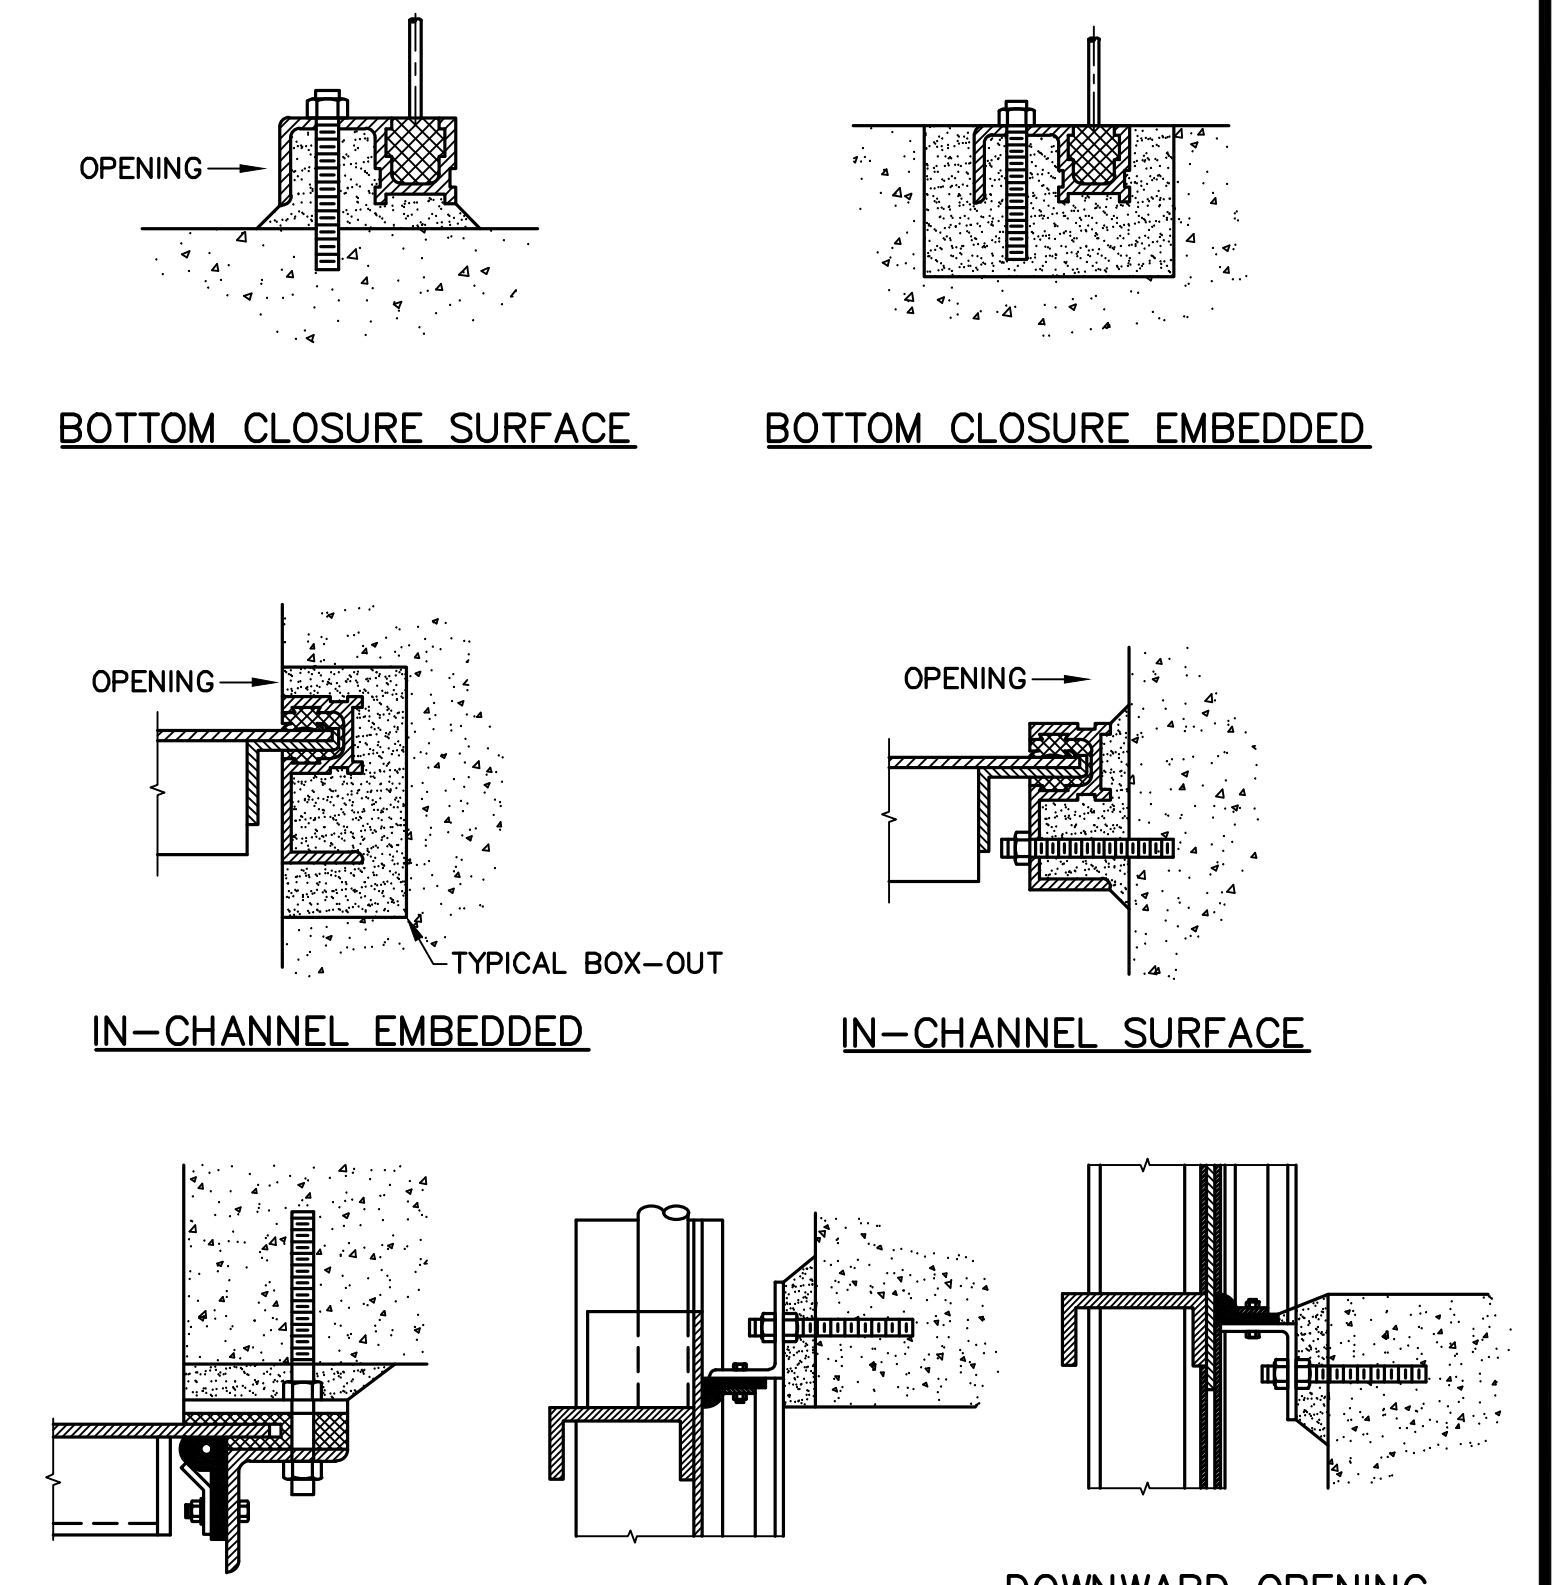

**SLIDE GATE** (M254)  
NTS

FILENAME: 0055-006-M-2 8-01-22 11:28am cto XREFS: X-SWCS0-TBLK ICS-

**RECORD DRAWING**  
THIS RECORD DRAWING HAS BEEN PREPARED FROM THE ORIGINAL CONTRACT DOCUMENTS SIGNED AND SEALED BY THE RESPONSIBLE ENGINEER OF RECORD. ADDITIONAL INFORMATION HAS BEEN PROVIDED BY OTHERS TO REPRESENT AS-CONSTRUCTED CONDITION AND IS SHOWN ON THESE RECORD DRAWINGS. THE RESPONSIBLE ENGINEER OF RECORD CANNOT VERIFY THE ACCURACY OF THE AS-CONSTRUCTED CONDITION INFORMATION REPRESENTED ON THE RECORD DRAWINGS.

0" = 1"  
VERIFY SCALES — BAR IS ONE INCH LONG ON FULL SIZE DRAWING. IF NOT ONE INCH LONG ON THIS DRAWING, ADJUST SCALES ACCORDINGLY




REV	DATE	BY	APVD	DESCRIPTION
1	07/22	CT	TV	RECORD DRAWING

DESIGNED	M. TAKEMOTO	SUBMITTED	MARK TAKEMOTO
DRAWN	S. JUNG		RMC PROJECT ENGINEER CE-64369
CHECKED	M. NAKAMOTO	APPROVED	STEVE CLARY
			RMC ENGINEER CE-30318










TREATMENT AND WET WEATHER FLOW UPGRADE		DWG NO	M-7
MECHANICAL STANDARD DETAILS - 7		SHEET NO	119 OF 226
		PROJ NO	055-006
		DATE	JULY 2022

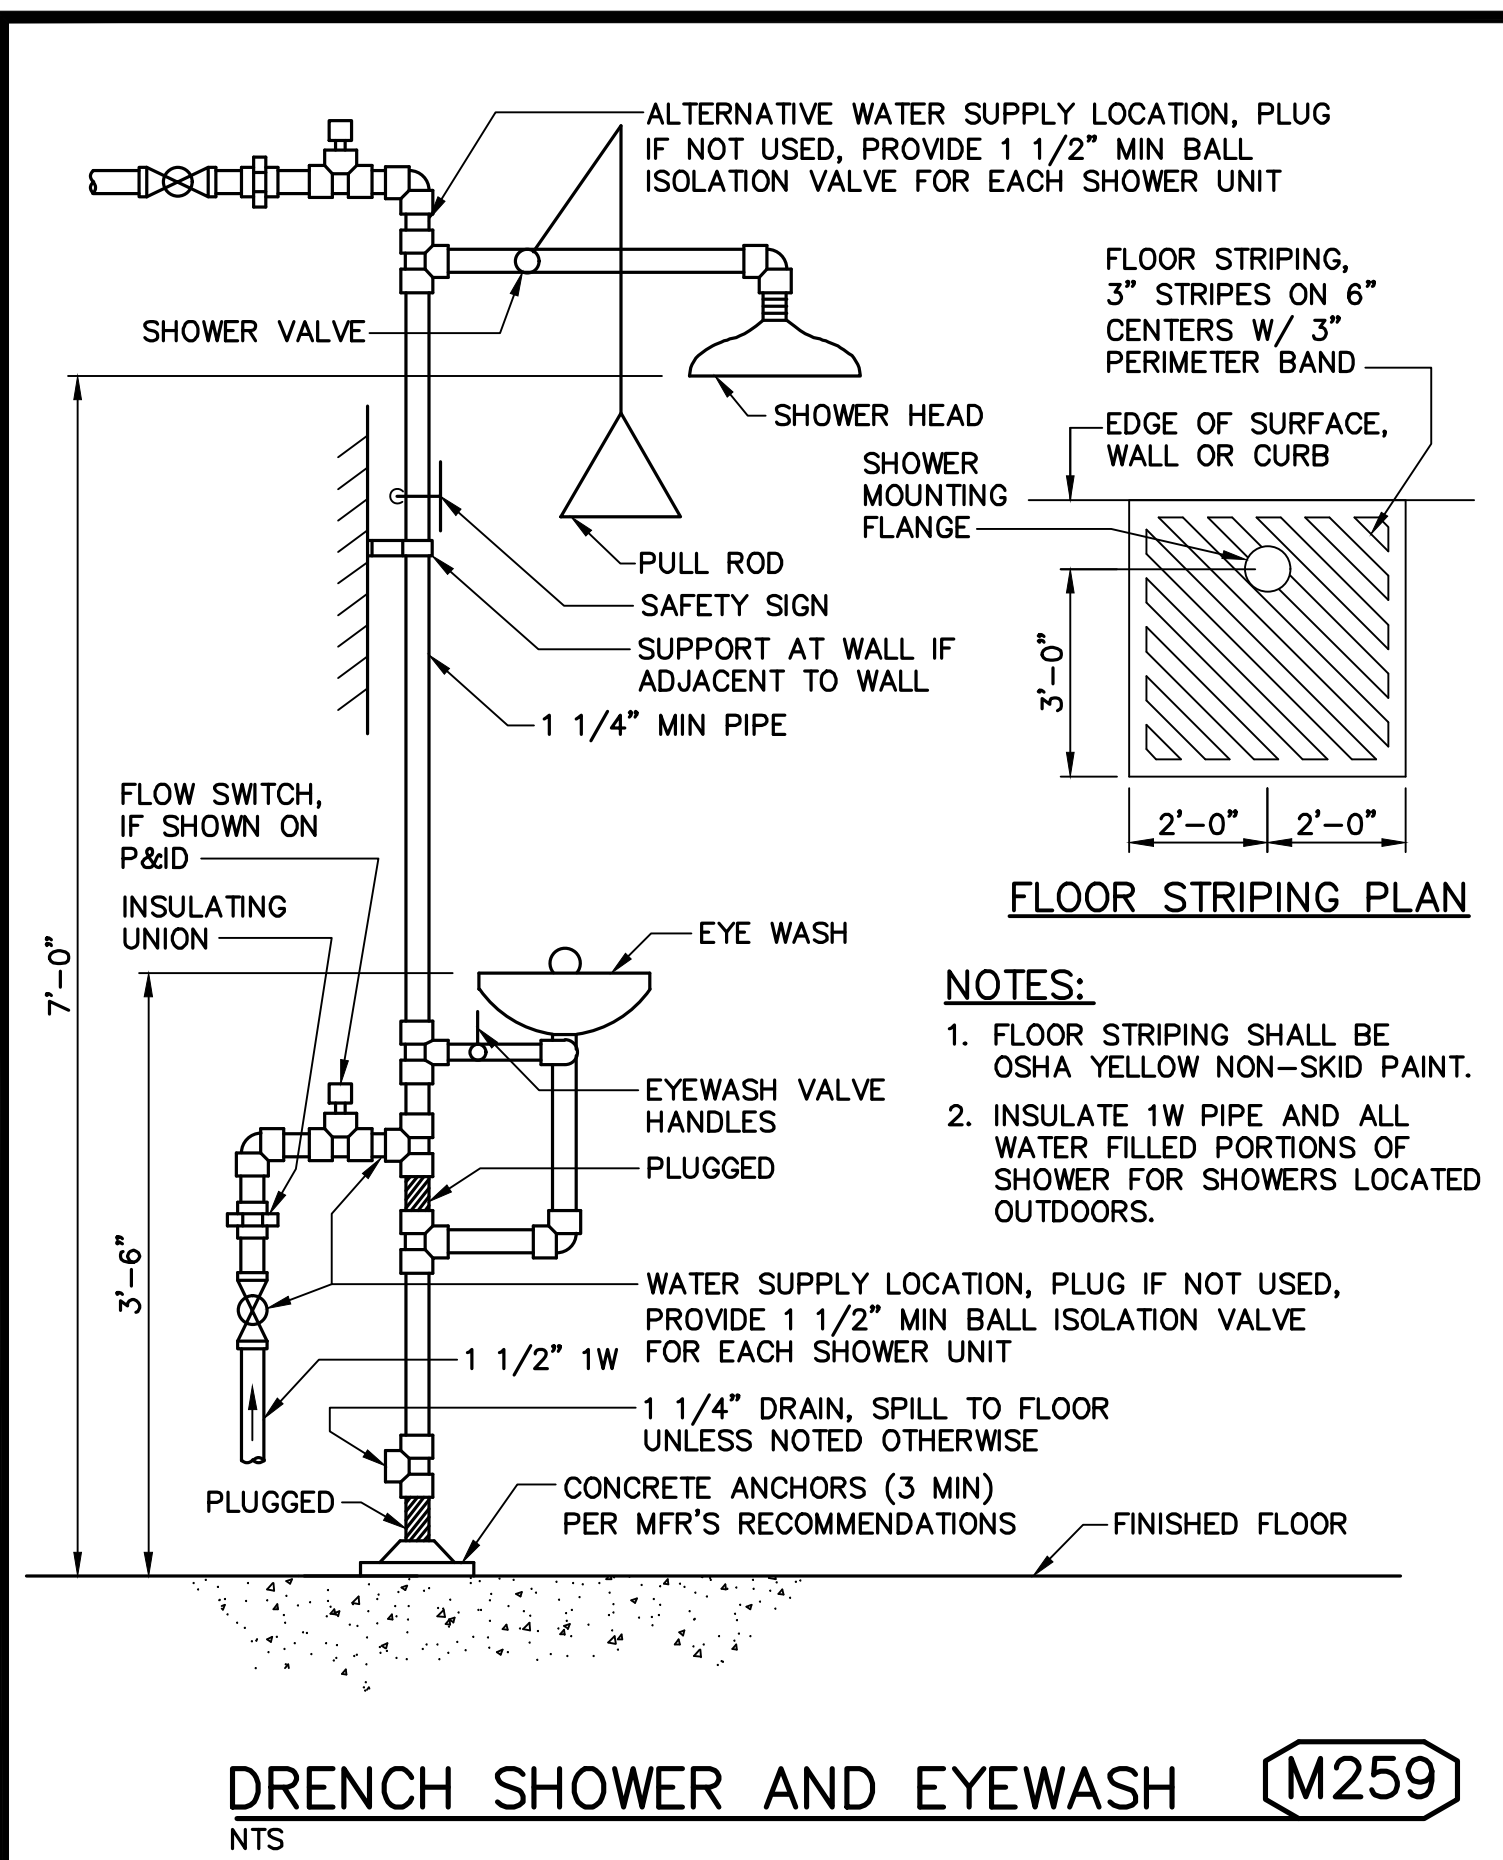

**HOSE RACK**

RACK TYPE	DIMENSIONS IN INCHES							
	A	B	C	D	E	F	G	H
TYPE 1 (3/4" & 1" HOSE)	18	11	10	9 1/2	3	7 1/2	9	1 1/4
TYPE 2 (1 1/2" HOSE)	24	14	14	12	3 1/2	10	12 1/2	1 1/2

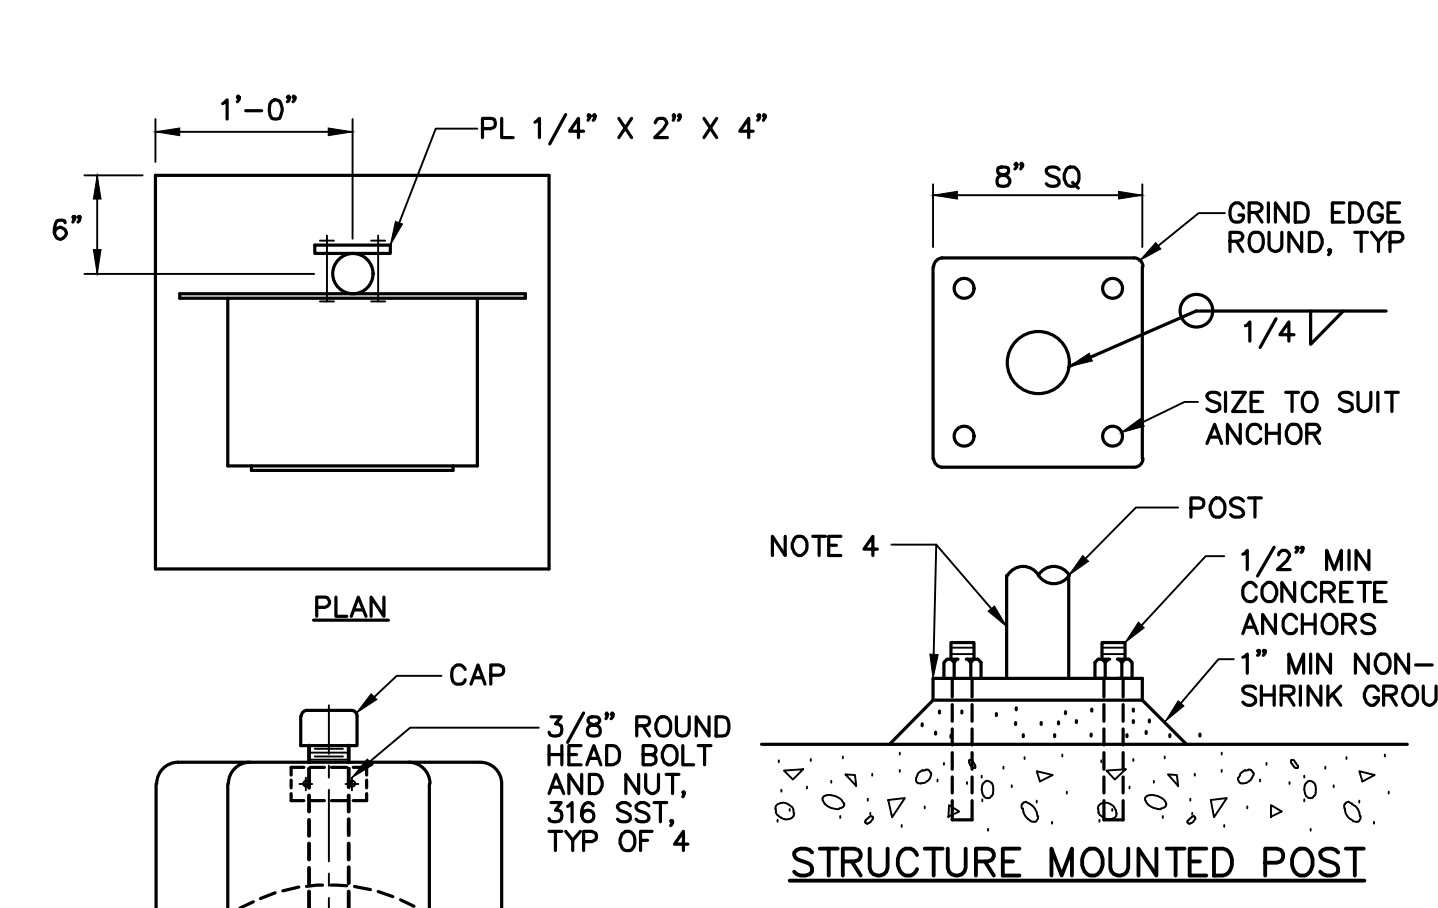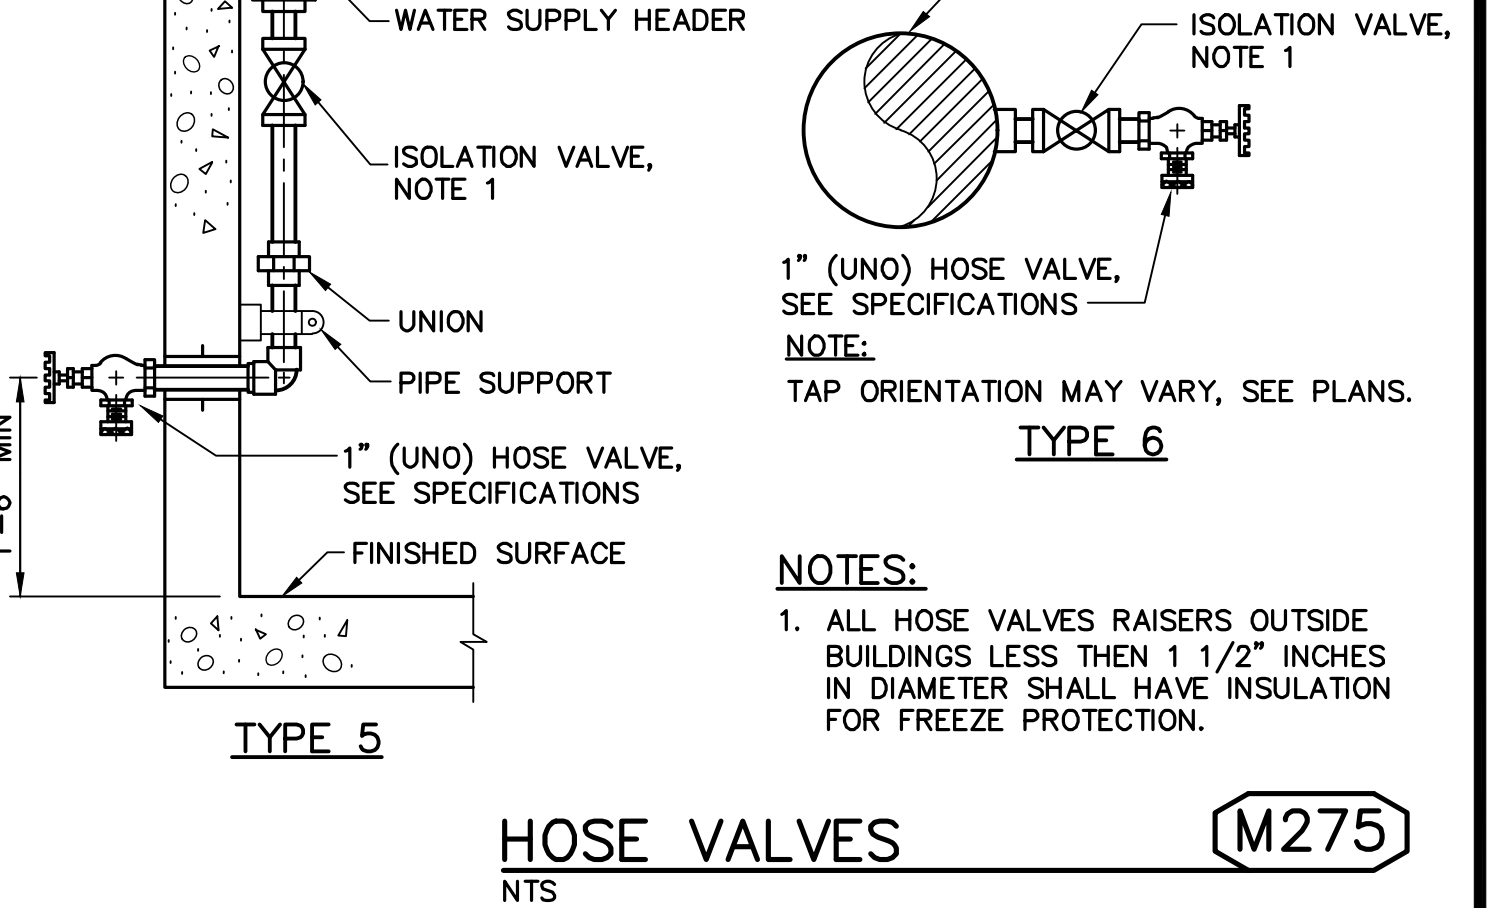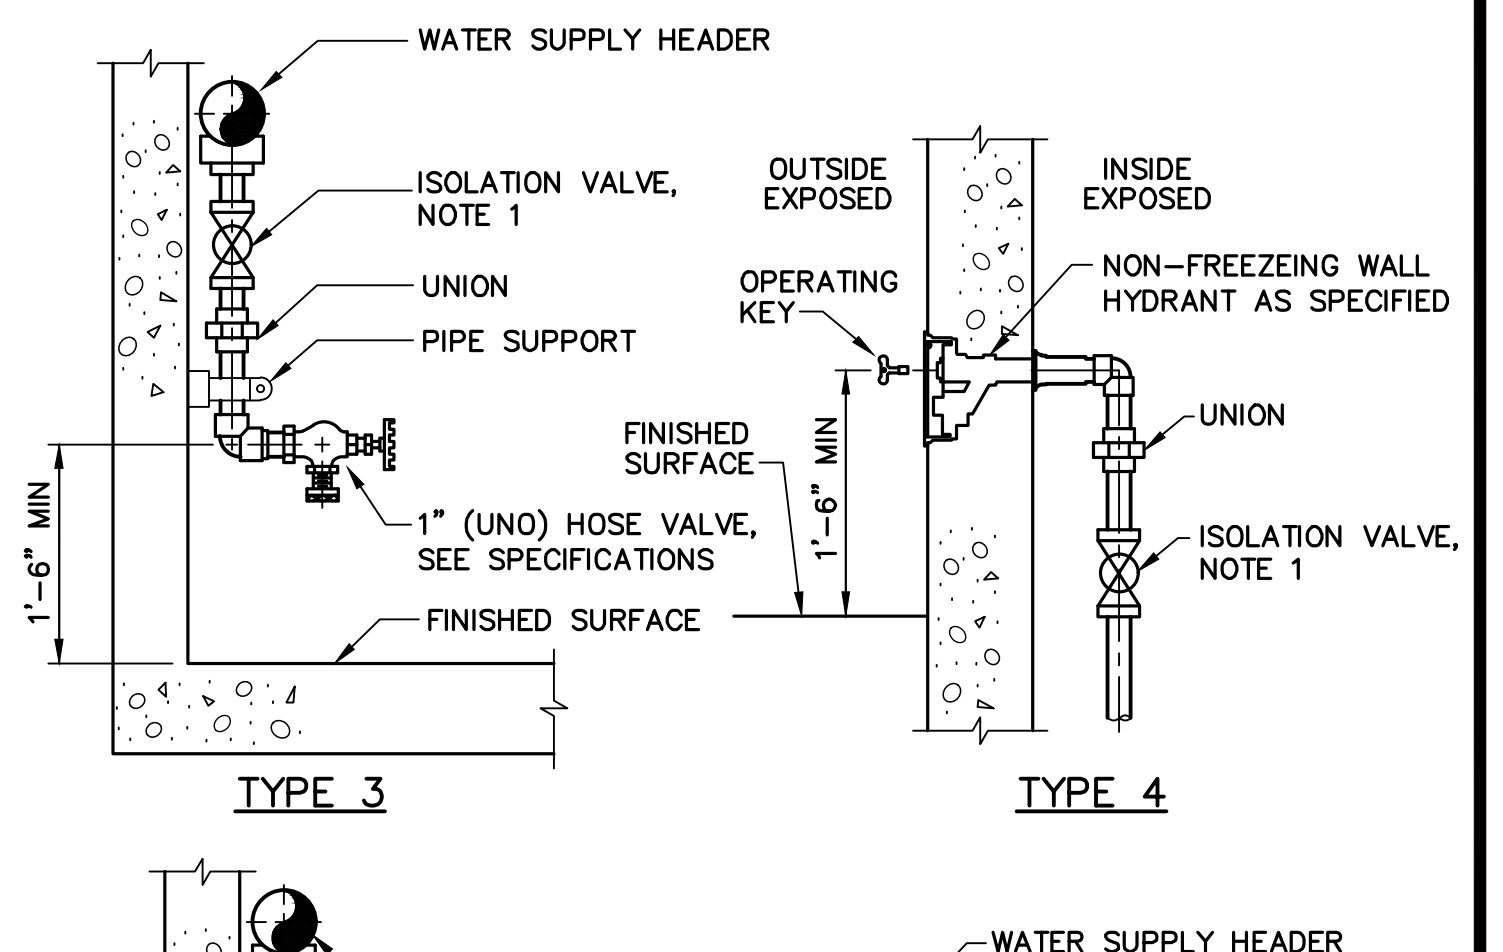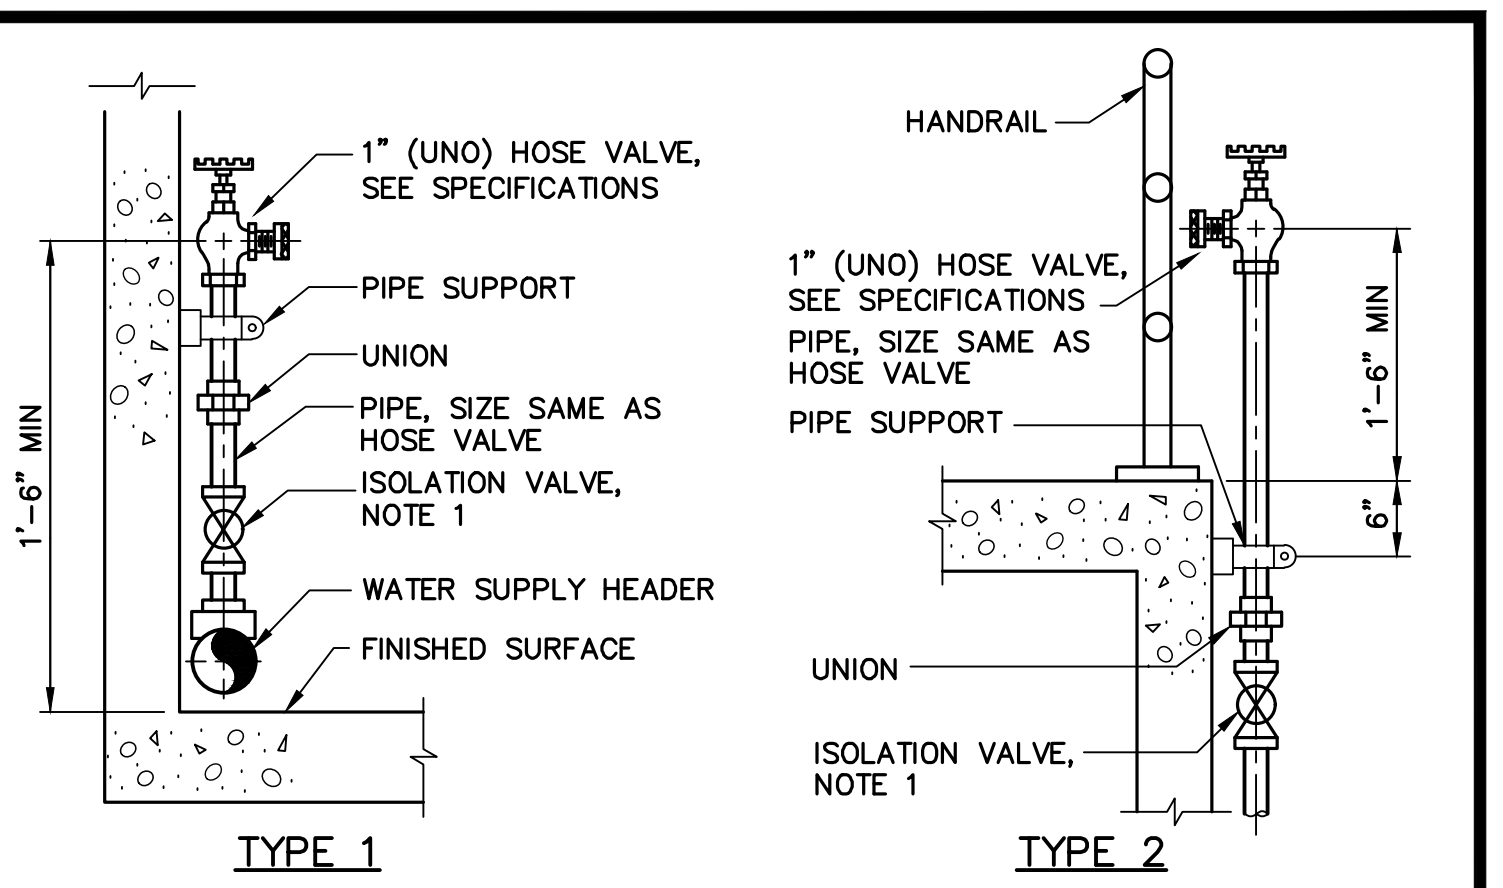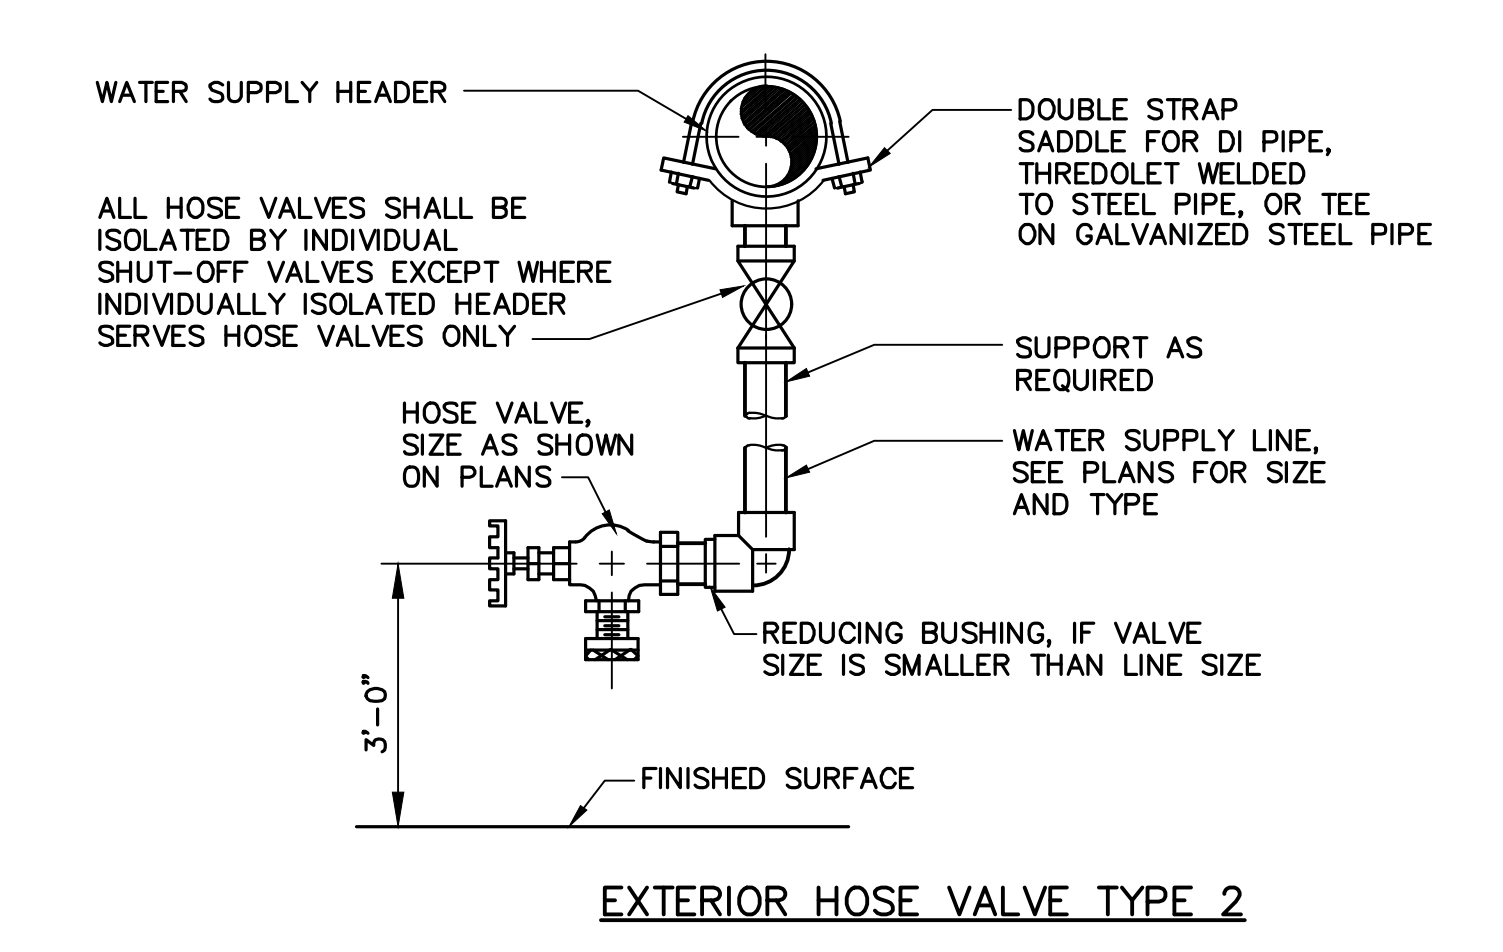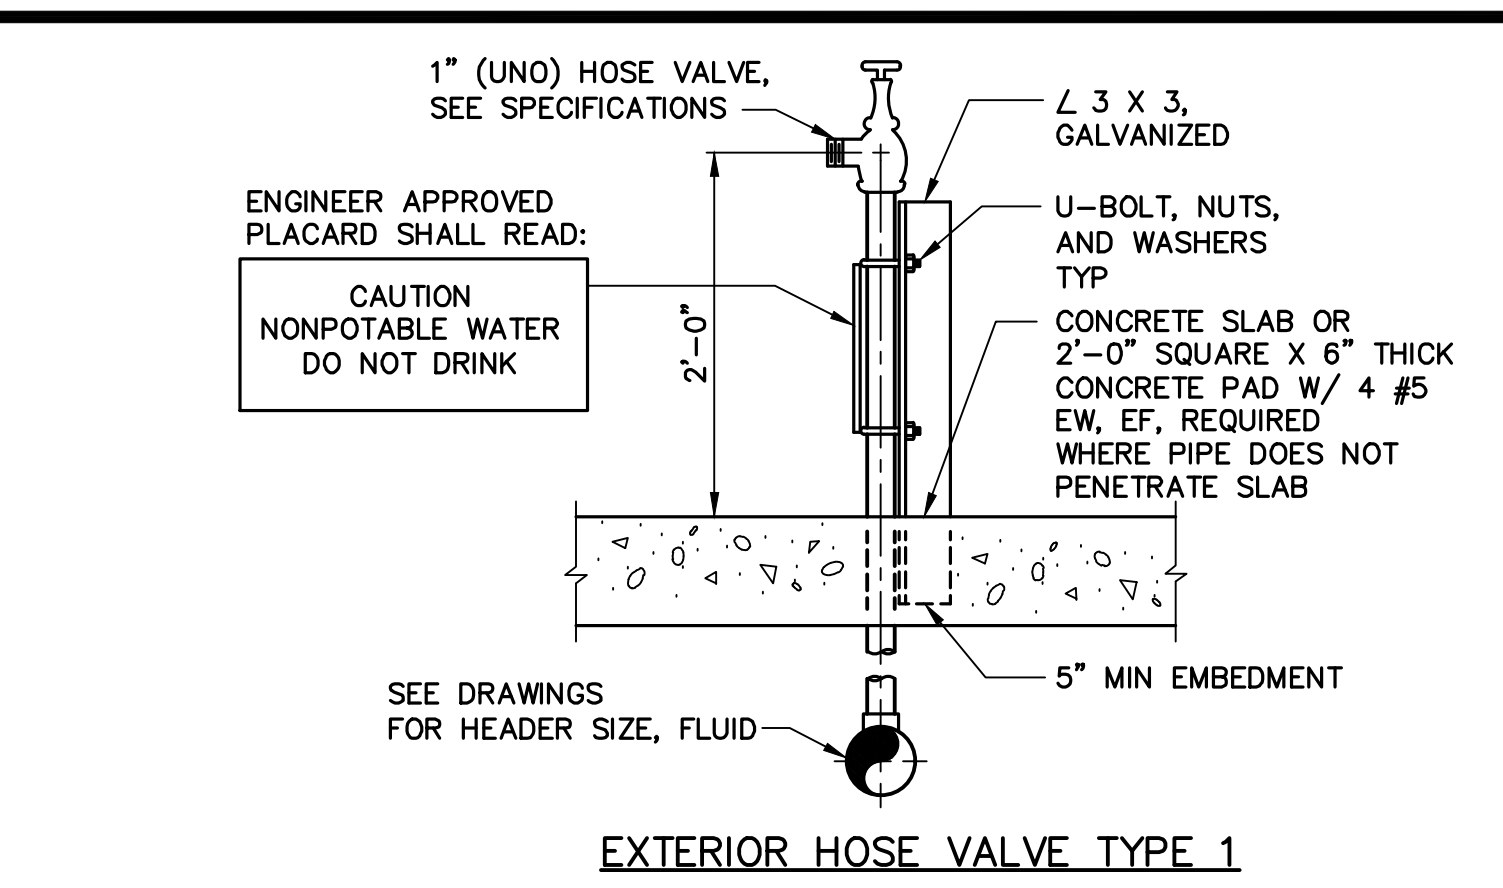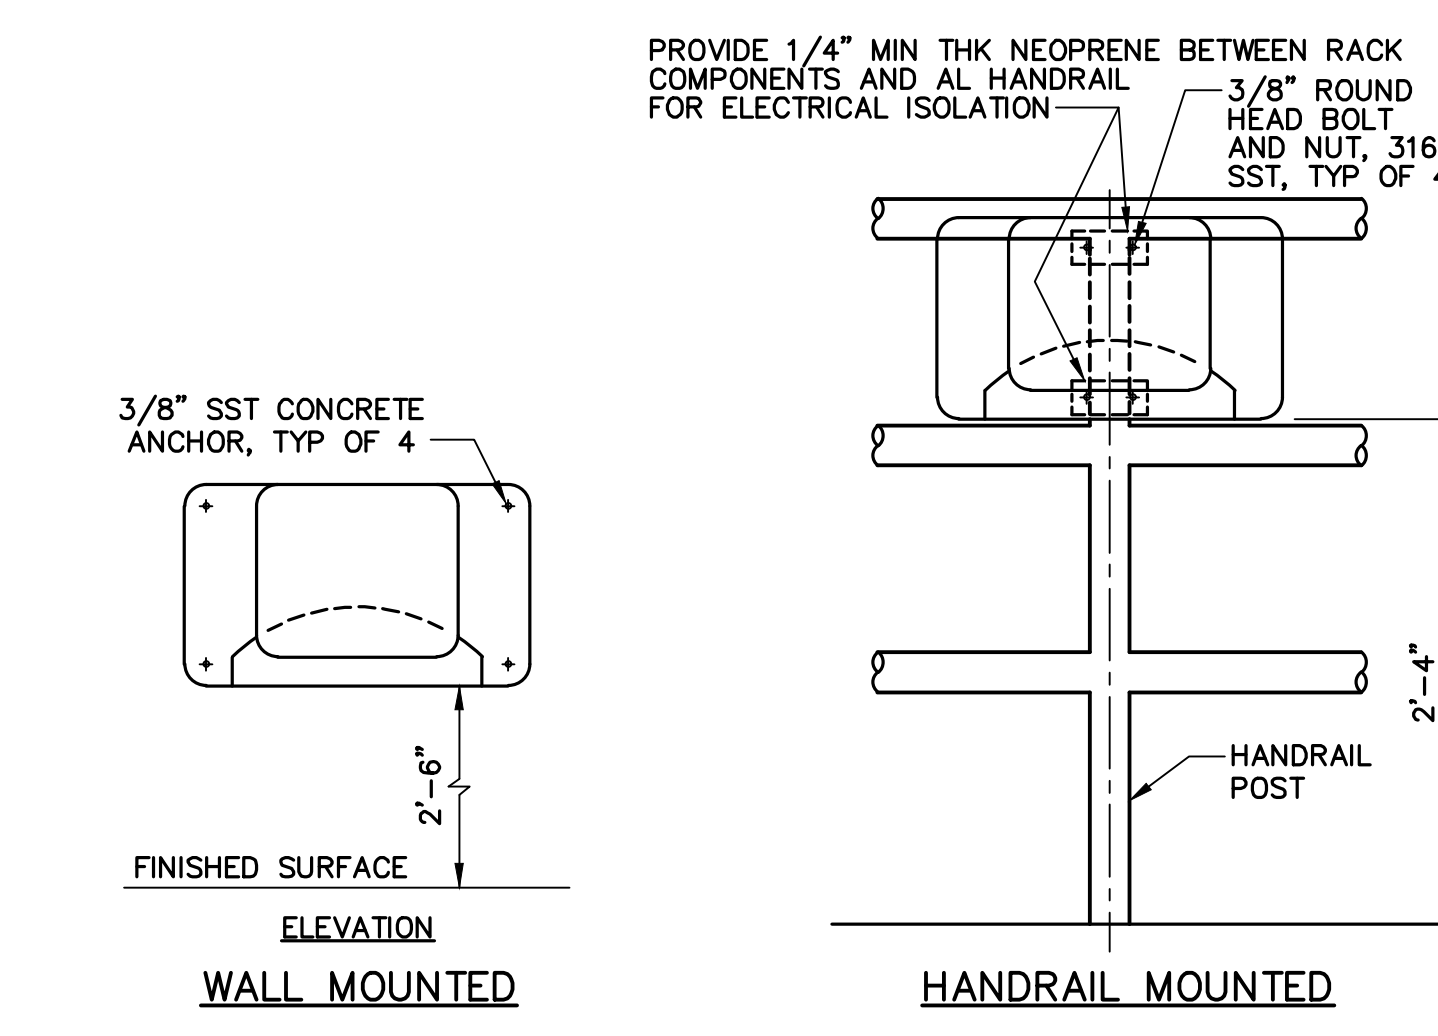


**HOSE RACK**

NTS

**M270**

**NOTES:**

- CONSTRUCT HOSE RACK FROM 1/8" MIN A-36 STEEL PLATE. HOT DIP GALVANIZE HOSE RACK AFTER FABRICATION.
- ATTACH A WARNING SIGN TO EACH HOSE RACK OR ADJACENT HOSE VALVE. SIGN SHALL READ: CAUTION NONPOTABLE WATER DO NOT DRINK
- PROVIDE MINIMUM 75 FT OF HOSE AT EACH HOSE RACK. SIZE SHALL MATCH HOSE VALVE.
- CONSTRUCT BASEPLATE FOR STRUCTURE MOUNTED POST FROM 1/2" MIN A-36 STEEL PLATE. HOT DIP GALVANIZE BASE AND POST AFTER FABRICATION.

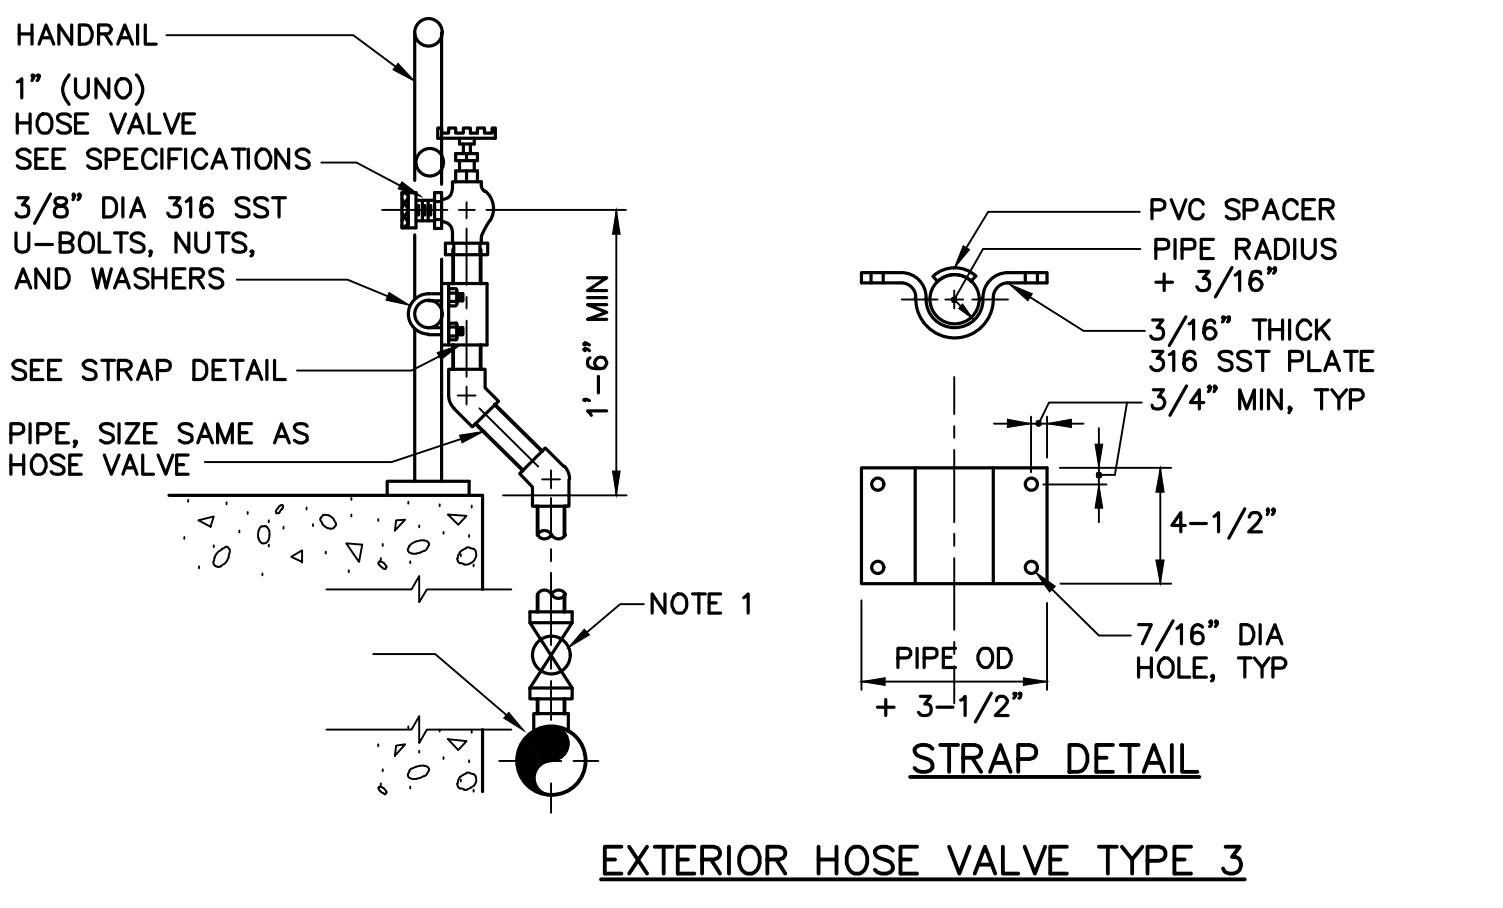

**RECORD DRAWING**  
 THIS RECORD DRAWING HAS BEEN PREPARED FROM THE ORIGINAL CONTRACT DOCUMENTS SIGNED AND SEALED BY THE RESPONSIBLE ENGINEER OF RECORD. ADDITIONAL INFORMATION HAS BEEN PROVIDED BY OTHERS TO REPRESENT AS-CONSTRUCTED CONDITION AND IS SHOWN ON THESE RECORD DRAWINGS. THE RESPONSIBLE ENGINEER OF RECORD CANNOT VERIFY THE ACCURACY OF THE AS-CONSTRUCTED CONDITION INFORMATION REPRESENTED ON THE RECORD DRAWINGS.


0" = 1" VERIFY SCALES - BAR IS ONE INCH LONG ON FULL SIZE DRAWING. IF NOT ONE INCH LONG ON THIS DRAWING, ADJUST SCALES ACCORDINGLY

DESIGNED	M. TAKEMOTO
DRAWN	S. JUNG
CHECKED	M. NAKAMOTO
APPROVED:	STEVE CLARY RMC ENGINEER CE-30318
DATE	07/22
BY	CT
APVD	TV
DESCRIPTION	RECORD DRAWING


DESIGNED: M. TAKEMOTO  
 DRAWN: S. JUNG  
 CHECKED: M. NAKAMOTO  
 APPROVED: STEVE CLARY  
 RMC PROJECT ENGINEER CE-64369  
 RMC ENGINEER CE-30318

TREATMENT AND WET WEATHER FLOW UPGRADE  
 MECHANICAL STANDARD DETAILS - 8  
 DWG NO: M-8  
 SHEET NO: 120 OF 226  
 PROJ NO: 055-006  
 DATE: JULY 2022


FILENAME: 0055-006-M-2 8-01-22 11:29am cto XREFS: X-SMCSO-TBLK ICS-

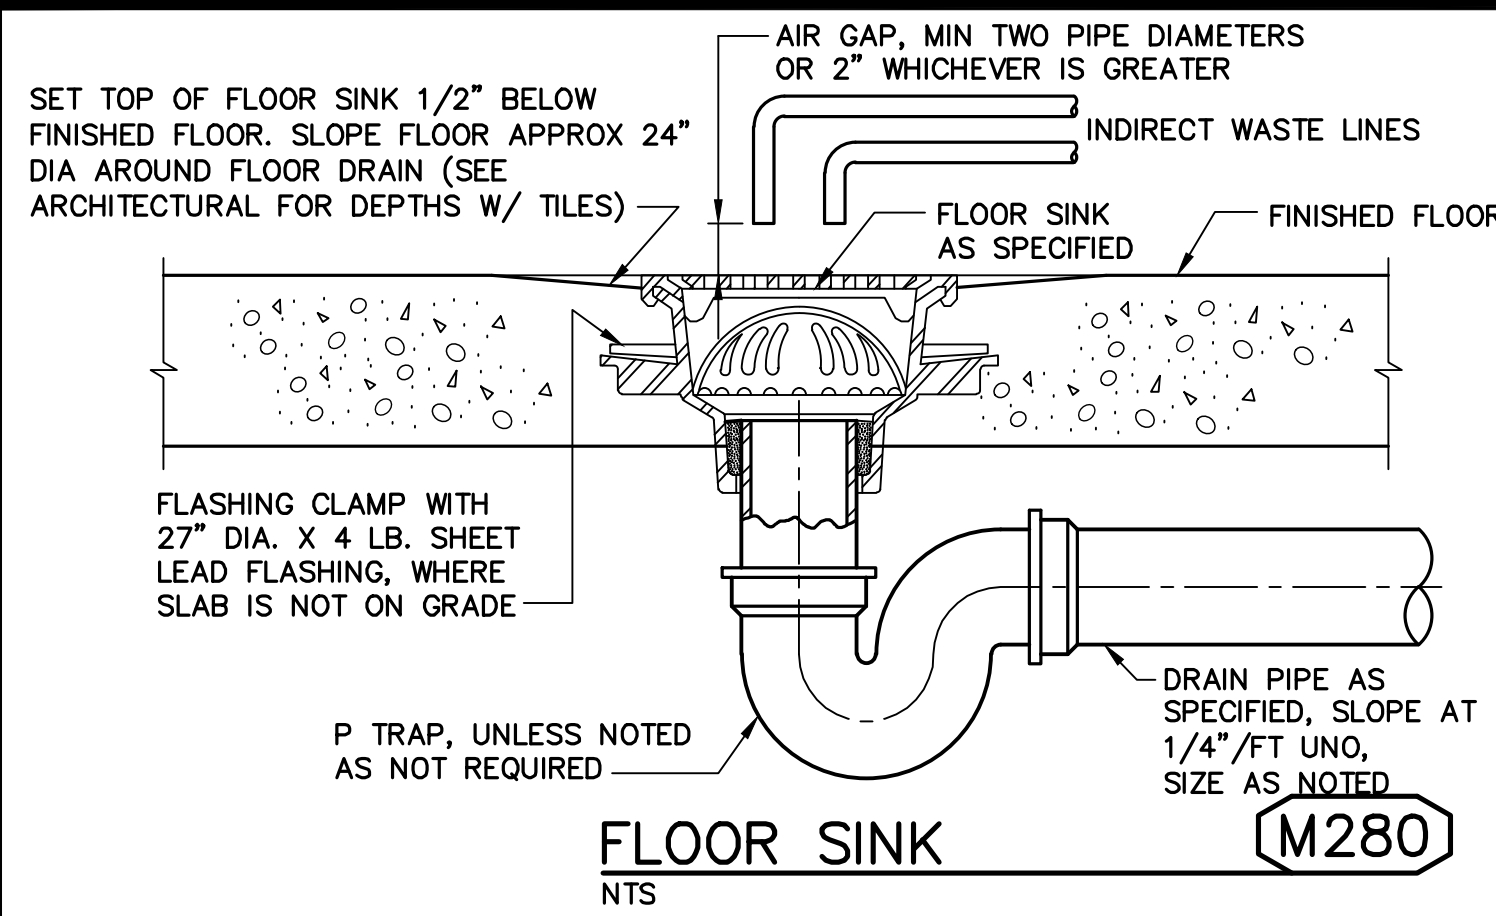


**FLOOR SINK** (M280)  
NTS

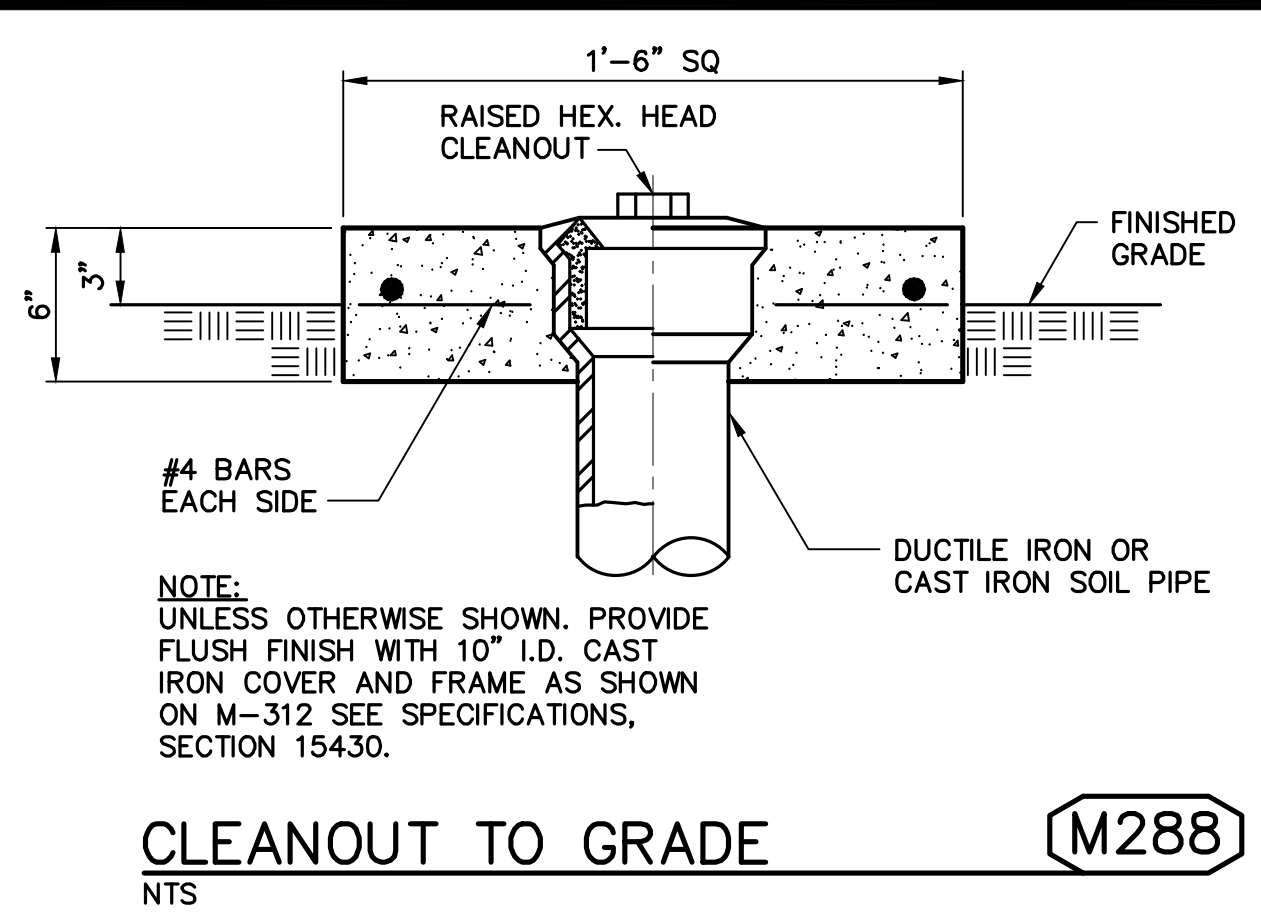


**CLEANOUT TO GRADE** (M288)  
NTS

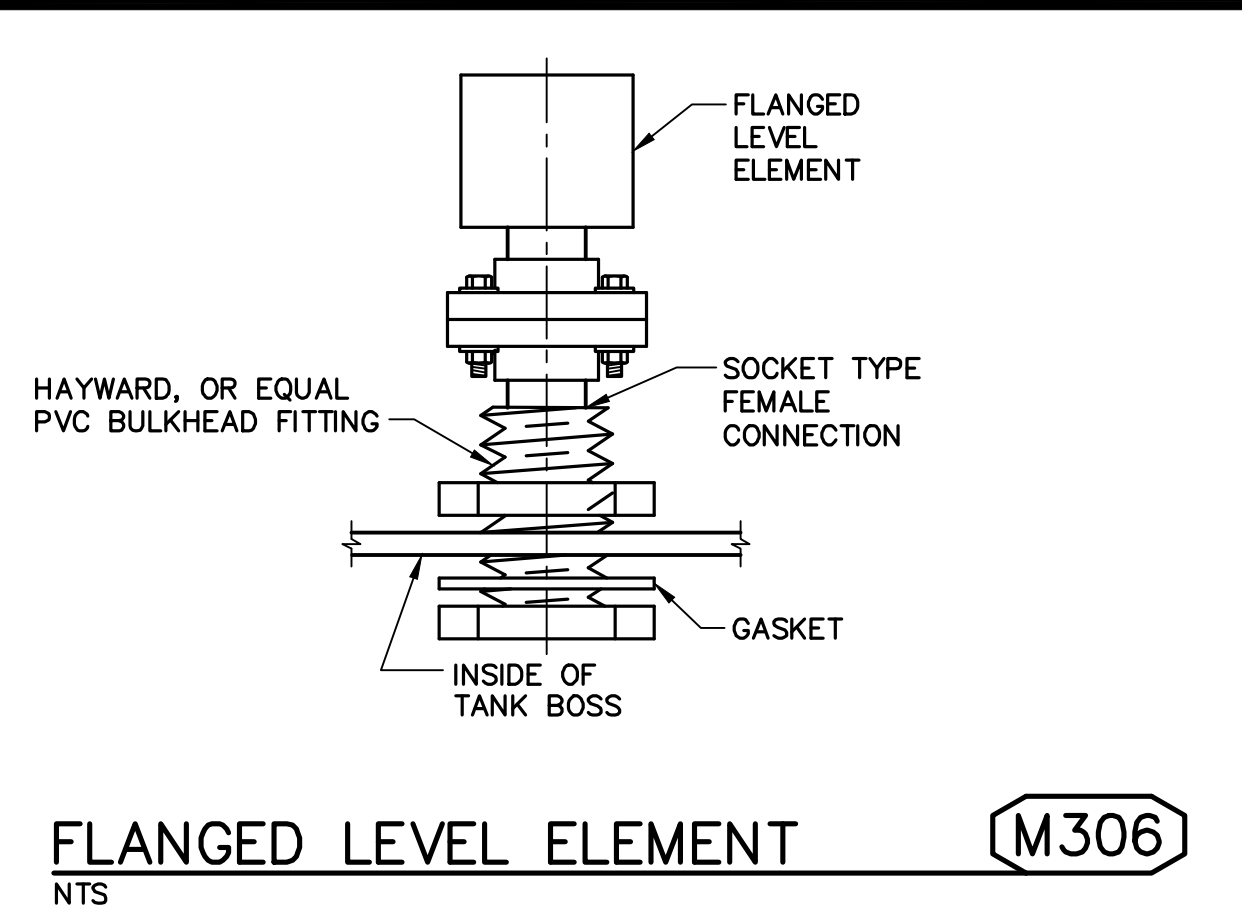


**FLANGED LEVEL ELEMENT** (M306)  
NTS

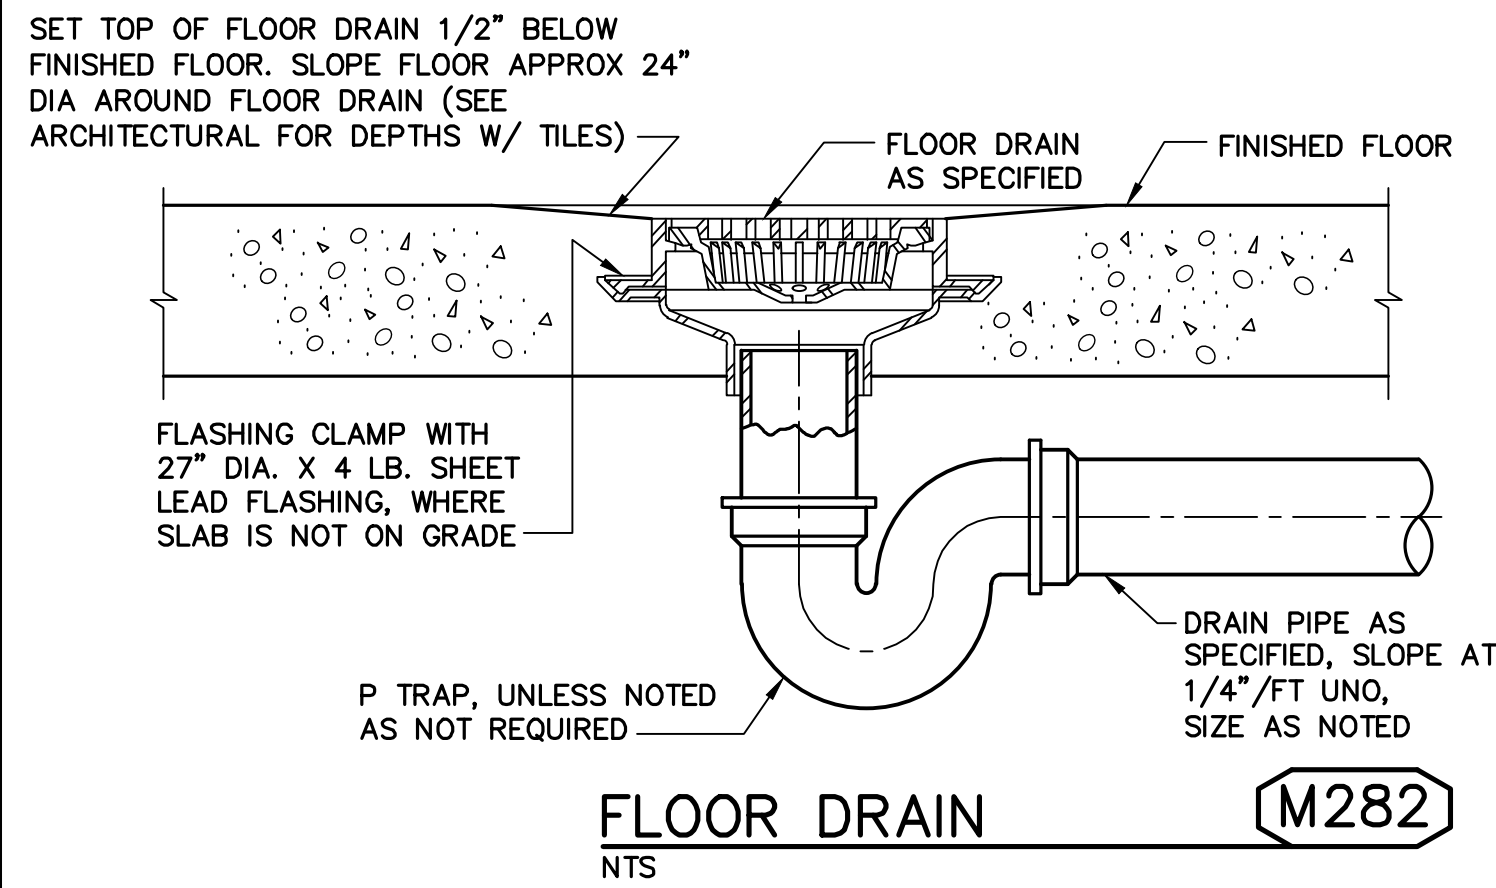


**FLOOR DRAIN** (M282)  
NTS

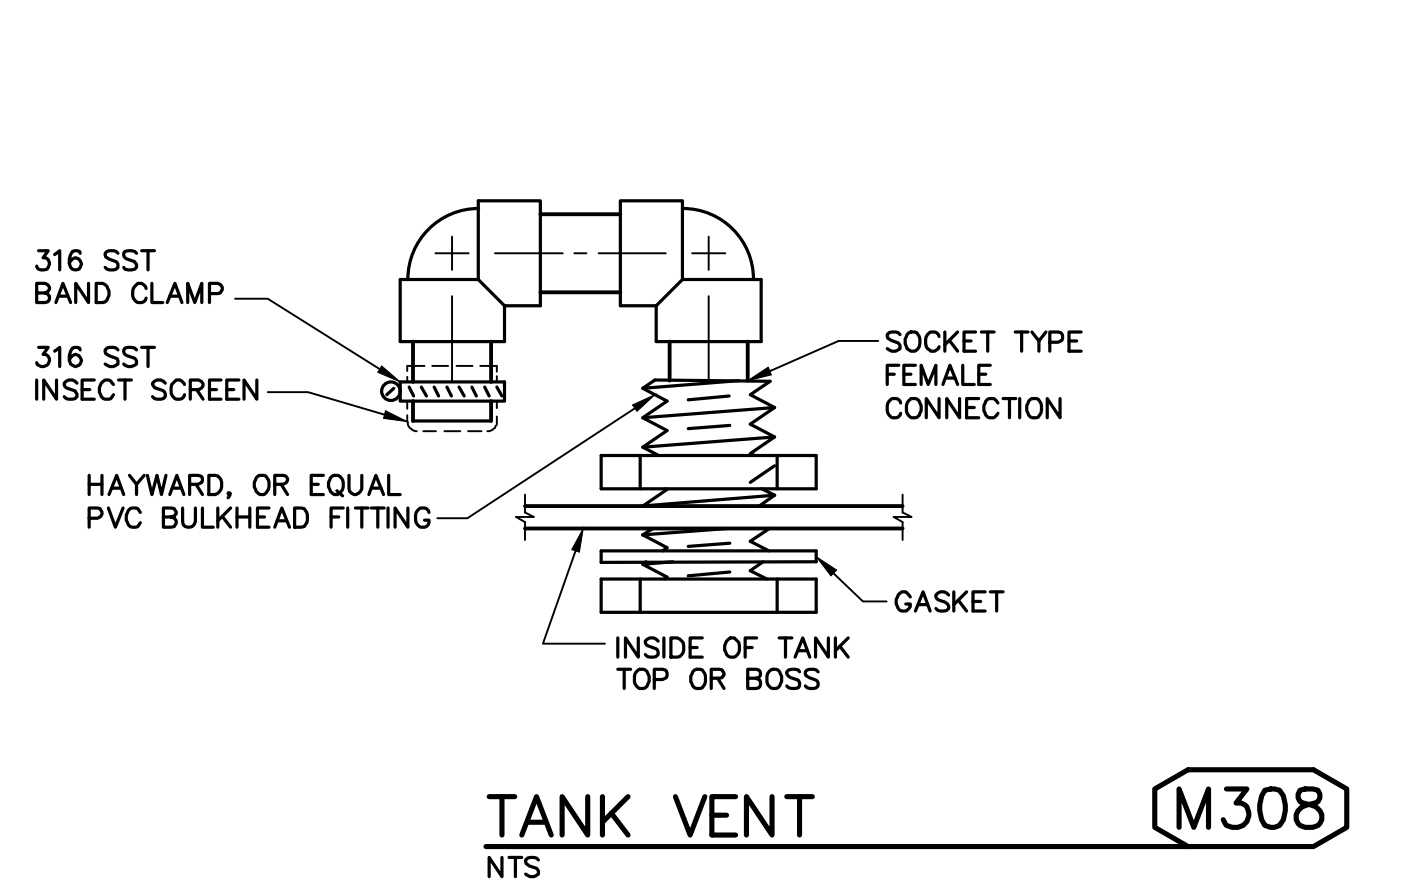


**TANK VENT** (M308)  
NTS

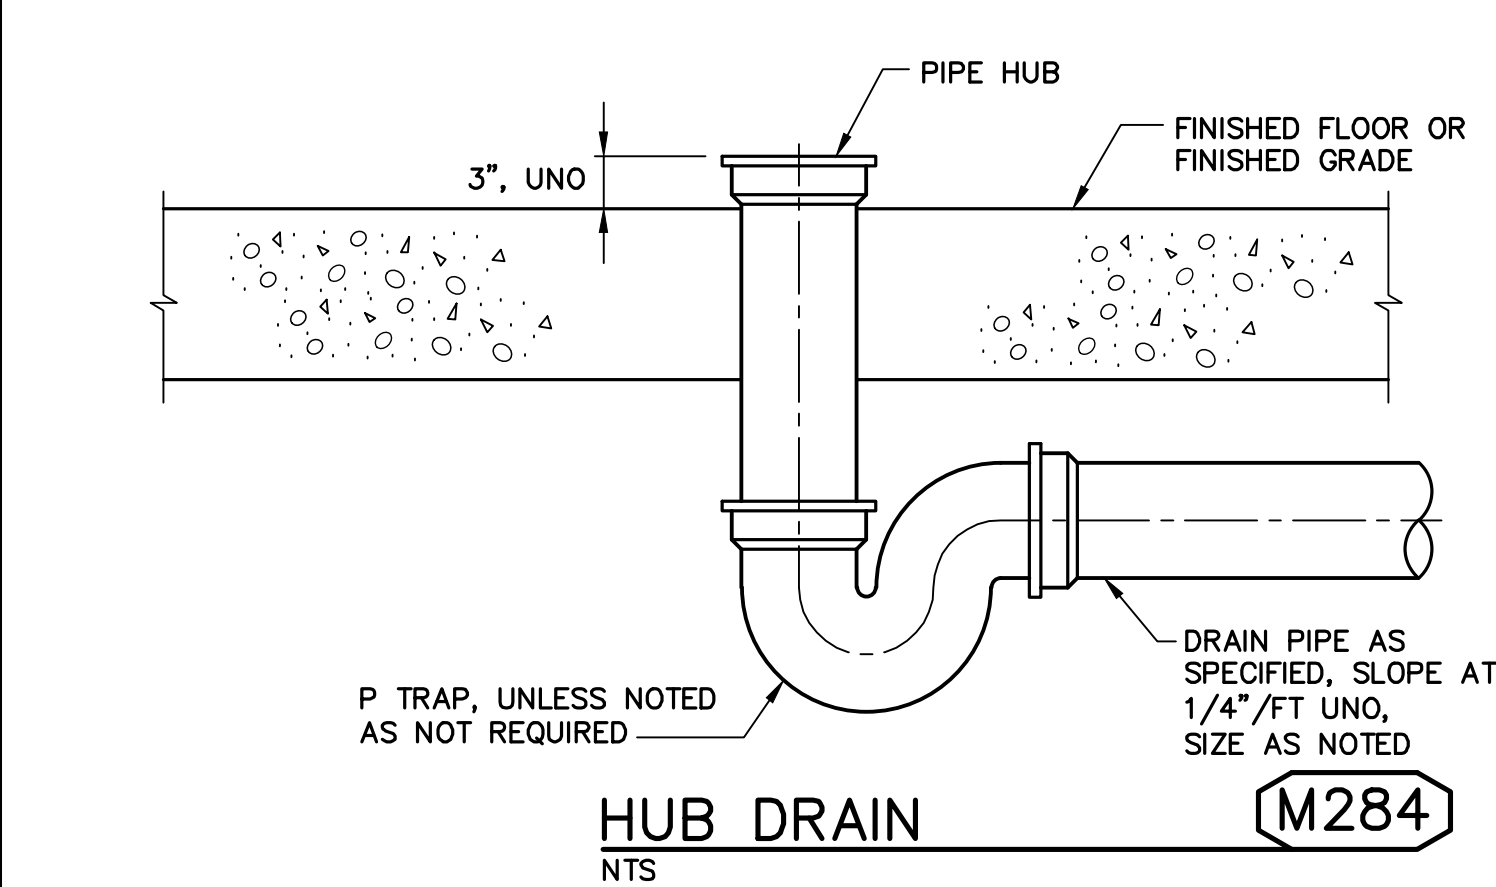


**HUB DRAIN** (M284)  
NTS

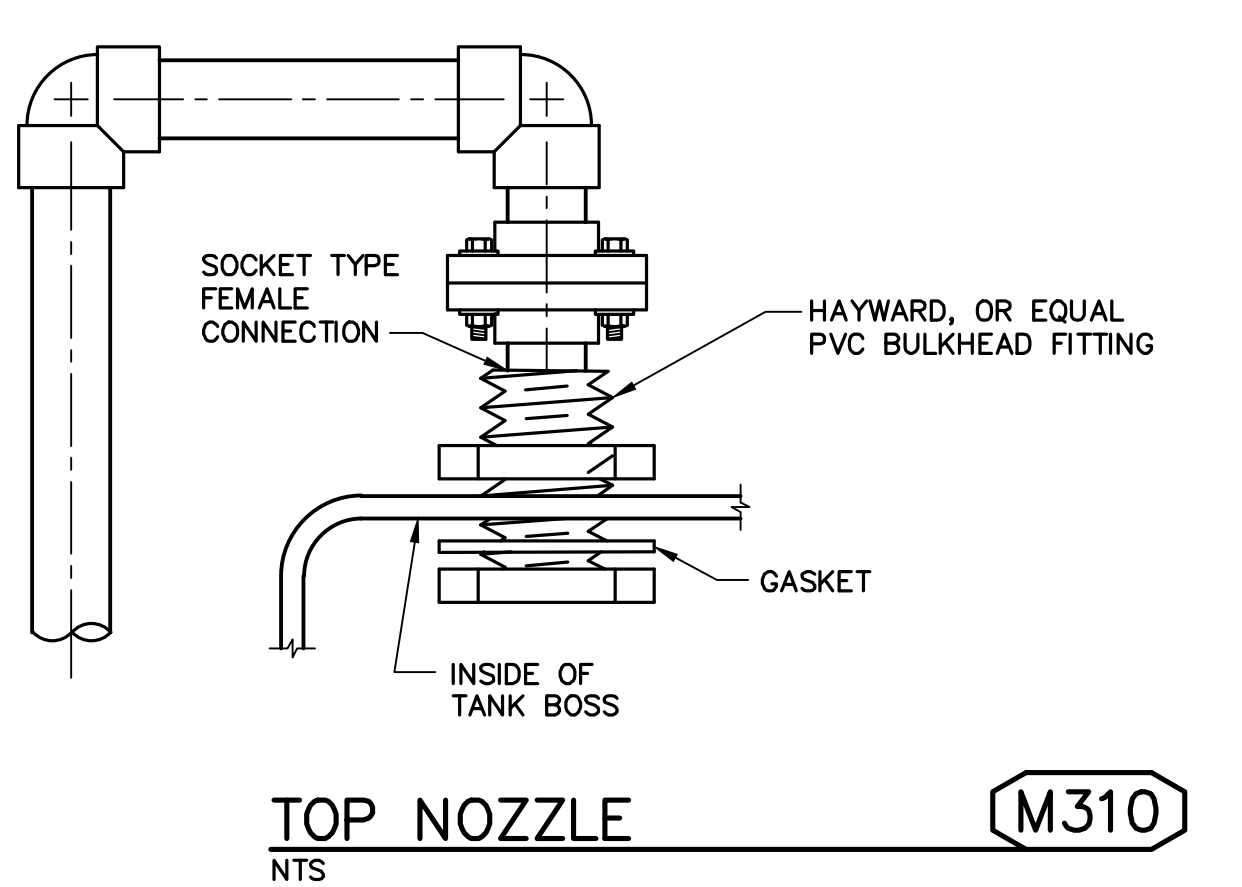


**TOP NOZZLE** (M310)  
NTS

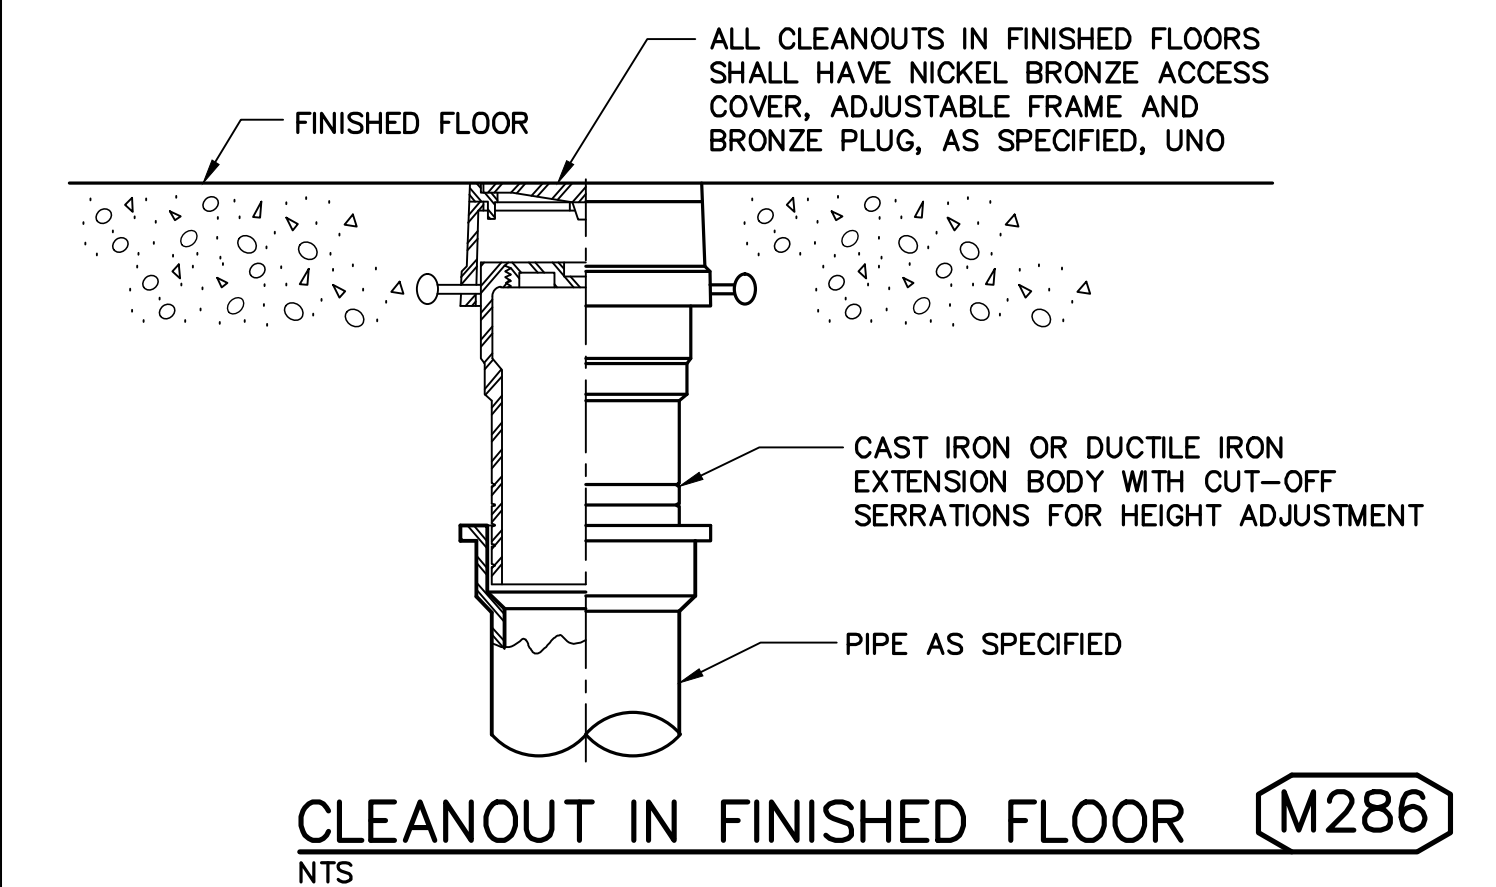

**CLEANOUT IN FINISHED FLOOR** (M286)  
NTS

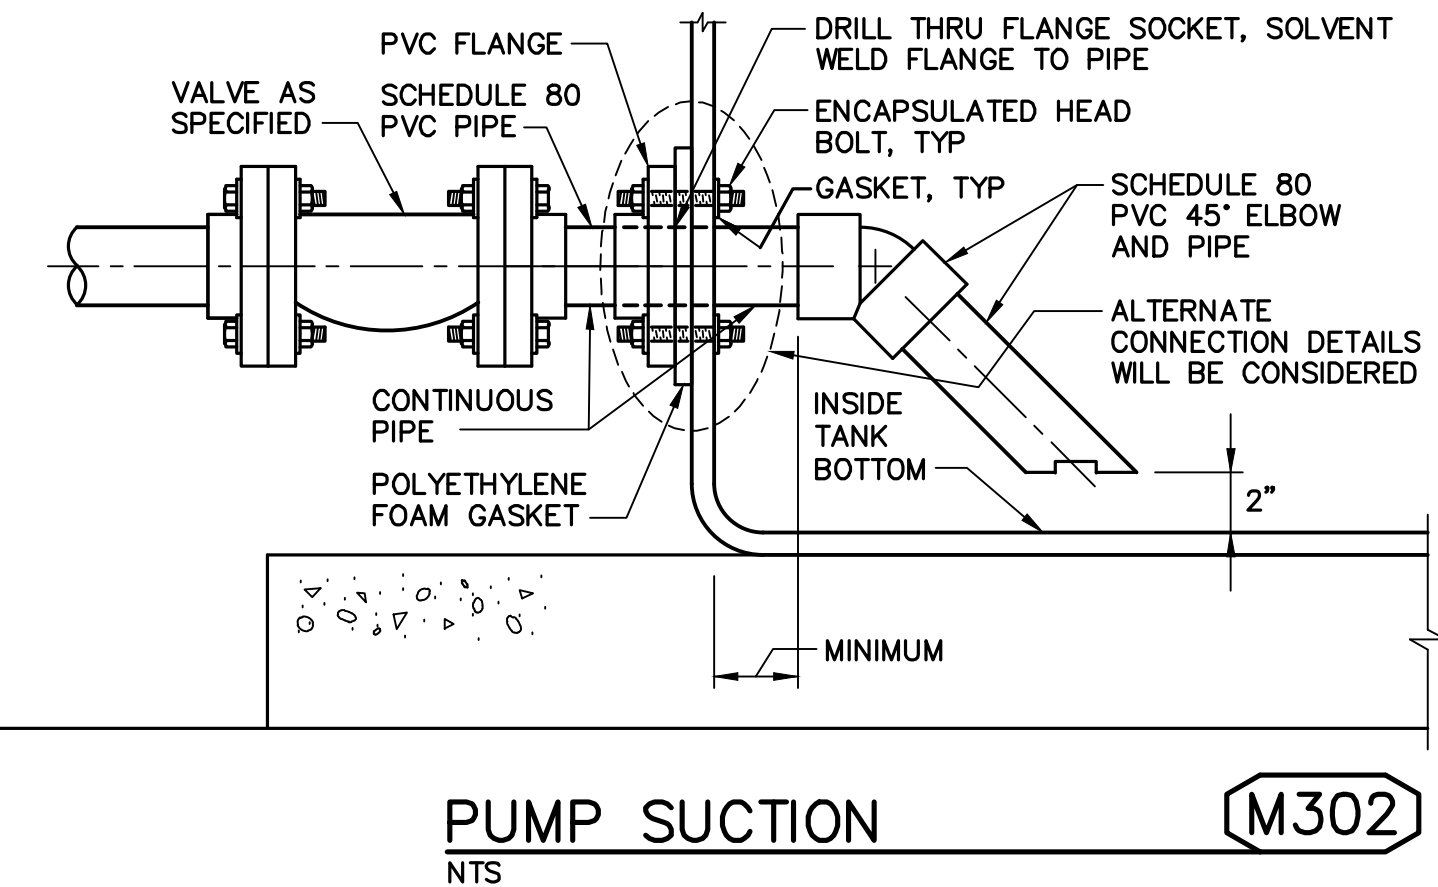

**PUMP SUCTION** (M302)  
NTS

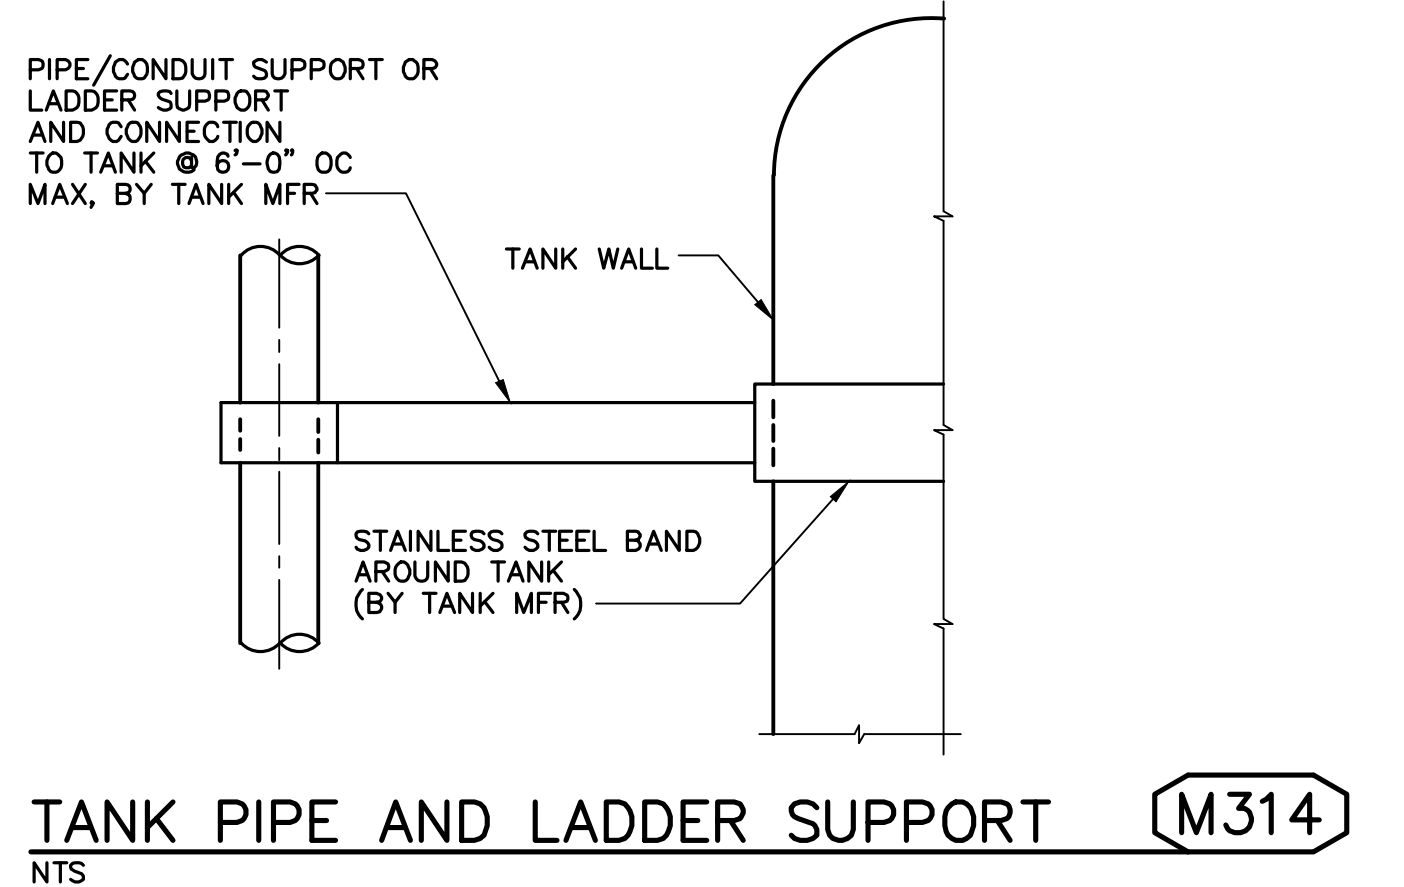

**TANK PIPE AND LADDER SUPPORT** (M314)  
NTS

FILENAME: 0055-006-M-2\_8-01-22\_11:29am.ctb XREFS: X-SMCS0-TBLK ICS-

**RECORD DRAWING**  
THIS RECORD DRAWING HAS BEEN PREPARED FROM THE ORIGINAL CONTRACT DOCUMENTS SIGNED AND SEALED BY THE RESPONSIBLE ENGINEER OF RECORD. ADDITIONAL INFORMATION HAS BEEN PROVIDED BY OTHERS TO REPRESENT AS-CONSTRUCTED CONDITION AND IS SHOWN ON THESE RECORD DRAWINGS. THE RESPONSIBLE ENGINEER OF RECORD CANNOT VERIFY THE ACCURACY OF THE AS-CONSTRUCTED CONDITION INFORMATION REPRESENTED ON THE RECORD DRAWINGS.



0" = 1"  
VERIFY SCALES — BAR IS ONE INCH LONG ON FULL SIZE DRAWING. IF NOT ONE INCH LONG ON THIS DRAWING, ADJUST SCALES ACCORDINGLY

	REV	DATE	BY	APVD	DESCRIPTION
	07/22	CT	TV		RECORD DRAWING

DESIGNED	M. TAKEMOTO	SUBMITTED	MARK TAKEMOTO
DRAWN	S. JUNG		RMC PROJECT ENGINEER CE-64369
CHECKED	M. NAKAMOTO	APPROVED	STEVE CLARY
			RMC ENGINEER CE-30318



TREATMENT AND WET WEATHER FLOW UPGRADE		DWG NO	M-9
MECHANICAL STANDARD DETAILS - 9		SHEET NO	121 OF 226
		PROJ NO	055-006
		DATE	JULY 2022

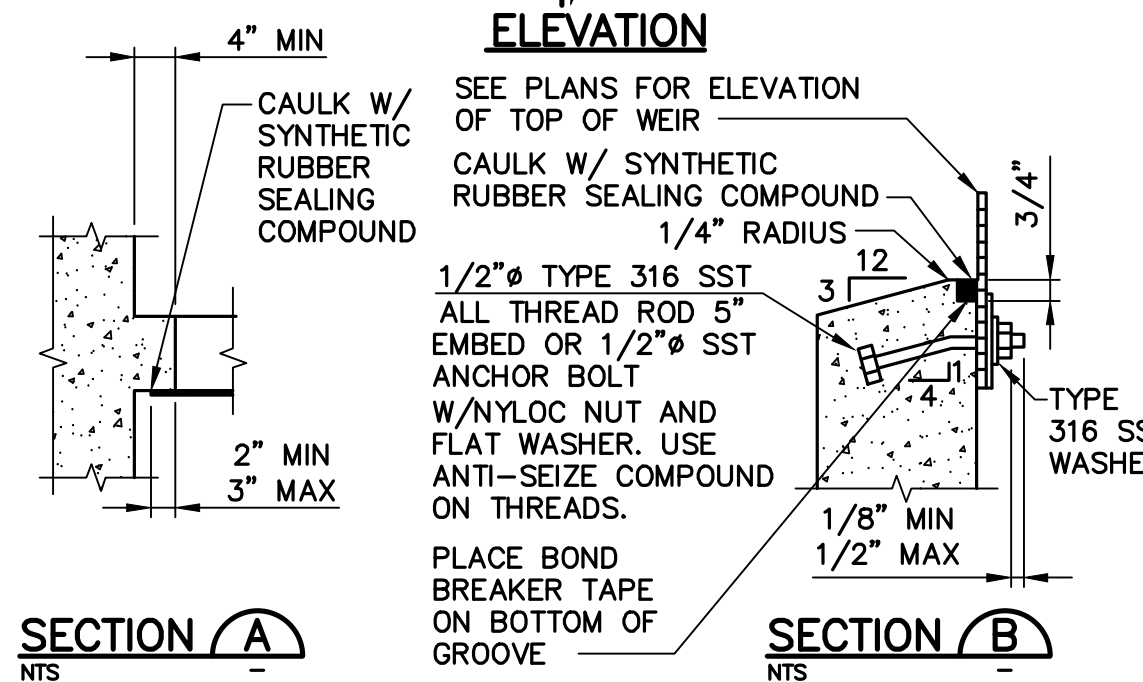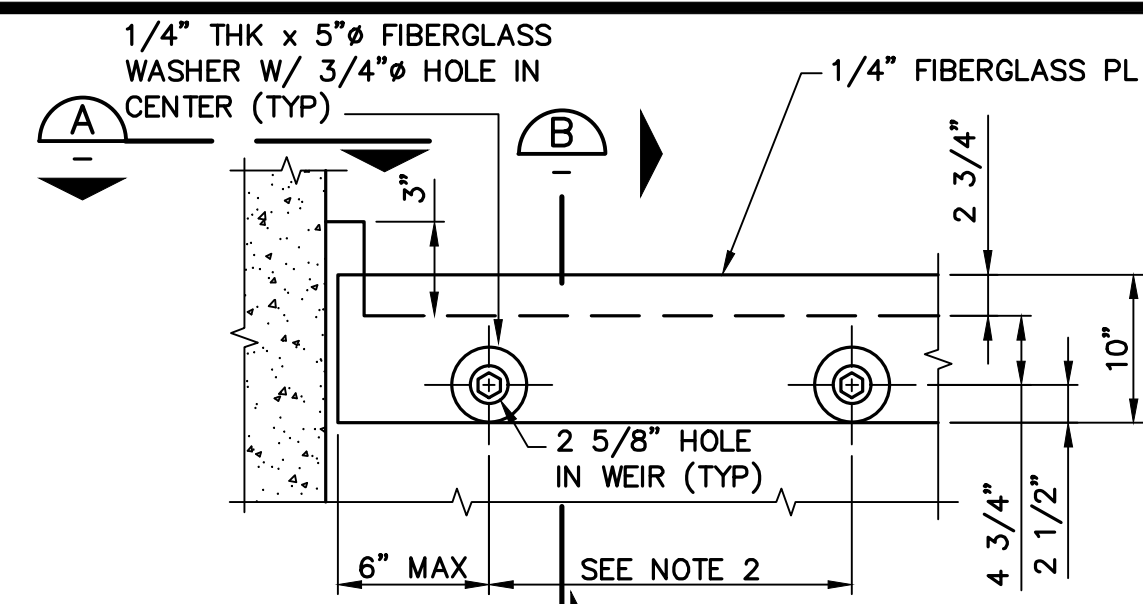

**ELEVATION**

SEE PLANS FOR ELEVATION OF TOP OF WEIR

CAULK W/ SYNTHETIC RUBBER SEALING COMPOUND

1/4" RADIUS

1/2" TYPE 316 SST ALL THREAD ROD 5" EMBED OR 1/2" SST ANCHOR BOLT W/NYLOC NUT AND FLAT WASHER. USE ANTI-SEIZE COMPOUND ON THREADS.

PLACE BOND BREAKER TAPE ON BOTTOM OF GROOVE

TYPE 316 SST WASHER


- NOTES:**
1. ALL EDGES, VOIDS, AND SPLICES SHALL BE SEALED WATER TIGHT W/SYNTHETIC RUBBER SEALING COMPOUND.
  2. ANCHOR BOLT SPACING = 12" OC FOR STRAIGHT WEIRS AND 2'-0" OC FOR CIRCULAR WEIRS.
  3. ADJUST WEIR LEVEL AT CALM WATER SURFACE TO WITHIN ± 1/32 INCH OF THE INDICATED ELEVATION. ENGINEER TO APPROVE PRIOR TO CAULKING.

**PLAIN WEIR** M320

FILENAME: 0055-006-M-2\_8-01-22\_11:29am.ctb XREFS: X-SMCSO-TBLK | <<--

**RECORD DRAWING**

THIS RECORD DRAWING HAS BEEN PREPARED FROM THE ORIGINAL CONTRACT DOCUMENTS SIGNED AND SEALED BY THE RESPONSIBLE ENGINEER OF RECORD. ADDITIONAL INFORMATION HAS BEEN PROVIDED BY OTHERS TO REPRESENT AS-CONSTRUCTED CONDITION AND IS SHOWN ON THESE RECORD DRAWINGS. THE RESPONSIBLE ENGINEER OF RECORD CANNOT VERIFY THE ACCURACY OF THE AS-CONSTRUCTED CONDITION INFORMATION REPRESENTED ON THE RECORD DRAWINGS.

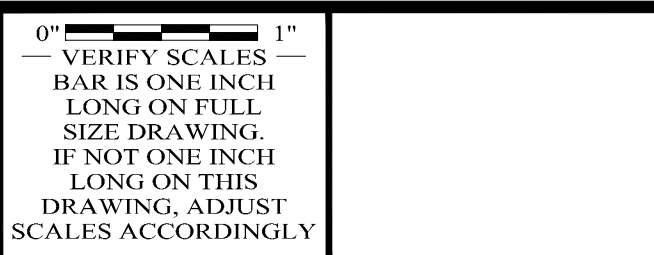

REV	DATE	BY	APVD	DESCRIPTION
▲				
▲				
▲				
▲	07/22	CT	TV	RECORD DRAWING


DESIGNED	M. TAKEMOTO	SUBMITTED: MARK TAKEMOTO RMC PROJECT ENGINEER CE-64369
DRAWN	S. JUNG	
CHECKED	M. NAKAMOTO	APPROVED: STEVE CLARY RMC ENGINEER CE-30318



TREATMENT AND WET WEATHER FLOW UPGRADE

**MECHANICAL STANDARD DETAILS - 10**

DWG NO	M-10
SHEET NO	122 OF 226
PROJ NO	055-006
DATE	JULY 2022

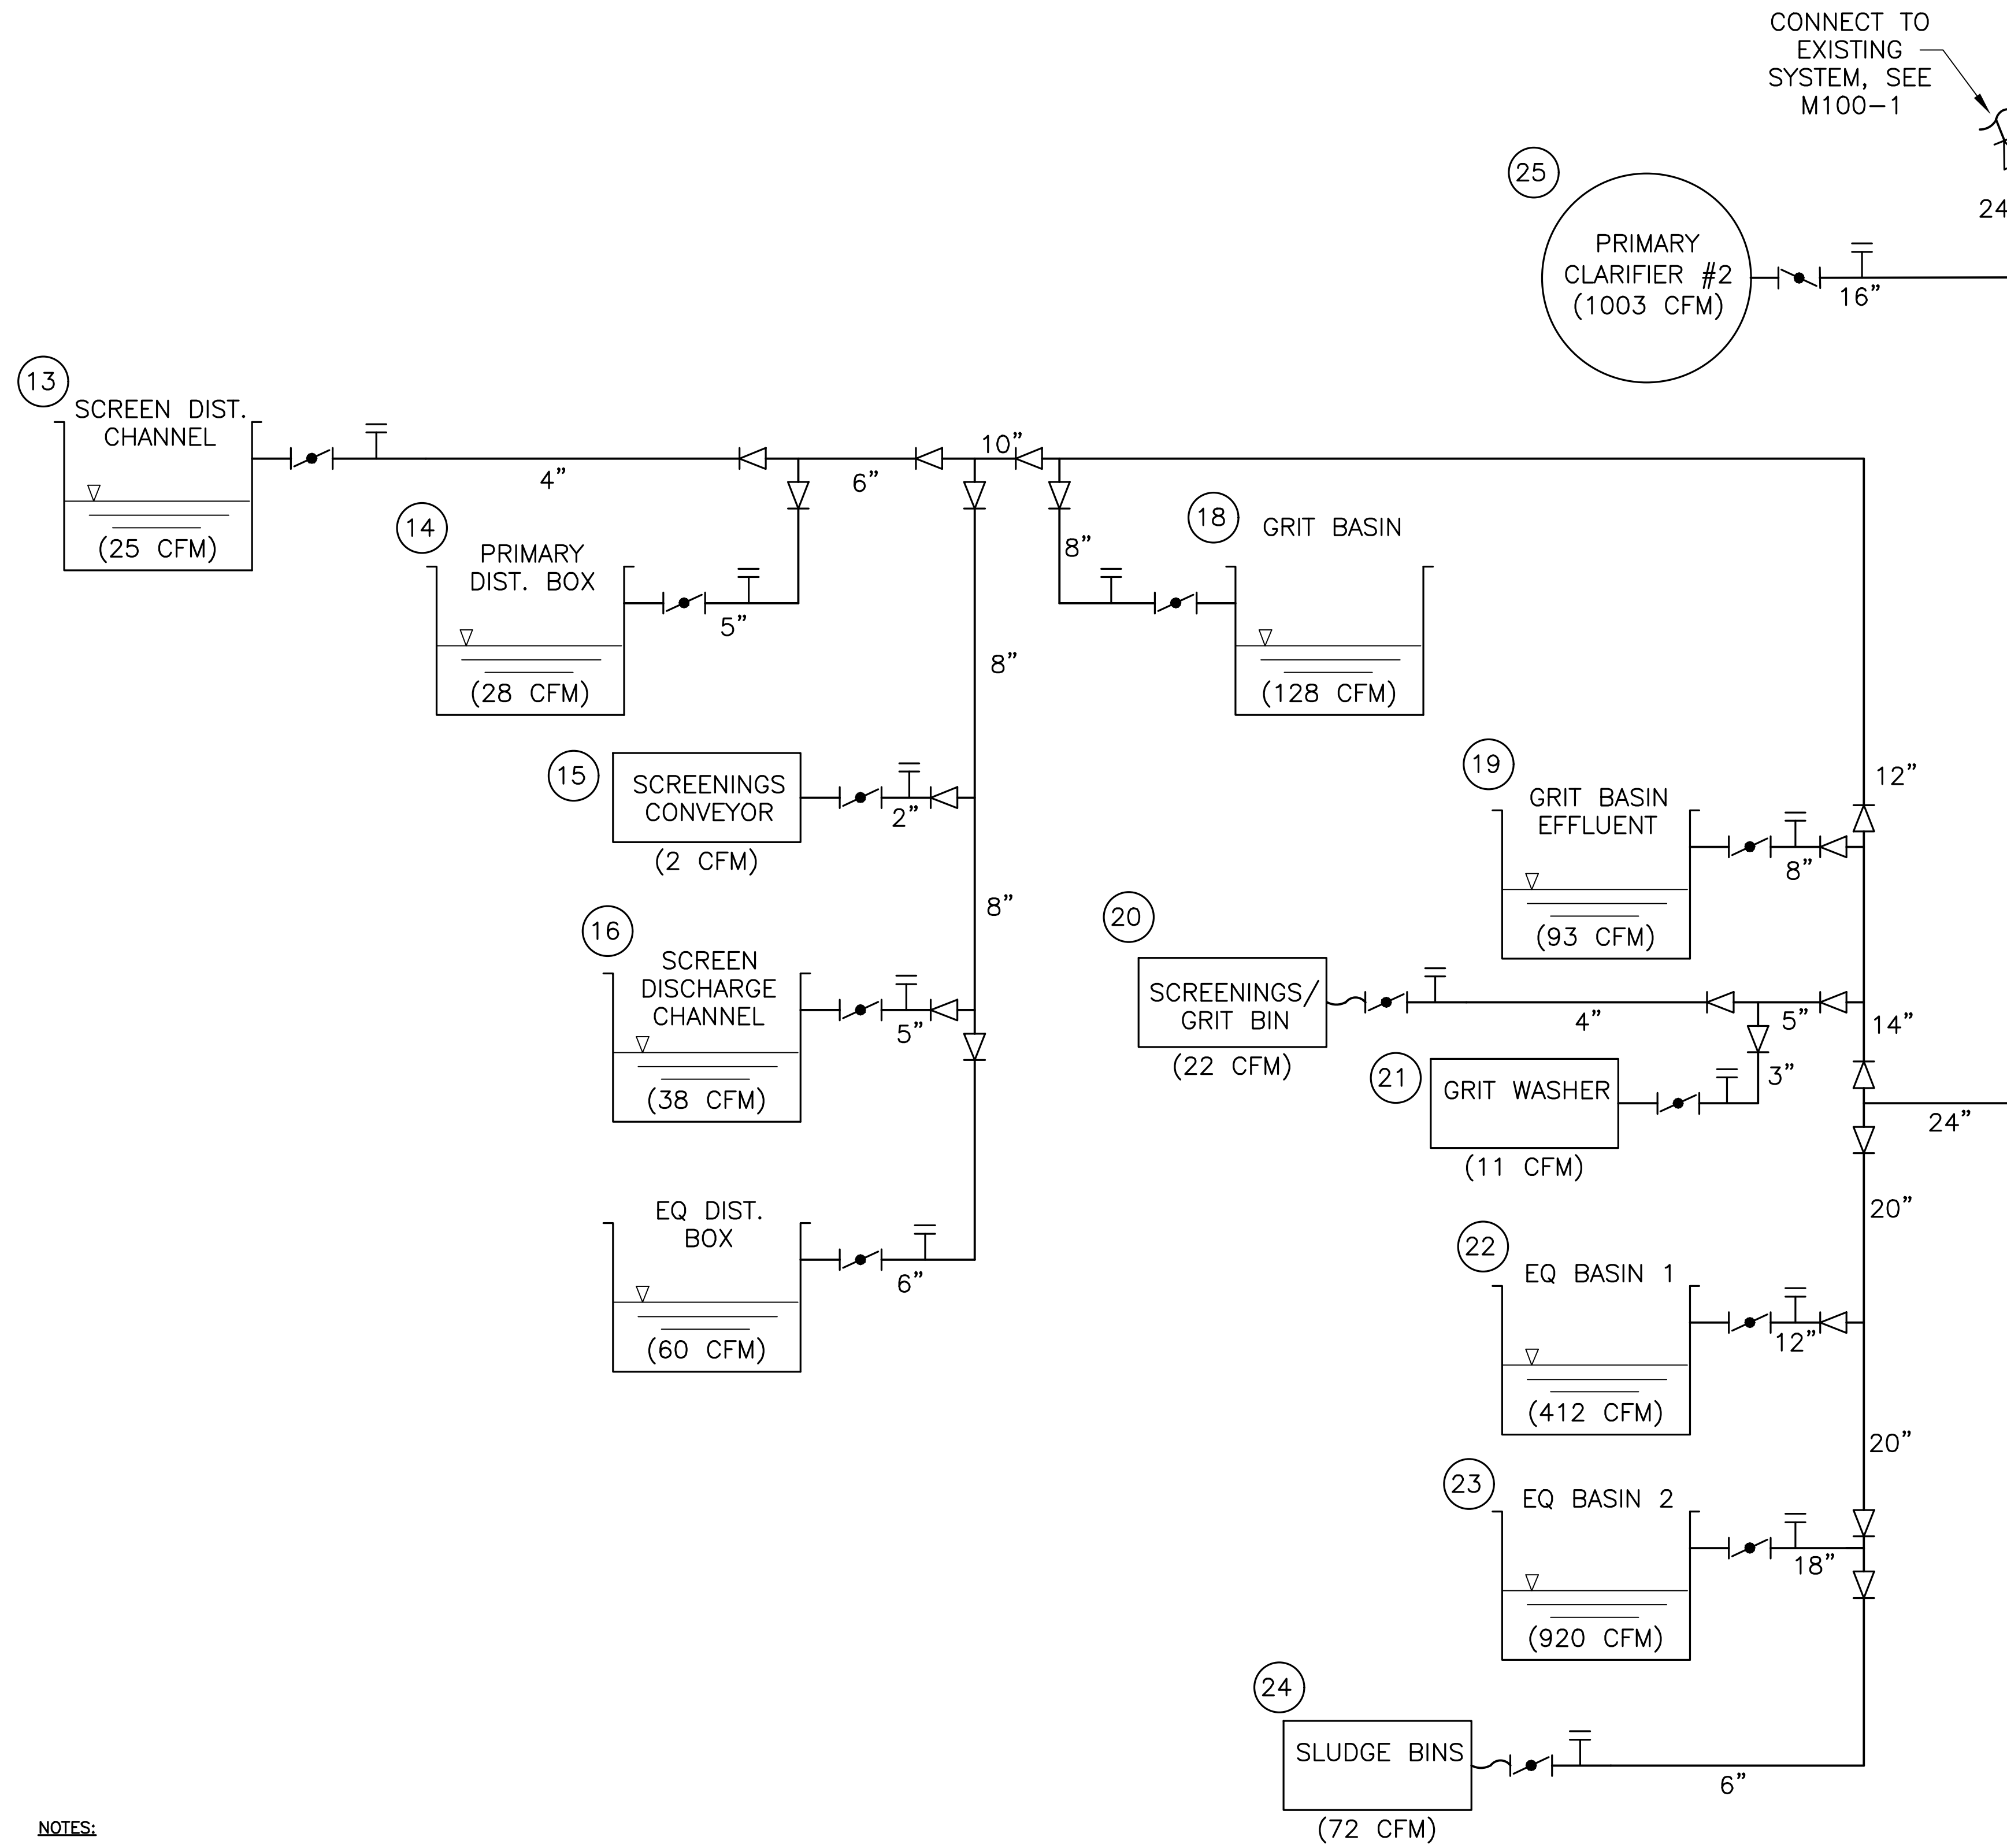

**LEGEND:**

- DAMPER
- INSERTION AIRFLOW PROBE
- REDUCER
- ZONE NUMBER
- FLEXIBLE CONNECTION

ODOR CONTROL SYSTEM AIR FLOW SCHEDULE

Existing Zones					
Zone #	Duct Size (IN.)	Location	Volume (CU FT)	Minimum CFM	Minimum AC/HR
6	6	Primary Effluent Chamber (sample sump)	592	118	1.2%
1	8	Laundry Trough	283	57	0.6%
3	8	Laundry Trough	283	57	0.6%
4	8	Laundry Trough	283	57	0.6%
7	8	Laundry Trough	283	57	0.6%
		Subtotal Primary Clarifier	1,722	344	3.4%
5	8	Removed From Service	-	-	0.0%
2	18	Removed From Service	-	-	0.0%
9	12	Sludge Thickener	471	31	0.3%
8	12	Screw Press	251	50	0.5%
10	2	Screw Press	48	10	0.1%
		Subtotal Screw Press	299	60	0.6%
11	28	FFR #2	40,500	3,465	33.9%
12	28	FFR #1	40,500	3,505	34.3%
		<b>Existing Subtotal</b>	<b>83,491</b>	<b>7,406</b>	<b>72.5%</b>
New Zones					
13	4	Screen Dist Channel	124	25	0.3%
14	5	Primary Dist. Box	140	28	0.4%
15	2	Screenings Conveyor	12	2	0.0%
16	5	Screen Discharge Channel	192	38	0.5%
17	6	EQ Dist Box	299	60	0.8%
18	8	Grit Basin	638	128	1.7%
19	8	Grit Basin Effluent	466	93	1.3%
20	4	Screenings/Grit Bin	108	22	0.3%
21	3	Grit Washer	57	11	0.2%
22	12	EQ Basin 1	4,125	412	5.6%
23	18	EQ Basin 2	9,201	920	12.4%
24	6	Sludge Bin	360	72	1.0%
25	18	Primary Clarifier No. 2	5,014	1,003	13.5%
		<b>New Subtotal</b>	<b>20,611</b>	<b>2,814</b>	<b>38.0%</b>
<b>All Zones</b>		<b>Total</b>	<b>104,102</b>	<b>10,220</b>	<b>100%</b>

- NOTES:**
- DRAWING NOT TO SCALE.
  - ODOR CONTROL FOUL AIR LINES SHALL BE INSTALLED IN ACCORDANCE WITH SECTION 02510 - FRP DUCTWORK.
  - EXISTING AND NEW ODOR CONTROL ZONES SHALL BE BALANCED PER THE ODOR CONTROL AIR FLOW SCHEDULE AND IN ACCORDANCE WITH SECTION 15954 - HVAC SYSTEMS TESTING, ADJUSTING, AND BALANCING.

FILENAME: 0055-006-M-20 8-01-22 11:28am cto || XREFS: X-SAKUSD-TBLK Kc--

**RECORD DRAWING**  
 THIS RECORD DRAWING HAS BEEN PREPARED FROM THE ORIGINAL CONTRACT DOCUMENTS SIGNED AND SEALED BY THE RESPONSIBLE ENGINEER OF RECORD. ADDITIONAL INFORMATION HAS BEEN PROVIDED BY OTHERS TO REPRESENT AS-CONSTRUCTED CONDITION AND IS SHOWN ON THESE RECORD DRAWINGS. THE RESPONSIBLE ENGINEER OF RECORD CANNOT VERIFY THE ACCURACY OF THE AS-CONSTRUCTED CONDITION INFORMATION REPRESENTED ON THE RECORD DRAWINGS.

0" = 1"   
 VERIFY SCALES - BAR IS ONE INCH LONG ON FULL SIZE DRAWING. IF NOT ONE INCH LONG ON THIS DRAWING, ADJUST SCALES ACCORDINGLY



REV	DATE	BY	APVD	DESCRIPTION
▲	07/22	CT	TV	RECORD DRAWING



DESIGNED M. TAKEMOTO  
 DRAWN M. TAKEMOTO  
 CHECKED M. NAKAMOTO

SUBMITTED: MARK TAKEMOTO  
 RMC PROJECT ENGINEER CE-64369  
 APPROVED: STEVE CLARY  
 RMC ENGINEER CE-30318



TREATMENT AND WET WEATHER FLOW UPGRADE  
**ODOR CONTROL SCHEMATIC**

DWG NO **M20**  
 SHEET NO 123 OF 226  
 PROJ NO 055-006  
 DATE JULY 2022

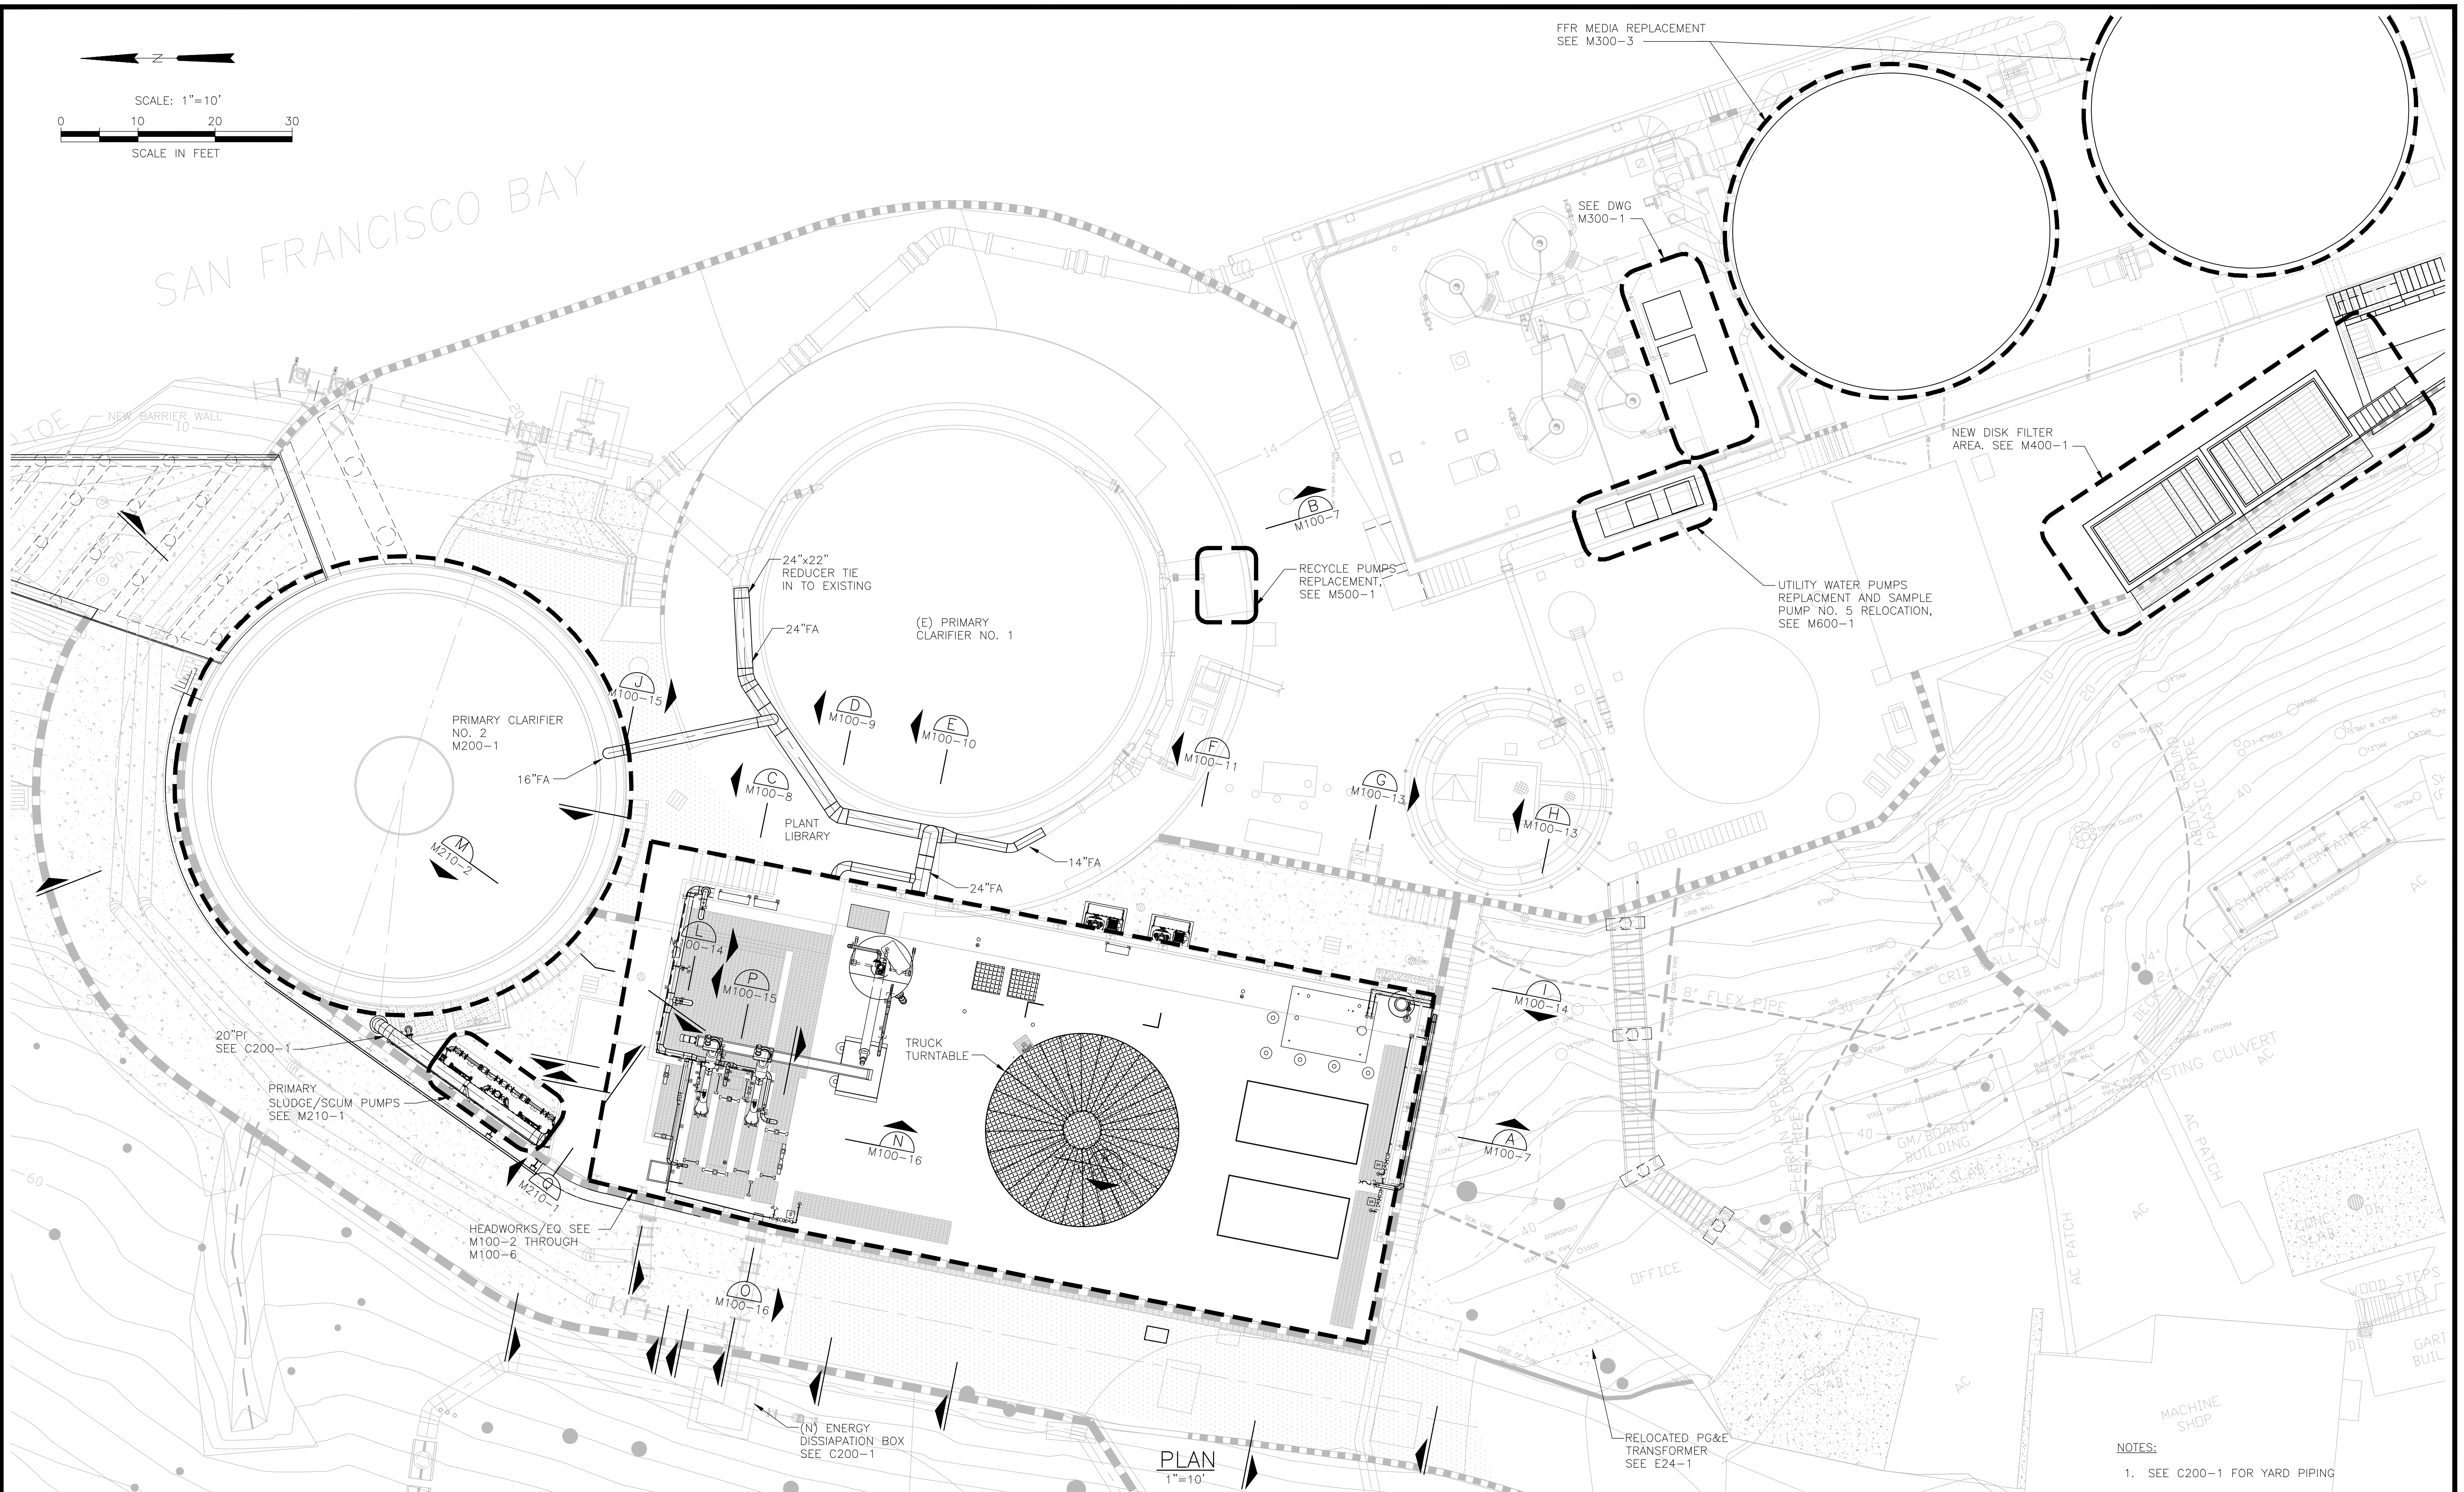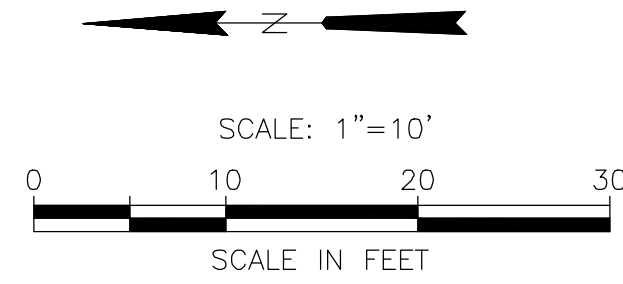

PLAN  
1"=10'

NOTES:  
1. SEE C200-1 FOR YARD PIPING

**RECORD DRAWING**  
THIS RECORD DRAWING HAS BEEN PREPARED FROM THE ORIGINAL CONTRACT DOCUMENTS SIGNED AND SEALED BY THE RESPONSIBLE ENGINEER OF RECORD. ADDITIONAL INFORMATION HAS BEEN PROVIDED BY OTHERS TO REPRESENT AS-CONSTRUCTED CONDITION AND IS SHOWN ON THESE RECORD DRAWINGS. THE RESPONSIBLE ENGINEER OF RECORD CANNOT VERIFY THE ACCURACY OF THE AS-CONSTRUCTED CONDITION INFORMATION REPRESENTED ON THE RECORD DRAWINGS.


0" = 1" = 1"  
VERIFY SCALES —  
BAR IS ONE INCH  
LONG ON FULL  
SIZE DRAWING.  
IF NOT ONE INCH  
LONG ON THIS  
DRAWING, ADJUST  
SCALES ACCORDINGLY



REV	DATE	BY	APVD	DESCRIPTION
▲				
▲				
▲				
▲	07/22	CT	TV	RECORD DRAWING


DESIGNED M. TAKEMOTO  
DRAWN S. NGUYEN  
CHECKED M. NAKAMOTO

SUBMITTED: MARK TAKEMOTO  
RMC PROJECT ENGINEER CE-64369  
APPROVED: STEVE CLARY  
RMC ENGINEER CE-30318

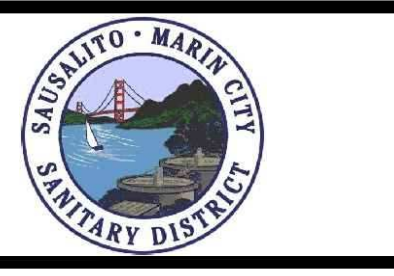

TREATMENT AND WET WEATHER FLOW UPGRADE  
**OVERALL SITE PLAN**

DWG NO M100-1  
SHEET NO 124 OF 226  
PROJ NO 055-006  
DATE JULY 2022

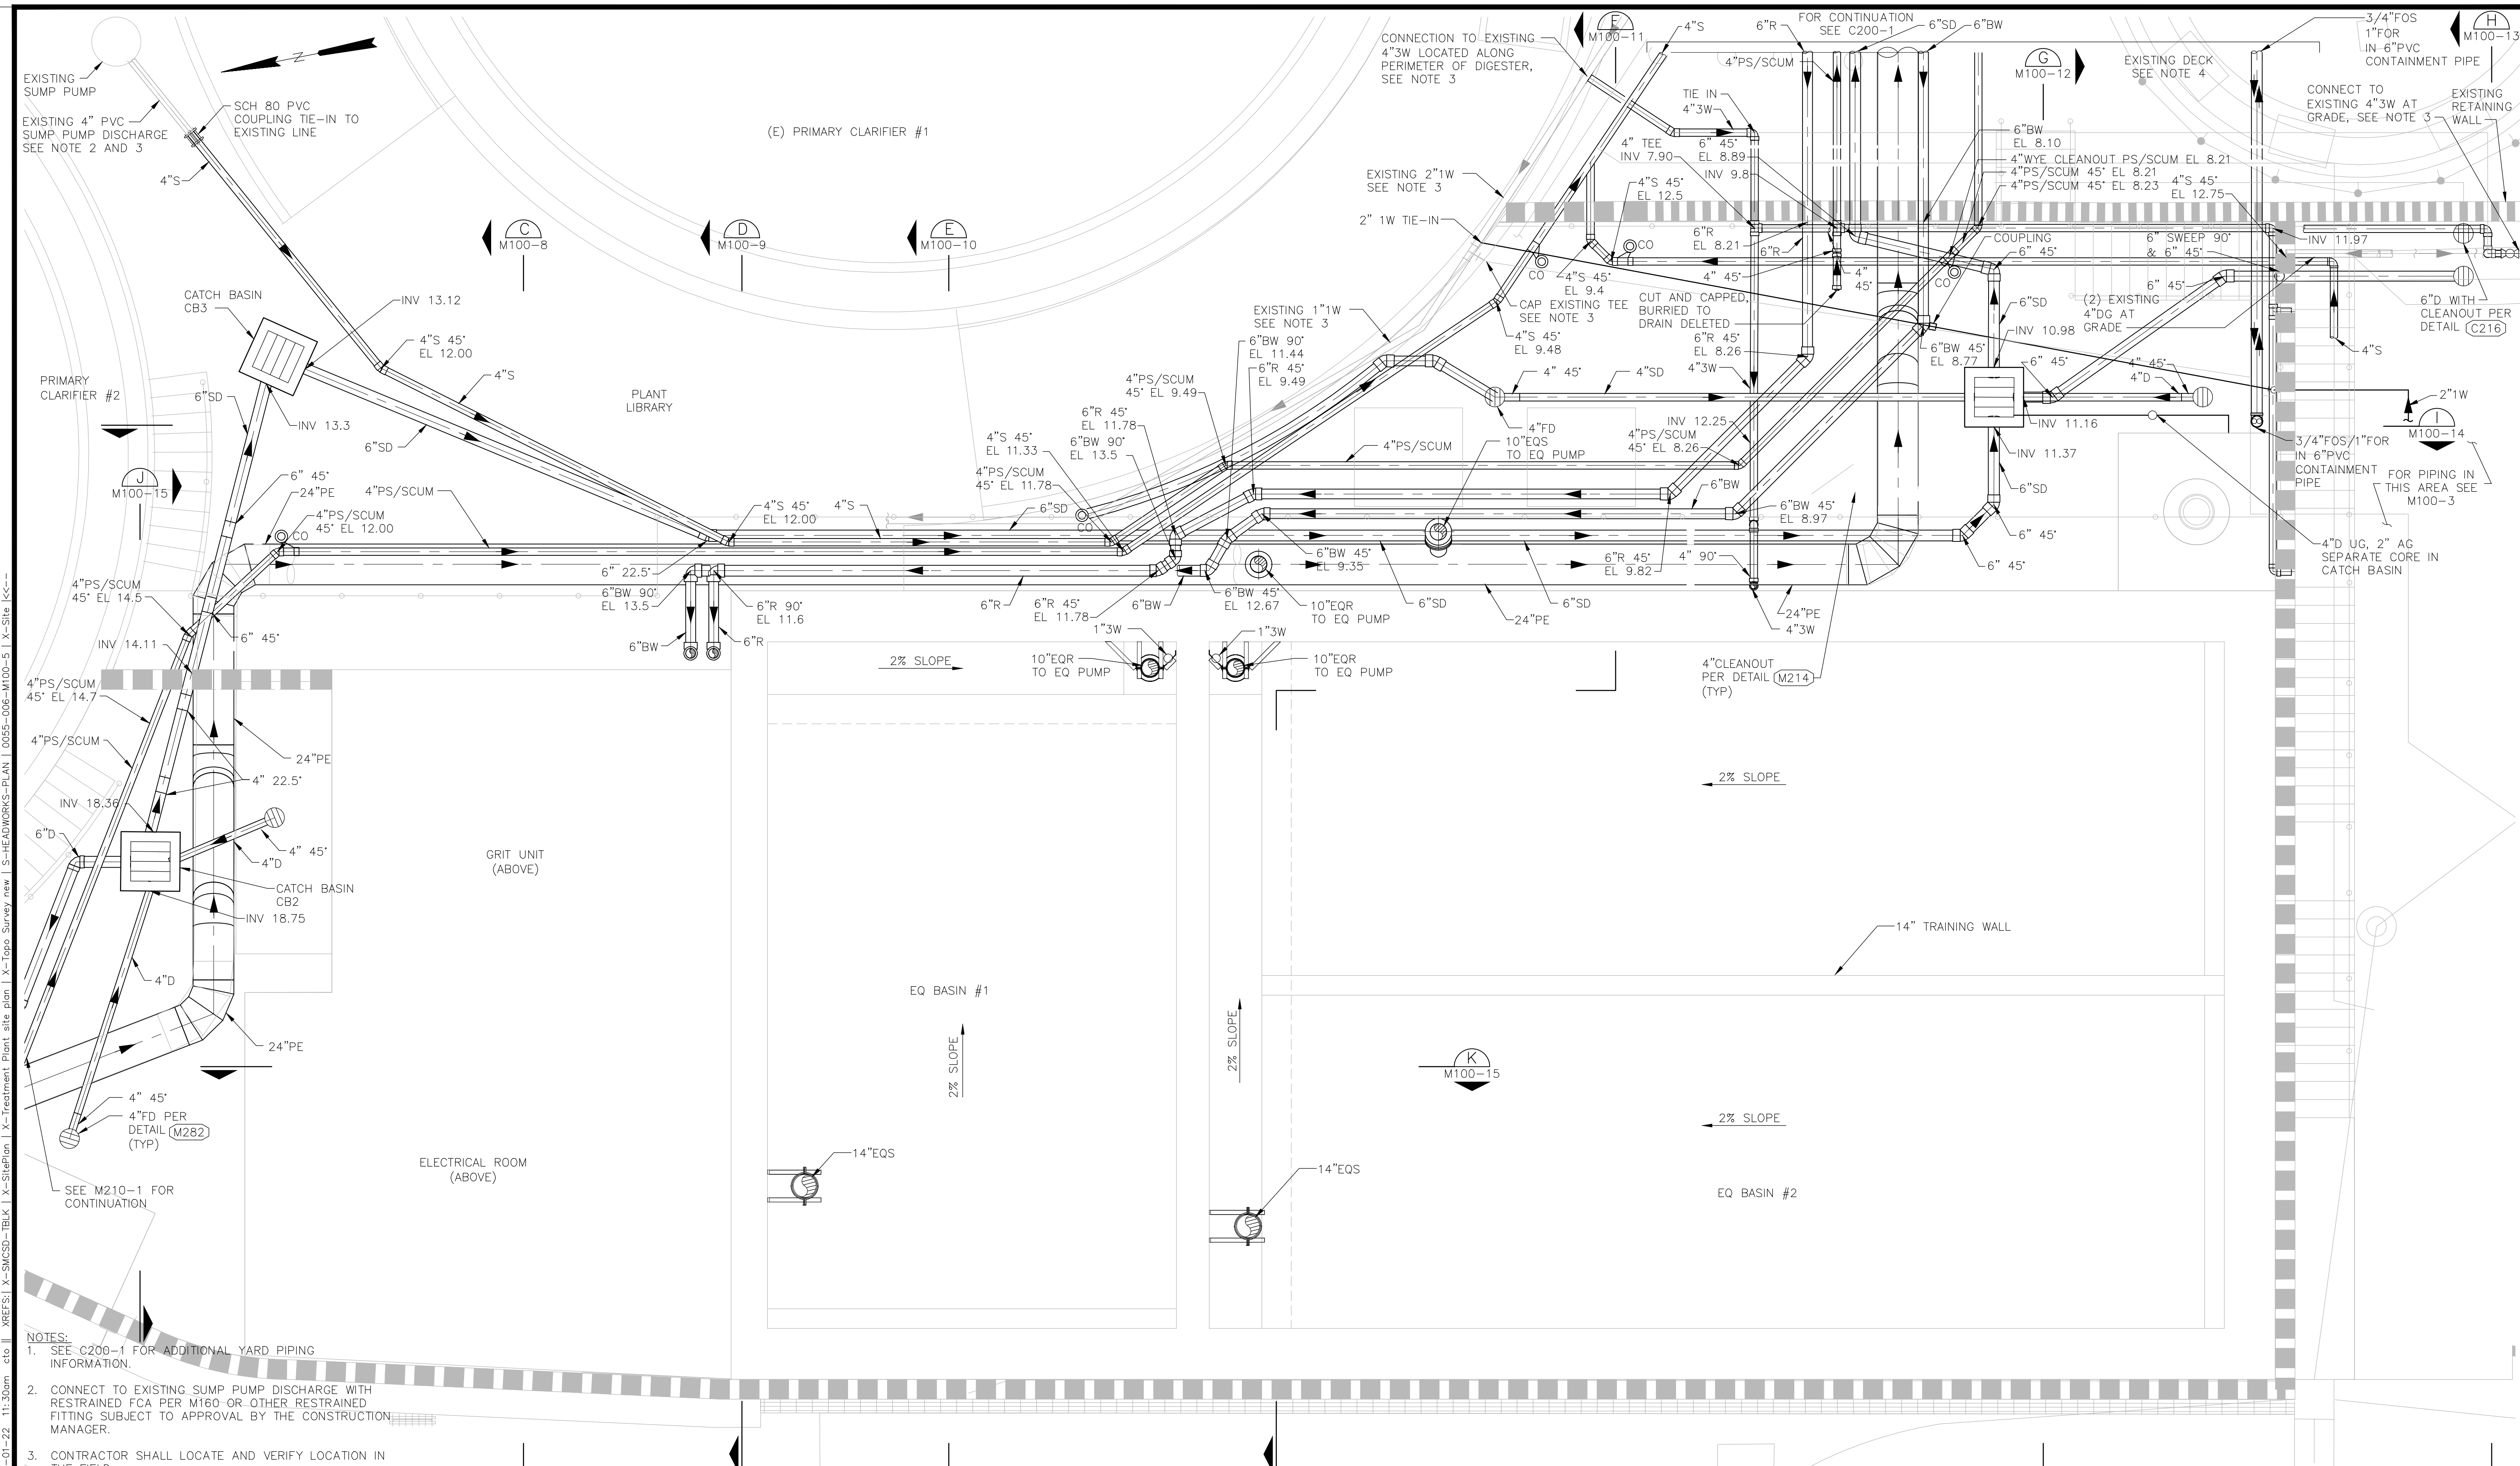

PLAN AT ELEVATION 12.00 FT  
1/4" = 1'-0"

- NOTES:
- SEE C200-1 FOR ADDITIONAL YARD PIPING INFORMATION.
  - CONNECT TO EXISTING SUMP PUMP DISCHARGE WITH RESTRAINED FCA PER M160 OR OTHER RESTRAINED FITTING SUBJECT TO APPROVAL BY THE CONSTRUCTION MANAGER.
  - CONTRACTOR SHALL LOCATE AND VERIFY LOCATION IN THE FIELD.
  - ALL PIPELINES IN THIS AREA SHALL BE LOCATED BELOW THE EXISTING CONCRETE DECK.

**RECORD DRAWING**  
THIS RECORD DRAWING HAS BEEN PREPARED FROM THE ORIGINAL CONTRACT DOCUMENTS SIGNED AND SEALED BY THE RESPONSIBLE ENGINEER OF RECORD. ADDITIONAL INFORMATION HAS BEEN PROVIDED BY OTHERS TO REPRESENT AS-CONSTRUCTED CONDITION AND IS SHOWN ON THESE RECORD DRAWINGS. THE RESPONSIBLE ENGINEER OF RECORD CANNOT VERIFY THE ACCURACY OF THE AS-CONSTRUCTED CONDITION INFORMATION REPRESENTED ON THE RECORD DRAWINGS.

0" = 1"  
VERIFY SCALES —  
BAR IS ONE INCH  
LONG ON FULL  
SIZE DRAWING.  
IF NOT ONE INCH  
LONG ON THIS  
DRAWING, ADJUST  
SCALES ACCORDINGLY




REV	DATE	BY	APVD	DESCRIPTION
1	07/22	CT	TV	RECORD DRAWING

DESIGNED	M. TAKEMOTO	SUBMITTED	MARK TAKEMOTO
DRAWN	S. NGUYEN		RMC PROJECT ENGINEER CE-64369
CHECKED	M. NAKAMOTO	APPROVED	STEVE CLARY
			RMC ENGINEER CE-30318



TREATMENT AND WET WEATHER FLOW UPGRADE  
**HEADWORKS AND EQ BASIN FOUNDATION PLAN**

DWG NO	M100-2
SHEET NO	125 OF 226
PROJ NO	055-006
DATE	JULY 2022

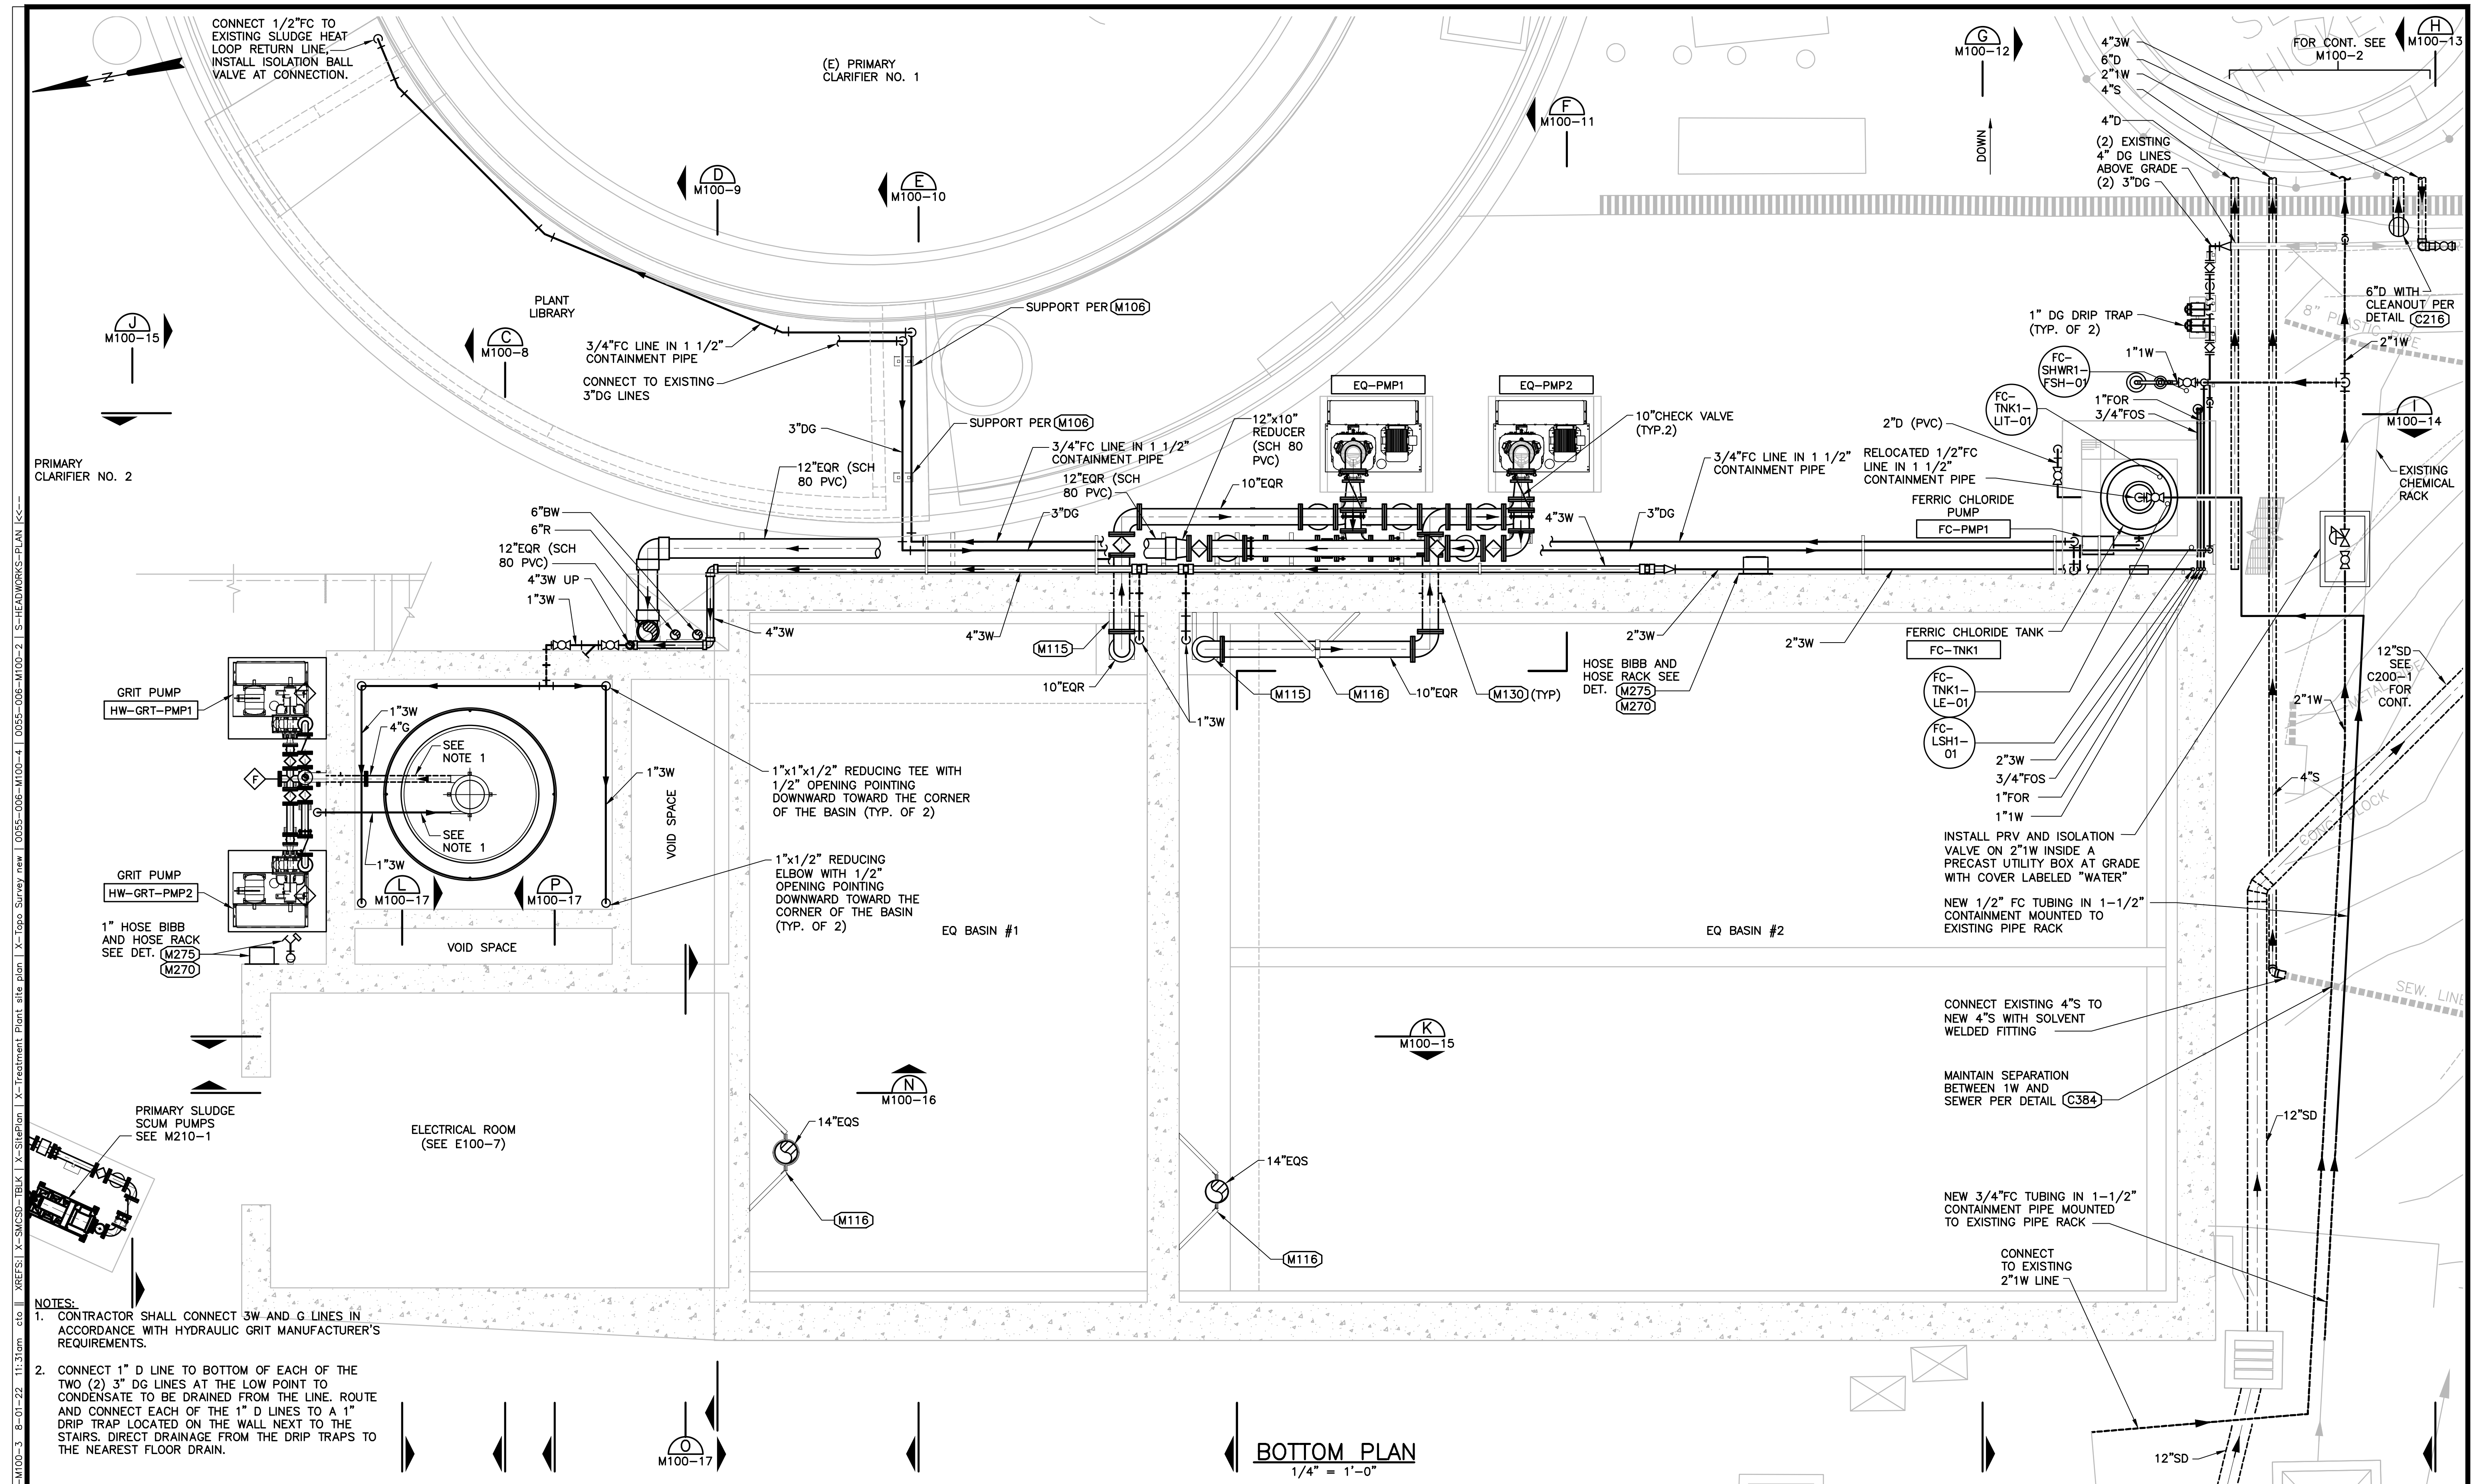

- NOTES:**
- CONTRACTOR SHALL CONNECT 3W AND G LINES IN ACCORDANCE WITH HYDRAULIC GRIT MANUFACTURER'S REQUIREMENTS.
  - CONNECT 1" D LINE TO BOTTOM OF EACH OF THE TWO (2) 3" DG LINES AT THE LOW POINT TO CONDENSATE TO BE DRAINED FROM THE LINE. ROUTE AND CONNECT EACH OF THE 1" D LINES TO A 1" DRIP TRAP LOCATED ON THE WALL NEXT TO THE STAIRS. DIRECT DRAINAGE FROM THE DRIP TRAPS TO THE NEAREST FLOOR DRAIN.

**BOTTOM PLAN**  
1/4" = 1'-0"

**RECORD DRAWING**  
THIS RECORD DRAWING HAS BEEN PREPARED FROM THE ORIGINAL CONTRACT DOCUMENTS SIGNED AND SEALED BY THE RESPONSIBLE ENGINEER OF RECORD. ADDITIONAL INFORMATION HAS BEEN PROVIDED BY OTHERS TO REPRESENT AS-CONSTRUCTED CONDITION AND IS SHOWN ON THESE RECORD DRAWINGS. THE RESPONSIBLE ENGINEER OF RECORD CANNOT VERIFY THE ACCURACY OF THE AS-CONSTRUCTED CONDITION INFORMATION REPRESENTED ON THE RECORD DRAWINGS.

0" = 1"  
VERIFY SCALES — BAR IS ONE INCH LONG ON FULL SIZE DRAWING. IF NOT ONE INCH LONG ON THIS DRAWING, ADJUST SCALES ACCORDINGLY



REV	DATE	BY	APVD	DESCRIPTION
▲	07/22	CT	TV	RECORD DRAWING
▲				
▲				


DESIGNED	M. TAKEMOTO	SUBMITTED	MARK TAKEMOTO
DRAWN	S. NGUYEN		RMC PROJECT ENGINEER CE-64369
CHECKED	M. NAKAMOTO	APPROVED:	STEVE CLARY
			RMC ENGINEER CE-30318



TREATMENT AND WET WEATHER FLOW UPGRADE  
**HEADWORKS AND EQ BASIN**  
LOWER PLAN EL 25.00

DWG NO	M100-3
SHEET NO	126 OF 226
PROJ NO	055-006
DATE	JULY 2022

FILENAME: 0055-006-M100-3 8-01-22 11:31am cto XREFS: X-SMUCSD-BLK X-SignPlan X-Treatment Plant site plan X-Topo Survey new 0055-006-M100-2 S-HEADWORKS-PLAN E-... Last Saved By: cto 5-10-21 01:45pm

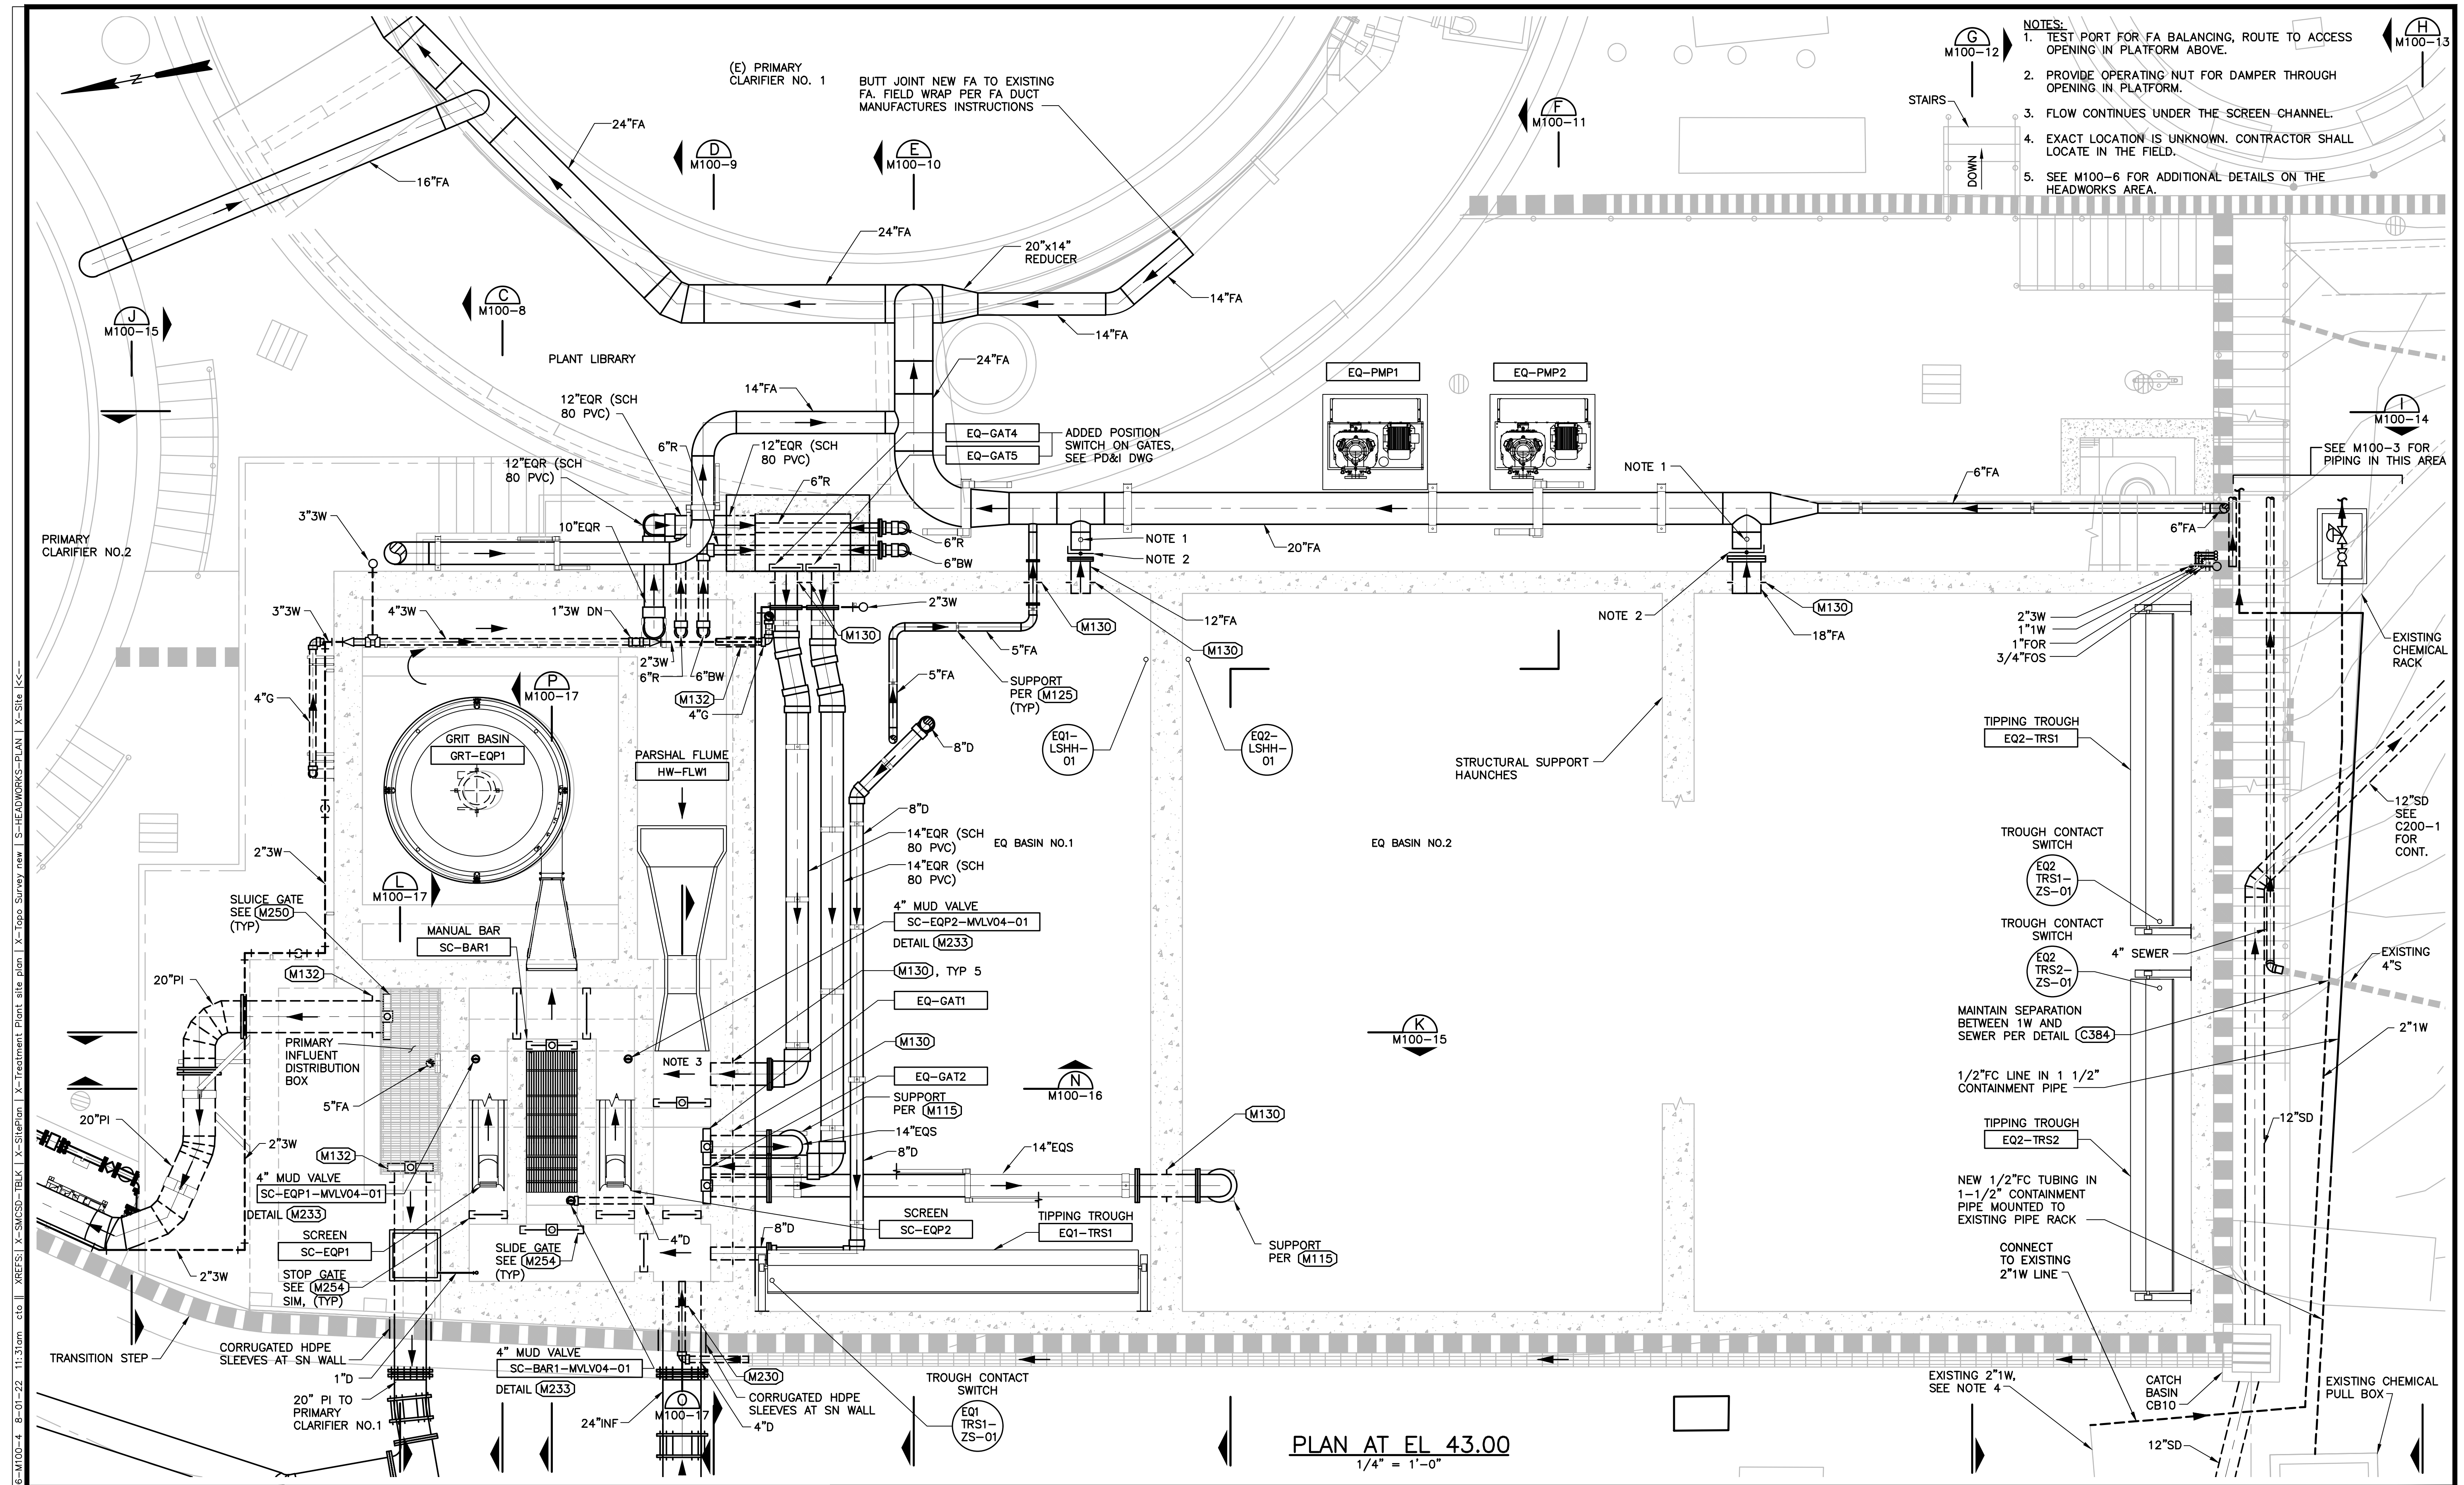

- NOTES:**
1. TEST PORT FOR FA BALANCING, ROUTE TO ACCESS OPENING IN PLATFORM ABOVE.
  2. PROVIDE OPERATING NUT FOR DAMPER THROUGH OPENING IN PLATFORM.
  3. FLOW CONTINUES UNDER THE SCREEN-CHANNEL.
  4. EXACT LOCATION IS UNKNOWN. CONTRACTOR SHALL LOCATE IN THE FIELD.
  5. SEE M100-6 FOR ADDITIONAL DETAILS ON THE HEADWORKS AREA.

**PLAN AT EL. 43.00**  
1/4" = 1'-0"

**RECORD DRAWING**  
THIS RECORD DRAWING HAS BEEN PREPARED FROM THE ORIGINAL CONTRACT DOCUMENTS SIGNED AND SEALED BY THE RESPONSIBLE ENGINEER OF RECORD. ADDITIONAL INFORMATION HAS BEEN PROVIDED BY OTHERS TO REPRESENT AS-CONSTRUCTED CONDITION AND IS SHOWN ON THESE RECORD DRAWINGS. THE RESPONSIBLE ENGINEER OF RECORD CANNOT VERIFY THE ACCURACY OF THE AS-CONSTRUCTED CONDITION INFORMATION REPRESENTED ON THE RECORD DRAWINGS.


0" = 1" VERIFY SCALES - BAR IS ONE INCH LONG ON FULL SIZE DRAWING. IF NOT ONE INCH LONG ON THIS DRAWING, ADJUST SCALES ACCORDINGLY

	DESIGNED	M. TAKEMOTO	DATE	07/22	BY	CT	APVD	TV	RECORD DRAWING
	DRAWN	S. NGUYEN	DESCRIPTION						

DESIGNED	M. TAKEMOTO	SUBMITTED	MARK TAKEMOTO
DRAWN	S. NGUYEN		RMC PROJECT ENGINEER CE-64369
CHECKED	M. NAKAMOTO	APPROVED	STEVE CLARY
			RMC ENGINEER CE-30318



TREATMENT AND WET WEATHER FLOW UPGRADE		DWG NO	M100-4
HEADWORKS AND EQ BASIN PLAN AT EL. 43.00		SHEET NO	127 OF 226
		PROJ NO	055-006
		DATE	JULY 2022

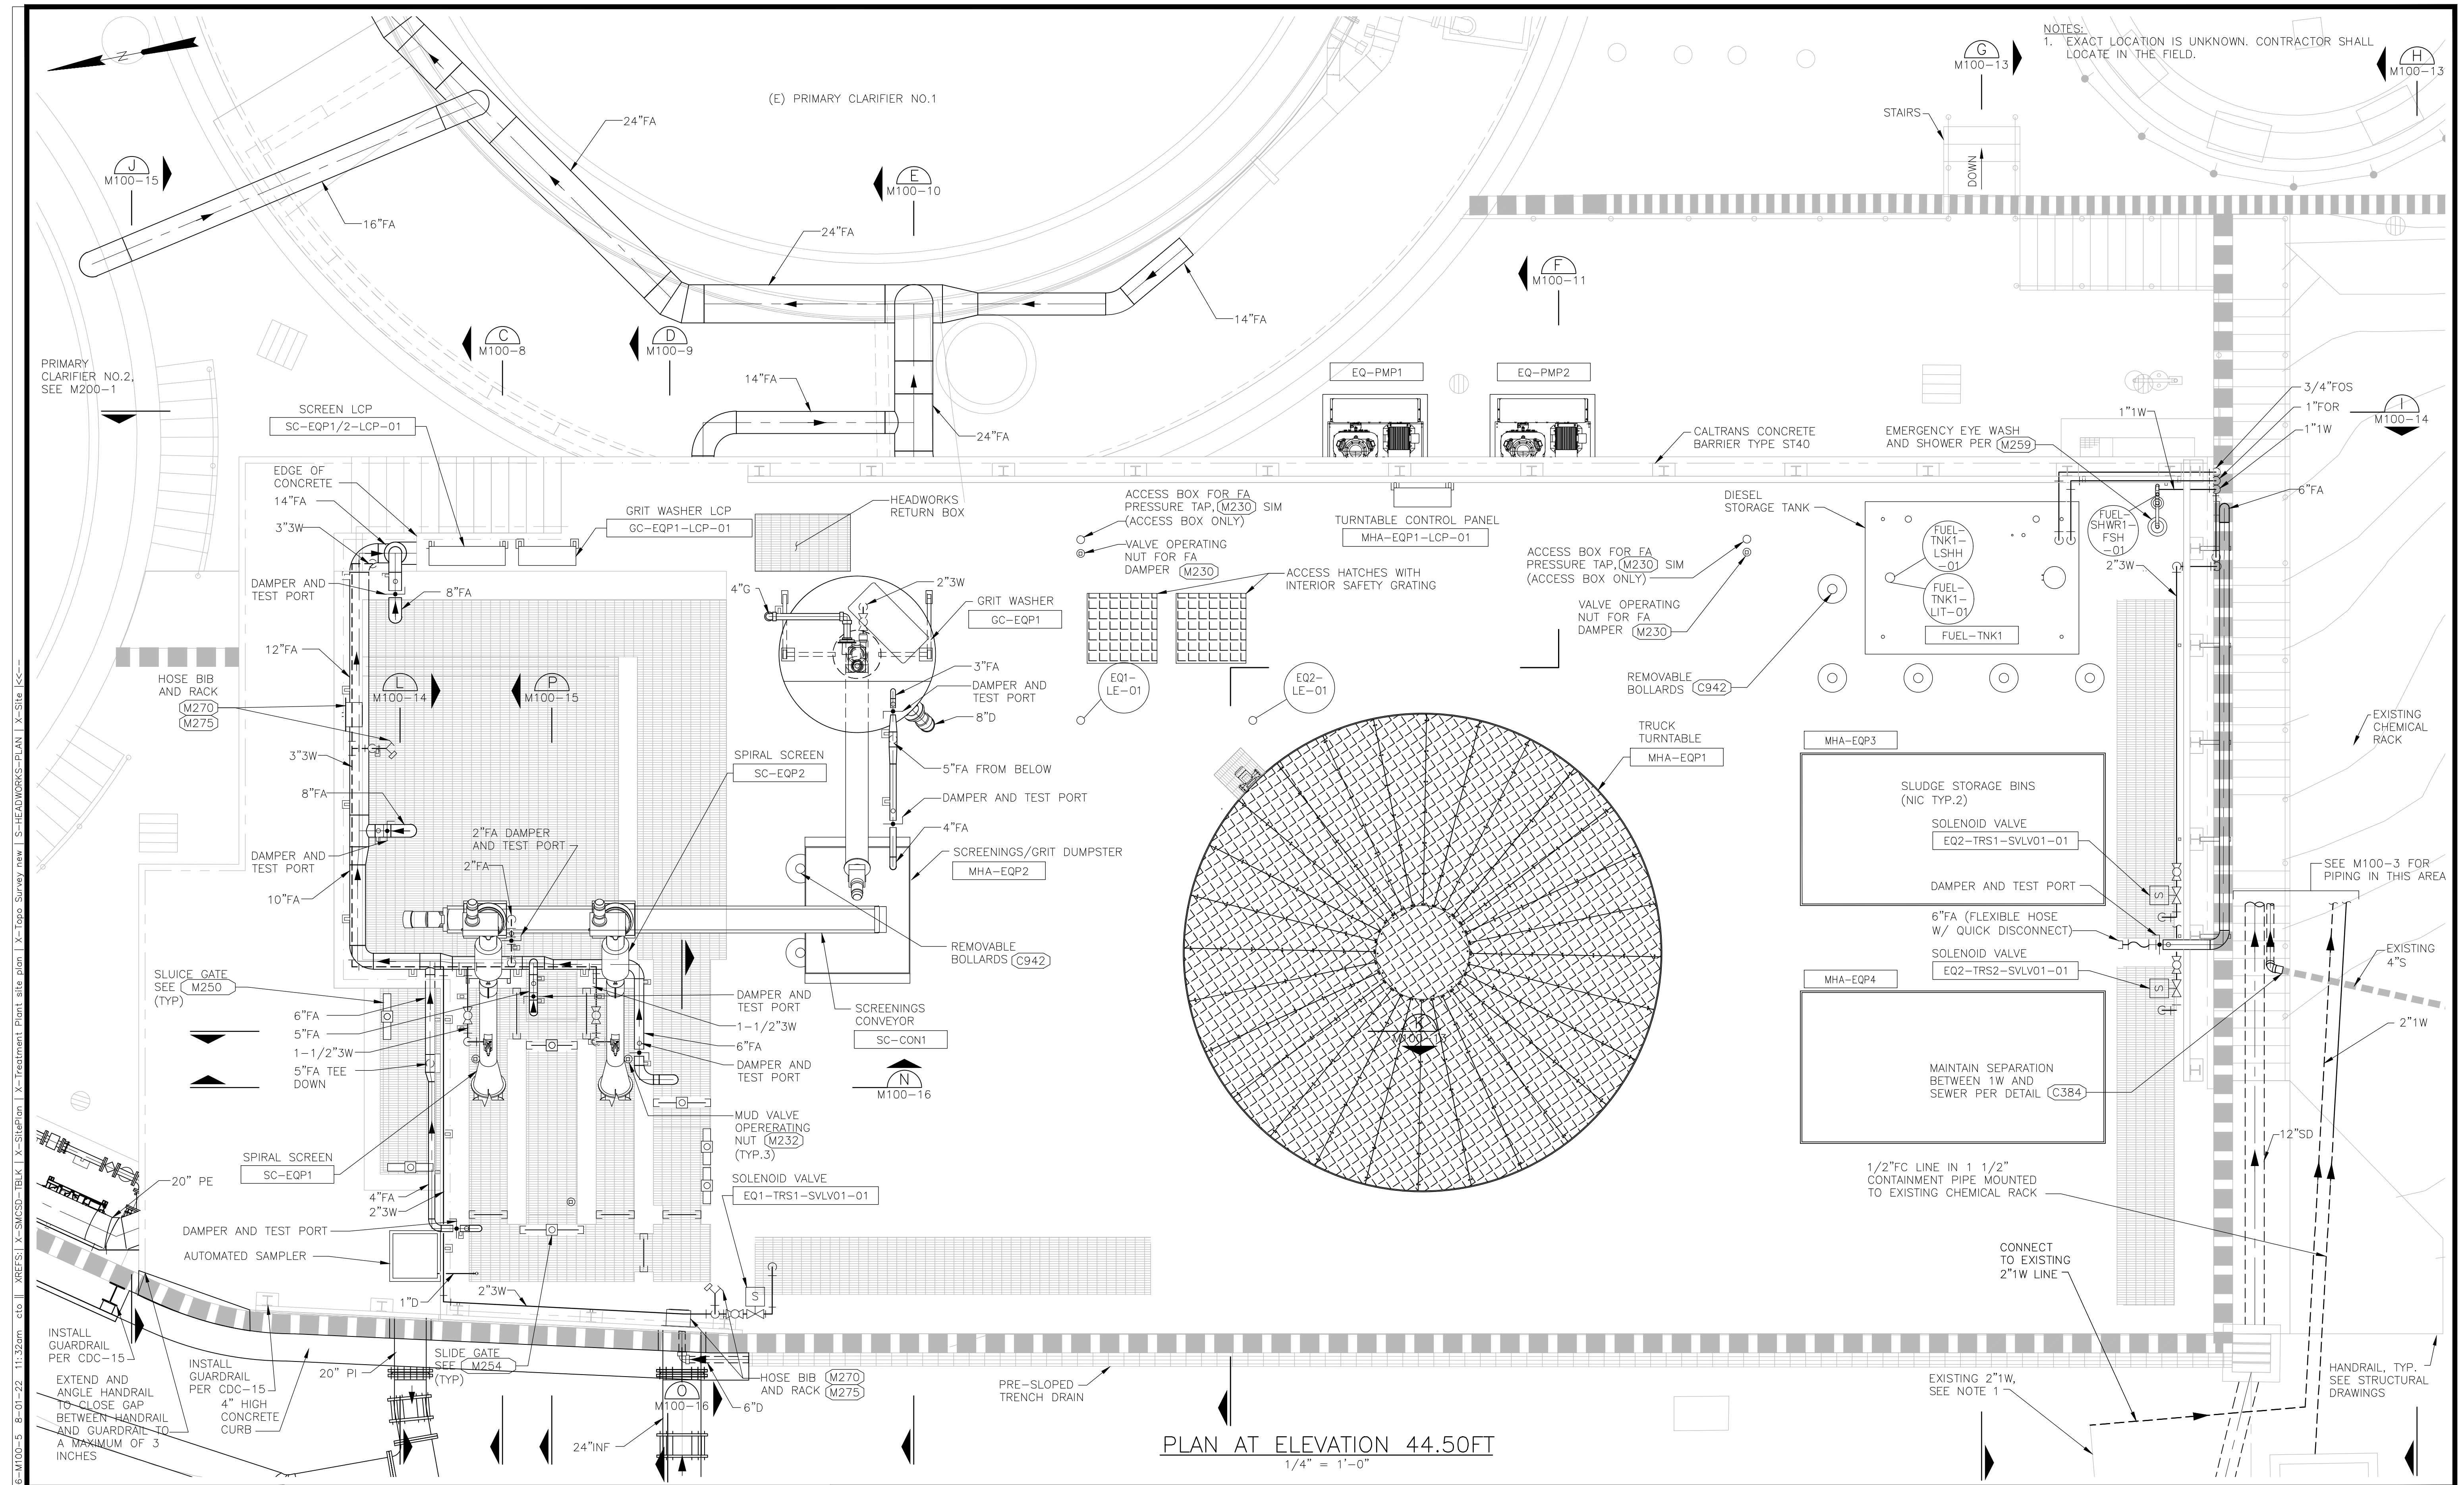

PLAN AT ELEVATION 44.50FT  
1/4" = 1'-0"

**RECORD DRAWING**  
THIS RECORD DRAWING HAS BEEN PREPARED FROM THE ORIGINAL CONTRACT DOCUMENTS SIGNED AND SEALED BY THE RESPONSIBLE ENGINEER OF RECORD. ADDITIONAL INFORMATION HAS BEEN PROVIDED BY OTHERS TO REPRESENT AS-CONSTRUCTED CONDITION AND IS SHOWN ON THESE RECORD DRAWINGS. THE RESPONSIBLE ENGINEER OF RECORD CANNOT VERIFY THE ACCURACY OF THE AS-CONSTRUCTED CONDITION INFORMATION REPRESENTED ON THE RECORD DRAWINGS.

0" = 1"  
VERIFY SCALES - BAR IS ONE INCH LONG ON FULL SIZE DRAWING. IF NOT ONE INCH LONG ON THIS DRAWING, ADJUST SCALES ACCORDINGLY





REV	DATE	BY	APVD	DESCRIPTION
07/22	CT	TV		RECORD DRAWING

DESIGNED	M. TAKEMOTO	SUBMITTED	MARK TAKEMOTO
DRAWN	S. NGUYEN		RMC PROJECT ENGINEER CE-64369
CHECKED	M. NAKAMOTO	APPROVED	STEVE CLARY
			RMC ENGINEER CE-30318



TREATMENT AND WET WEATHER FLOW UPGRADE		DWG NO	M100-5
HEADWORKS AND EQ BASIN TOP PLAN		SHEET NO	128 OF 226
		PROJ NO	055-006
		DATE	JULY 2022

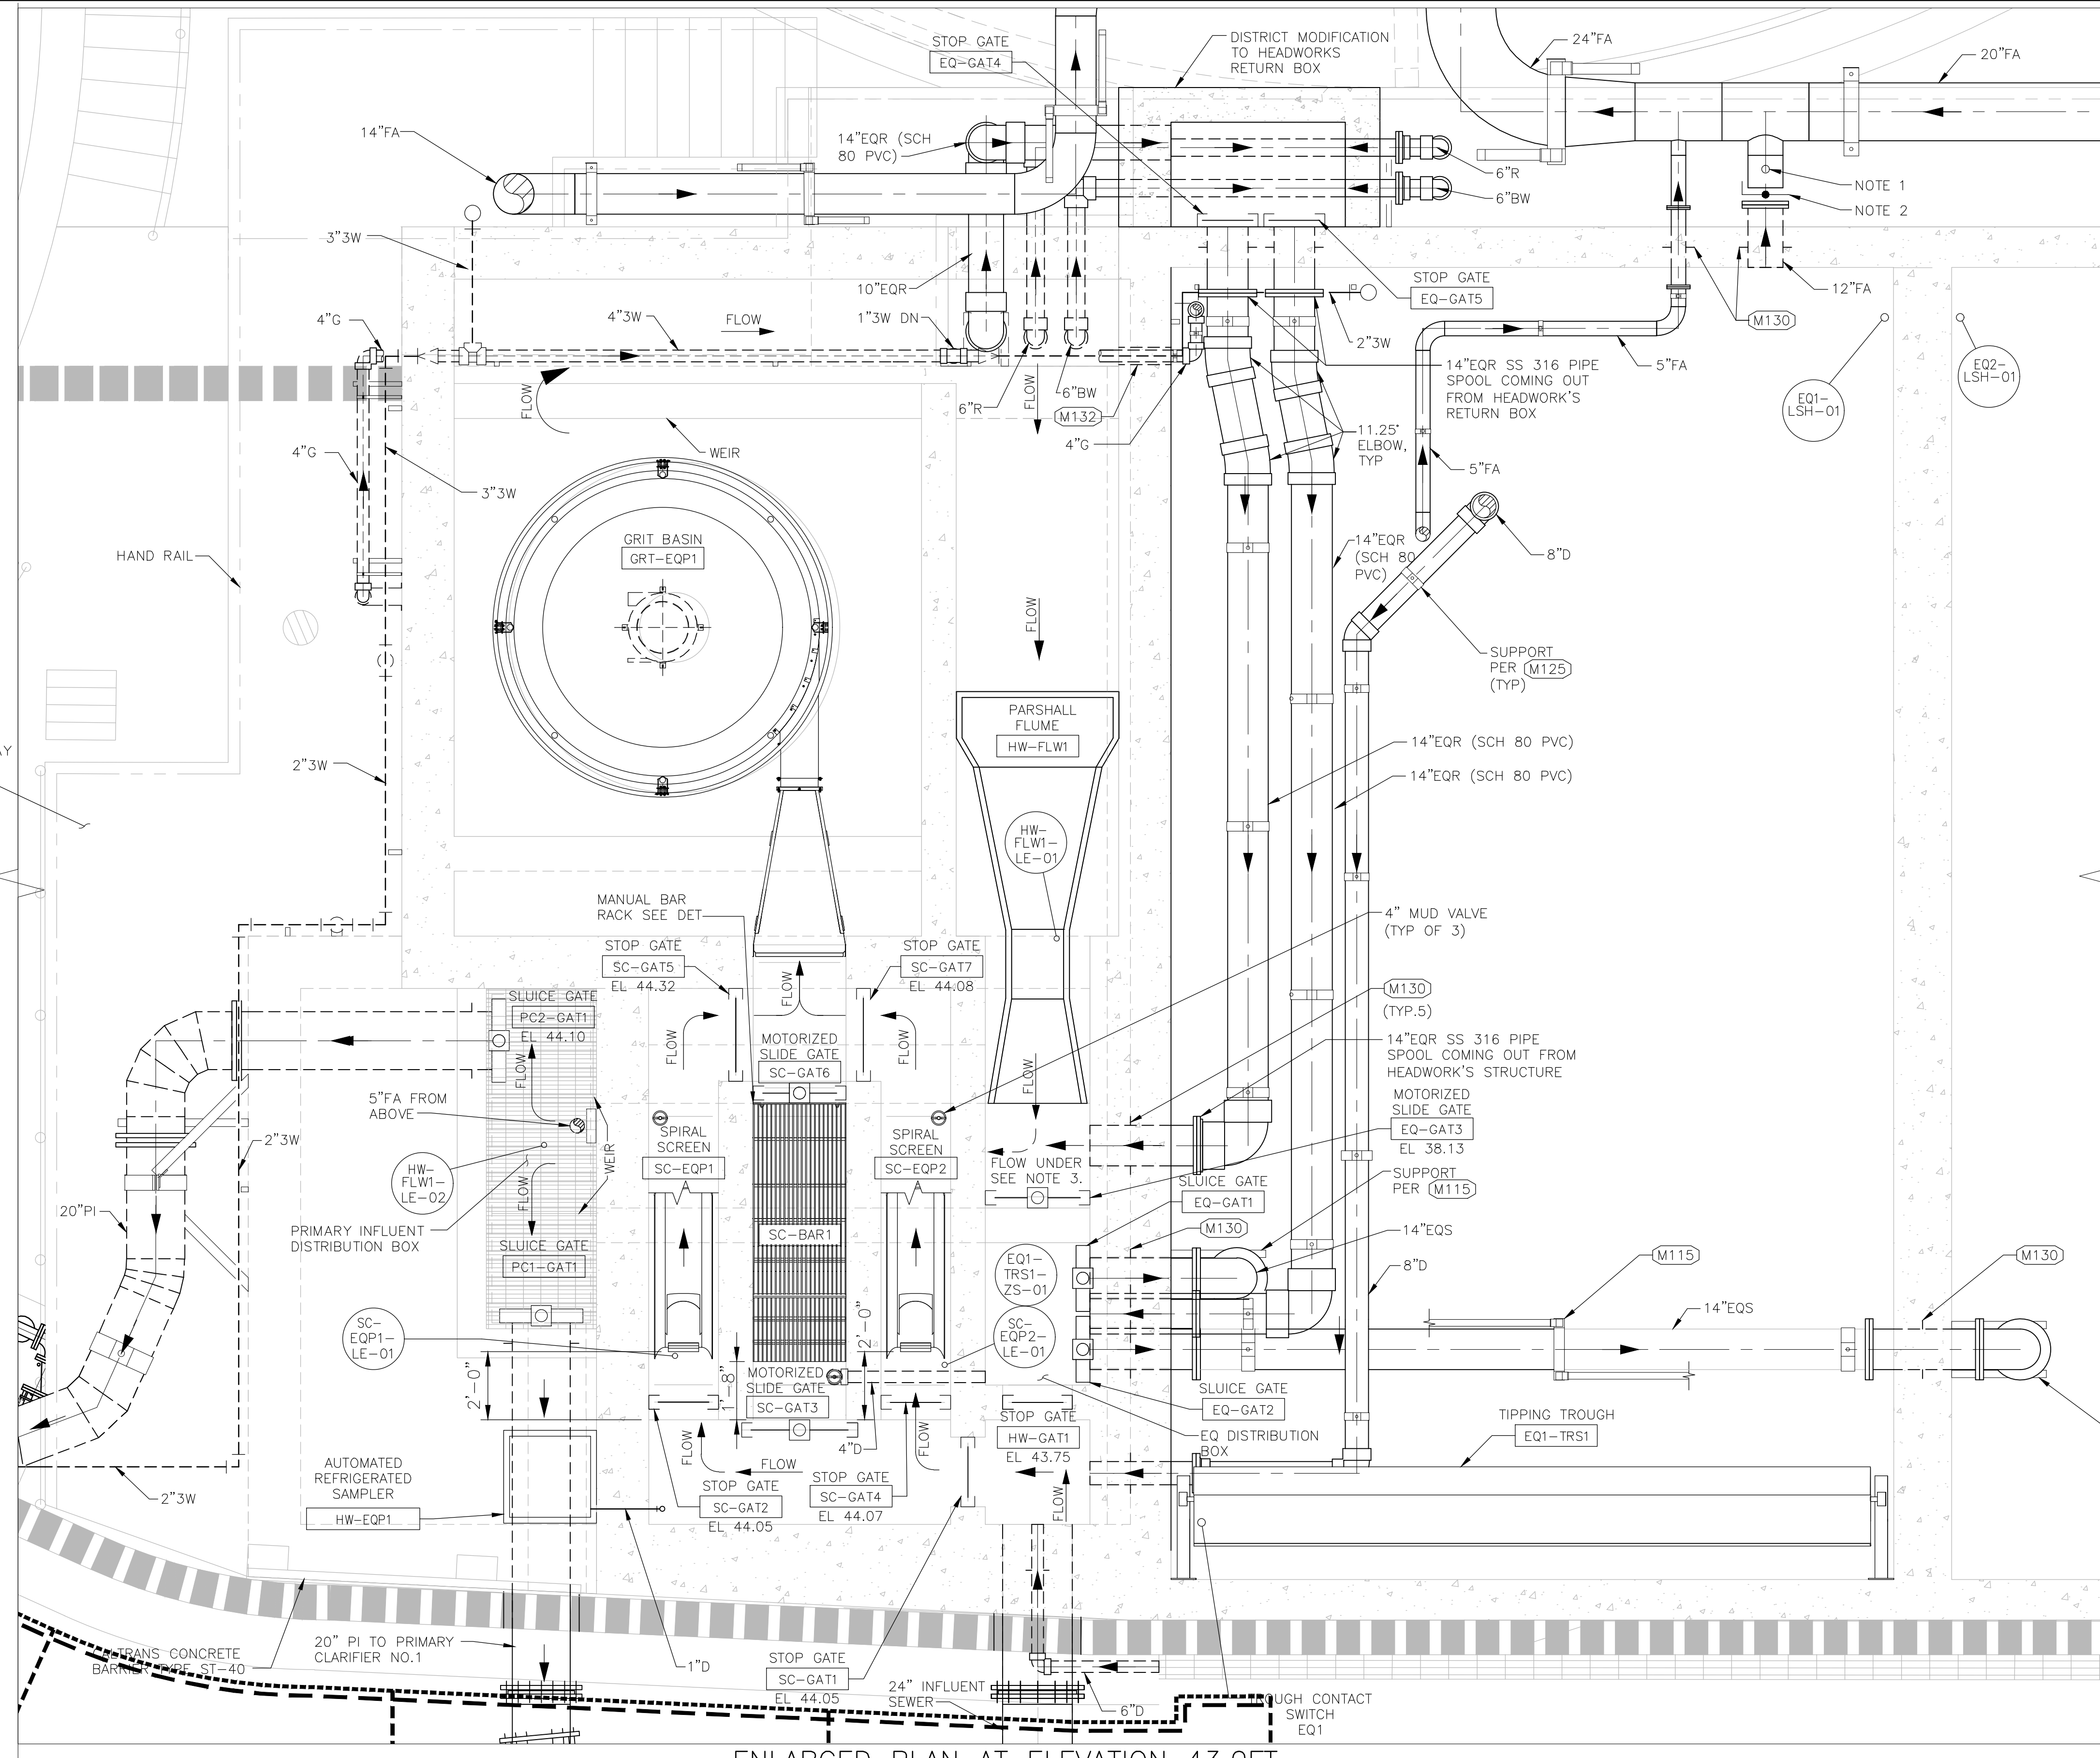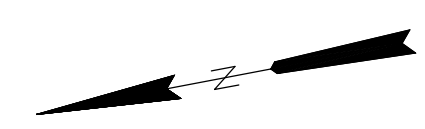

- NOTES:
1. TEST PORT, ROUTE TO ACCESS OPENING IN PLATFORM ABOVE.
  2. PROVIDE OPERATING NUT FOR DAMPER THROUGH OPENING IN PLATFORM.
  3. FLOW CONTINUES UNDER THE SCREEN CHANNEL.

ENLARGED PLAN AT ELEVATION 43.0FT  
3/8" = 1'-0"

FILENAME: 0055-006-M100-6 8-01-22 11:32am cto || xREFS: | x-SitePlan | x-Treatment Plant site plan | x-Topo Survey new | S-HEADWORKS-PLAN | x-Site | 0055-006-M100-4 | cto

**RECORD DRAWING**  
 THIS RECORD DRAWING HAS BEEN PREPARED FROM THE ORIGINAL CONTRACT DOCUMENTS SIGNED AND SEALED BY THE RESPONSIBLE ENGINEER OF RECORD. ADDITIONAL INFORMATION HAS BEEN PROVIDED BY OTHERS TO REPRESENT AS-CONSTRUCTED CONDITION AND IS SHOWN ON THESE RECORD DRAWINGS. THE RESPONSIBLE ENGINEER OF RECORD CANNOT VERIFY THE ACCURACY OF THE AS-CONSTRUCTED CONDITION INFORMATION REPRESENTED ON THE RECORD DRAWINGS.

0" = 1"  
 VERIFY SCALES - BAR IS ONE INCH LONG ON FULL SIZE DRAWING. IF NOT ONE INCH LONG ON THIS DRAWING, ADJUST SCALES ACCORDINGLY



REV	DATE	BY	APVD	DESCRIPTION
07/22	CT	TV		RECORD DRAWING


DESIGNED	M. TAKEMOTO	SUBMITTED	MARK TAKEMOTO
DRAWN	S. NGUYEN		RMC PROJECT ENGINEER CE-64369
CHECKED	M. NAKAMOTO	APPROVED:	STEVE CLARY
			RMC ENGINEER CE-30318



TREATMENT AND WET WEATHER FLOW UPGRADE  
**HEADWORKS AND EQ BASIN**  
 ENLARGED PLAN AT EL 43.00


DWG NO	M100-6
SHEET NO	129 OF 226
PROJ NO	055-006
DATE	JULY 2022

FILENAME: 0055-006-M100-7 8-01-22 11:33am etc || XREFS: X-SMCSO-BLK | X-Headworks Sections | 0055-006-M100-5 | 0055-006-M100-2 | 0055-006-M100-3 | 0055-006-M100-4 | X-StrPlan | X-Topo Survey new | S-Headworks-SECT | X-Treatment Plant site plan | S-TANK-SECT | X-...

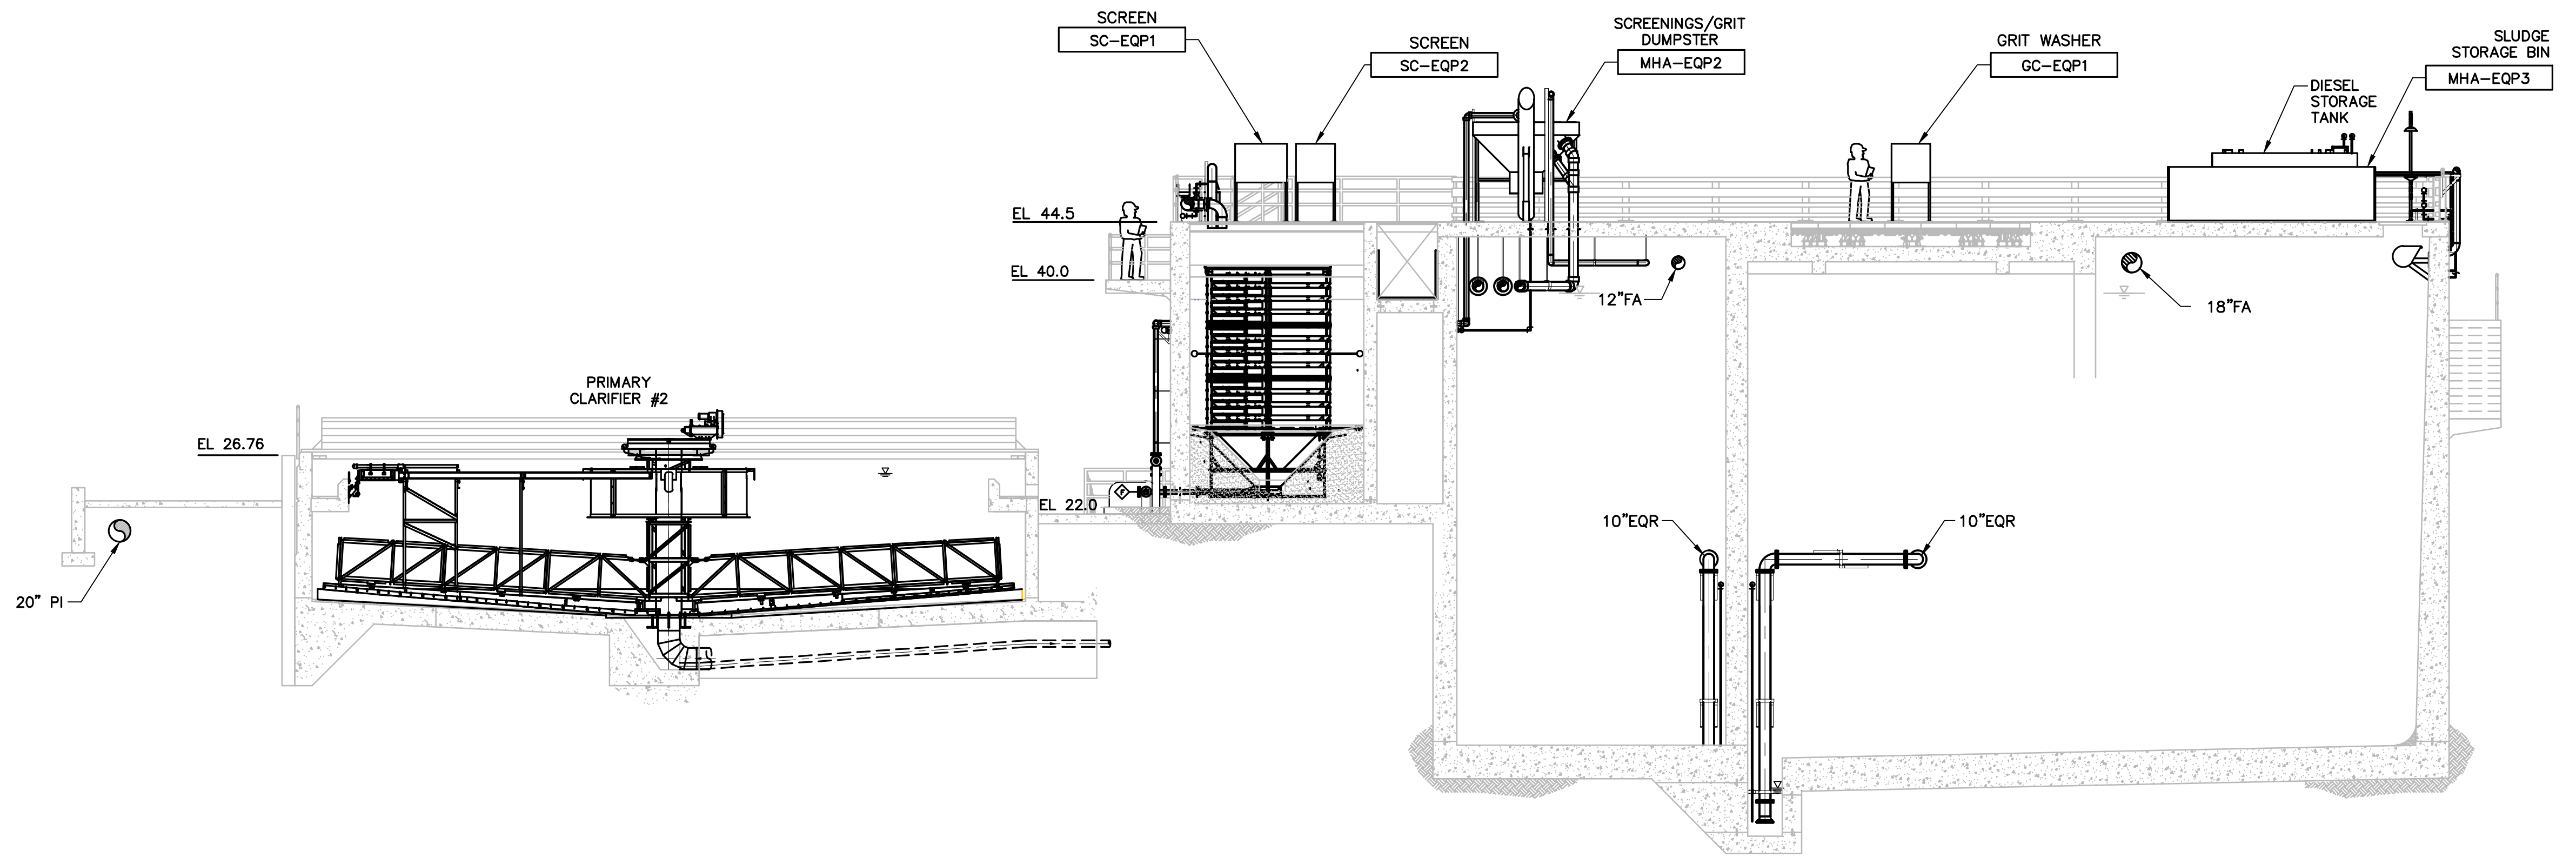

**SECTION A**  
SCALE: 1/8"=1'-0" M100-1

**NOTES:**  
1. NOT ALL BURIED PIPING SHOWN FOR CLARITY.

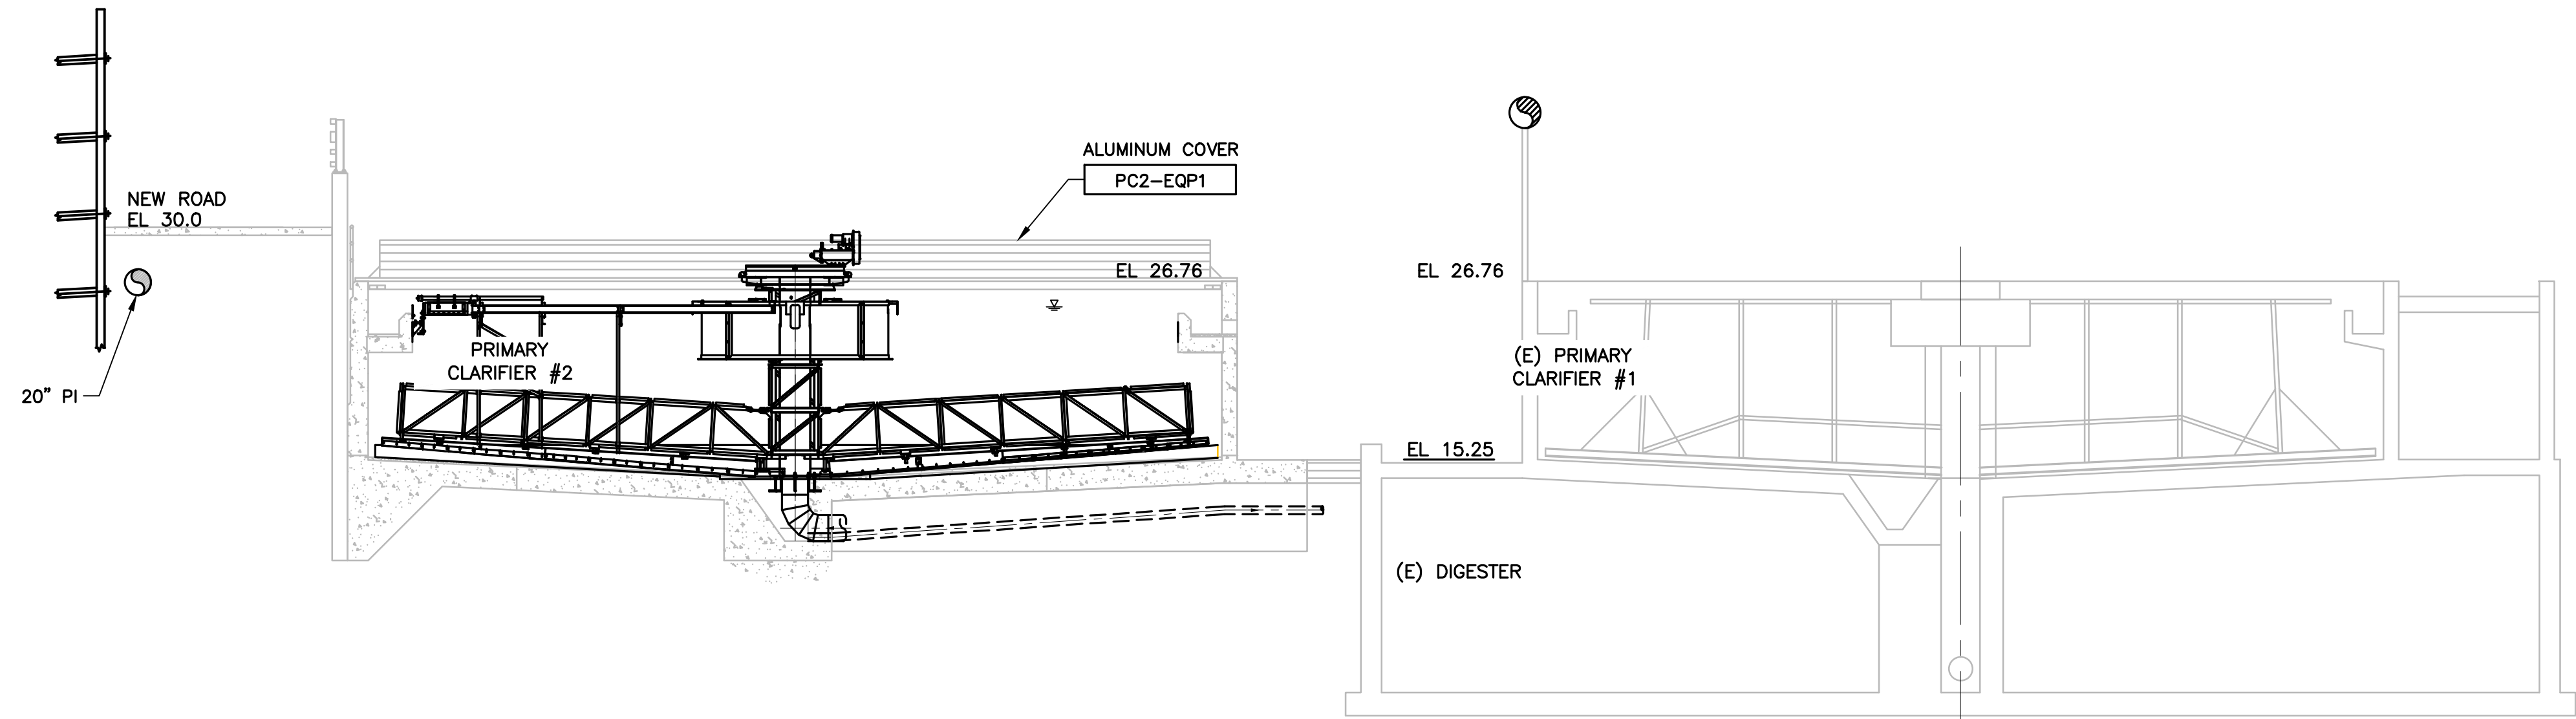

**SECTION B**  
SCALE: 1/8"=1'-0" M100-1

**RECORD DRAWING**

THIS RECORD DRAWING HAS BEEN PREPARED FROM THE ORIGINAL CONTRACT DOCUMENTS SIGNED AND SEALED BY THE RESPONSIBLE ENGINEER OF RECORD. ADDITIONAL INFORMATION HAS BEEN PROVIDED BY OTHERS TO REPRESENT AS-CONSTRUCTED CONDITION AND IS SHOWN ON THESE RECORD DRAWINGS. THE RESPONSIBLE ENGINEER OF RECORD CANNOT VERIFY THE ACCURACY OF THE AS-CONSTRUCTED CONDITION INFORMATION REPRESENTED ON THE RECORD DRAWINGS.

0" = 1"  
VERIFY SCALES —  
BAR IS ONE INCH  
LONG ON FULL  
SIZE DRAWING.  
IF NOT ONE INCH  
LONG ON THIS  
DRAWING, ADJUST  
SCALES ACCORDINGLY



REV	DATE	BY	APVD	DESCRIPTION
▲	07/22	CT	TV	RECORD DRAWING

DESIGNED	M. TAKEMOTO
DRAWN	S. NGUYEN
CHECKED	M. NAKAMOTO


SUBMITTED:	MARK TAKEMOTO	RMC PROJECT ENGINEER	CE-64369
APPROVED:	STEVE CLARY	RMC ENGINEER	CE-30318



TREATMENT AND WET WEATHER FLOW UPGRADE  
**HEADWORKS/PRIMARY SECTION 1**

DWG NO	M100-7
SHEET NO	130 OF 226
PROJ NO	055-006
DATE	JULY 2022

NOTES:  
 1. CONTRACTOR SHALL COORDINATE AND CONFIRM ALL EQUIPMENT DIMENSIONS, CONNECTIONS, AND INSTALLATION REQUIREMENTS.

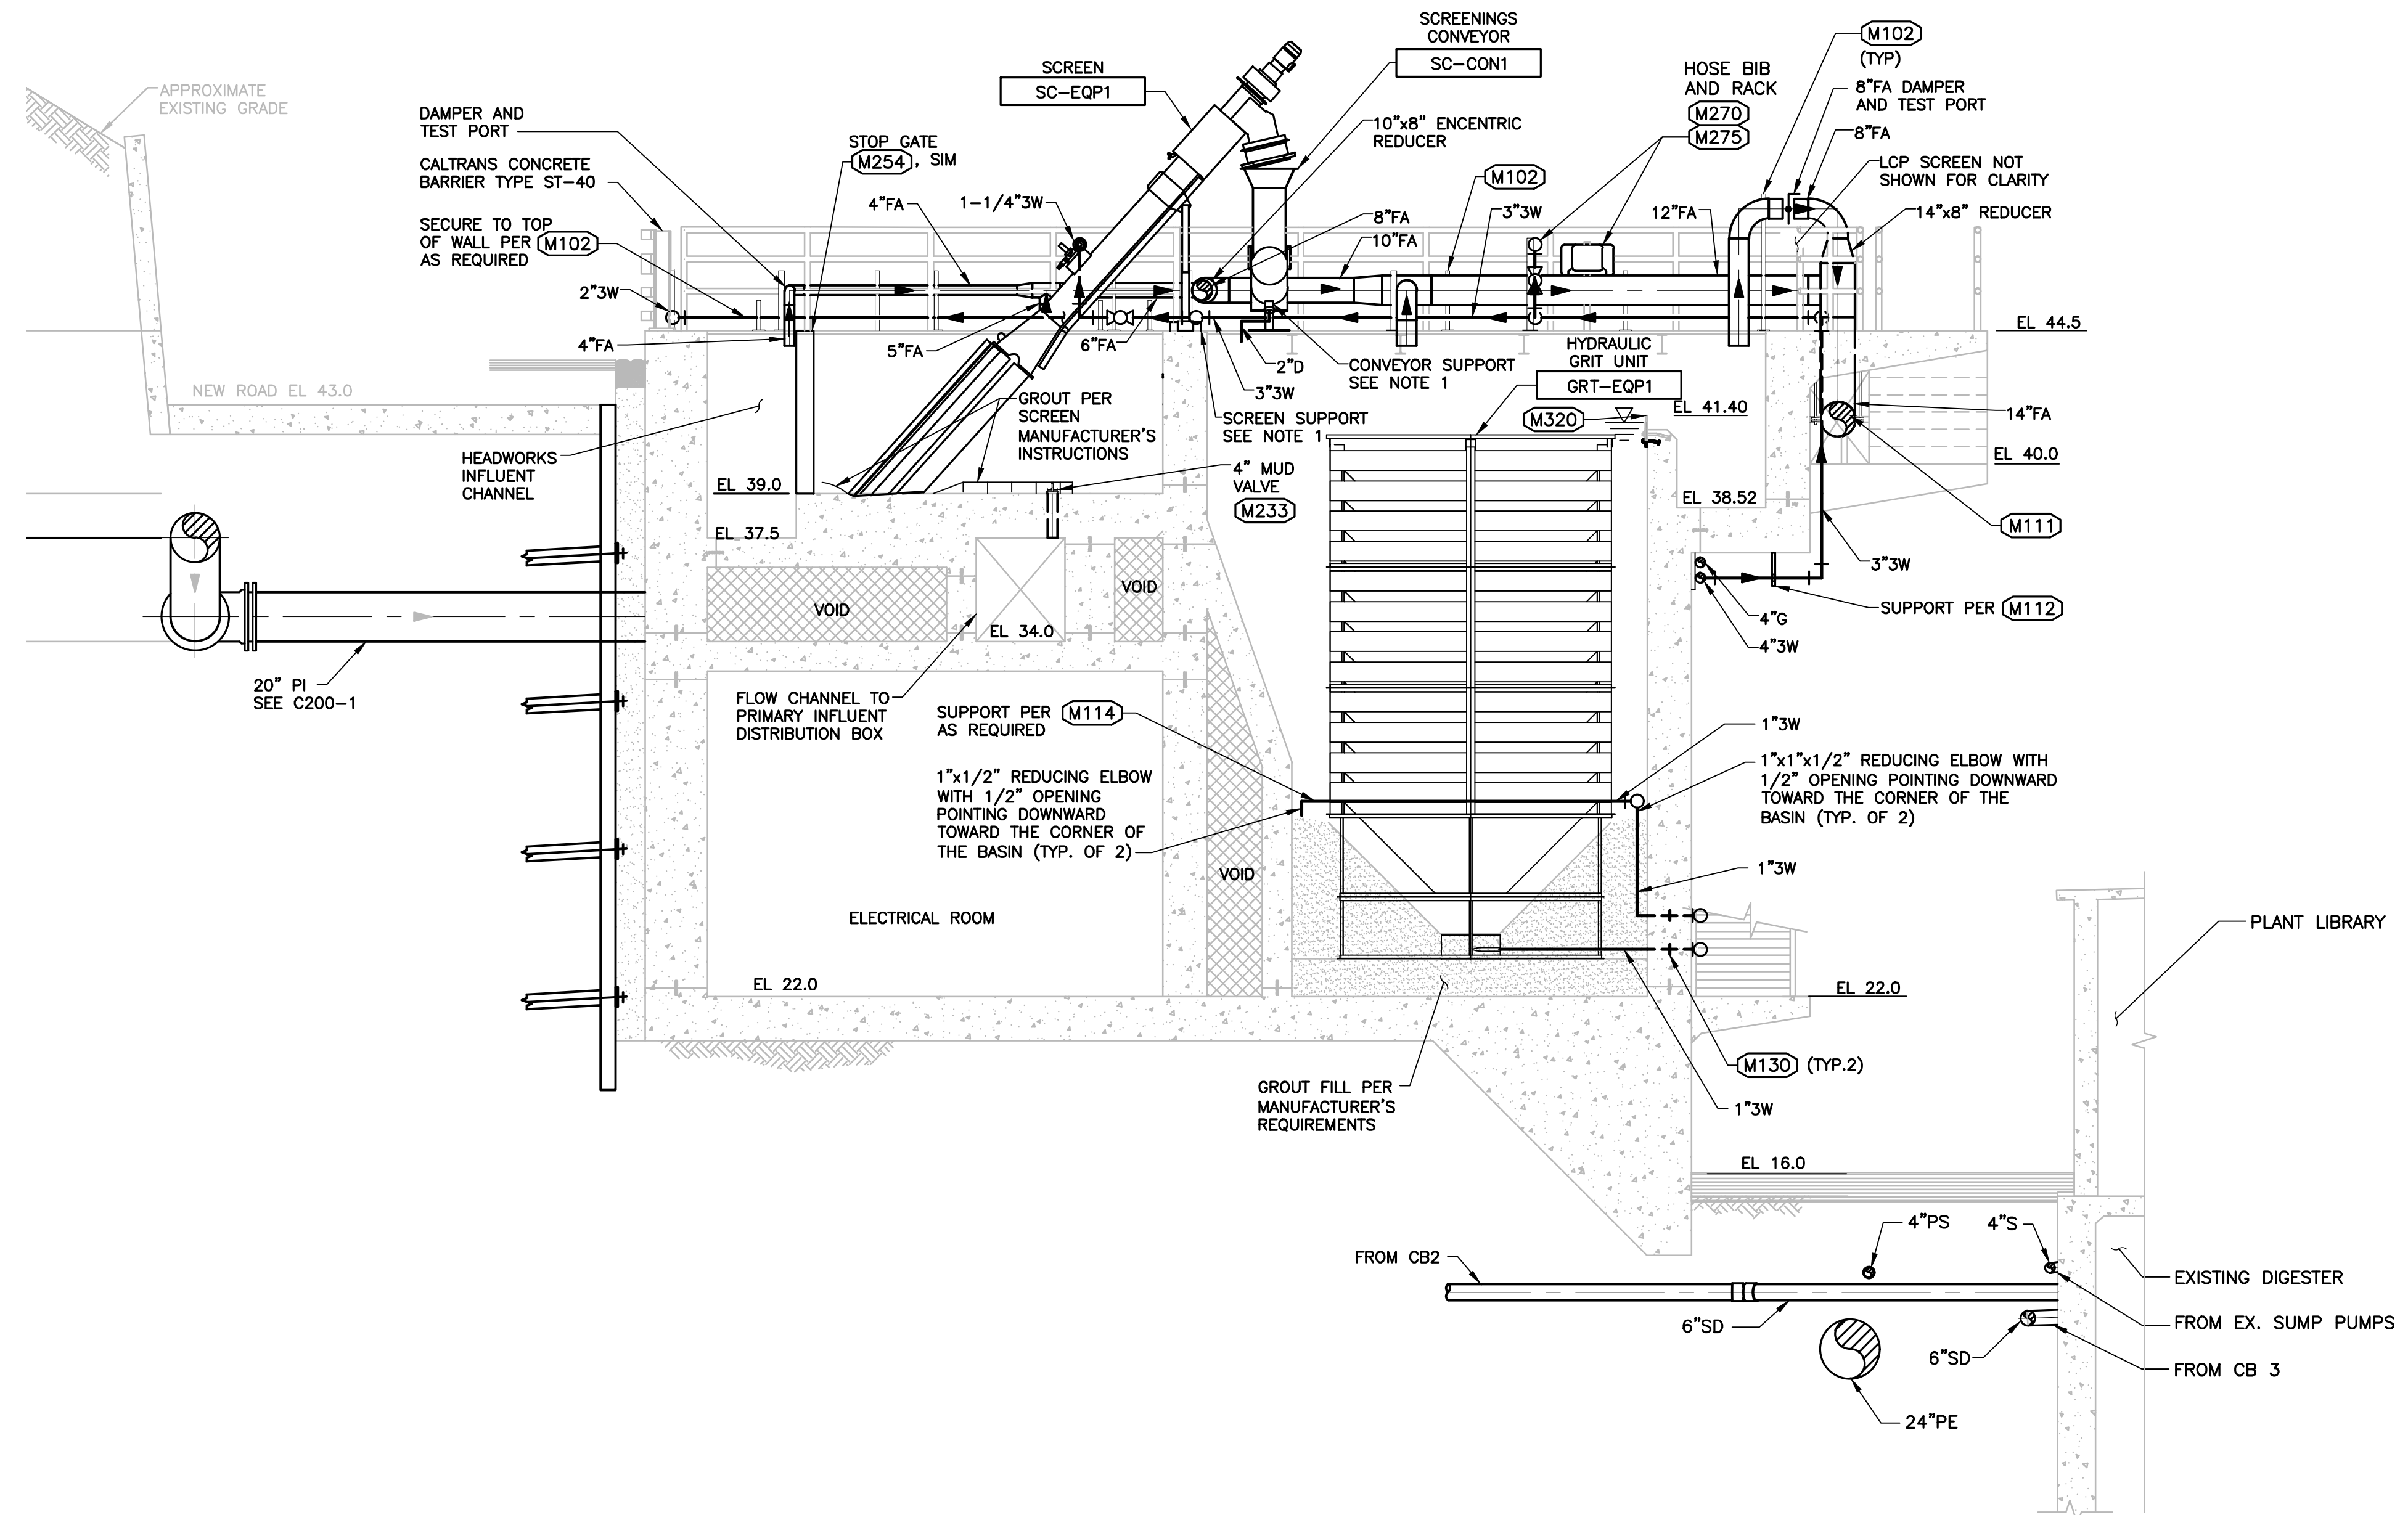

SECTION C  
 SCALE: 1/4"=1'-0" M100-3

FILENAME: 0355-006-M100-8 - 01-22 11:34am.ctb XREFS: X-SMCSO-BLK X-Headworks Sections X-Topo Survey new 0355-006-M100-2 0355-006-M100-3 0355-006-M100-4 X-Treatment Plant site plan kcc-

**RECORD DRAWING**  
 THIS RECORD DRAWING HAS BEEN PREPARED FROM THE ORIGINAL CONTRACT DOCUMENTS SIGNED AND SEALED BY THE RESPONSIBLE ENGINEER OF RECORD. ADDITIONAL INFORMATION HAS BEEN PROVIDED BY OTHERS TO REPRESENT AS-CONSTRUCTED CONDITION AND IS SHOWN ON THESE RECORD DRAWINGS. THE RESPONSIBLE ENGINEER OF RECORD CANNOT VERIFY THE ACCURACY OF THE AS-CONSTRUCTED CONDITION INFORMATION REPRESENTED ON THE RECORD DRAWINGS.

0" = 1"  
 VERIFY SCALES —  
 BAR IS ONE INCH  
 LONG ON FULL  
 SIZE DRAWING.  
 IF NOT ONE INCH  
 LONG ON THIS  
 DRAWING, ADJUST  
 SCALES ACCORDINGLY



REV	DATE	BY	APVD	DESCRIPTION
▲				
▲				
▲	07/22	CT	TV	RECORD DRAWING

DESIGNED	M. TAKEMOTO	SUBMITTED	MARK TAKEMOTO
DRAWN	S. NGUYEN		RMC PROJECT ENGINEER CE-64369
CHECKED	M. NAKAMOTO	APPROVED:	STEVE CLARY
			RMC ENGINEER CE-30318




TREATMENT AND WET WEATHER FLOW UPGRADE  
**HEADWORKS SECTION 1**

DWG NO	M100-8
SHEET NO	131 OF 226
PROJ NO	055-006
DATE	JULY 2022

FILENAME: 0055-006-M100-9 - 8-01-22 11:34am.ctb XREFS: X-SMCSO-BLK | S-HEADWORKS-SECT | X-HEADWORKS-SECTIONS | 0055-006-M100-3 | 0055-006-M100-2 | 0055-006-M100-1 | X-Topo-Survey-new | X-Treatment-Plant-site-plan | X-...

- NOTES:**
- CONTRACTOR SHALL COORDINATE AND CONFIRM ALL EQUIPMENT DIMENSIONS, CONNECTIONS, AND INSTALLATION REQUIREMENTS.
  - PIPE SUPPORTS SHALL BE PROVIDED IN ACCORDANCE WITH SECTION 15006.
  - BURIED PIPELINES LOCATED BETWEEN THE EXISTING DIGESTER AND NEW EQ STRUCTURE SHALL BE BACKFILLED WITH CLSM.

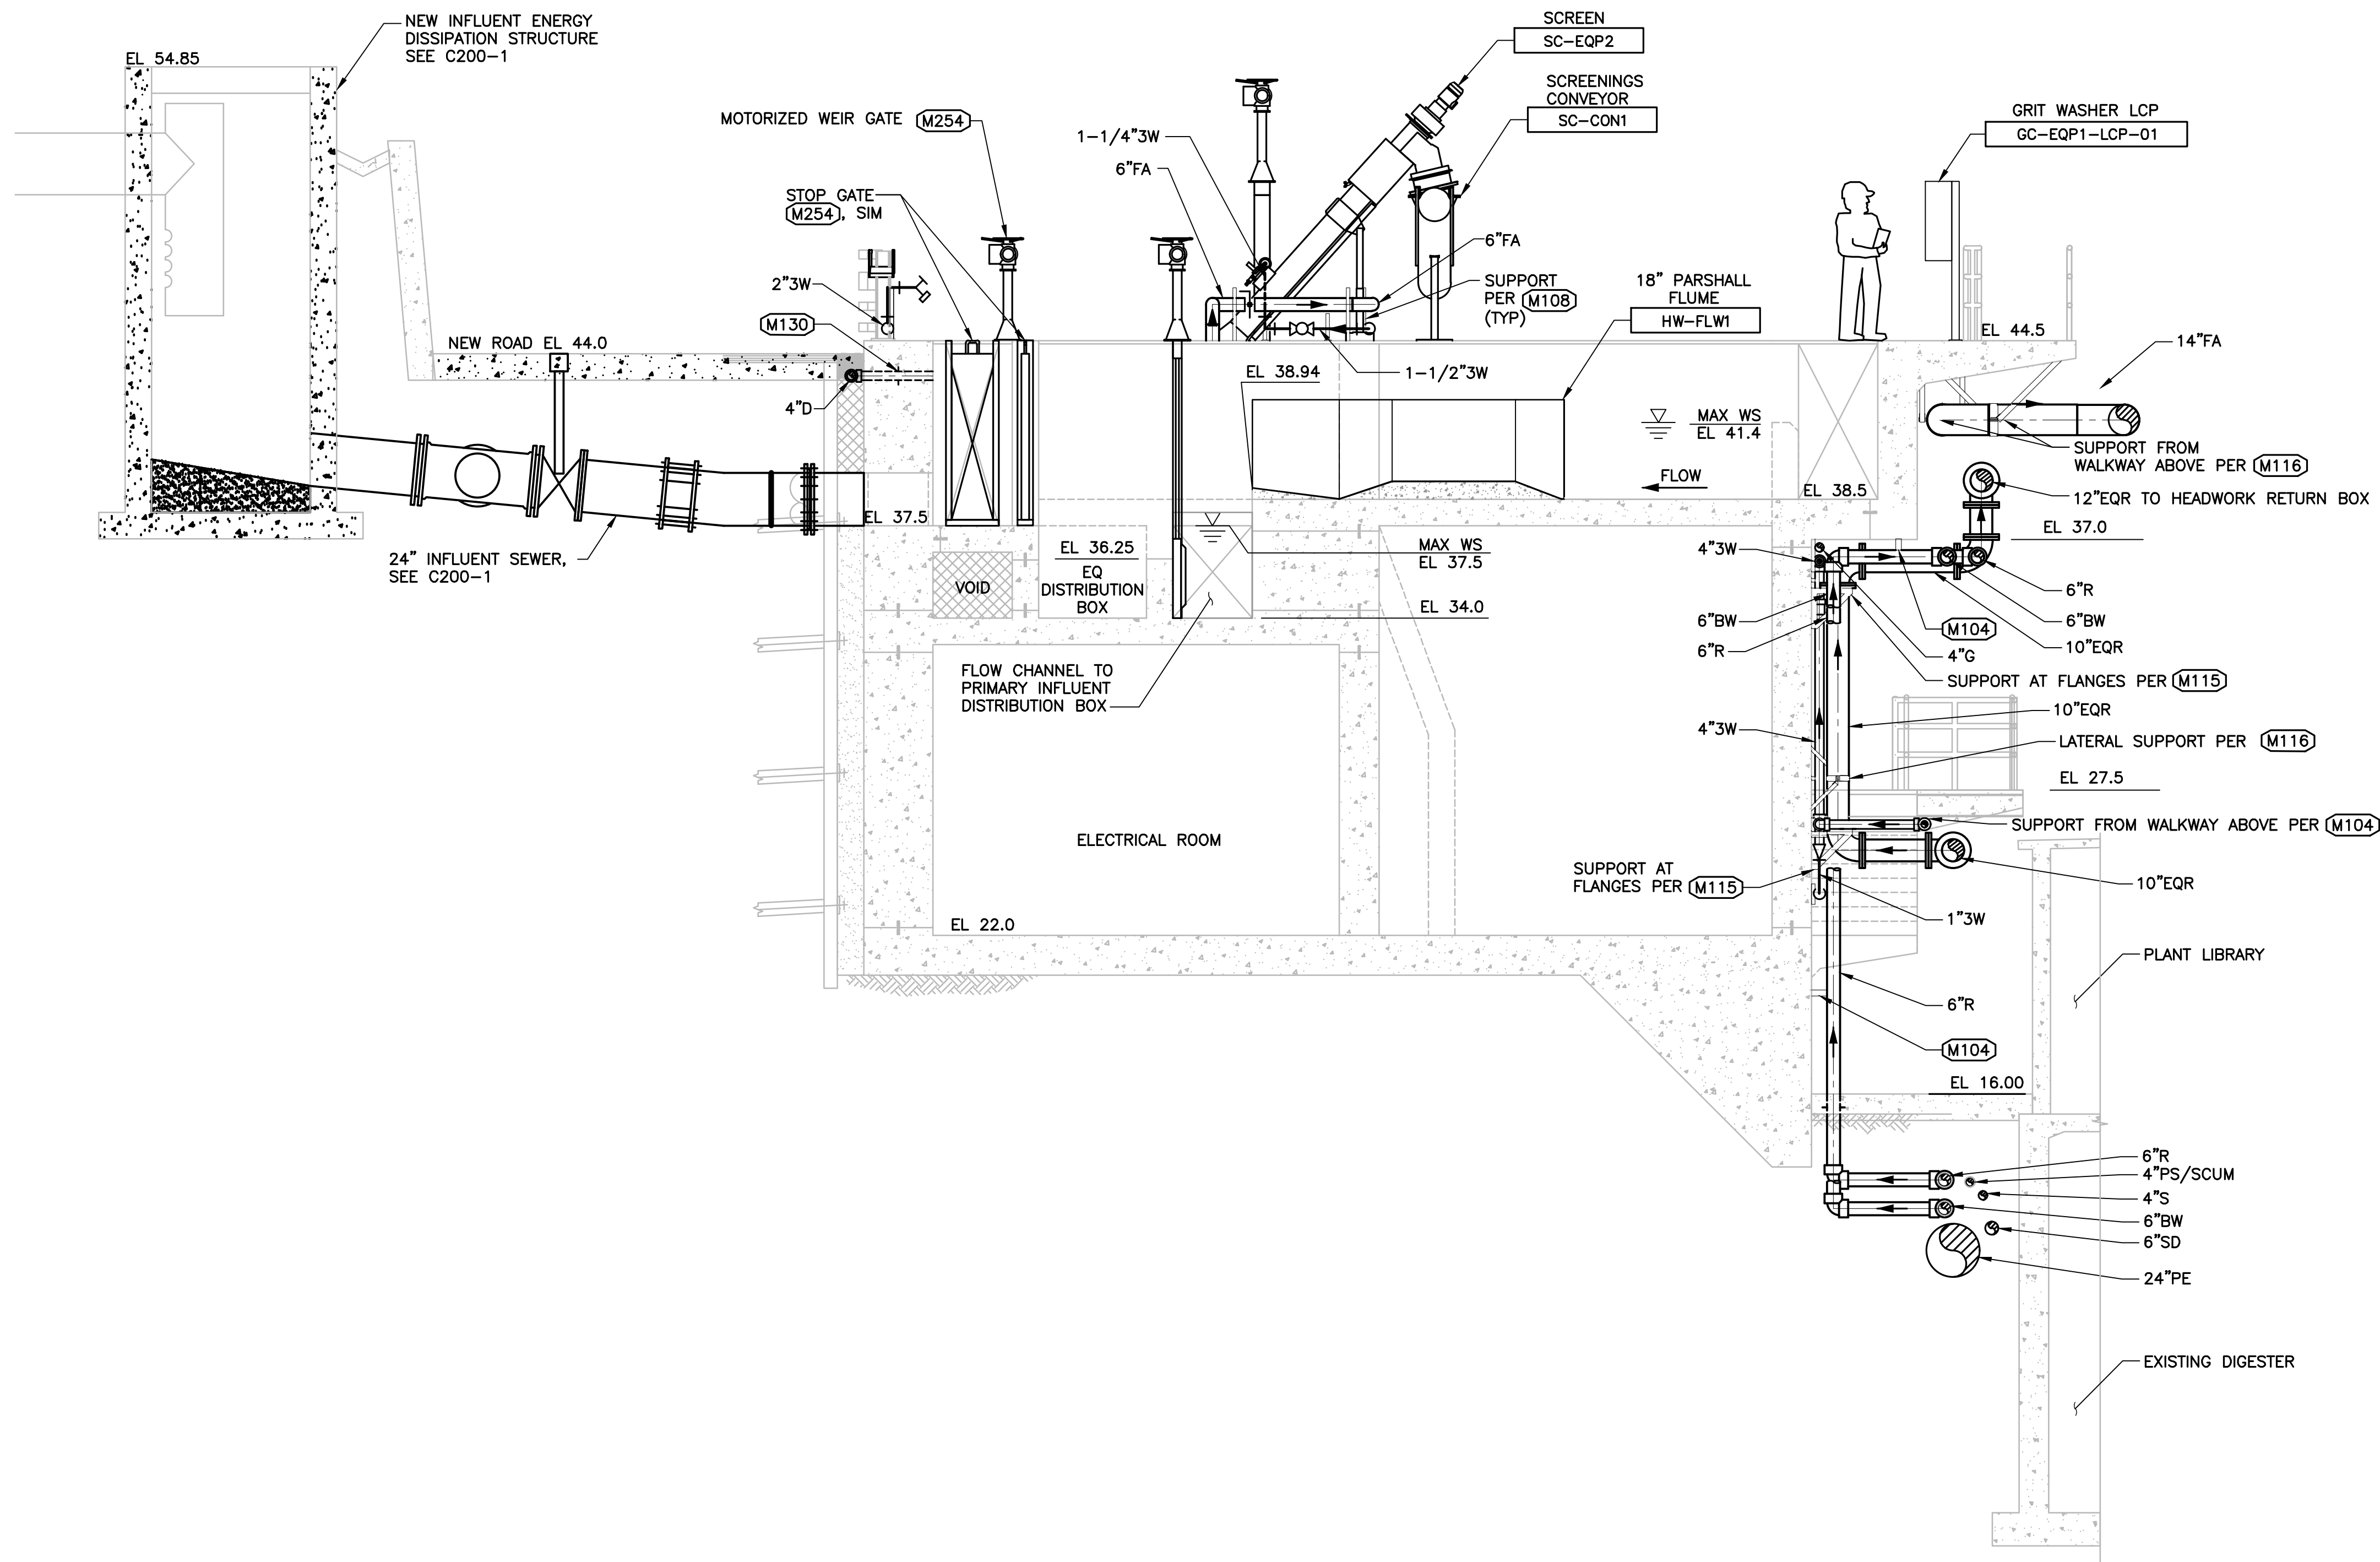

**SECTION D**  
SCALE: 1/4"=1'-0" M100-3

**RECORD DRAWING**

THIS RECORD DRAWING HAS BEEN PREPARED FROM THE ORIGINAL CONTRACT DOCUMENTS SIGNED AND SEALED BY THE RESPONSIBLE ENGINEER OF RECORD. ADDITIONAL INFORMATION HAS BEEN PROVIDED BY OTHERS TO REPRESENT AS-CONSTRUCTED CONDITION AND IS SHOWN ON THESE RECORD DRAWINGS. THE RESPONSIBLE ENGINEER OF RECORD CANNOT VERIFY THE ACCURACY OF THE AS-CONSTRUCTED CONDITION INFORMATION REPRESENTED ON THE RECORD DRAWINGS.

0" = 1" —  
VERIFY SCALES —  
BAR IS ONE INCH  
LONG ON FULL  
SIZE DRAWING.  
IF NOT ONE INCH  
LONG ON THIS  
DRAWING, ADJUST  
SCALES ACCORDINGLY



REV	DATE	BY	APVD	DESCRIPTION
▲	07/22	CT	TV	RECORD DRAWING

DESIGNED	M. TAKEMOTO
DRAWN	S. NGUYEN
CHECKED	M. NAKAMOTO

SUBMITTED:	MARK TAKEMOTO	RMC PROJECT ENGINEER	CE-64369
APPROVED:	STEVE CLARY	RMC ENGINEER	CE-30318




TREATMENT AND WET WEATHER FLOW UPGRADE  
**HEADWORKS SECTION 2**

DWG NO	M100-9
SHEET NO	132 OF 226
PROJ NO	055-006
DATE	JULY 2022



FILENAME: 0355-006-M100-11\_8-01-22 11:35am cto || XREFS || X-SACS-D-TBLK || X-HEADWORKS-SECTIONS || 0355-006-M100-5 || 0355-006-M100-2 || 0355-006-M100-3 || 0355-006-M100-4 || X-STEPPLAN || X-Topo Survey new || S-HEADWORKS-PLAN || S-HEADWORKS-SECT || X-Treatment Plant site plan |<--

NOTES:  
 1. CONTRACTOR SHALL COORDINATE AND CONFIRM ALL EQUIPMENT DIMENSIONS, CONNECTIONS, AND INSTALLATION REQUIREMENTS.  
 2. AIR RELEASE VALVES SHALL BE PROVIDED AND INSTALLED IN ACCORDANCE WITH THE PUMP MANUFACTURER'S REQUIREMENTS.

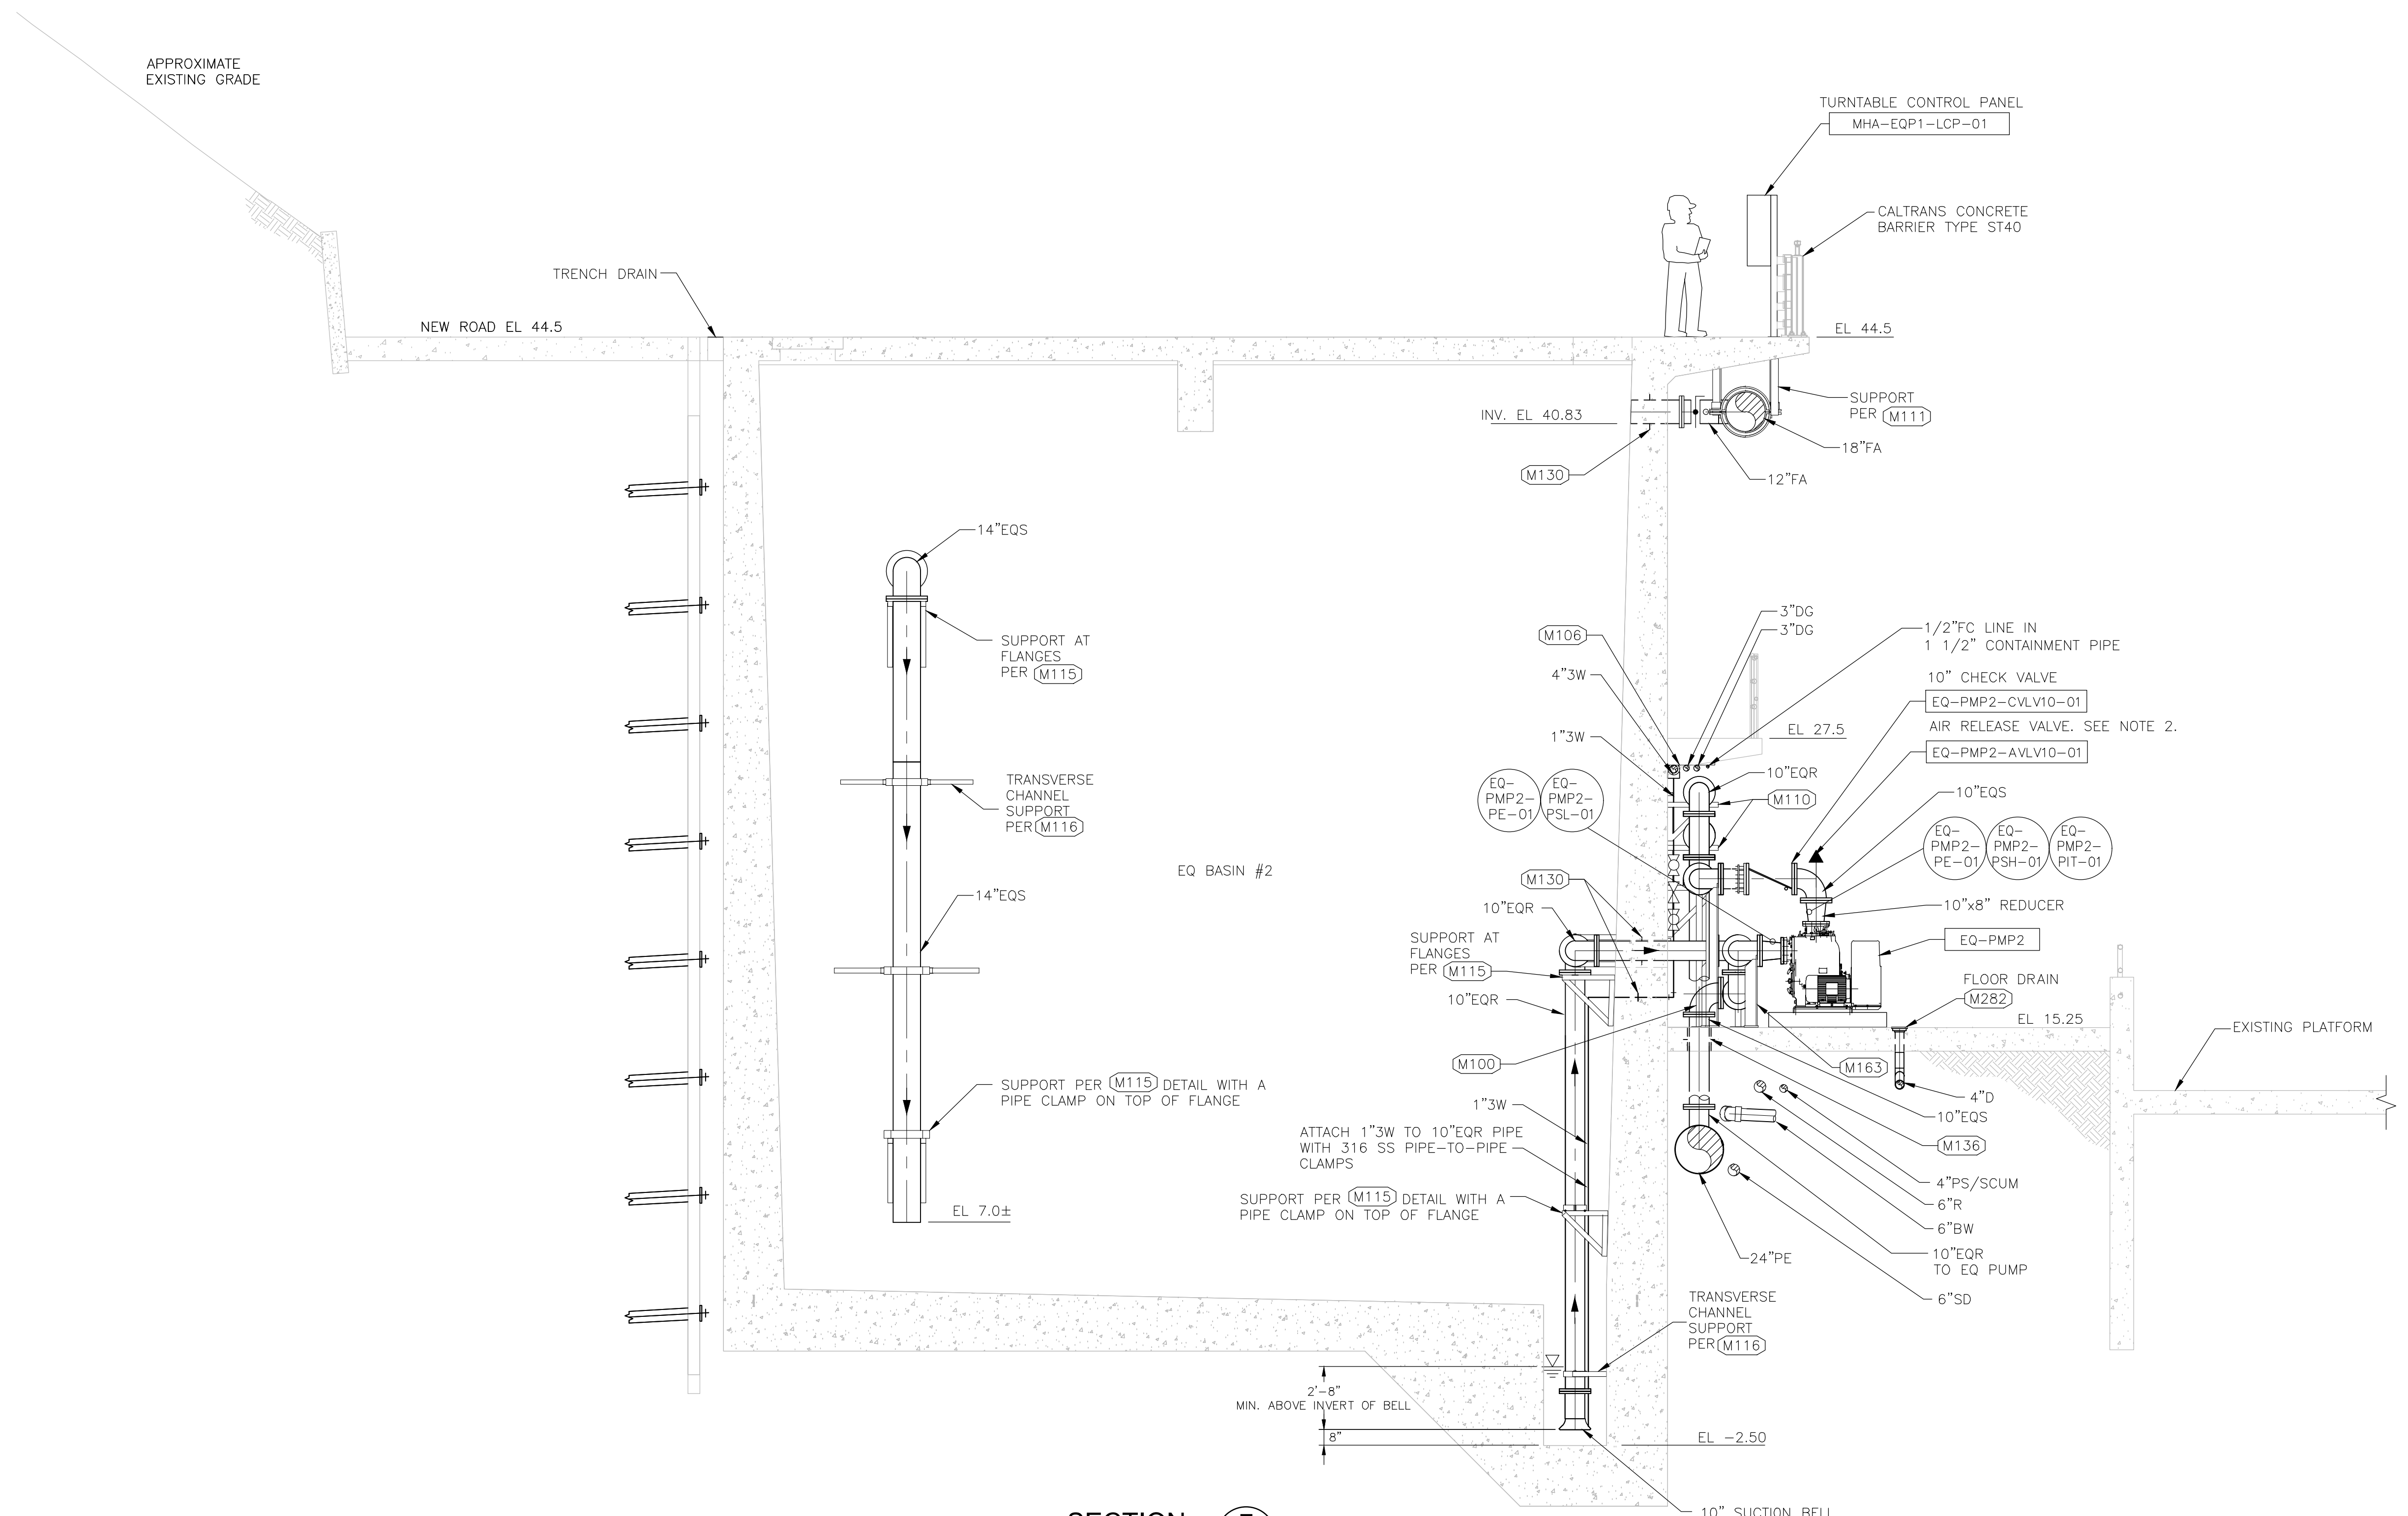

**SECTION F**  
 SCALE: 1/4"=1'-0" M100-2

**RECORD DRAWING**  
 THIS RECORD DRAWING HAS BEEN PREPARED FROM THE ORIGINAL CONTRACT DOCUMENTS SIGNED AND SEALED BY THE RESPONSIBLE ENGINEER OF RECORD. ADDITIONAL INFORMATION HAS BEEN PROVIDED BY OTHERS TO REPRESENT AS-CONSTRUCTED CONDITION AND IS SHOWN ON THESE RECORD DRAWINGS. THE RESPONSIBLE ENGINEER OF RECORD CANNOT VERIFY THE ACCURACY OF THE AS-CONSTRUCTED CONDITION INFORMATION REPRESENTED ON THE RECORD DRAWINGS.

0" = 1"  
 VERIFY SCALES —  
 BAR IS ONE INCH  
 LONG ON FULL  
 SIZE DRAWING.  
 IF NOT ONE INCH  
 LONG ON THIS  
 DRAWING, ADJUST  
 SCALES ACCORDINGLY



REV	DATE	BY	APVD	DESCRIPTION
▲				
▲				
▲	07/22	CT	TV	RECORD DRAWING


DESIGNED	M. TAKEMOTO	SUBMITTED	MARK TAKEMOTO
DRAWN	S. NGUYEN		RMC PROJECT ENGINEER CE-64369
CHECKED	M. NAKAMOTO	APPROVED:	STEVE CLARY
			RMC ENGINEER CE-30318



TREATMENT AND WET WEATHER FLOW UPGRADE  
**HEADWORKS SECTION 4**

DWG NO	M100-11
SHEET NO	134 OF 226
PROJ NO	055-006
DATE	JULY 2022

FILENAME: 0055-006-M100-12 8-01-22 11:36am cto || REFERENCE: X-SMCSO-TBLK X-Headworks Sections | 0055-006-M100-5 | 0055-006-M100-2 | 0055-006-M100-3 | 0055-006-M100-4 | X-Station | X-Topo Survey new | S-HEADWORKS-PLAN | S-HEADWORKS-SECT | X-Treatment Plant Site plan | CC-

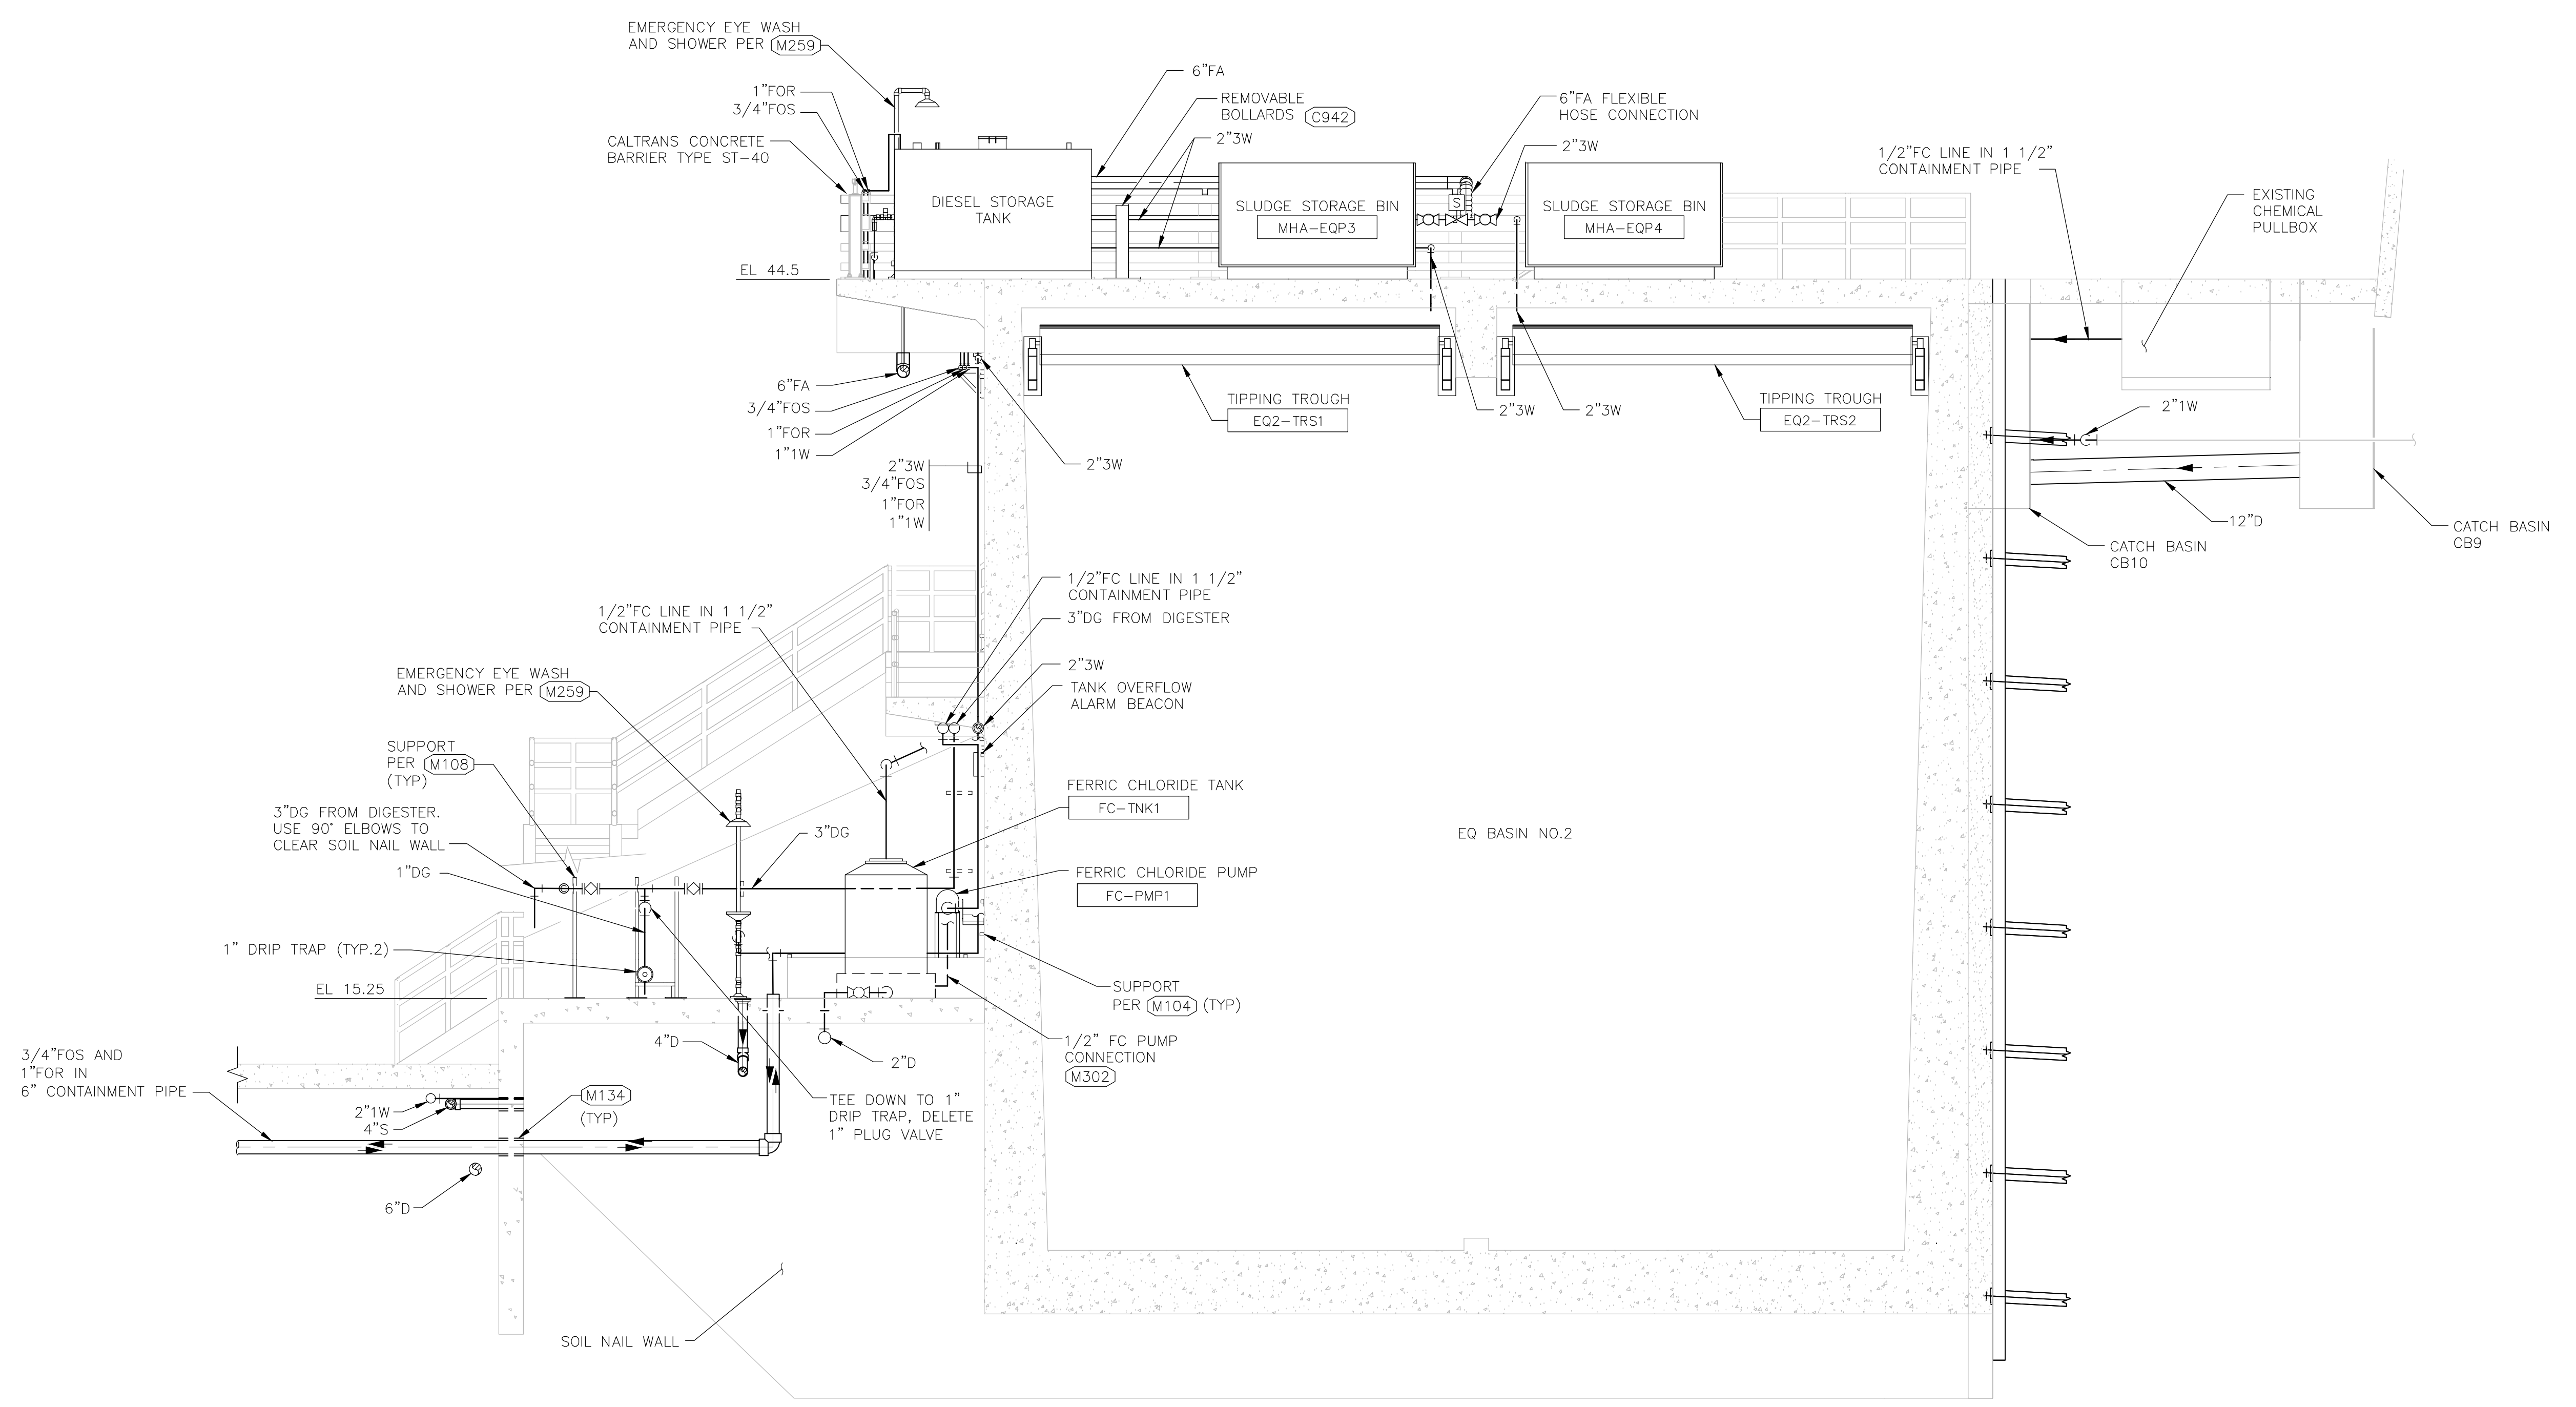

**SECTION G**  
SCALE: 1/4"=1'-0" M100-2

**RECORD DRAWING**

THIS RECORD DRAWING HAS BEEN PREPARED FROM THE ORIGINAL CONTRACT DOCUMENTS SIGNED AND SEALED BY THE RESPONSIBLE ENGINEER OF RECORD. ADDITIONAL INFORMATION HAS BEEN PROVIDED BY OTHERS TO REPRESENT AS-CONSTRUCTED CONDITION AND IS SHOWN ON THESE RECORD DRAWINGS. THE RESPONSIBLE ENGINEER OF RECORD CANNOT VERIFY THE ACCURACY OF THE AS-CONSTRUCTED CONDITION INFORMATION REPRESENTED ON THE RECORD DRAWINGS.

0" = 1"  
VERIFY SCALES —  
BAR IS ONE INCH  
LONG ON FULL  
SIZE DRAWING.  
IF NOT ONE INCH  
LONG ON THIS  
DRAWING, ADJUST  
SCALES ACCORDINGLY



REV	DATE	BY	APVD	DESCRIPTION
▲				
▲				
▲				
▲	07/22	CT	TV	RECORD DRAWING

DESIGNED	M. TAKEMOTO
DRAWN	S. NGUYEN
CHECKED	M. NAKAMOTO

SUBMITTED:	MARK TAKEMOTO	RMC PROJECT ENGINEER	CE-64369
APPROVED:	STEVE CLARY	RMC ENGINEER	CE-30318




TREATMENT AND WET WEATHER FLOW UPGRADE  
**HEADWORKS SECTION 5**

DWG NO	M100-12
SHEET NO	135 OF 226
PROJ NO	055-006
DATE	JULY 2022

FILENAME: 0055-006-M100-13\_8-01-22 11:37am cto || REF: X-SMSD-TBLK | X-Headworks Sections | 0055-006-M100-5 | 0055-006-M100-2 | 0055-006-M100-3 | 0055-006-M100-4 | X-Station | X-Topo Survey new | S-HEADWORKS-SEC | SFC Topo Rev041813 | Structural | X-Treatment Plant site plan

- NOTES:
1. CONTRACTOR SHALL VERIFY LOCATION IN FIELD.
  2. CONTRACTOR SHALL COORDINATE PIPE LOCATION AND ALIGNMENT WITH EXISTING UTILITIES AND THE SOIL NAIL WALL TO AVOID ANY CONFLICTS.

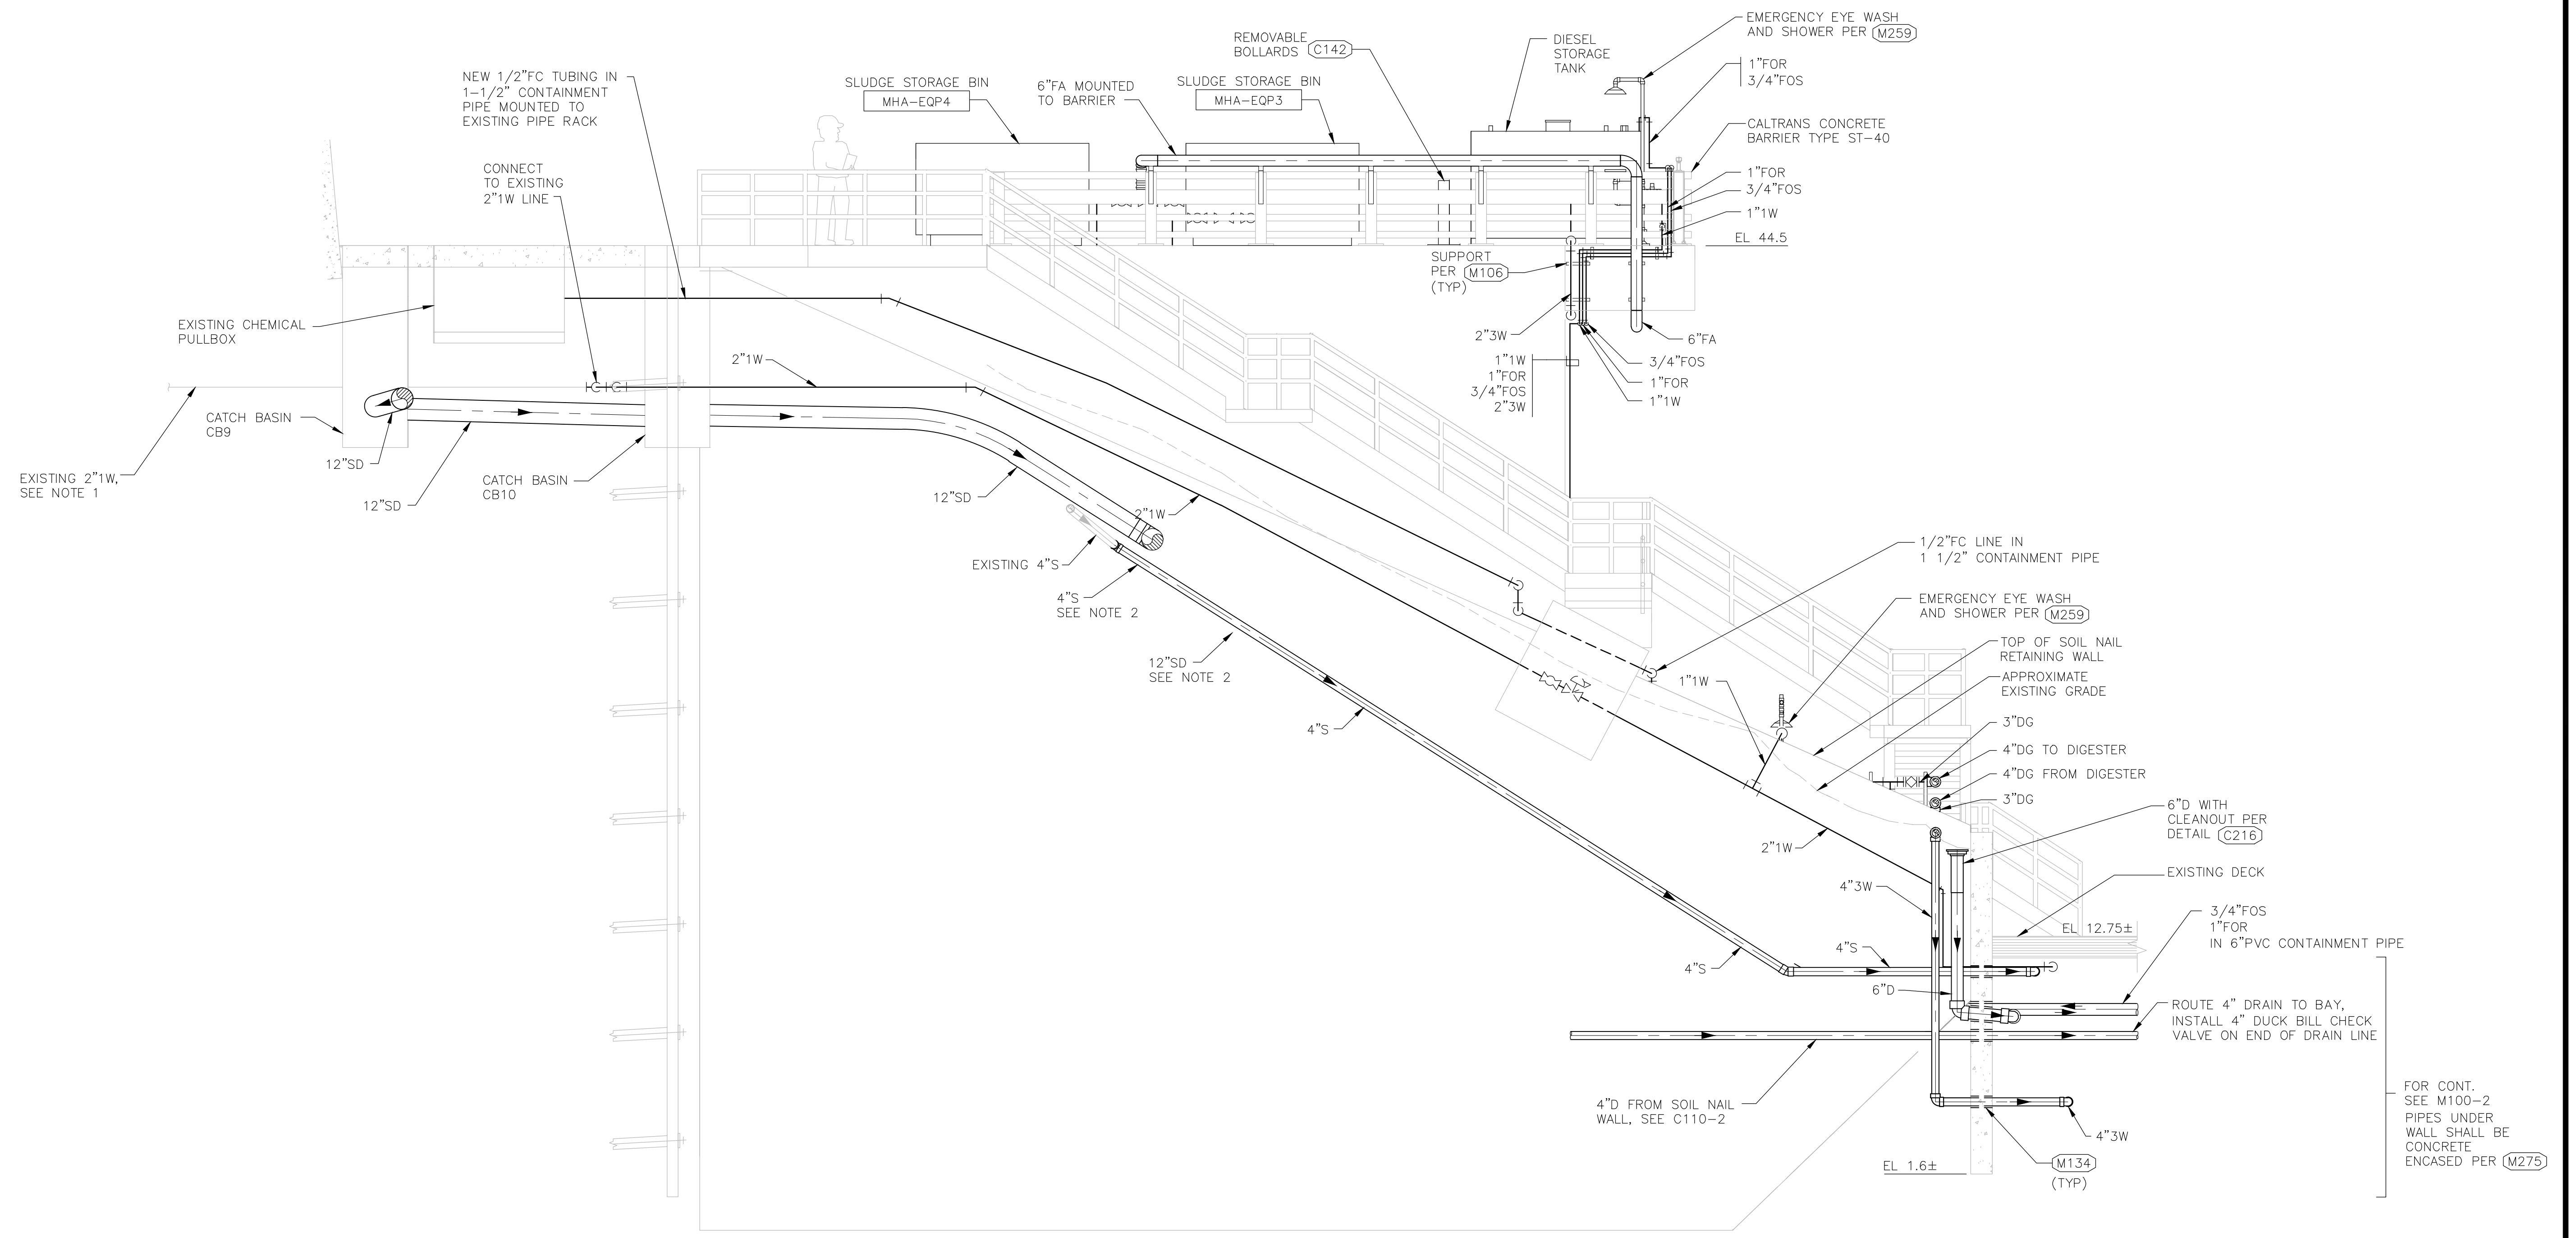

SECTION **H**  
SCALE: 1/4"=1'-0" M100-2

**RECORD DRAWING**  
THIS RECORD DRAWING HAS BEEN PREPARED FROM THE ORIGINAL CONTRACT DOCUMENTS SIGNED AND SEALED BY THE RESPONSIBLE ENGINEER OF RECORD. ADDITIONAL INFORMATION HAS BEEN PROVIDED BY OTHERS TO REPRESENT AS-CONSTRUCTED CONDITION AND IS SHOWN ON THESE RECORD DRAWINGS. THE RESPONSIBLE ENGINEER OF RECORD CANNOT VERIFY THE ACCURACY OF THE AS-CONSTRUCTED CONDITION INFORMATION REPRESENTED ON THE RECORD DRAWINGS.

0" = 1"  
VERIFY SCALES —  
BAR IS ONE INCH  
LONG ON FULL  
SIZE DRAWING.  
IF NOT ONE INCH  
LONG ON THIS  
DRAWING, ADJUST  
SCALES ACCORDINGLY



REV	DATE	BY	APVD	DESCRIPTION
▲	07/22	CT	TV	RECORD DRAWING

DESIGNED M. TAKEMOTO  
DRAWN S. NGUYEN  
CHECKED M. NAKAMOTO


SUBMITTED: MARK TAKEMOTO  
RMC PROJECT ENGINEER CE-64369  
APPROVED: STEVE CLARY  
RMC ENGINEER CE-30318



TREATMENT AND WET WEATHER FLOW UPGRADE  
**HEADWORKS SECTION 6**

DWG NO M100-13  
SHEET NO 136 OF 226  
PROJ NO 055-006  
DATE JULY 2022

FILENAME: 0055-006-M100-14\_8-01-22 11:37am cto || XREFS: X-SMCSO-TBLK X-Headworks Sections || 0055-006-M100-5 || 0055-006-M100-2 || 0055-006-M100-3 || 0055-006-M100-4 || X-Station || X-Topo Survey new || S-HEADWORKS-SEC || X-Treatment Plant site plan kcs--

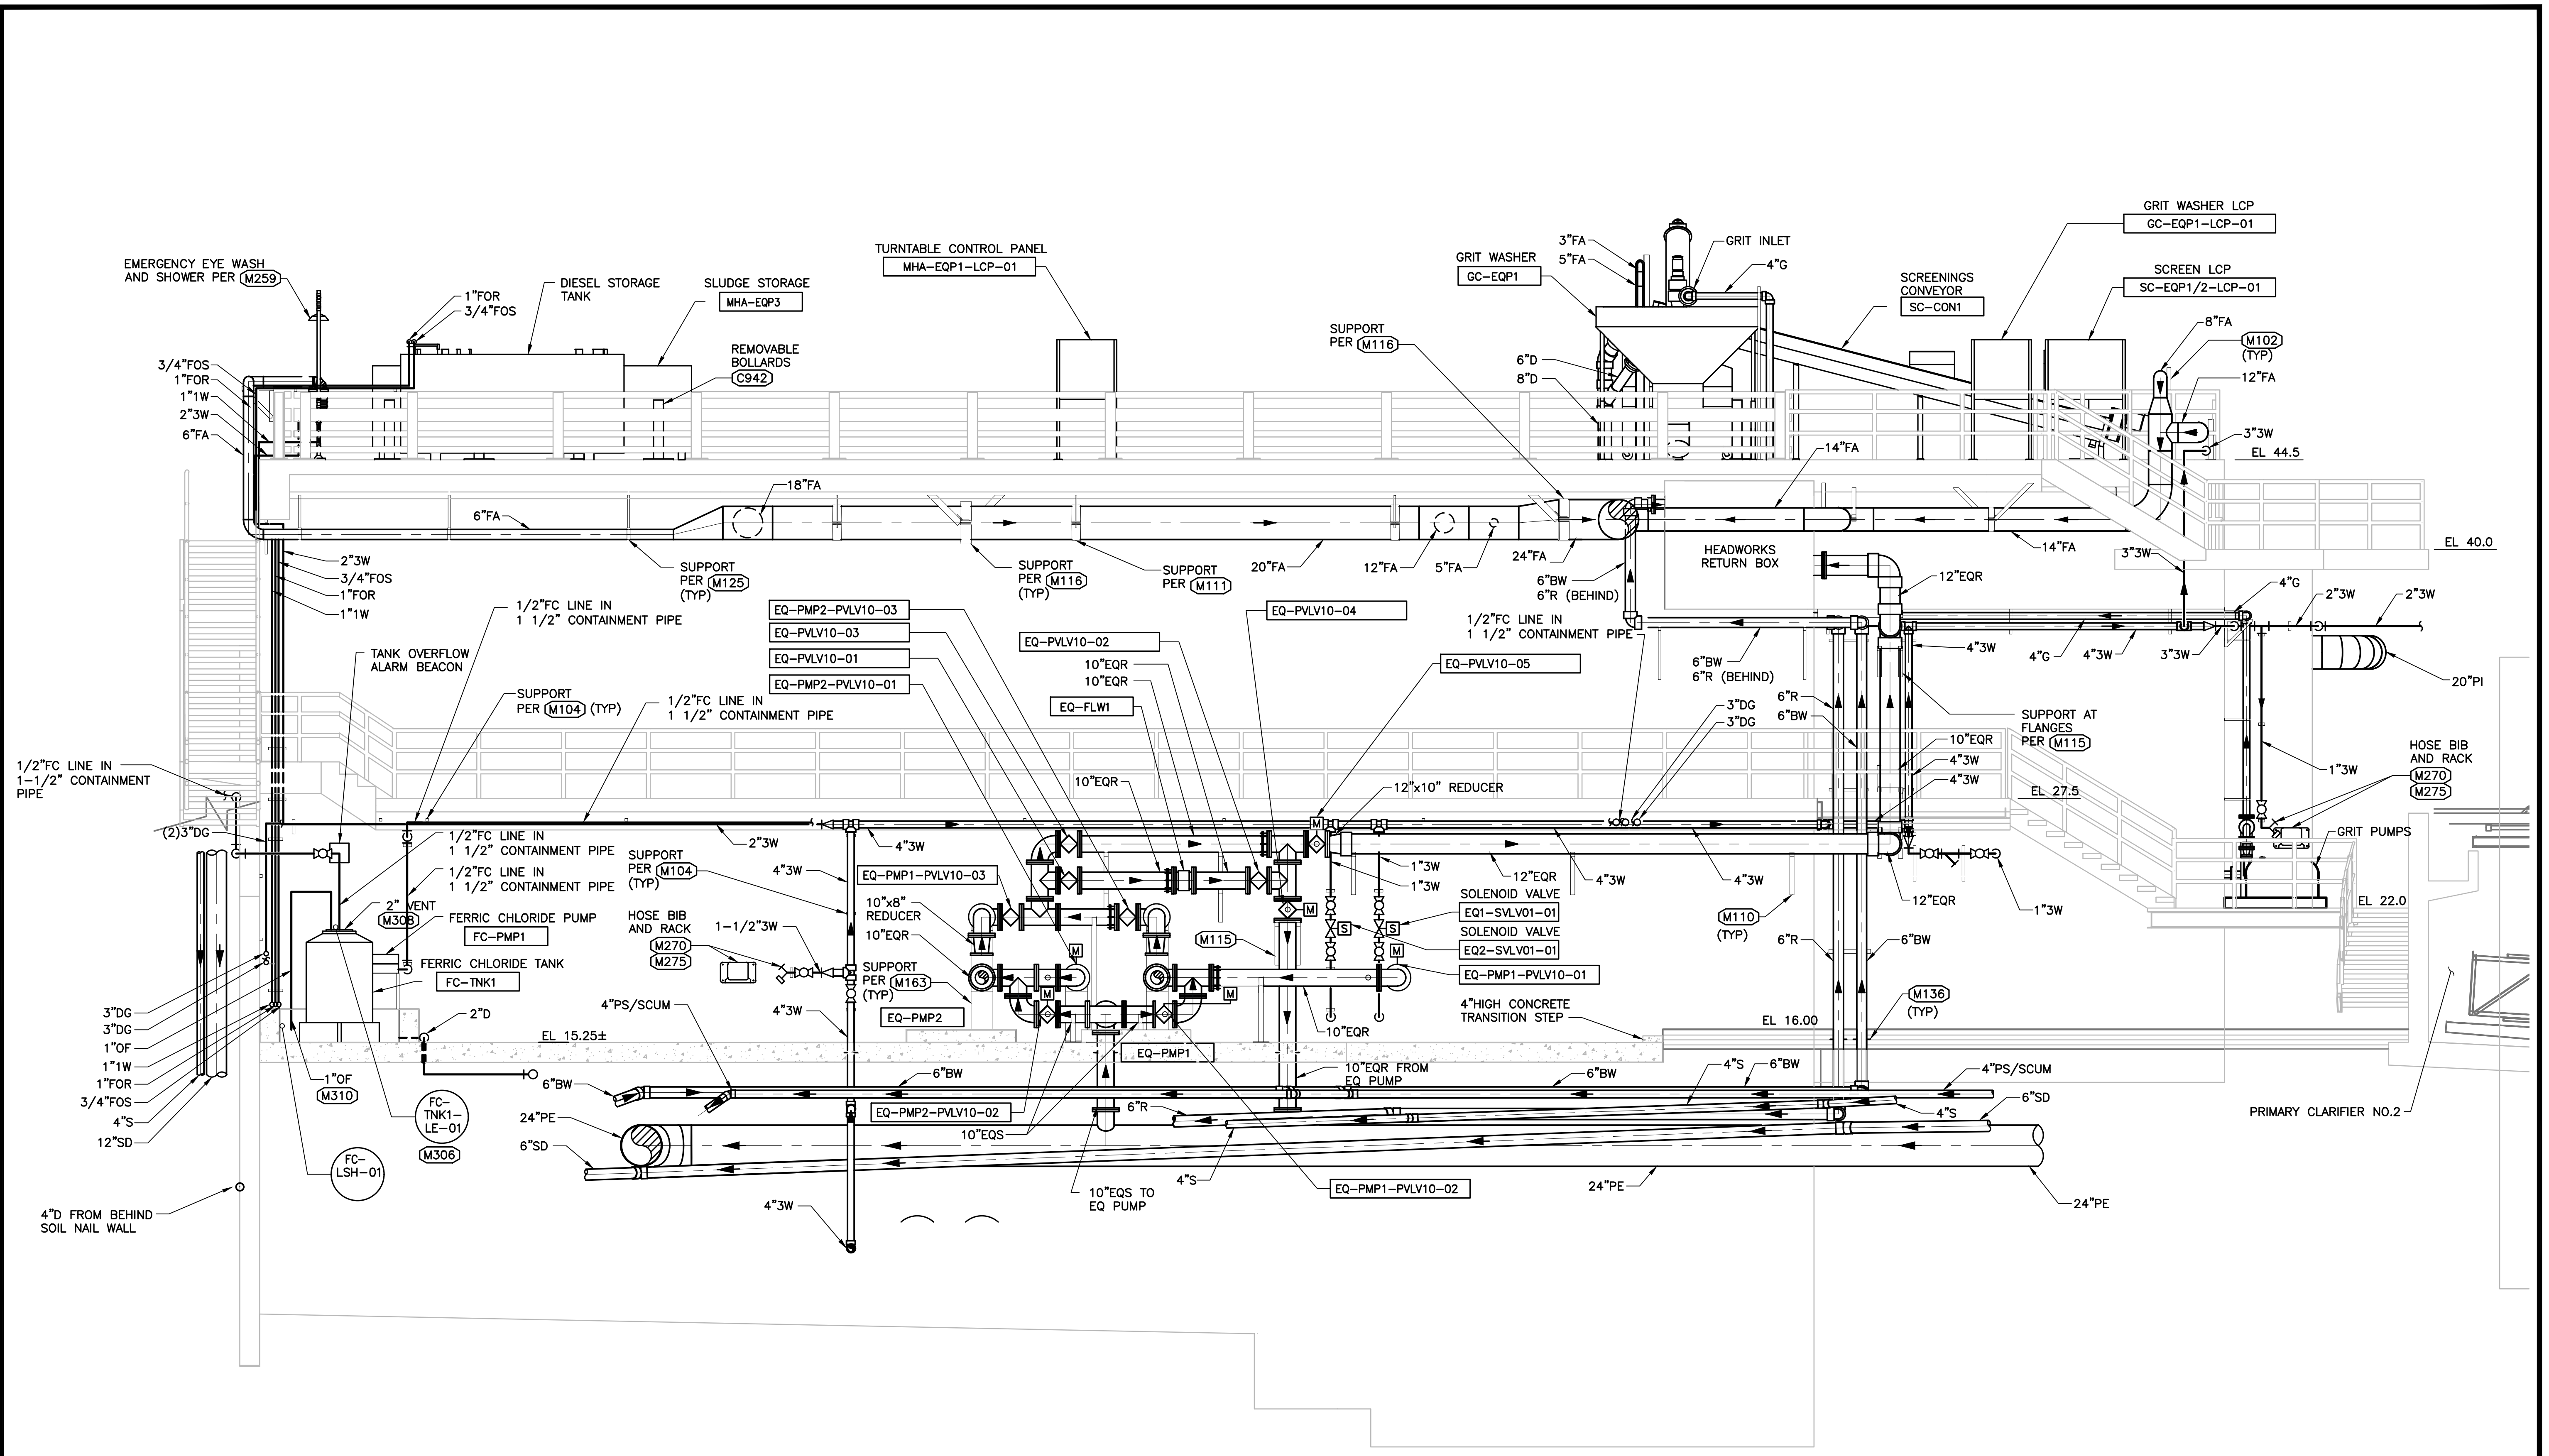

SECTION 1  
SCALE: 1/4"=1'-0" M100-1

**RECORD DRAWING**  
 THIS RECORD DRAWING HAS BEEN PREPARED FROM THE ORIGINAL CONTRACT DOCUMENTS SIGNED AND SEALED BY THE RESPONSIBLE ENGINEER OF RECORD. ADDITIONAL INFORMATION HAS BEEN PROVIDED BY OTHERS TO REPRESENT AS-CONSTRUCTED CONDITION AND IS SHOWN ON THESE RECORD DRAWINGS. THE RESPONSIBLE ENGINEER OF RECORD CANNOT VERIFY THE ACCURACY OF THE AS-CONSTRUCTED CONDITION INFORMATION REPRESENTED ON THE RECORD DRAWINGS.

0" = 1"  
 VERIFY SCALES — BAR IS ONE INCH LONG ON FULL SIZE DRAWING. IF NOT ONE INCH LONG ON THIS DRAWING, ADJUST SCALES ACCORDINGLY



REV	DATE	BY	APVD	DESCRIPTION
▲	07/22	CT	TV	RECORD DRAWING


DESIGNED	M. TAKEMOTO	SUBMITTED	MARK TAKEMOTO
DRAWN	S. NGUYEN		RMC PROJECT ENGINEER CE-64369
CHECKED	M. NAKAMOTO	APPROVED:	STEVE CLARY
			RMC ENGINEER CE-30318




TREATMENT AND WET WEATHER FLOW UPGRADE  
**HEADWORKS SECTION 7**

DWG NO	M100-14
SHEET NO	137 OF 226
PROJ NO	055-006
DATE	JULY 2022

FILENAME: 0055-008-M100-15 8-01-22 11:35am cto XREFS: X-SMCSO-TBLK X-Headworks Sections 0055-008-M100-5 0055-008-M100-2 0055-008-M100-3 0055-008-M100-4 X-Station X-Topo Survey new X-HEADWORKS-SEC X-Treatment Plant site plan X-

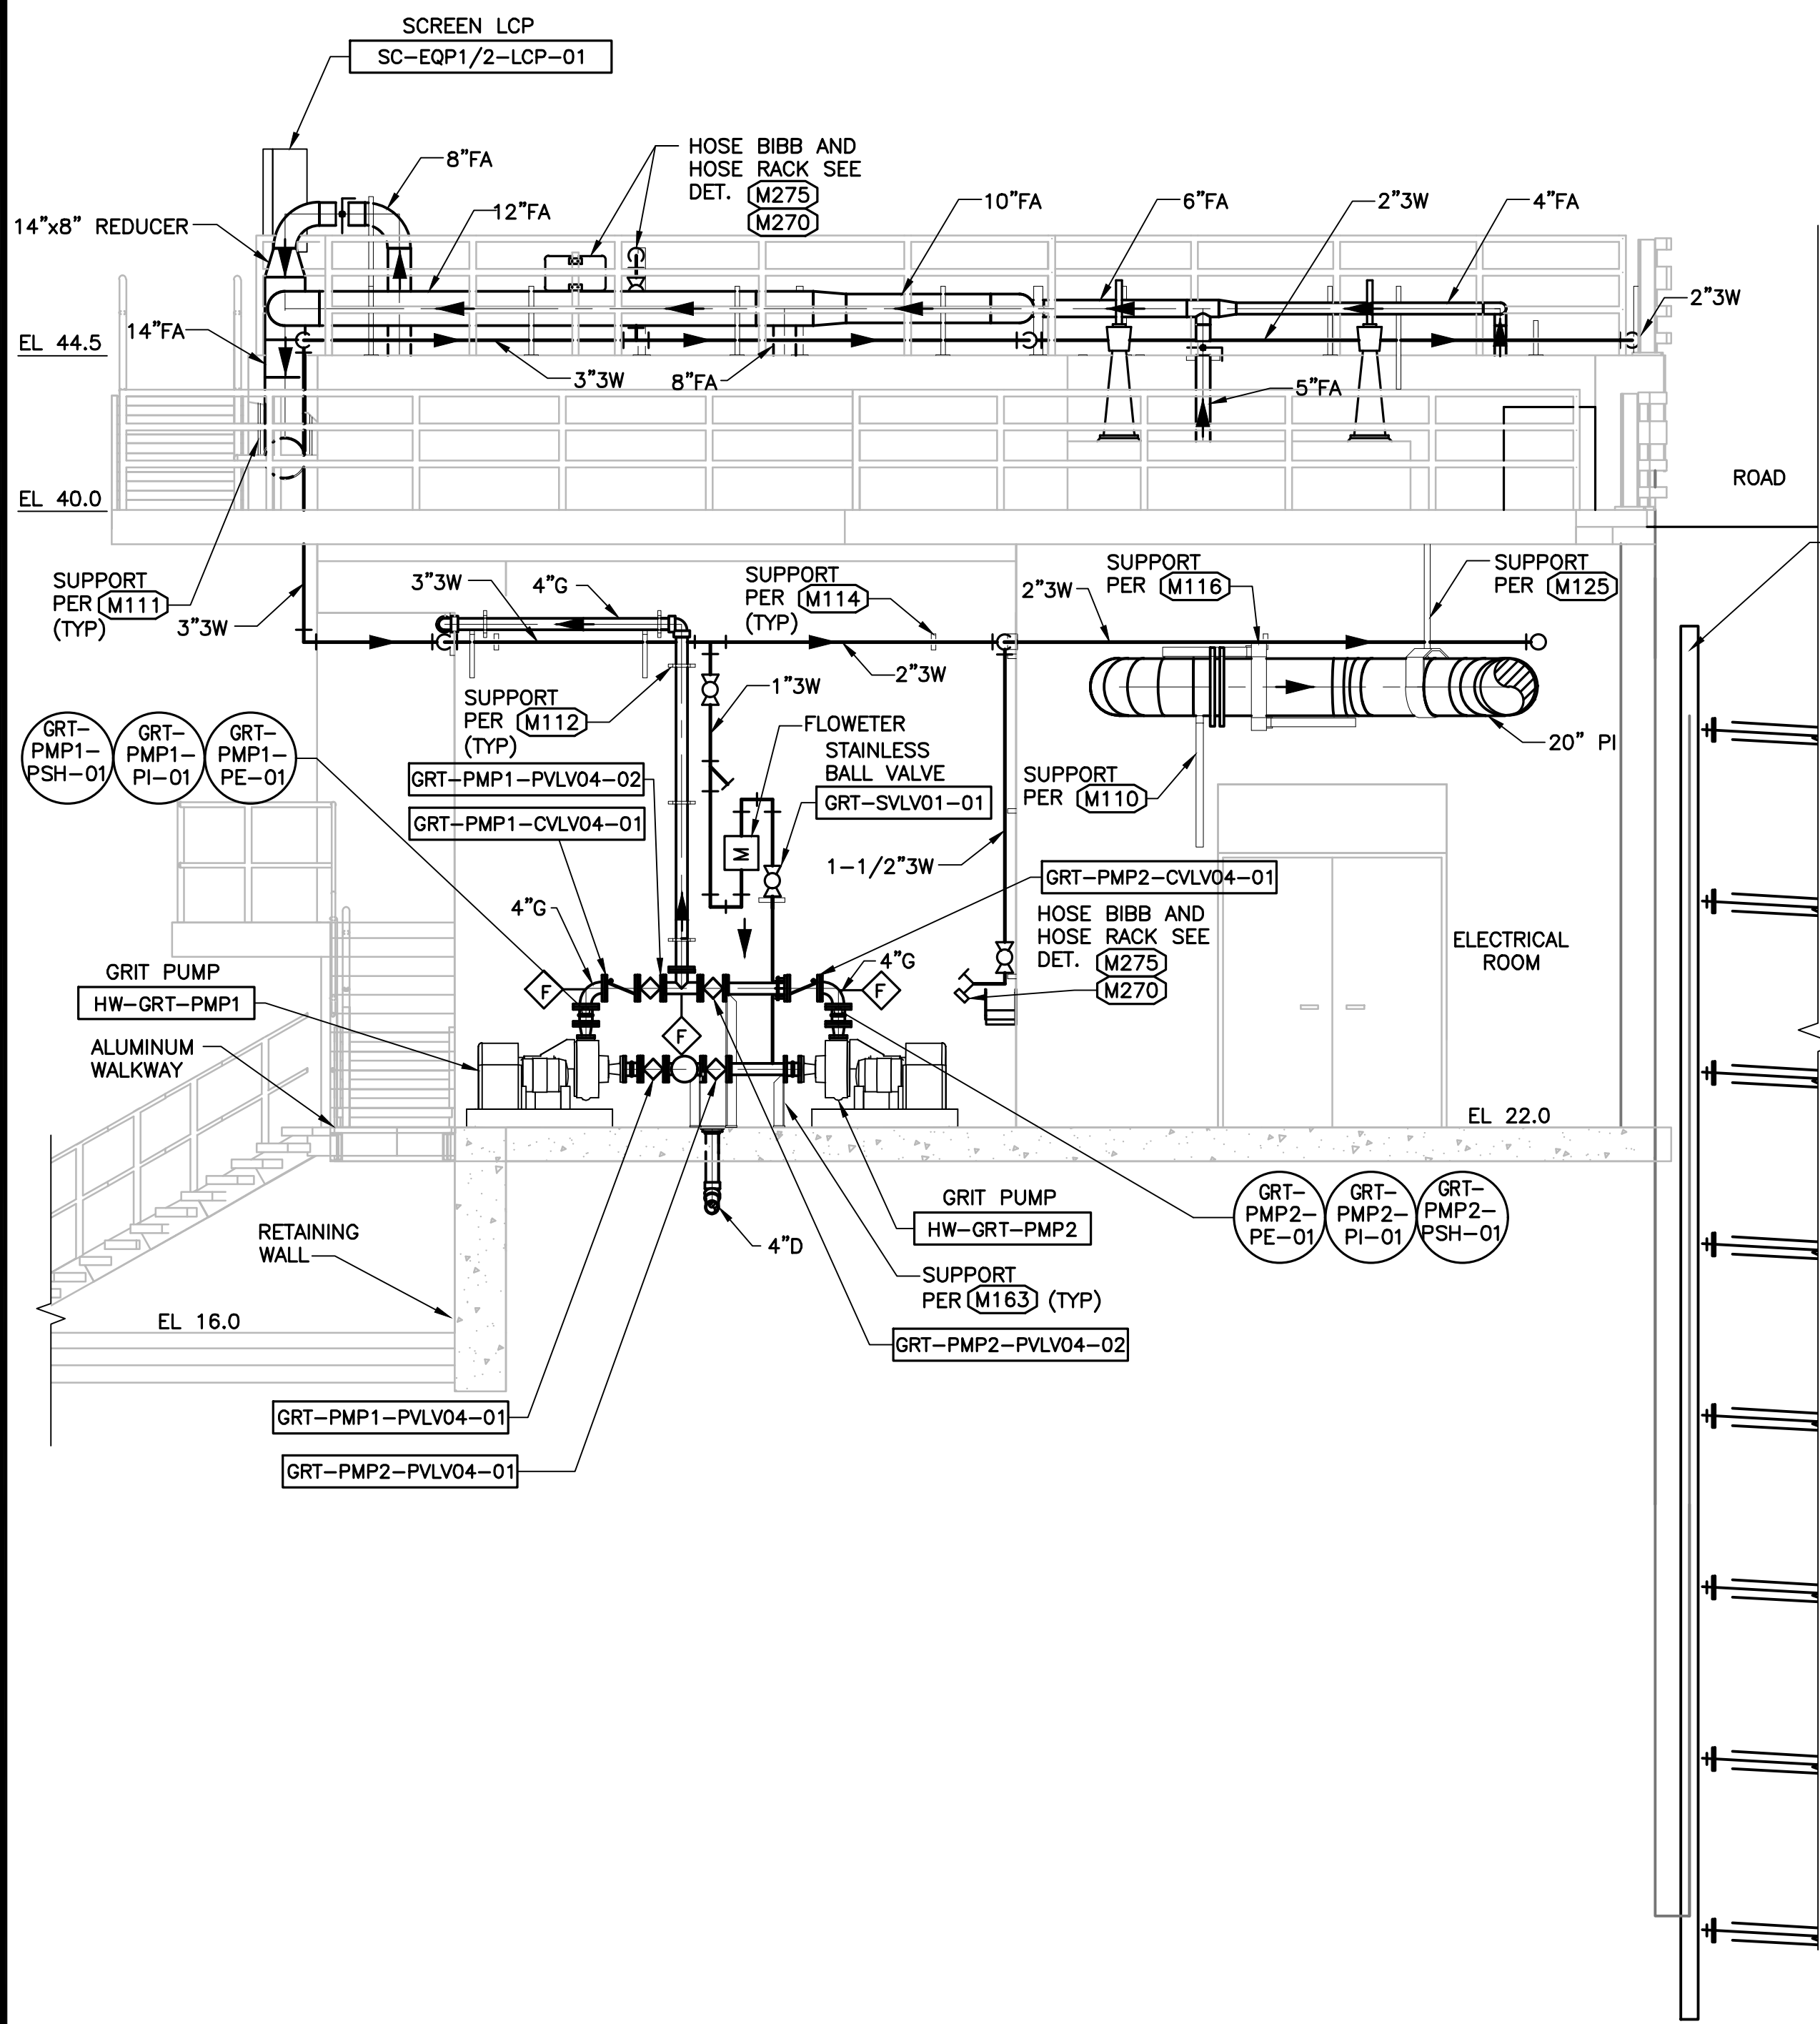

SECTION J  
SCALE: 1/4"=1'-0" M100-3

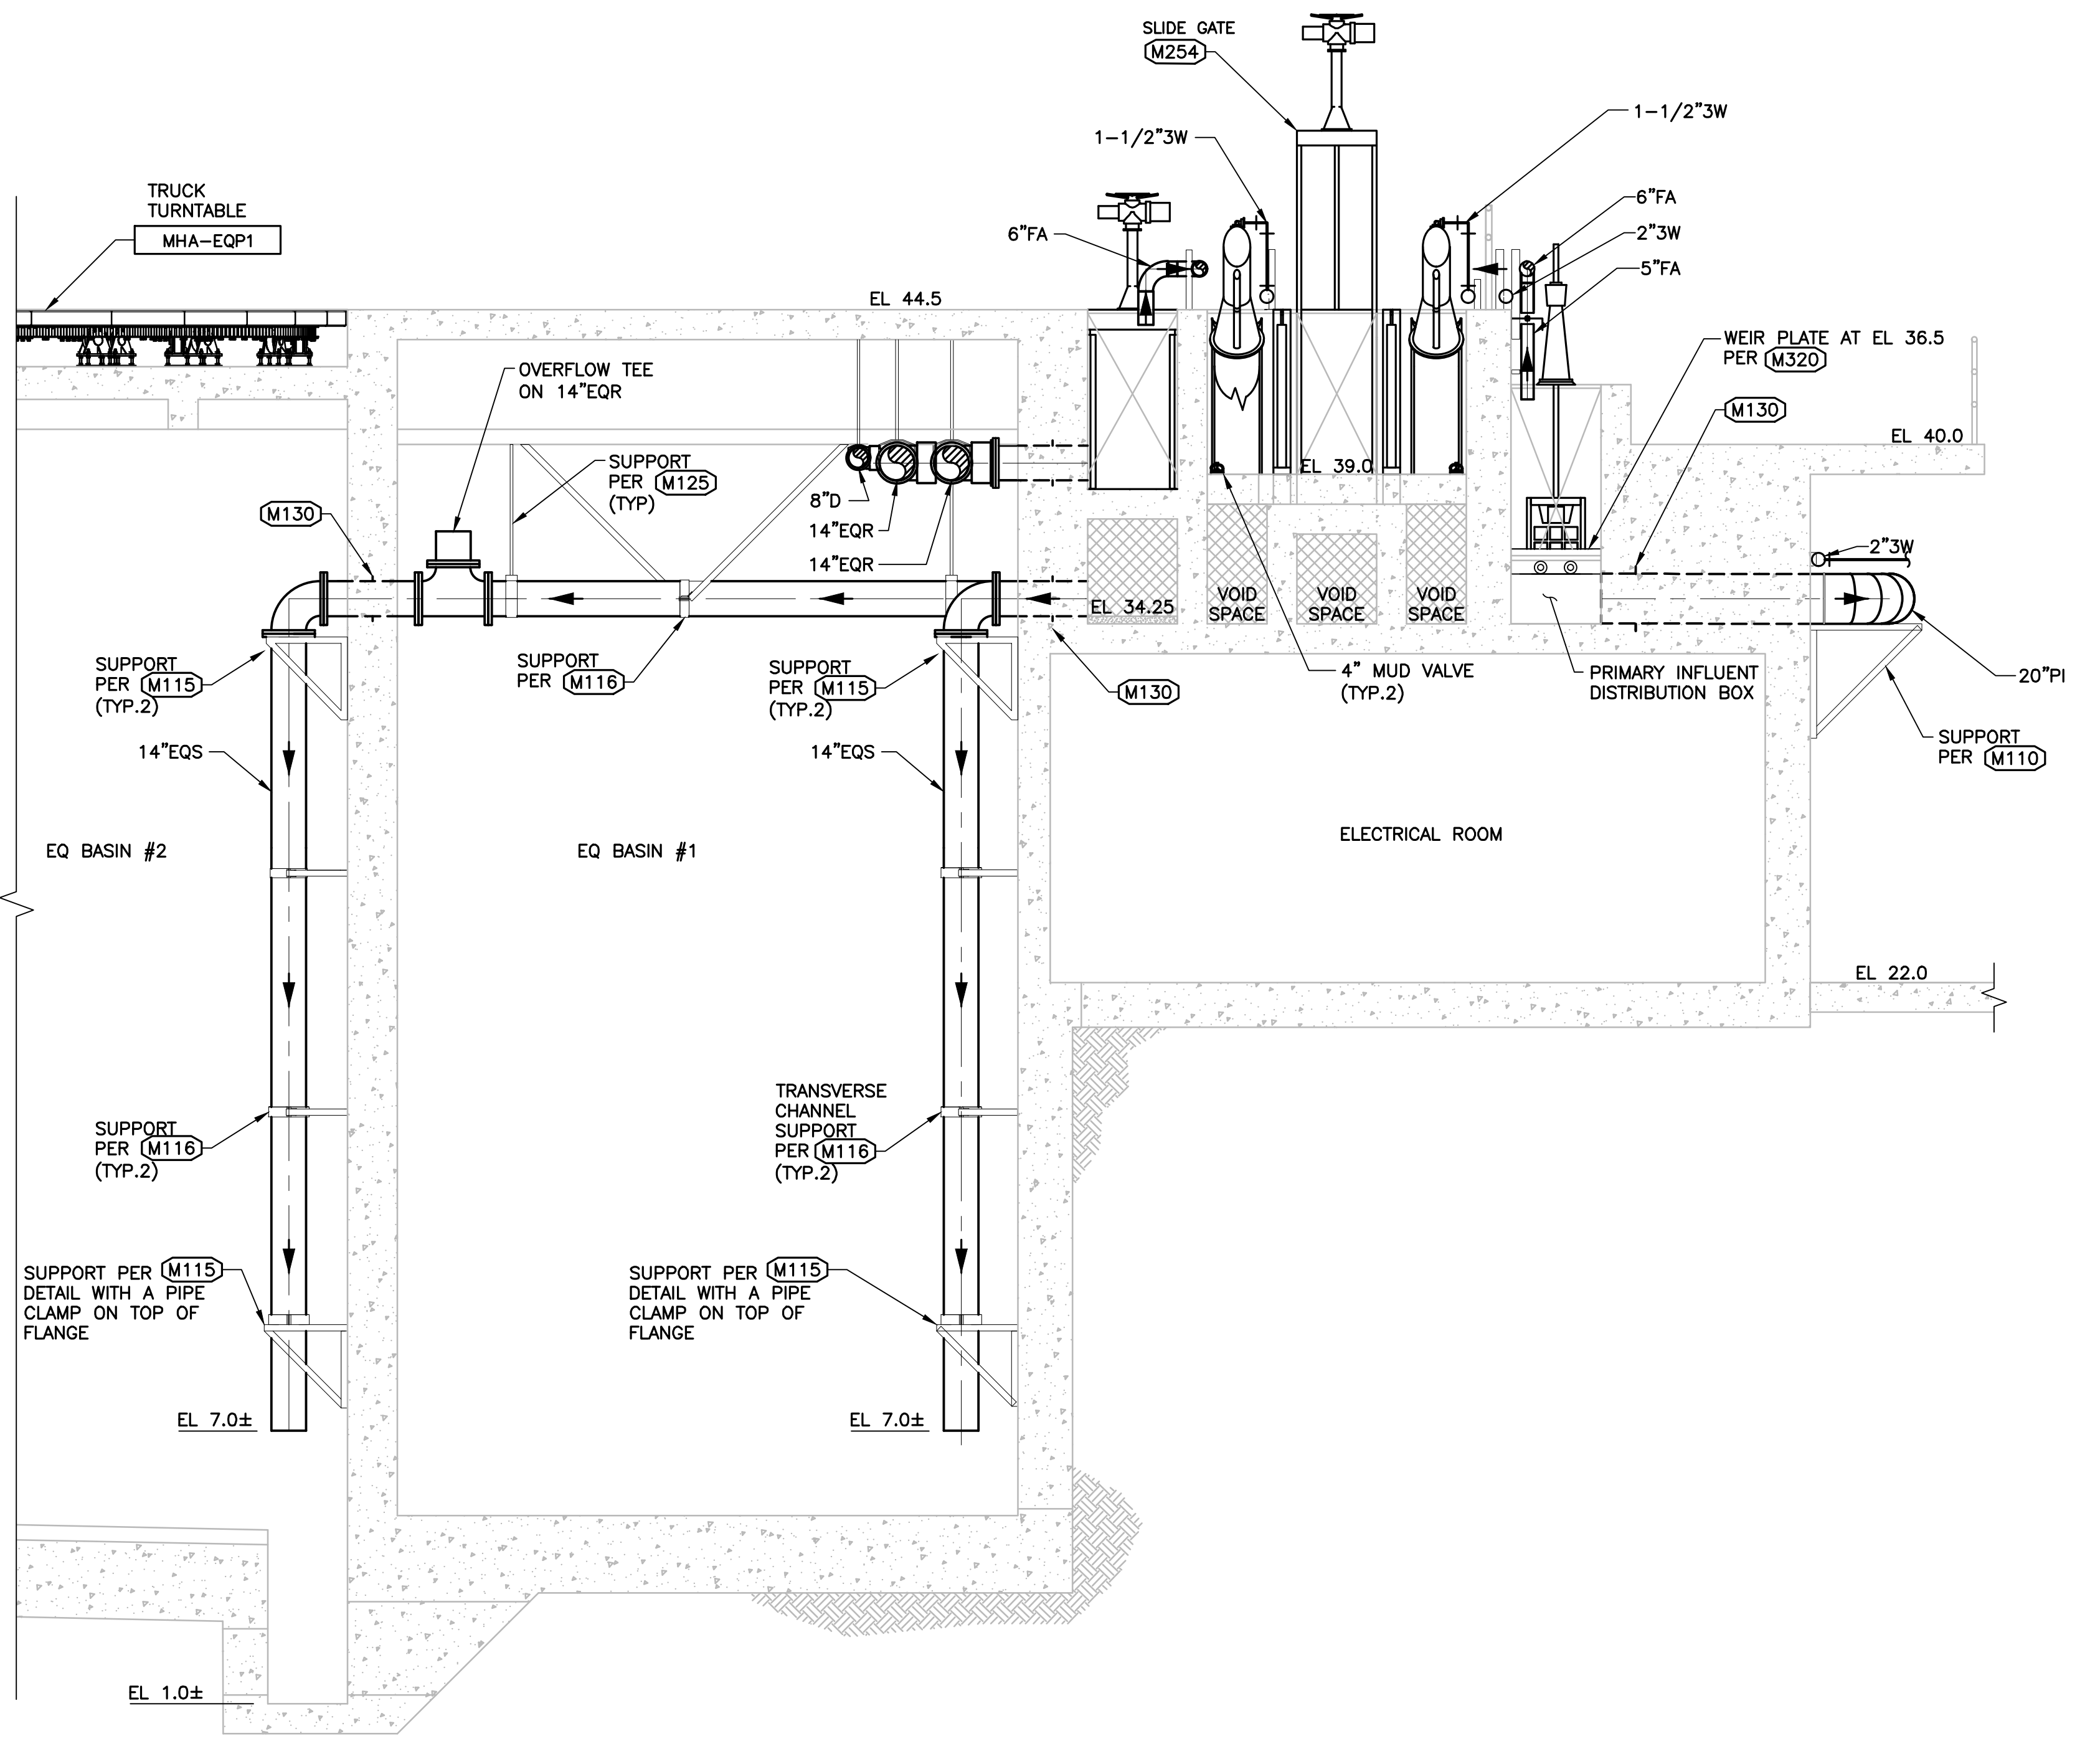

SECTION K  
SCALE: 1/4"=1'-0" M100-3

**RECORD DRAWING**  
 THIS RECORD DRAWING HAS BEEN PREPARED FROM THE ORIGINAL CONTRACT DOCUMENTS SIGNED AND SEALED BY THE RESPONSIBLE ENGINEER OF RECORD. ADDITIONAL INFORMATION HAS BEEN PROVIDED BY OTHERS TO REPRESENT AS-CONSTRUCTED CONDITION AND IS SHOWN ON THESE RECORD DRAWINGS. THE RESPONSIBLE ENGINEER OF RECORD CANNOT VERIFY THE ACCURACY OF THE AS-CONSTRUCTED CONDITION INFORMATION REPRESENTED ON THE RECORD DRAWINGS.


0" = 1"  
 VERIFY SCALES —  
 BAR IS ONE INCH  
 LONG ON FULL  
 SIZE DRAWING.  
 IF NOT ONE INCH  
 LONG ON THIS  
 DRAWING, ADJUST  
 SCALES ACCORDINGLY



REV	DATE	BY	APVD	DESCRIPTION
1	07/22	CT	TV	RECORD DRAWING

DESIGNED M. TAKEMOTO  
 DRAWN S. NGUYEN  
 CHECKED M. NAKAMOTO

SUBMITTED: MARK TAKEMOTO  
 RMC PROJECT ENGINEER CE-64369  
 APPROVED: STEVE CLARY  
 RMC ENGINEER CE-30318

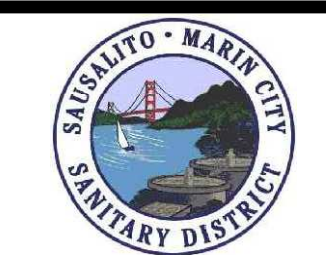


TREATMENT AND WET WEATHER FLOW UPGRADE  
 HEADWORKS SECTION 8

DWG NO M100-15  
 SHEET NO 138 OF 226  
 PROJ NO 055-006  
 DATE JULY 2022

FILENAME: 0055-006-M100-16 8-01-22 11:39am cto || XREFS: | X-SMCSO-TBLK | X-Headworks Sections | 0055-006-M100-5 | 0055-006-M100-2 | 0055-006-M100-3 | 0055-006-M100-4 | X-SitePlan | X-Topo Survey new | S-HEADWORKS-SECT | S-HEADWORKS-PLAN | X-Treatment Plant Site plan | K-

NOTES:  
 1. CONTRACTOR SHALL BE RESPONSIBLE FOR COORDINATING DIMENSION, CONNECTIONS AND ALL OTHER REQUIREMENTS TO ENSURE PROPER INSTALLATION AND OPERATION AMONGST ALL EQUIPMENT.

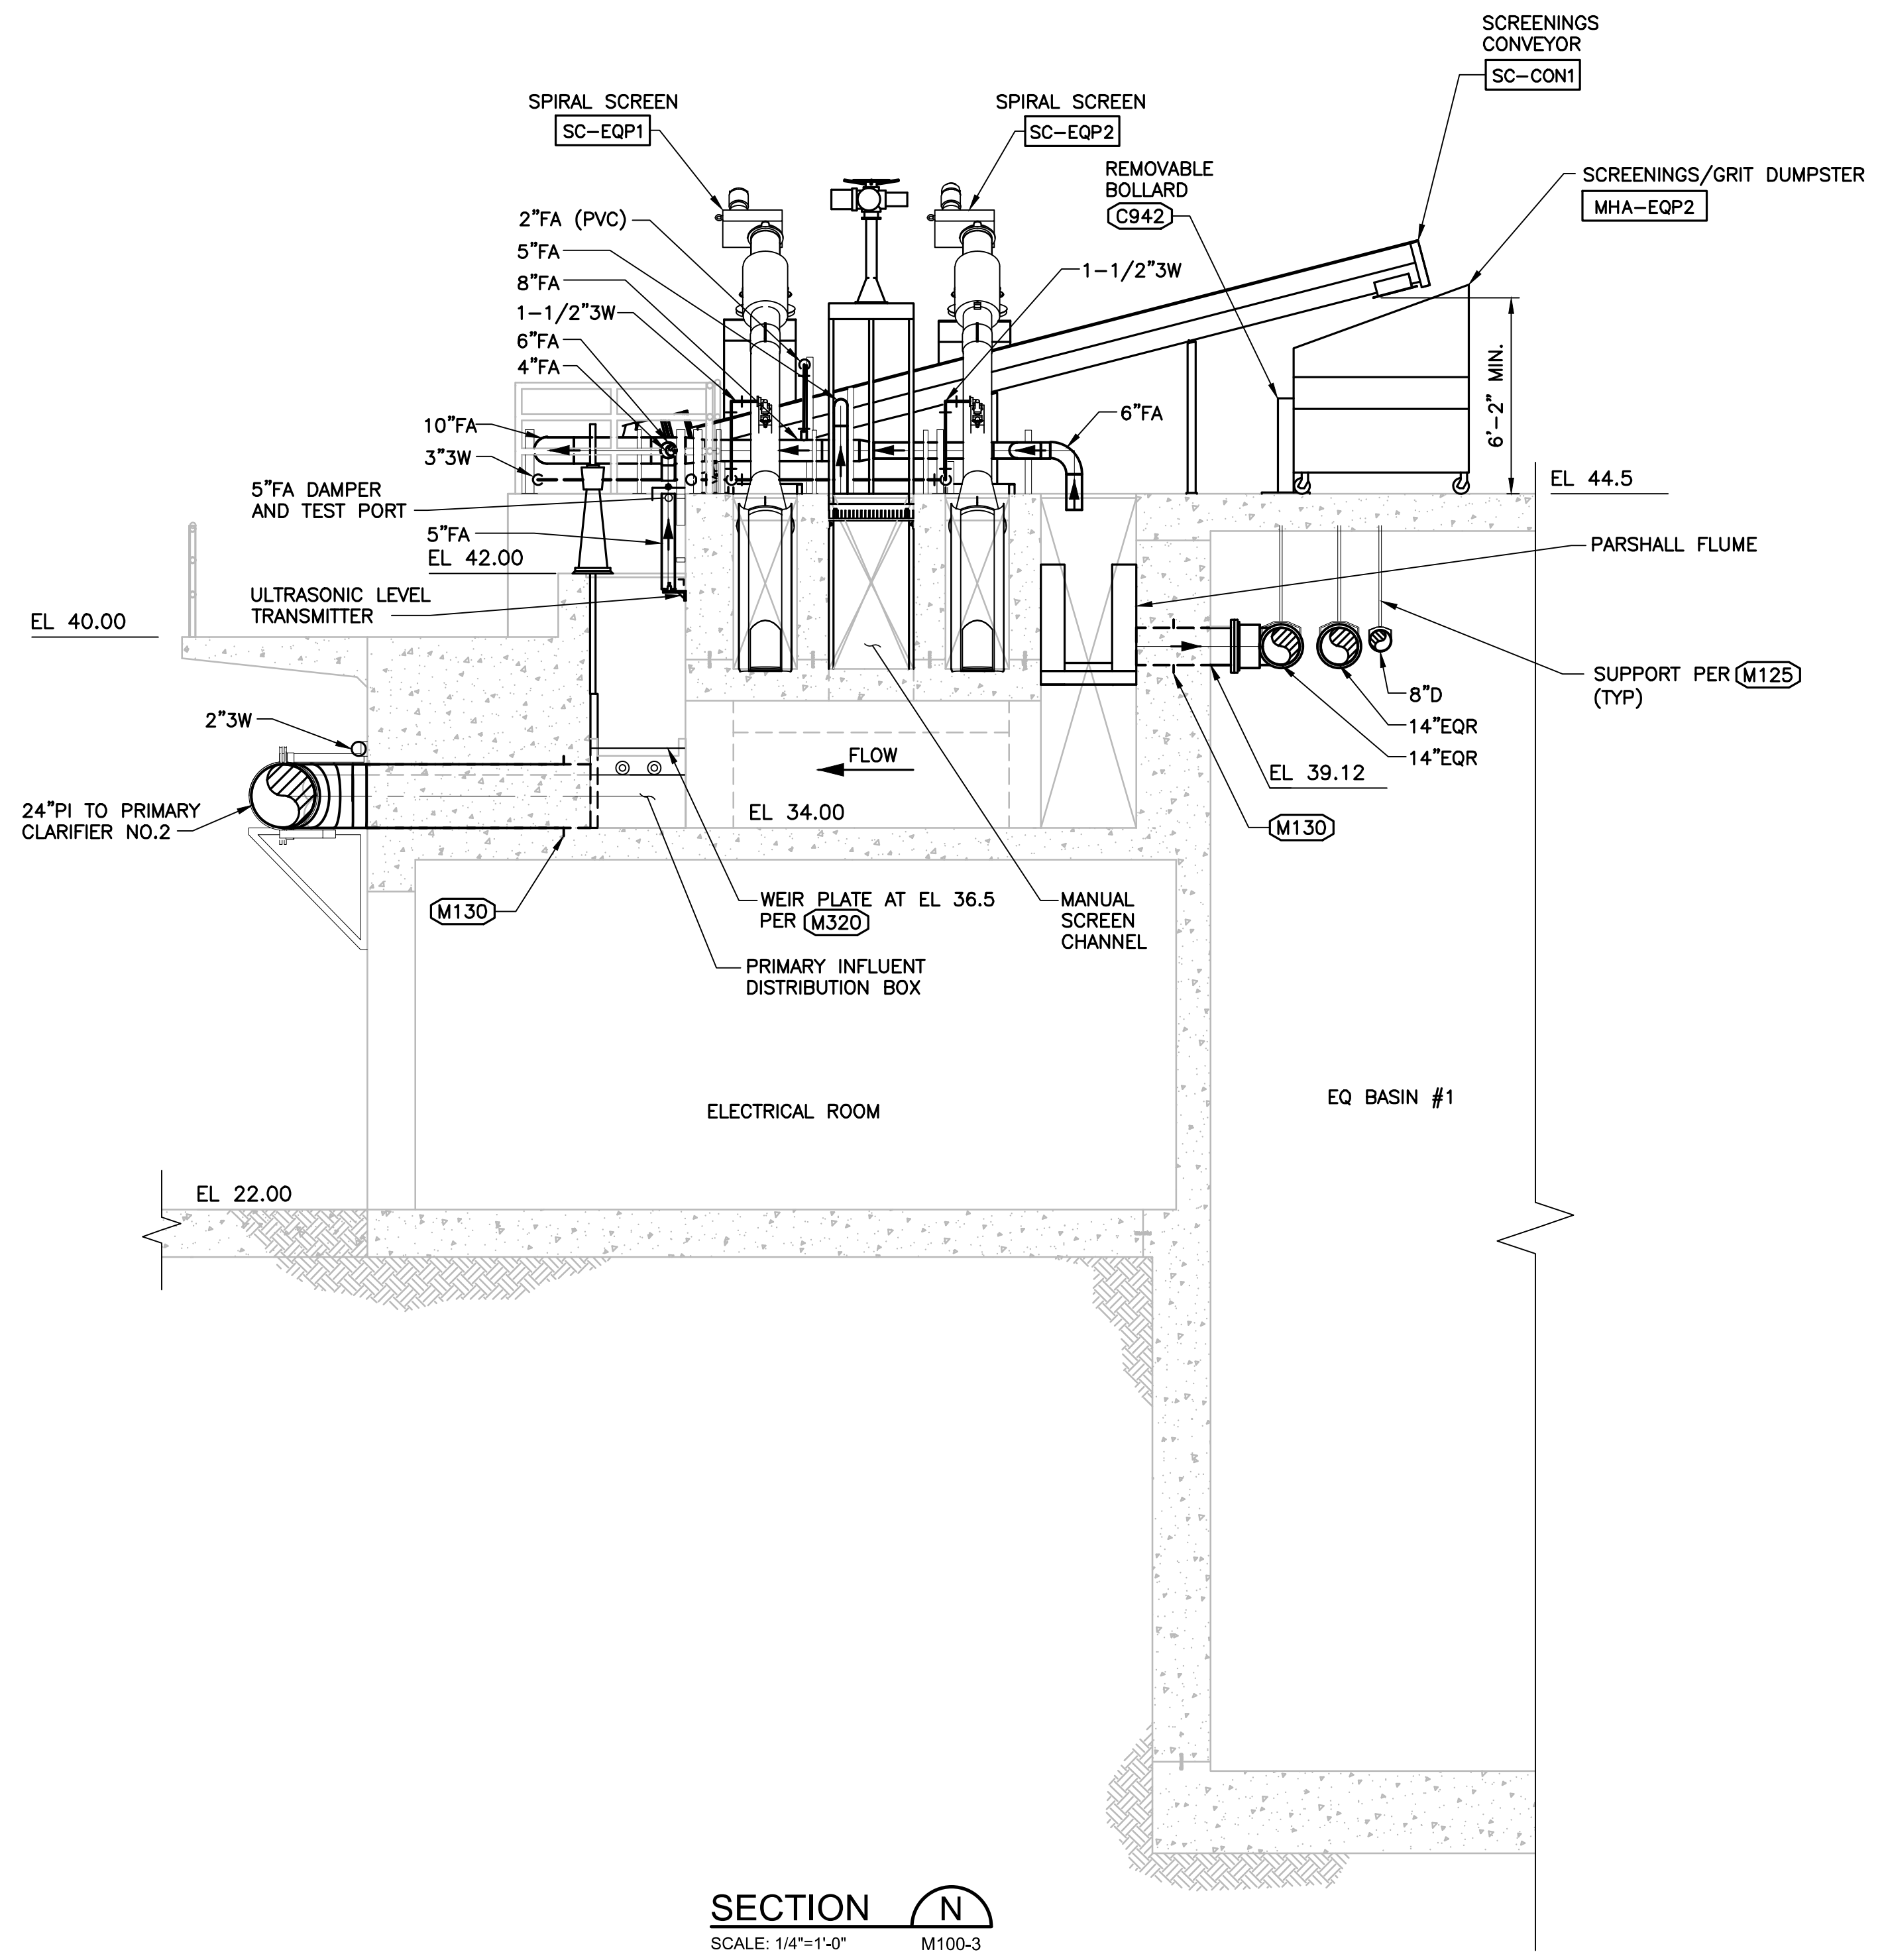

SECTION N  
 SCALE: 1/4"=1'-0" M100-3

**RECORD DRAWING**  
 THIS RECORD DRAWING HAS BEEN PREPARED FROM THE ORIGINAL CONTRACT DOCUMENTS SIGNED AND SEALED BY THE RESPONSIBLE ENGINEER OF RECORD. ADDITIONAL INFORMATION HAS BEEN PROVIDED BY OTHERS TO REPRESENT AS-CONSTRUCTED CONDITION AND IS SHOWN ON THESE RECORD DRAWINGS. THE RESPONSIBLE ENGINEER OF RECORD CANNOT VERIFY THE ACCURACY OF THE AS-CONSTRUCTED CONDITION INFORMATION REPRESENTED ON THE RECORD DRAWINGS.

0" 1"  
 VERIFY SCALES —  
 BAR IS ONE INCH  
 LONG ON FULL  
 SIZE DRAWING.  
 IF NOT ONE INCH  
 LONG ON THIS  
 DRAWING, ADJUST  
 SCALES ACCORDINGLY



REV	DATE	BY	APVD	DESCRIPTION
▲				
▲				
▲	07/22	CT	TV	RECORD DRAWING


DESIGNED	M. TAKEMOTO	SUBMITTED	MARK TAKEMOTO
DRAWN	S. NGUYEN		RMC PROJECT ENGINEER CE-64369
CHECKED	M. NAKAMOTO	APPROVED:	STEVE CLARY
			RMC ENGINEER CE-30318




TREATMENT AND WET WEATHER FLOW UPGRADE  
**HEADWORKS SECTION 9**

DWG NO	M100-16
SHEET NO	139 OF 226
PROJ NO	055-006
DATE	JULY 2022


FILENAME: 0055-006-M100-17 8-01-22 11:40am cto || WREPS || X-SMCSO-TBLK || 0055-006-M100-5 || 0055-006-M100-2 || 0055-006-M100-3 || 0055-006-M100-4 || X-SitePlan || X-Topo Survey new || S-HEADWORKS-PLAN || S-HEADWORKS-SECT || X-HEADWORKS-SECT || X-Headworks Sections || X-Treatment Plant Site plan ICC-

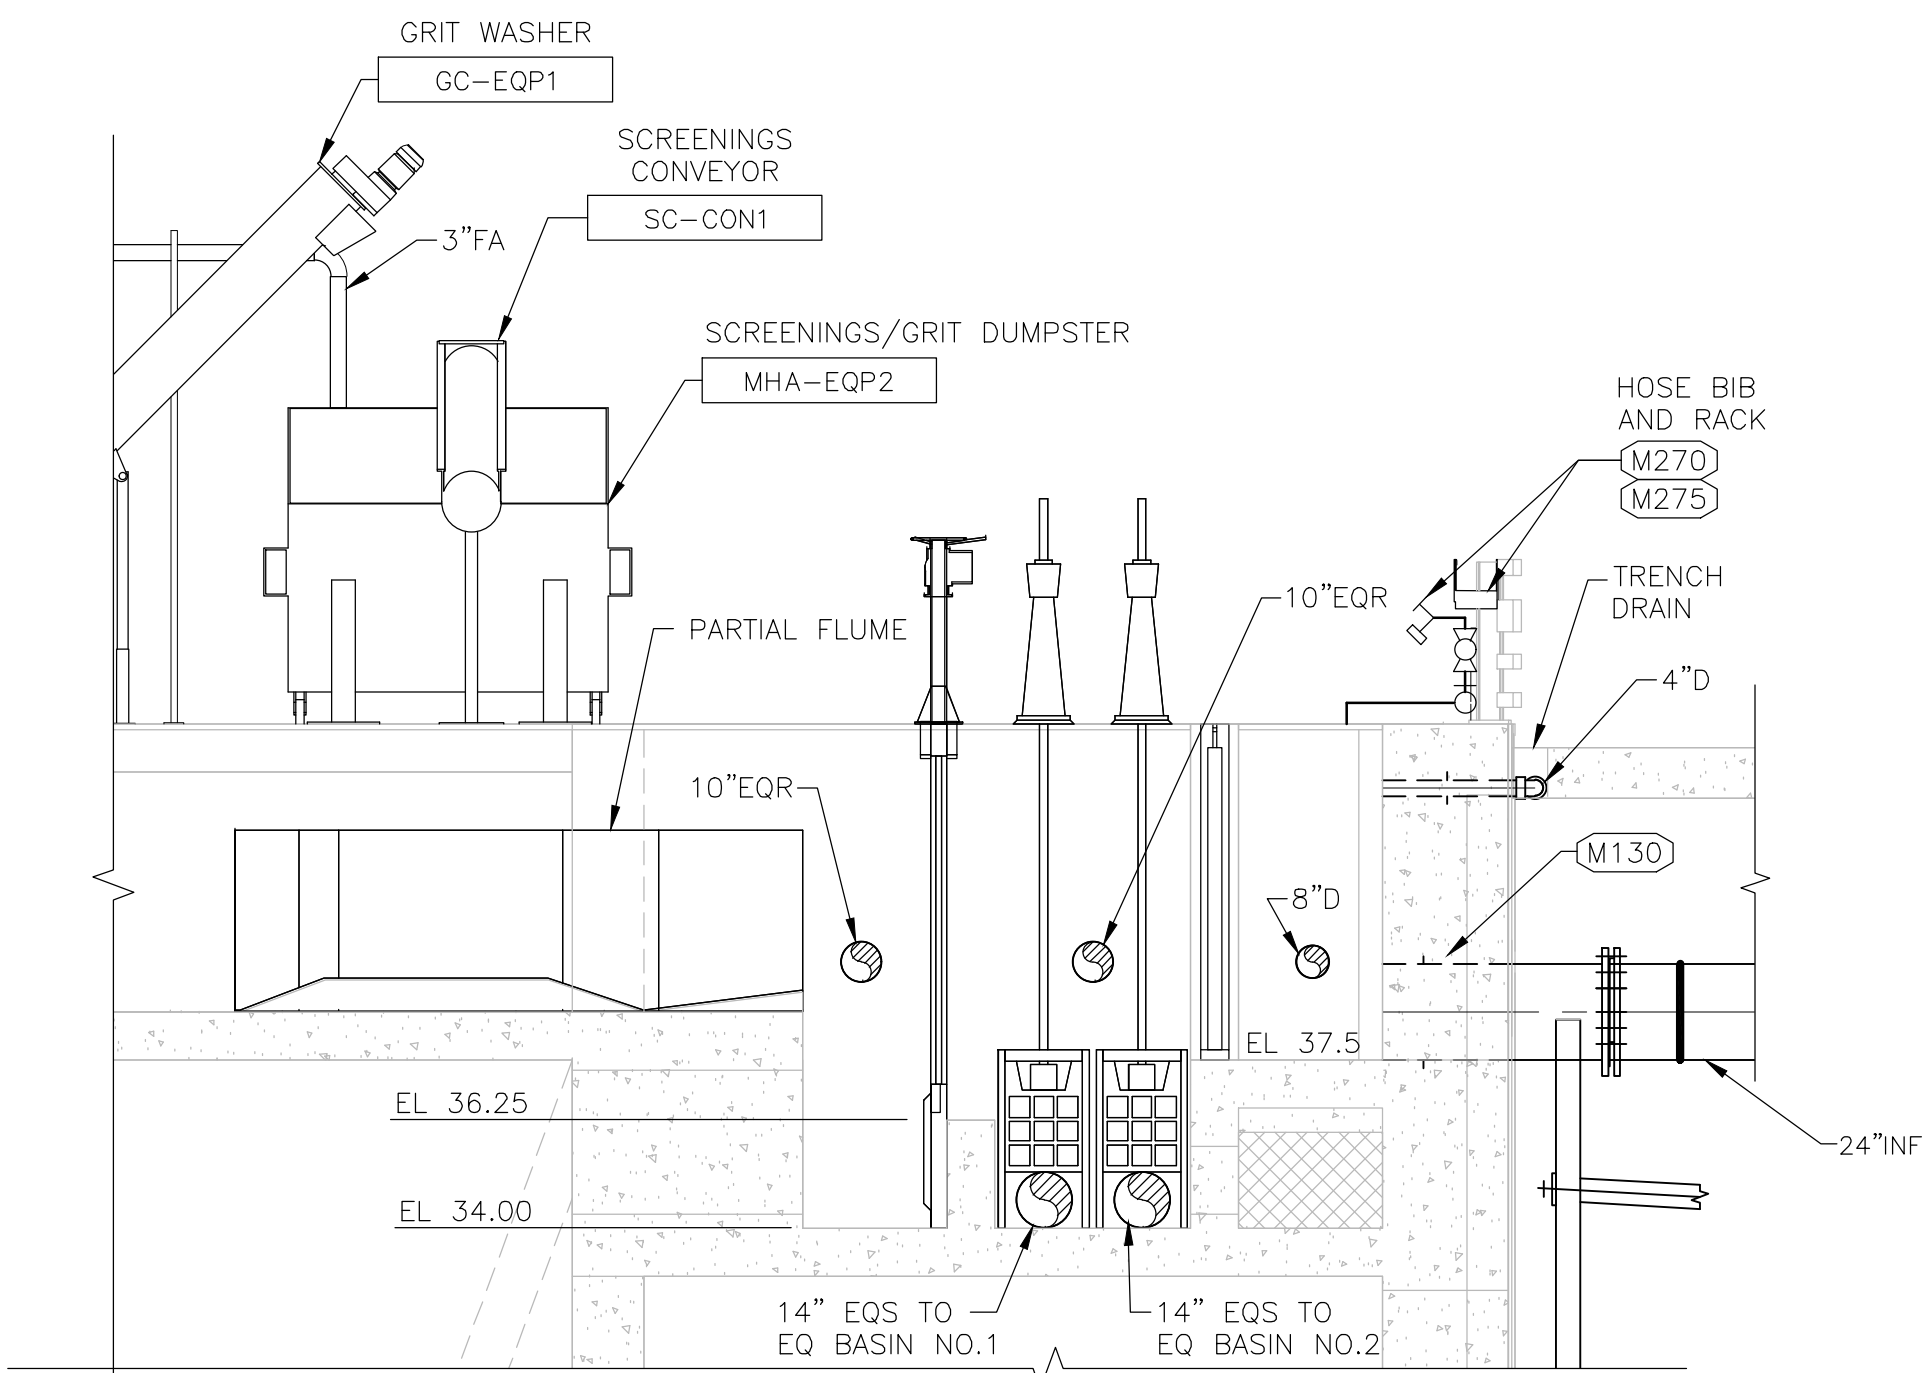

**SECTION O**  
SCALE: 1/4"=1'-0" M100-4

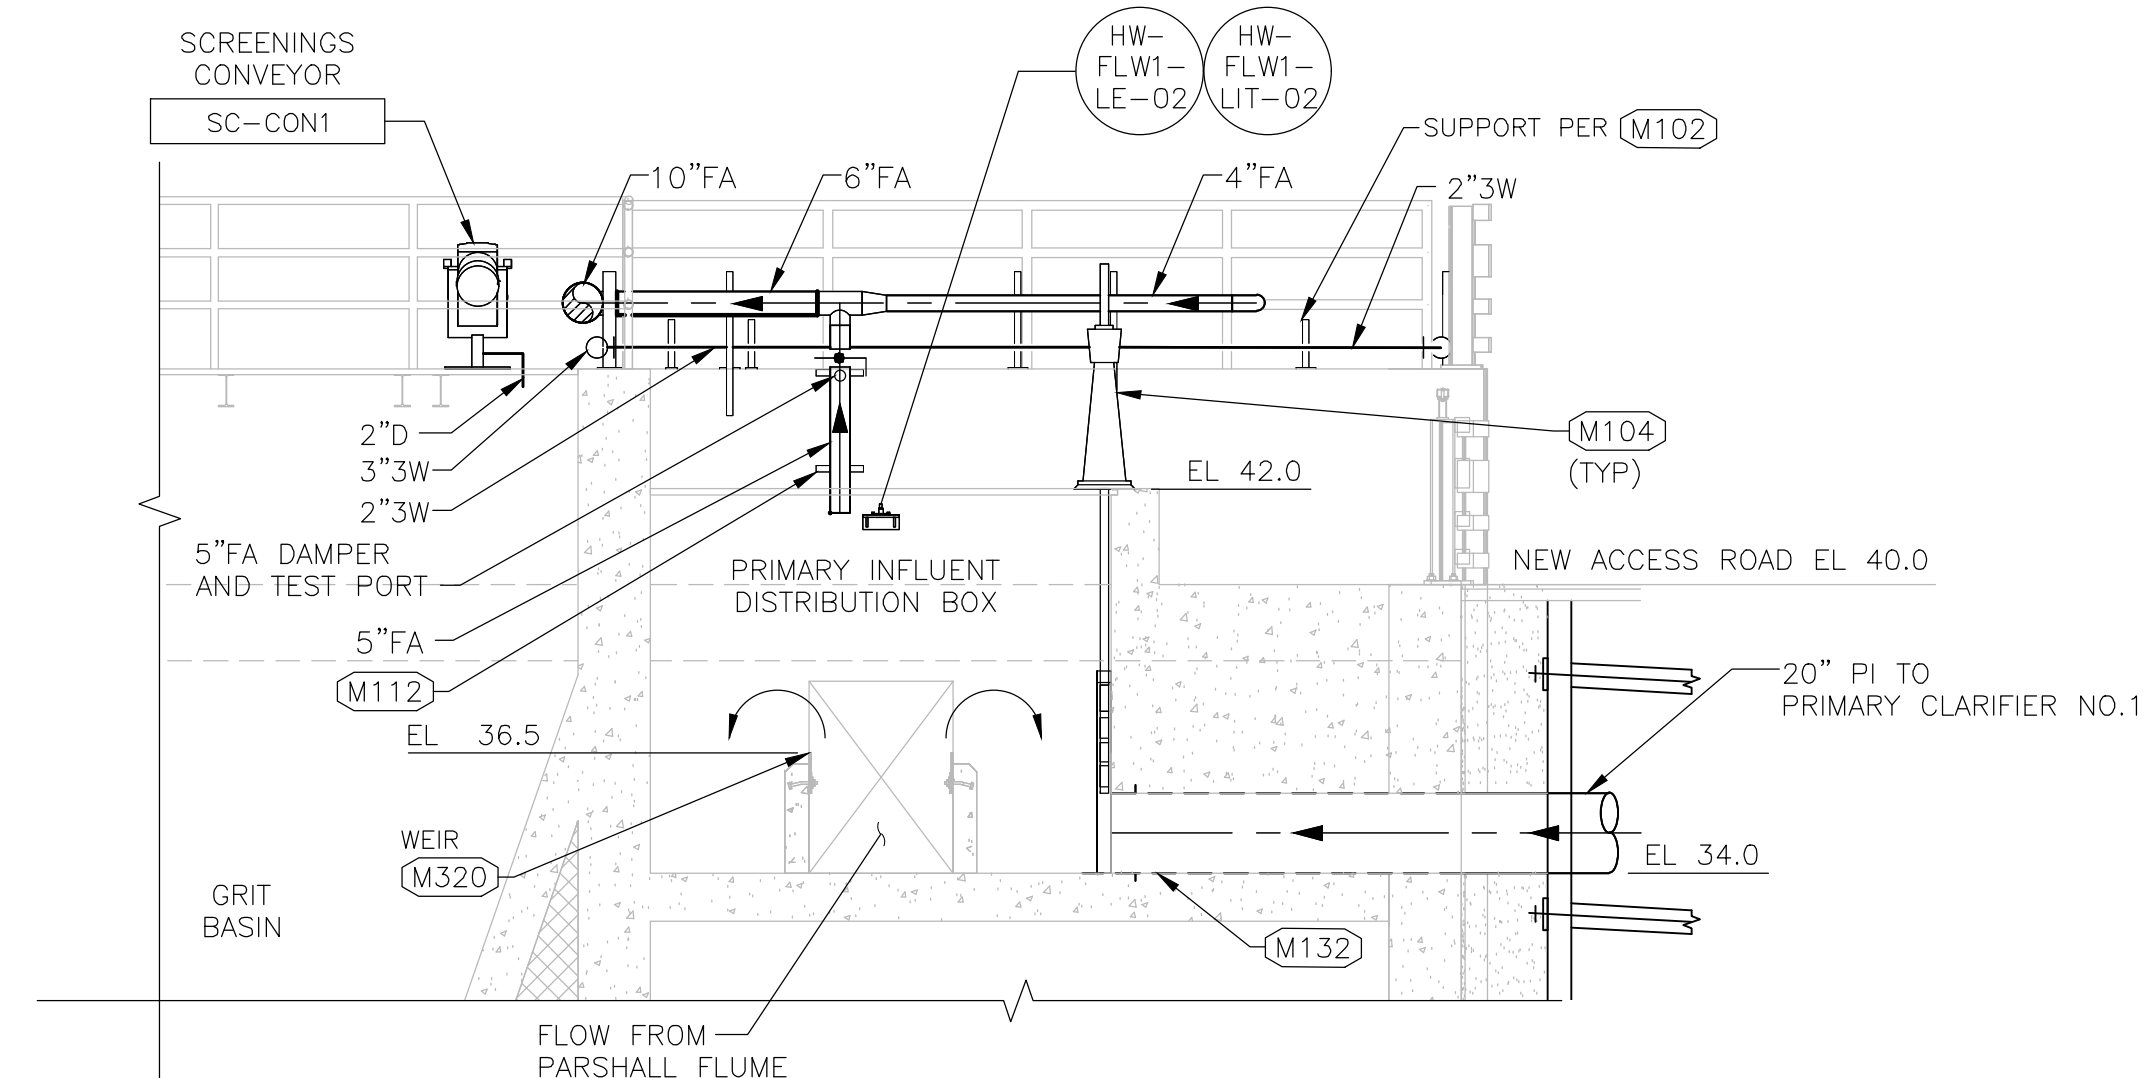

**SECTION L**  
SCALE: 1/4"=1'-0" M100-4

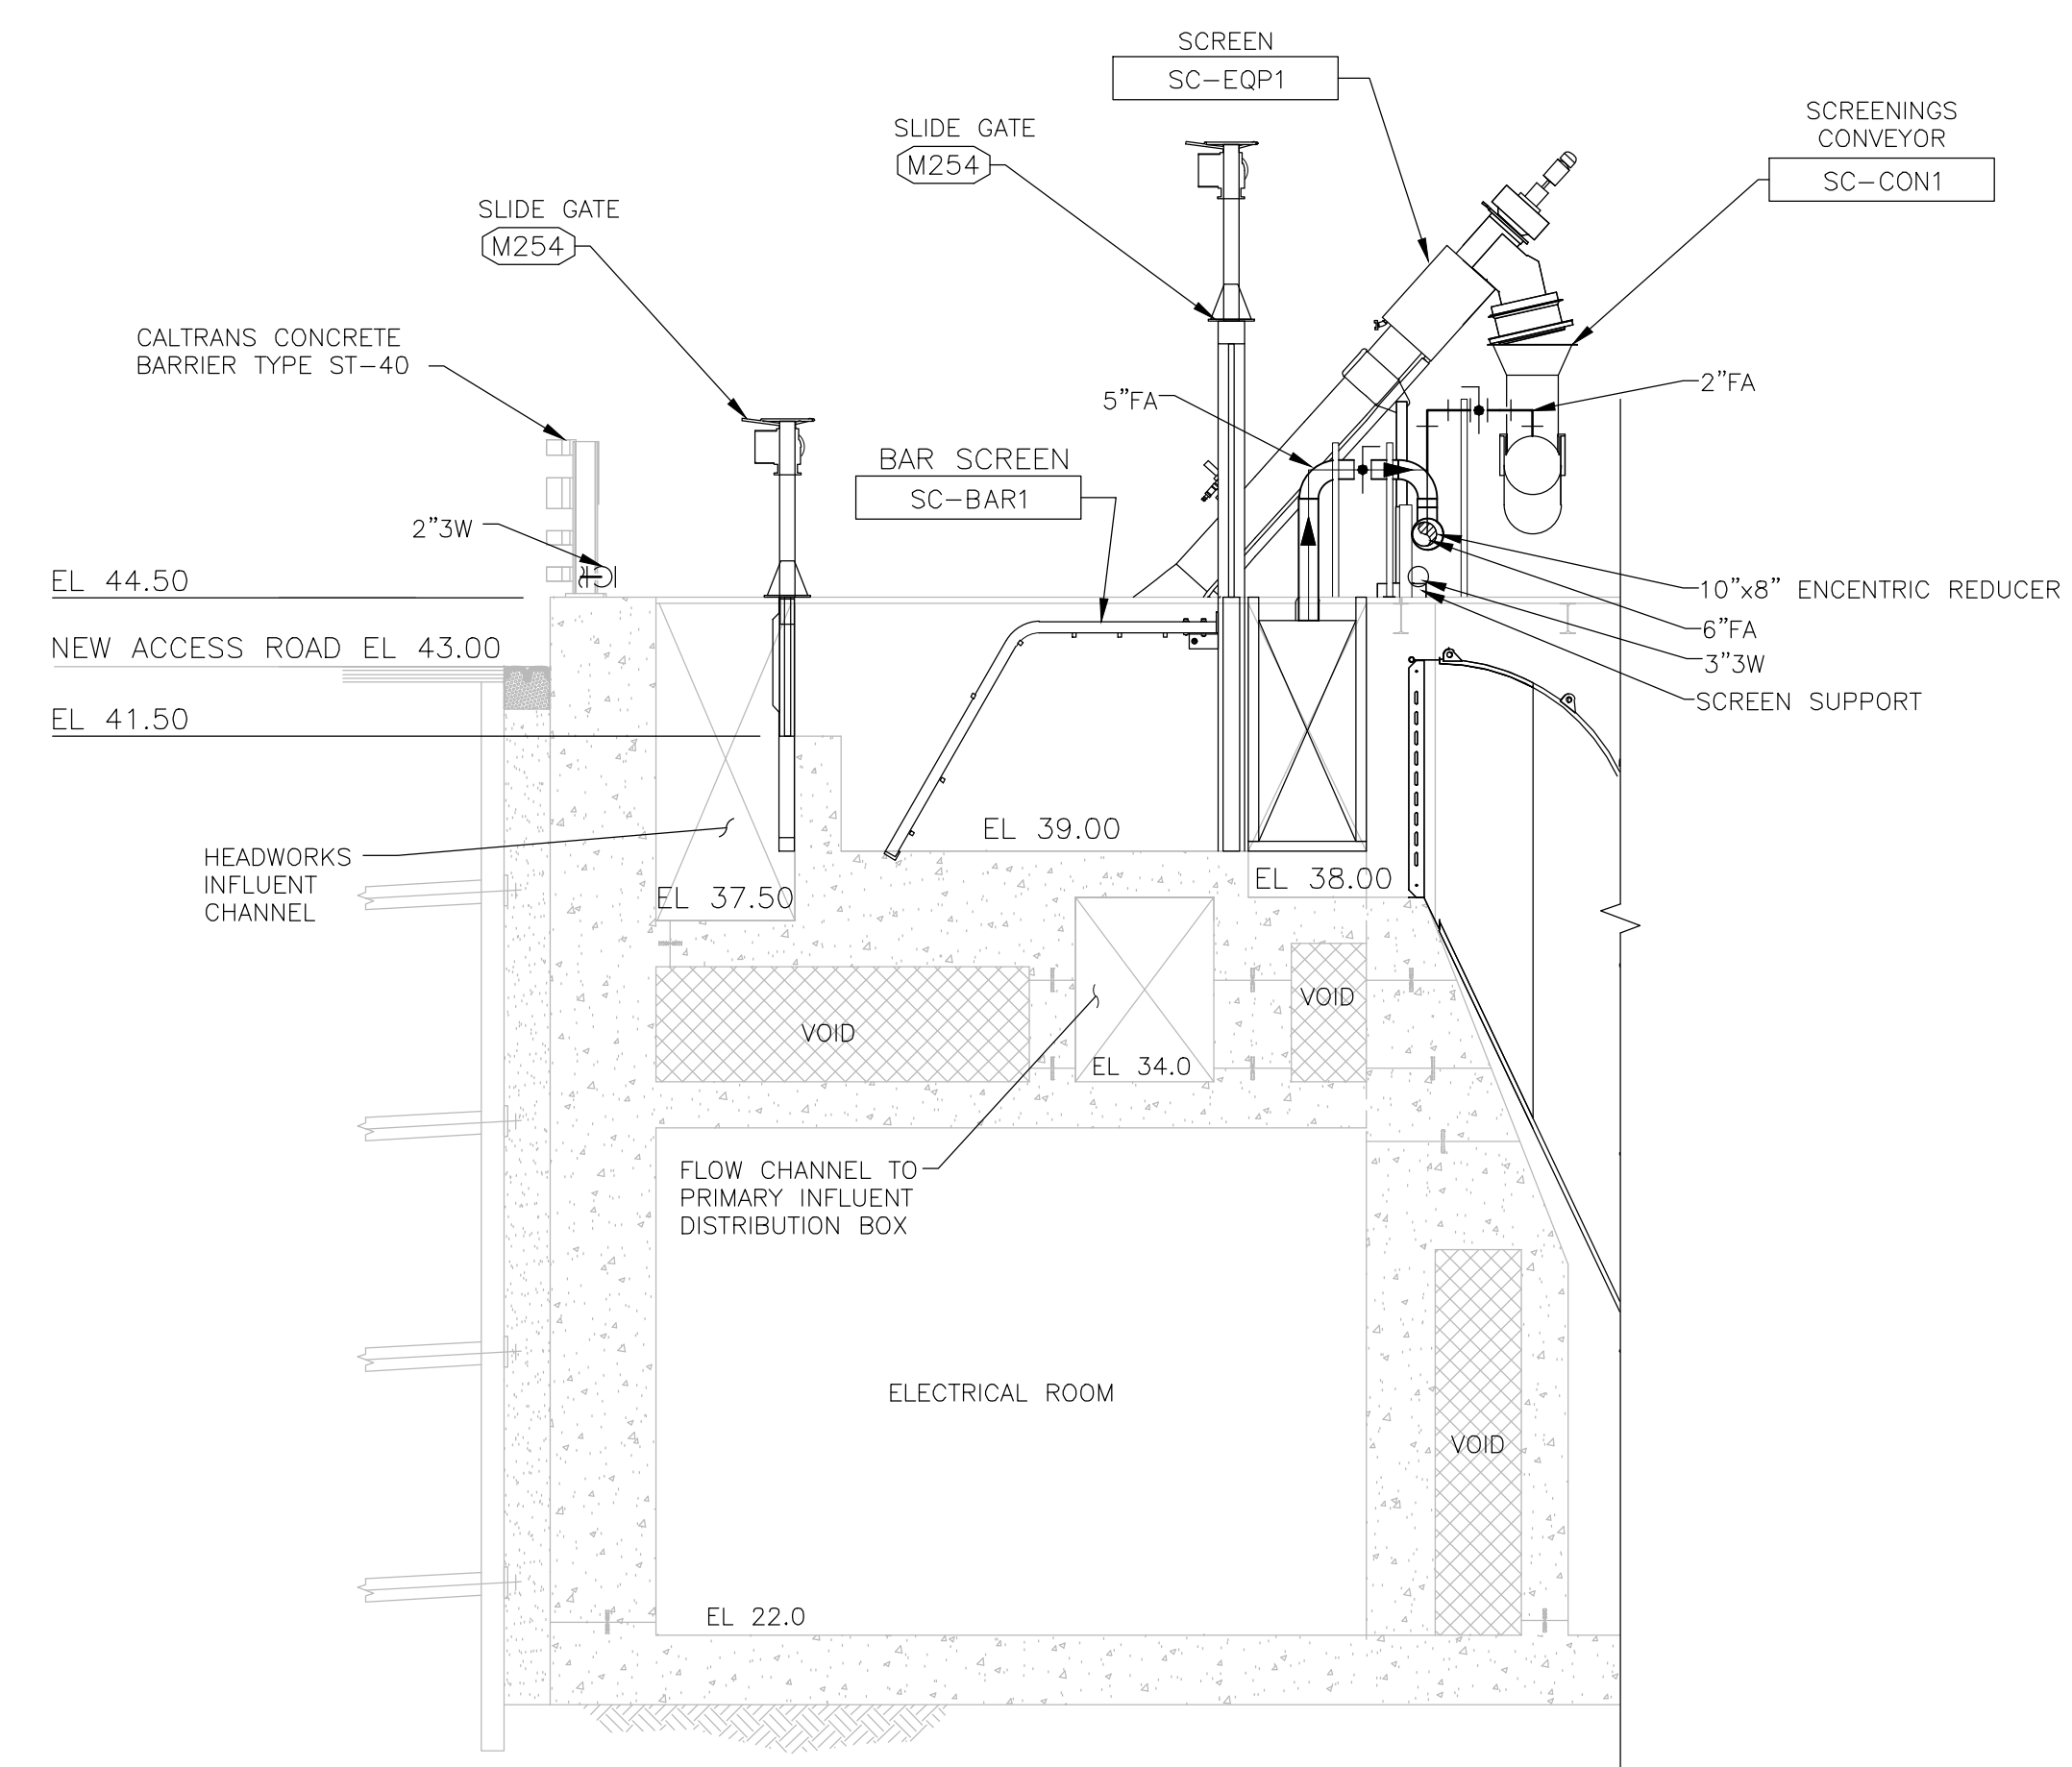

**SECTION P**  
SCALE: 1/2"=1'-0" M100-3

**RECORD DRAWING**  
THIS RECORD DRAWING HAS BEEN PREPARED FROM THE ORIGINAL CONTRACT DOCUMENTS SIGNED AND SEALED BY THE RESPONSIBLE ENGINEER OF RECORD. ADDITIONAL INFORMATION HAS BEEN PROVIDED BY OTHERS TO REPRESENT AS-CONSTRUCTED CONDITION AND IS SHOWN ON THESE RECORD DRAWINGS. THE RESPONSIBLE ENGINEER OF RECORD CANNOT VERIFY THE ACCURACY OF THE AS-CONSTRUCTED CONDITION INFORMATION REPRESENTED ON THE RECORD DRAWINGS.

0" 1"  
VERIFY SCALES —  
BAR IS ONE INCH  
LONG ON FULL  
SIZE DRAWING.  
IF NOT ONE INCH  
LONG ON THIS  
DRAWING, ADJUST  
SCALES ACCORDINGLY





REV	DATE	BY	APVD	DESCRIPTION
▲				
▲				
▲				
▲	07/22	CT	TV	RECORD DRAWING

DESIGNED	M. TAKEMOTO	SUBMITTED: MARK TAKEMOTO RMC PROJECT ENGINEER CE-64369
DRAWN	S. NGUYEN	
CHECKED	M. NAKAMOTO	APPROVED: STEVE CLARY RMC ENGINEER CE-30318



TREATMENT AND WET WEATHER FLOW UPGRADE  
**HEADWORKS SECTION 10**

DWG NO	M100-17
SHEET NO	140 OF 226
PROJ NO	055-006
DATE	JULY 2022

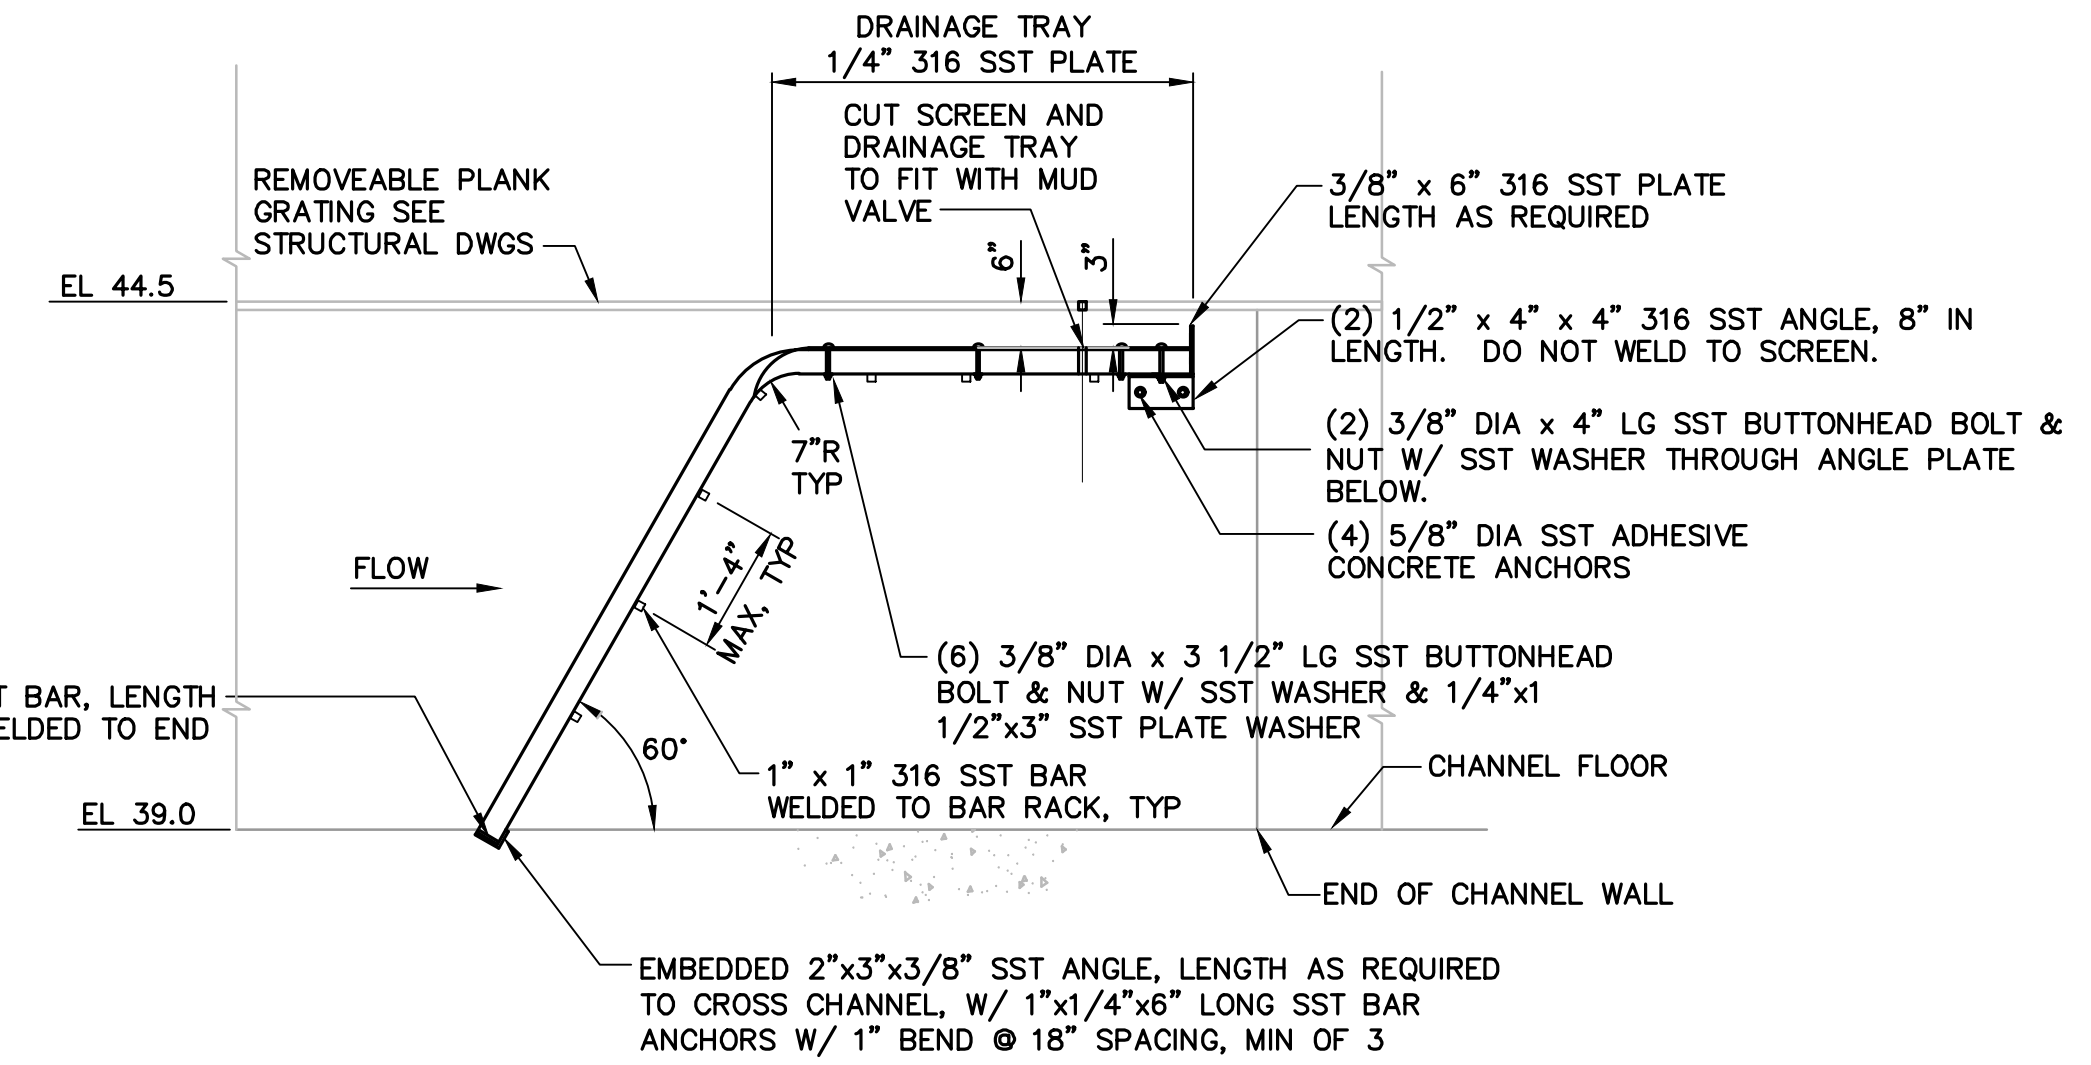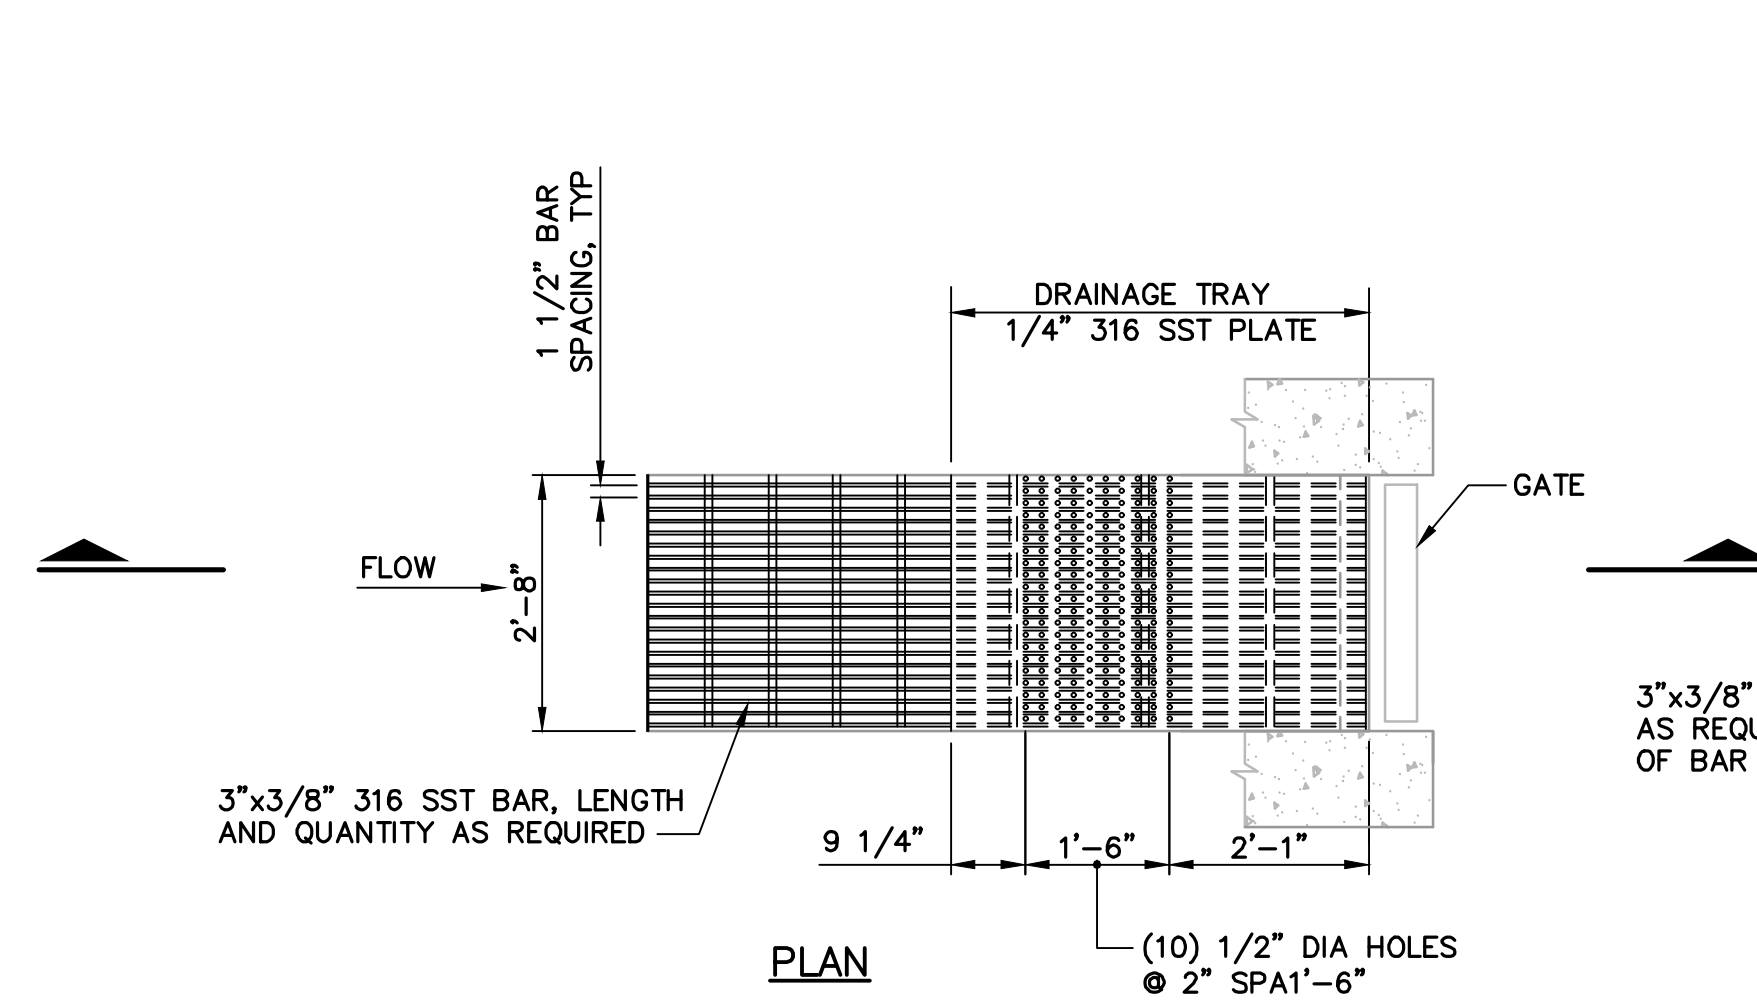


- NOTES:**
1. ALL BAR SCREEN PARTS SHALL BE 316 SST.
  2. FURNISH (1) ALUMINUM RAKE FOR USE WITH BAR SCREEN.

**MANUAL BAR SCREEN 1**  
1"=1'-0"

FILENAME: 0055-006-M100-18 8-01-22 11:40am cto || XREFS: X-SMCSO-TBLK <--

<p><b>RECORD DRAWING</b></p> <p>THIS RECORD DRAWING HAS BEEN PREPARED FROM THE ORIGINAL CONTRACT DOCUMENTS SIGNED AND SEALED BY THE RESPONSIBLE ENGINEER OF RECORD. ADDITIONAL INFORMATION HAS BEEN PROVIDED BY OTHERS TO REPRESENT AS-CONSTRUCTED CONDITION AND IS SHOWN ON THESE RECORD DRAWINGS. THE RESPONSIBLE ENGINEER OF RECORD CANNOT VERIFY THE ACCURACY OF THE AS-CONSTRUCTED CONDITION INFORMATION REPRESENTED ON THE RECORD DRAWINGS.</p>		<table border="1"> <tr><td>07/22</td><td>CT</td><td>TV</td><td>RECORD DRAWING</td></tr> <tr><td>REV</td><td>DATE</td><td>BY</td><td>APVD</td></tr> <tr><td> </td><td> </td><td> </td><td> </td></tr> <tr><td> </td><td> </td><td> </td><td> </td></tr> <tr><td> </td><td> </td><td> </td><td> </td></tr> </table>	07/22	CT	TV	RECORD DRAWING	REV	DATE	BY	APVD													<table border="1"> <tr><td>DESIGNED</td><td>M. TAKEMOTO</td></tr> <tr><td>DRAWN</td><td>S. JUNG</td></tr> <tr><td>CHECKED</td><td>M. NAKAMOTO</td></tr> </table>	DESIGNED	M. TAKEMOTO	DRAWN	S. JUNG	CHECKED	M. NAKAMOTO	<table border="1"> <tr><td>SUBMITTED:</td><td>MARK TAKEMOTO</td></tr> <tr><td colspan="2">RMC PROJECT ENGINEER CE-64369</td></tr> <tr><td>APPROVED:</td><td>STEVE CLARY</td></tr> <tr><td colspan="2">RMC ENGINEER CE-30318</td></tr> </table>	SUBMITTED:	MARK TAKEMOTO	RMC PROJECT ENGINEER CE-64369		APPROVED:	STEVE CLARY	RMC ENGINEER CE-30318			<p>TREATMENT AND WET WEATHER FLOW UPGRADE</p> <p><b>HEADWORKS DETAILS</b></p>	<p>DWG NO <b>M100-18</b></p> <p>SHEET NO 141 OF 226</p> <p>PROJ NO 055-006</p> <p>DATE JULY 2022</p>
			07/22	CT	TV	RECORD DRAWING																																			
REV	DATE	BY	APVD																																						
DESIGNED	M. TAKEMOTO																																								
DRAWN	S. JUNG																																								
CHECKED	M. NAKAMOTO																																								
SUBMITTED:	MARK TAKEMOTO																																								
RMC PROJECT ENGINEER CE-64369																																									
APPROVED:	STEVE CLARY																																								
RMC ENGINEER CE-30318																																									
<p>0" 1" — VERIFY SCALES — BAR IS ONE INCH LONG ON FULL SIZE DRAWING. IF NOT ONE INCH LONG ON THIS DRAWING, ADJUST SCALES ACCORDINGLY</p>	<p>DESIGN DESCRIPTION</p>																																								

NOTES:  
1. THE VIEW SHOWN IS FOR ILLUSTRATIVE PURPOSES ONLY. SEE M100-1.

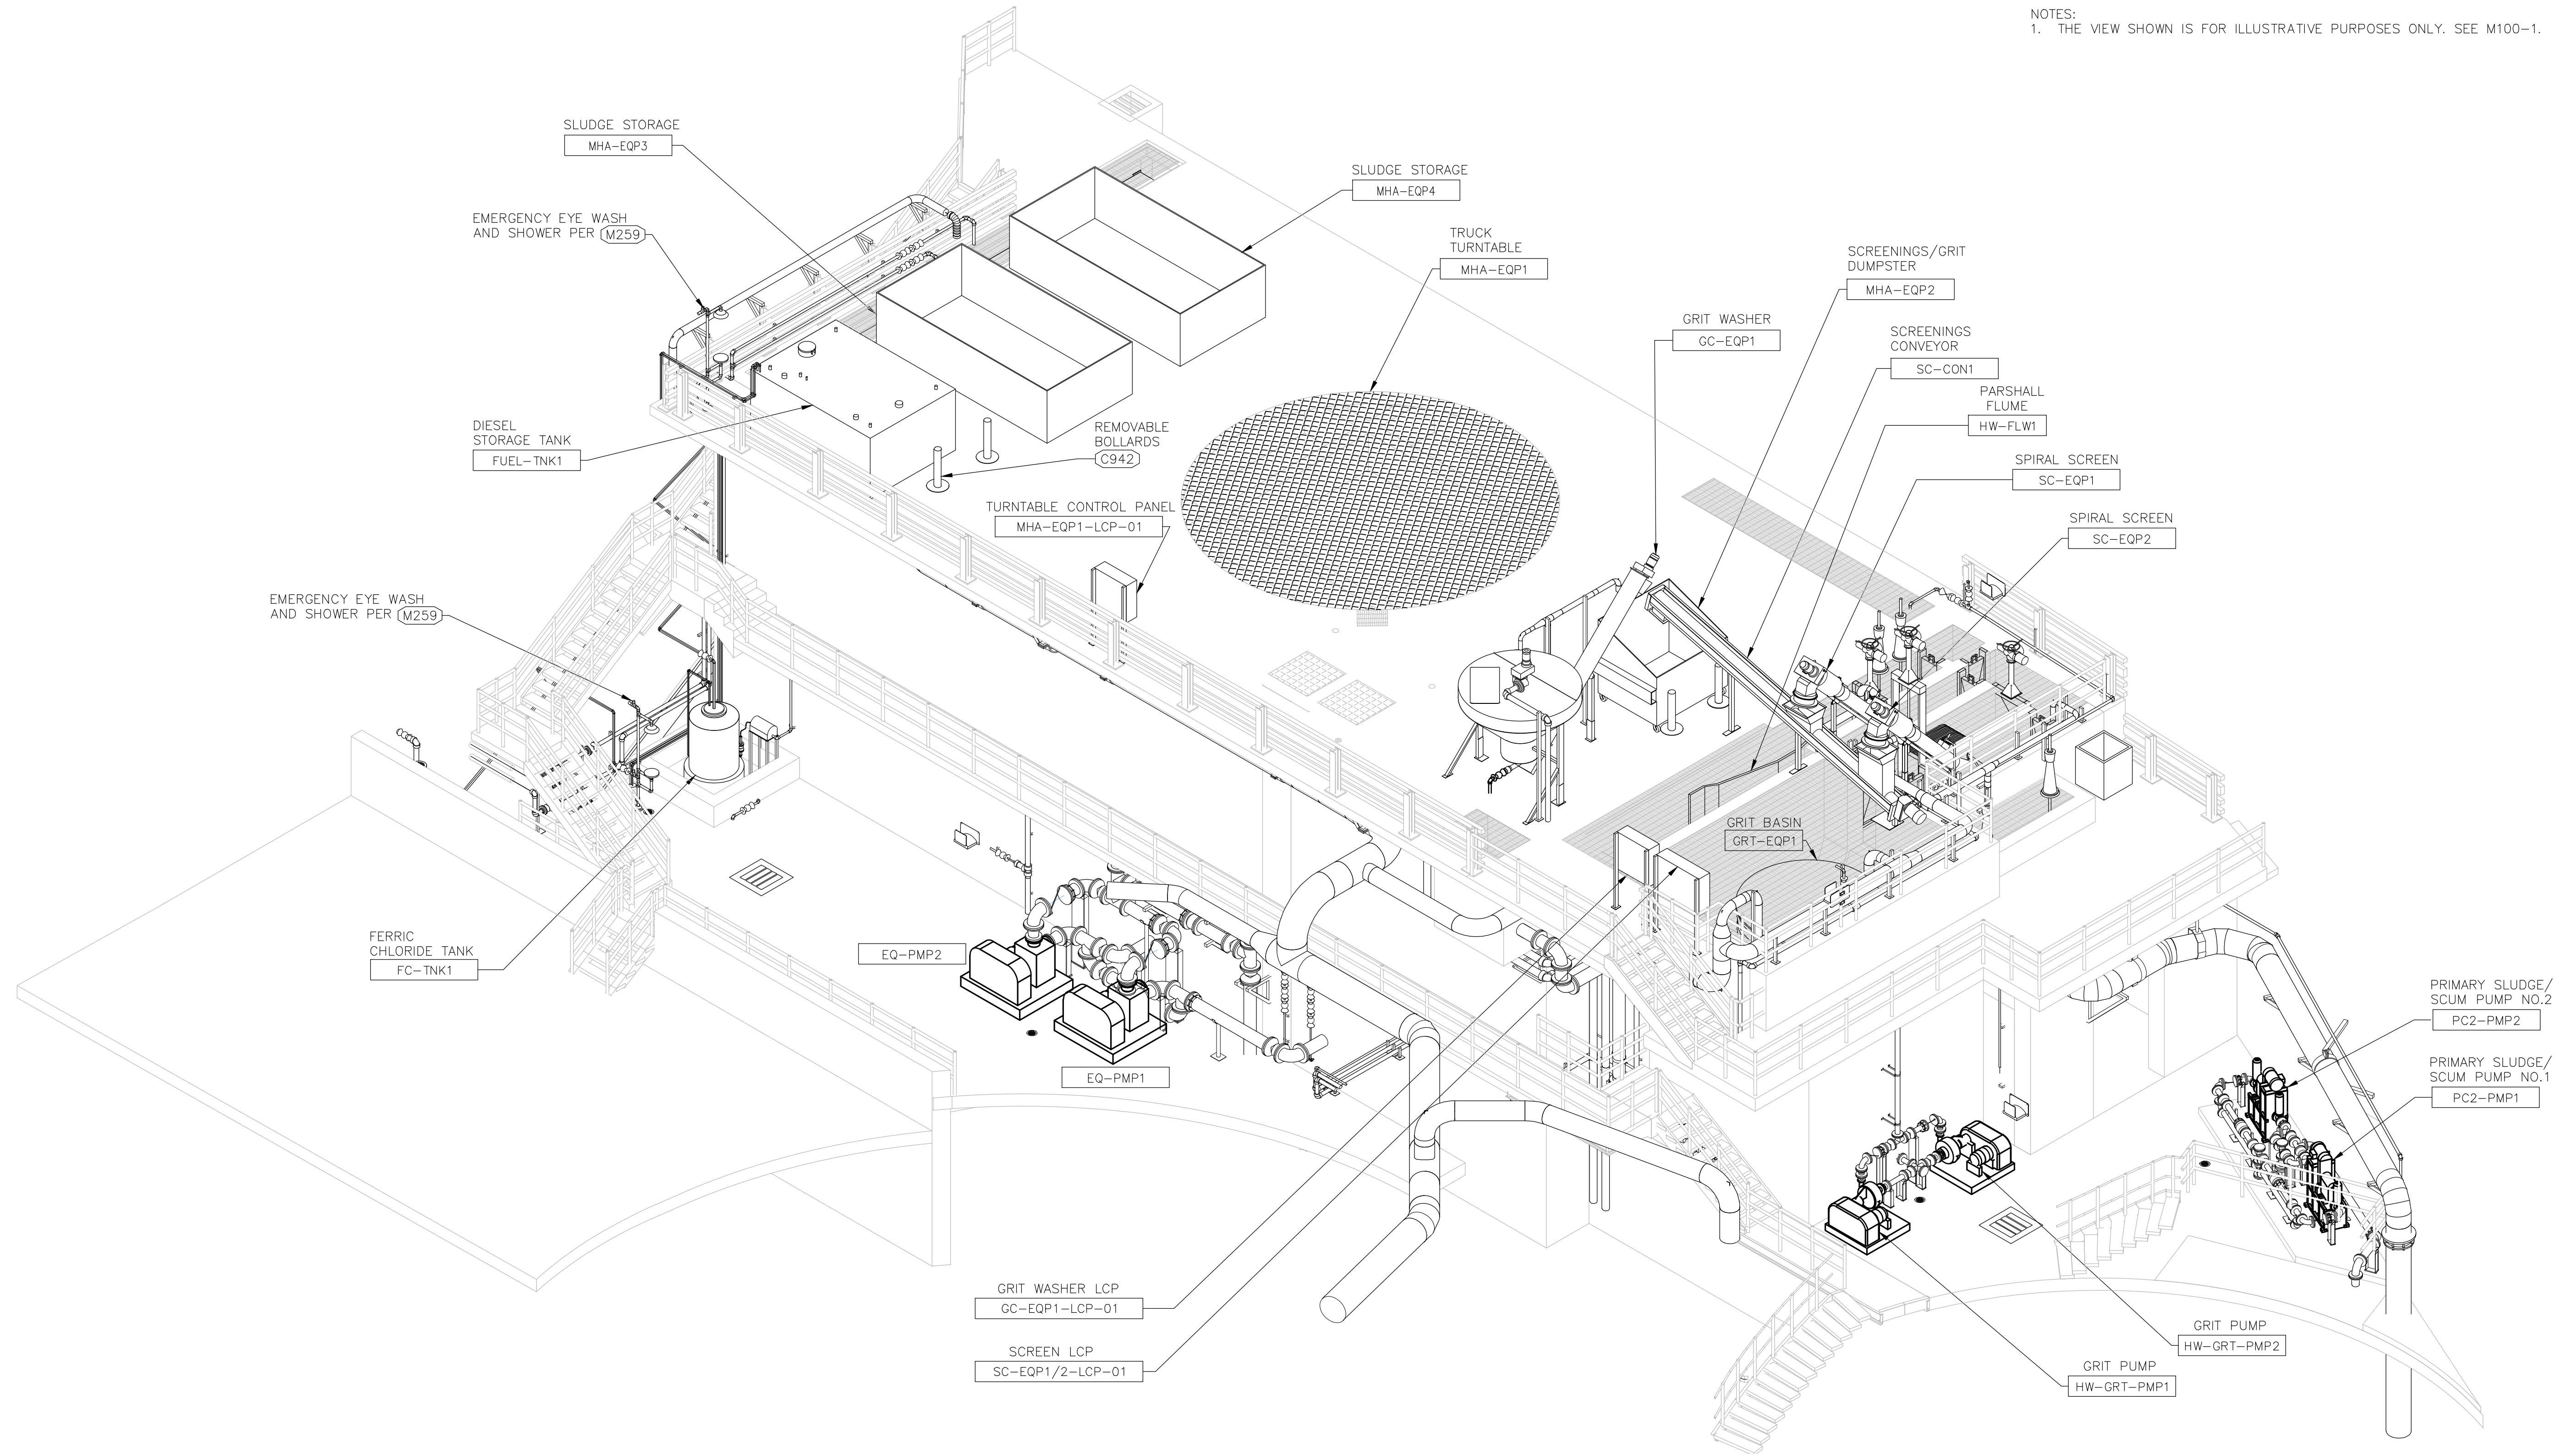

**HEADWORKS/EQ STRUCTURE**

SCALE: NTS

FILENAME: 0055-006-M10-1\_8-01-22\_11:40am.ctb XREFS: X-SMCSO=IBLK |<

**RECORD DRAWING**

THIS RECORD DRAWING HAS BEEN PREPARED FROM THE ORIGINAL CONTRACT DOCUMENTS SIGNED AND SEALED BY THE RESPONSIBLE ENGINEER OF RECORD. ADDITIONAL INFORMATION HAS BEEN PROVIDED BY OTHERS TO REPRESENT AS-CONSTRUCTED CONDITION AND IS SHOWN ON THESE RECORD DRAWINGS. THE RESPONSIBLE ENGINEER OF RECORD CANNOT VERIFY THE ACCURACY OF THE AS-CONSTRUCTED CONDITION INFORMATION REPRESENTED ON THE RECORD DRAWINGS.

0" = 1"  
VERIFY SCALES —  
BAR IS ONE INCH  
LONG ON FULL  
SIZE DRAWING.  
IF NOT ONE INCH  
LONG ON THIS  
DRAWING, ADJUST  
SCALES ACCORDINGLY



REV	DATE	BY	APVD	DESCRIPTION
▲				
▲				
▲				
▲	07/22	CT	TV	RECORD DRAWING

DESIGNED	M. TAKEMOTO
DRAWN	S. NGUYEN
CHECKED	M. NAKMOTO

SUBMITTED:	MARK TAKEMOTO	RMC PROJECT ENGINEER	CE-64369
APPROVED:	STEVE CLARY	RMC ENGINEER	CE-30318




TREATMENT AND WET WEATHER FLOW UPGRADE


**ILLUSTRATIVE ISOMETRIC VIEWS - 1**

DWG NO	M110-1
SHEET NO	142 OF 226
PROJ NO	055-006
DATE	JULY 2022

NOTES:  
 1. MOUNT OSHA SAFETY SIGN TO EACH SCUM/SLUDGE PUMP GEAR BOX COVER - "WARNING THIS EQUIPMENT STARTS AUTOMATICALLY"

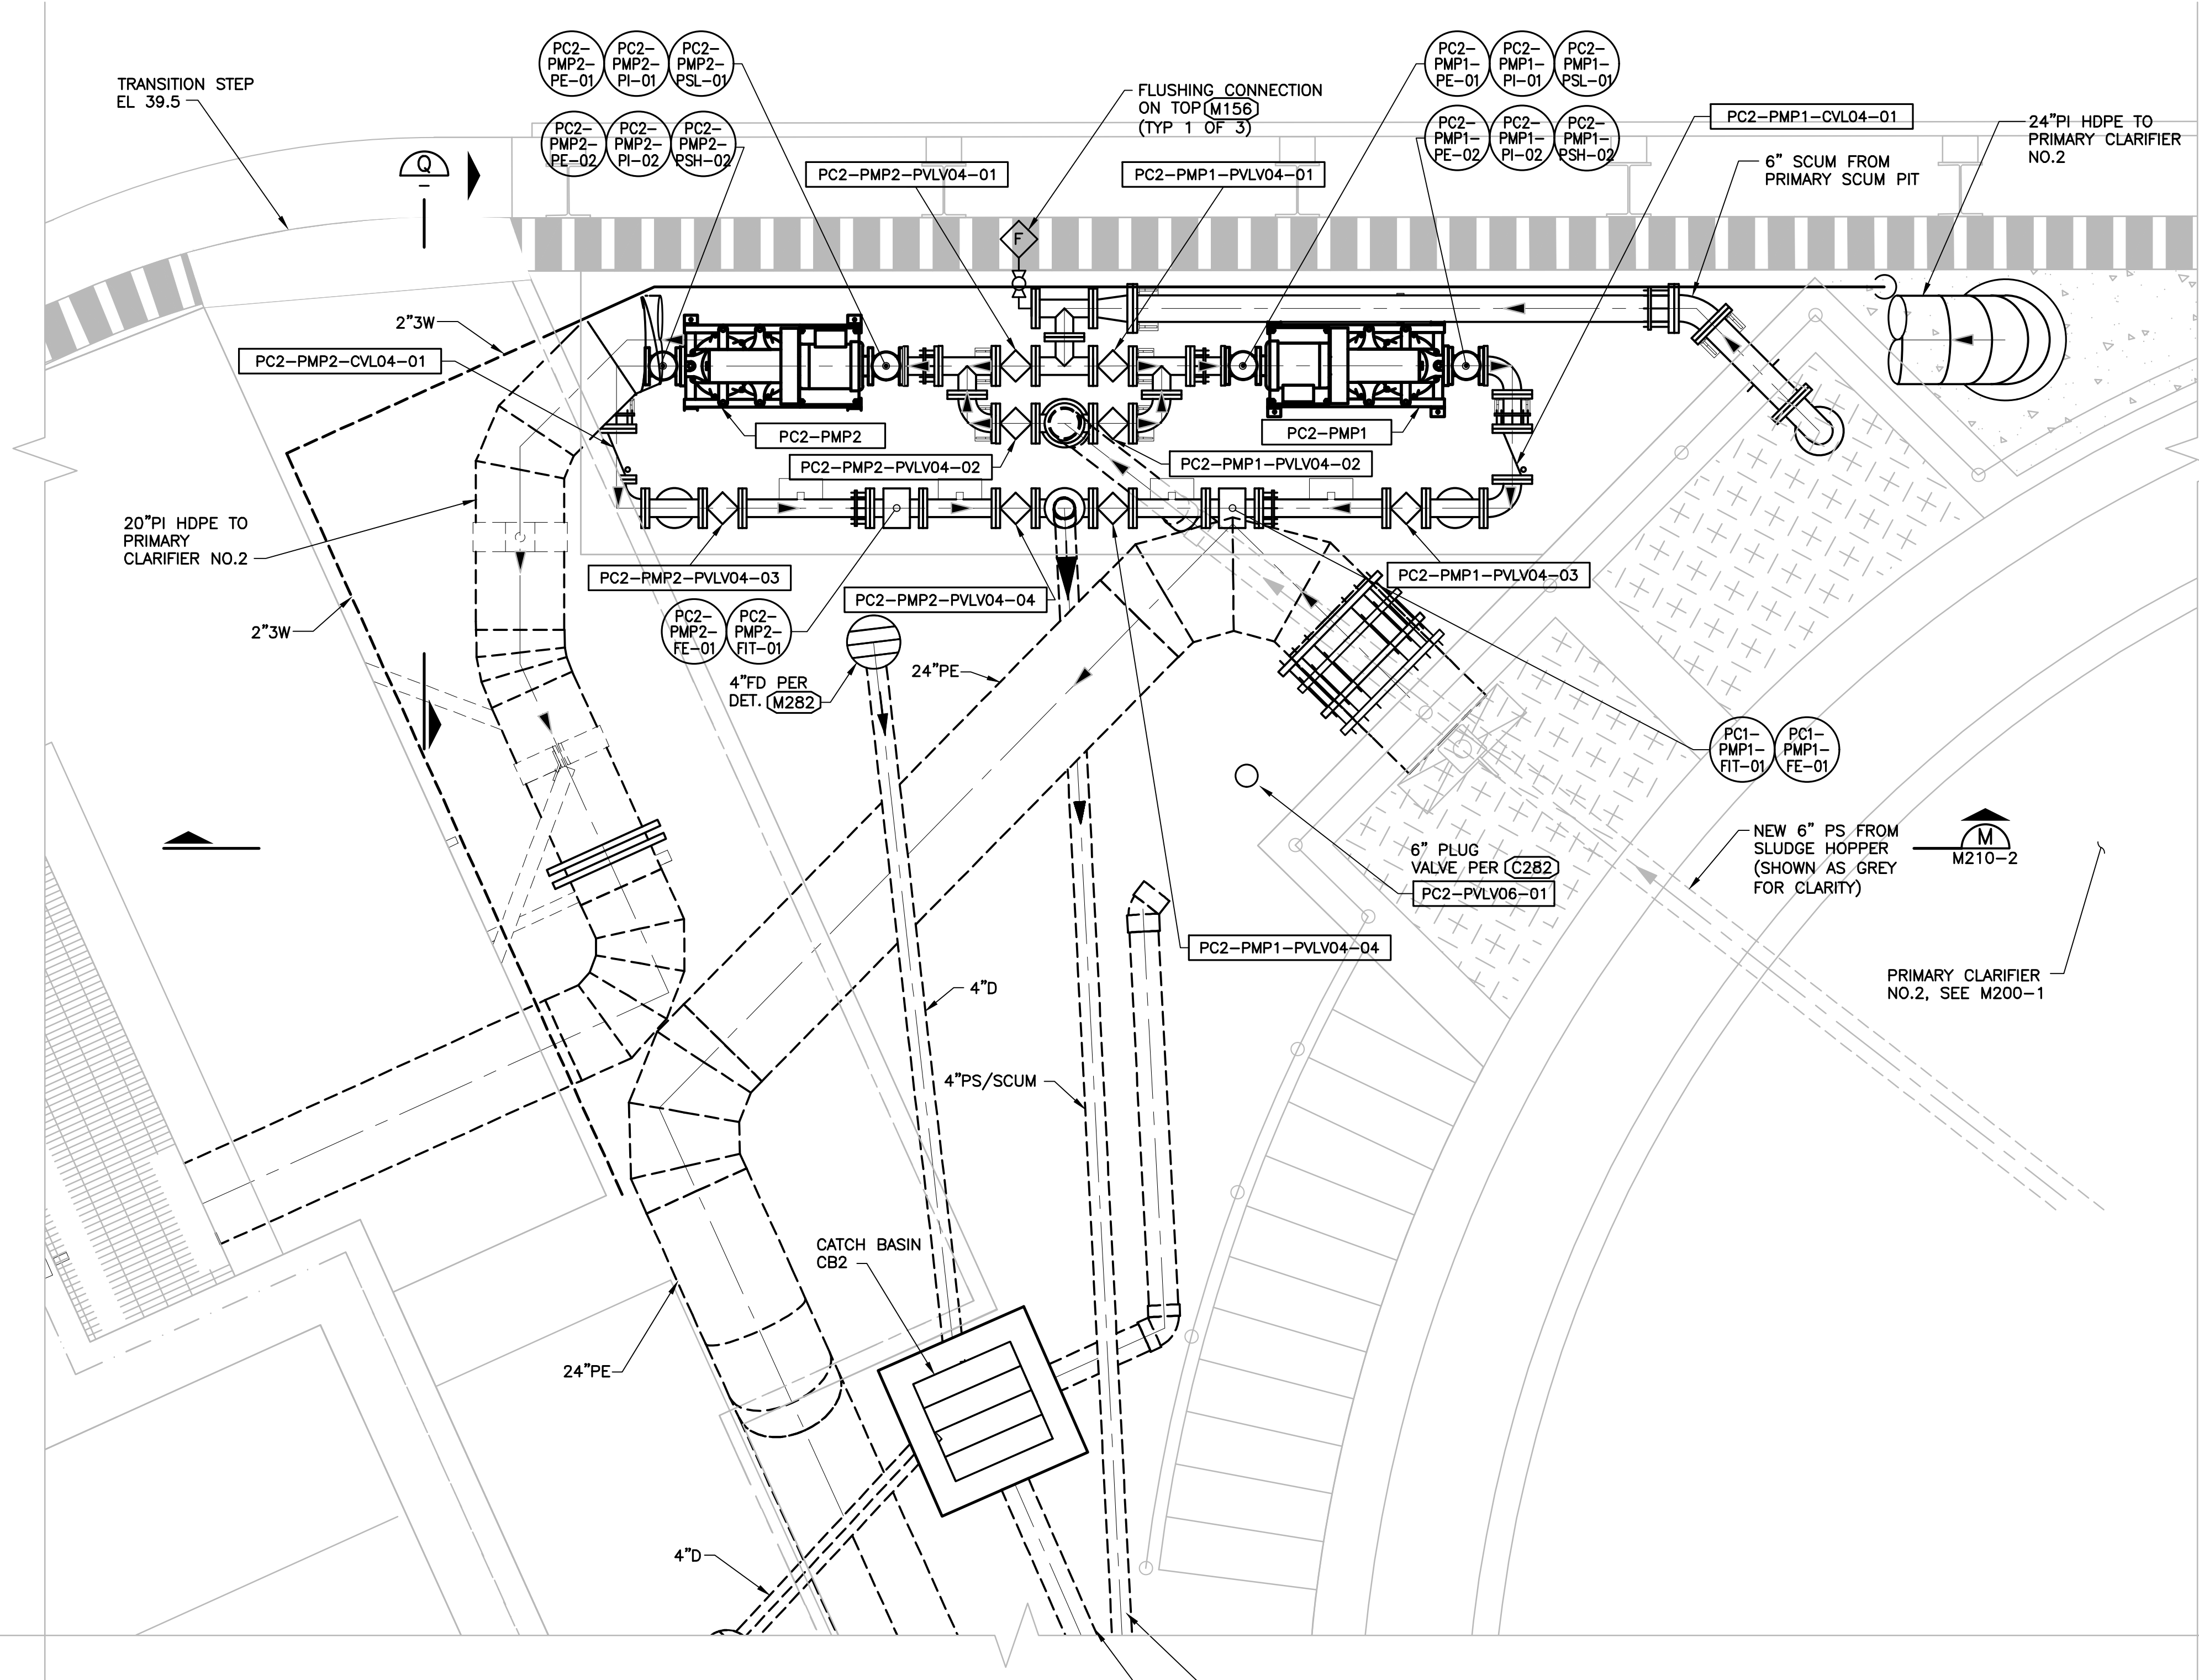

**PLAN**  
 1/2" = 1'-0"

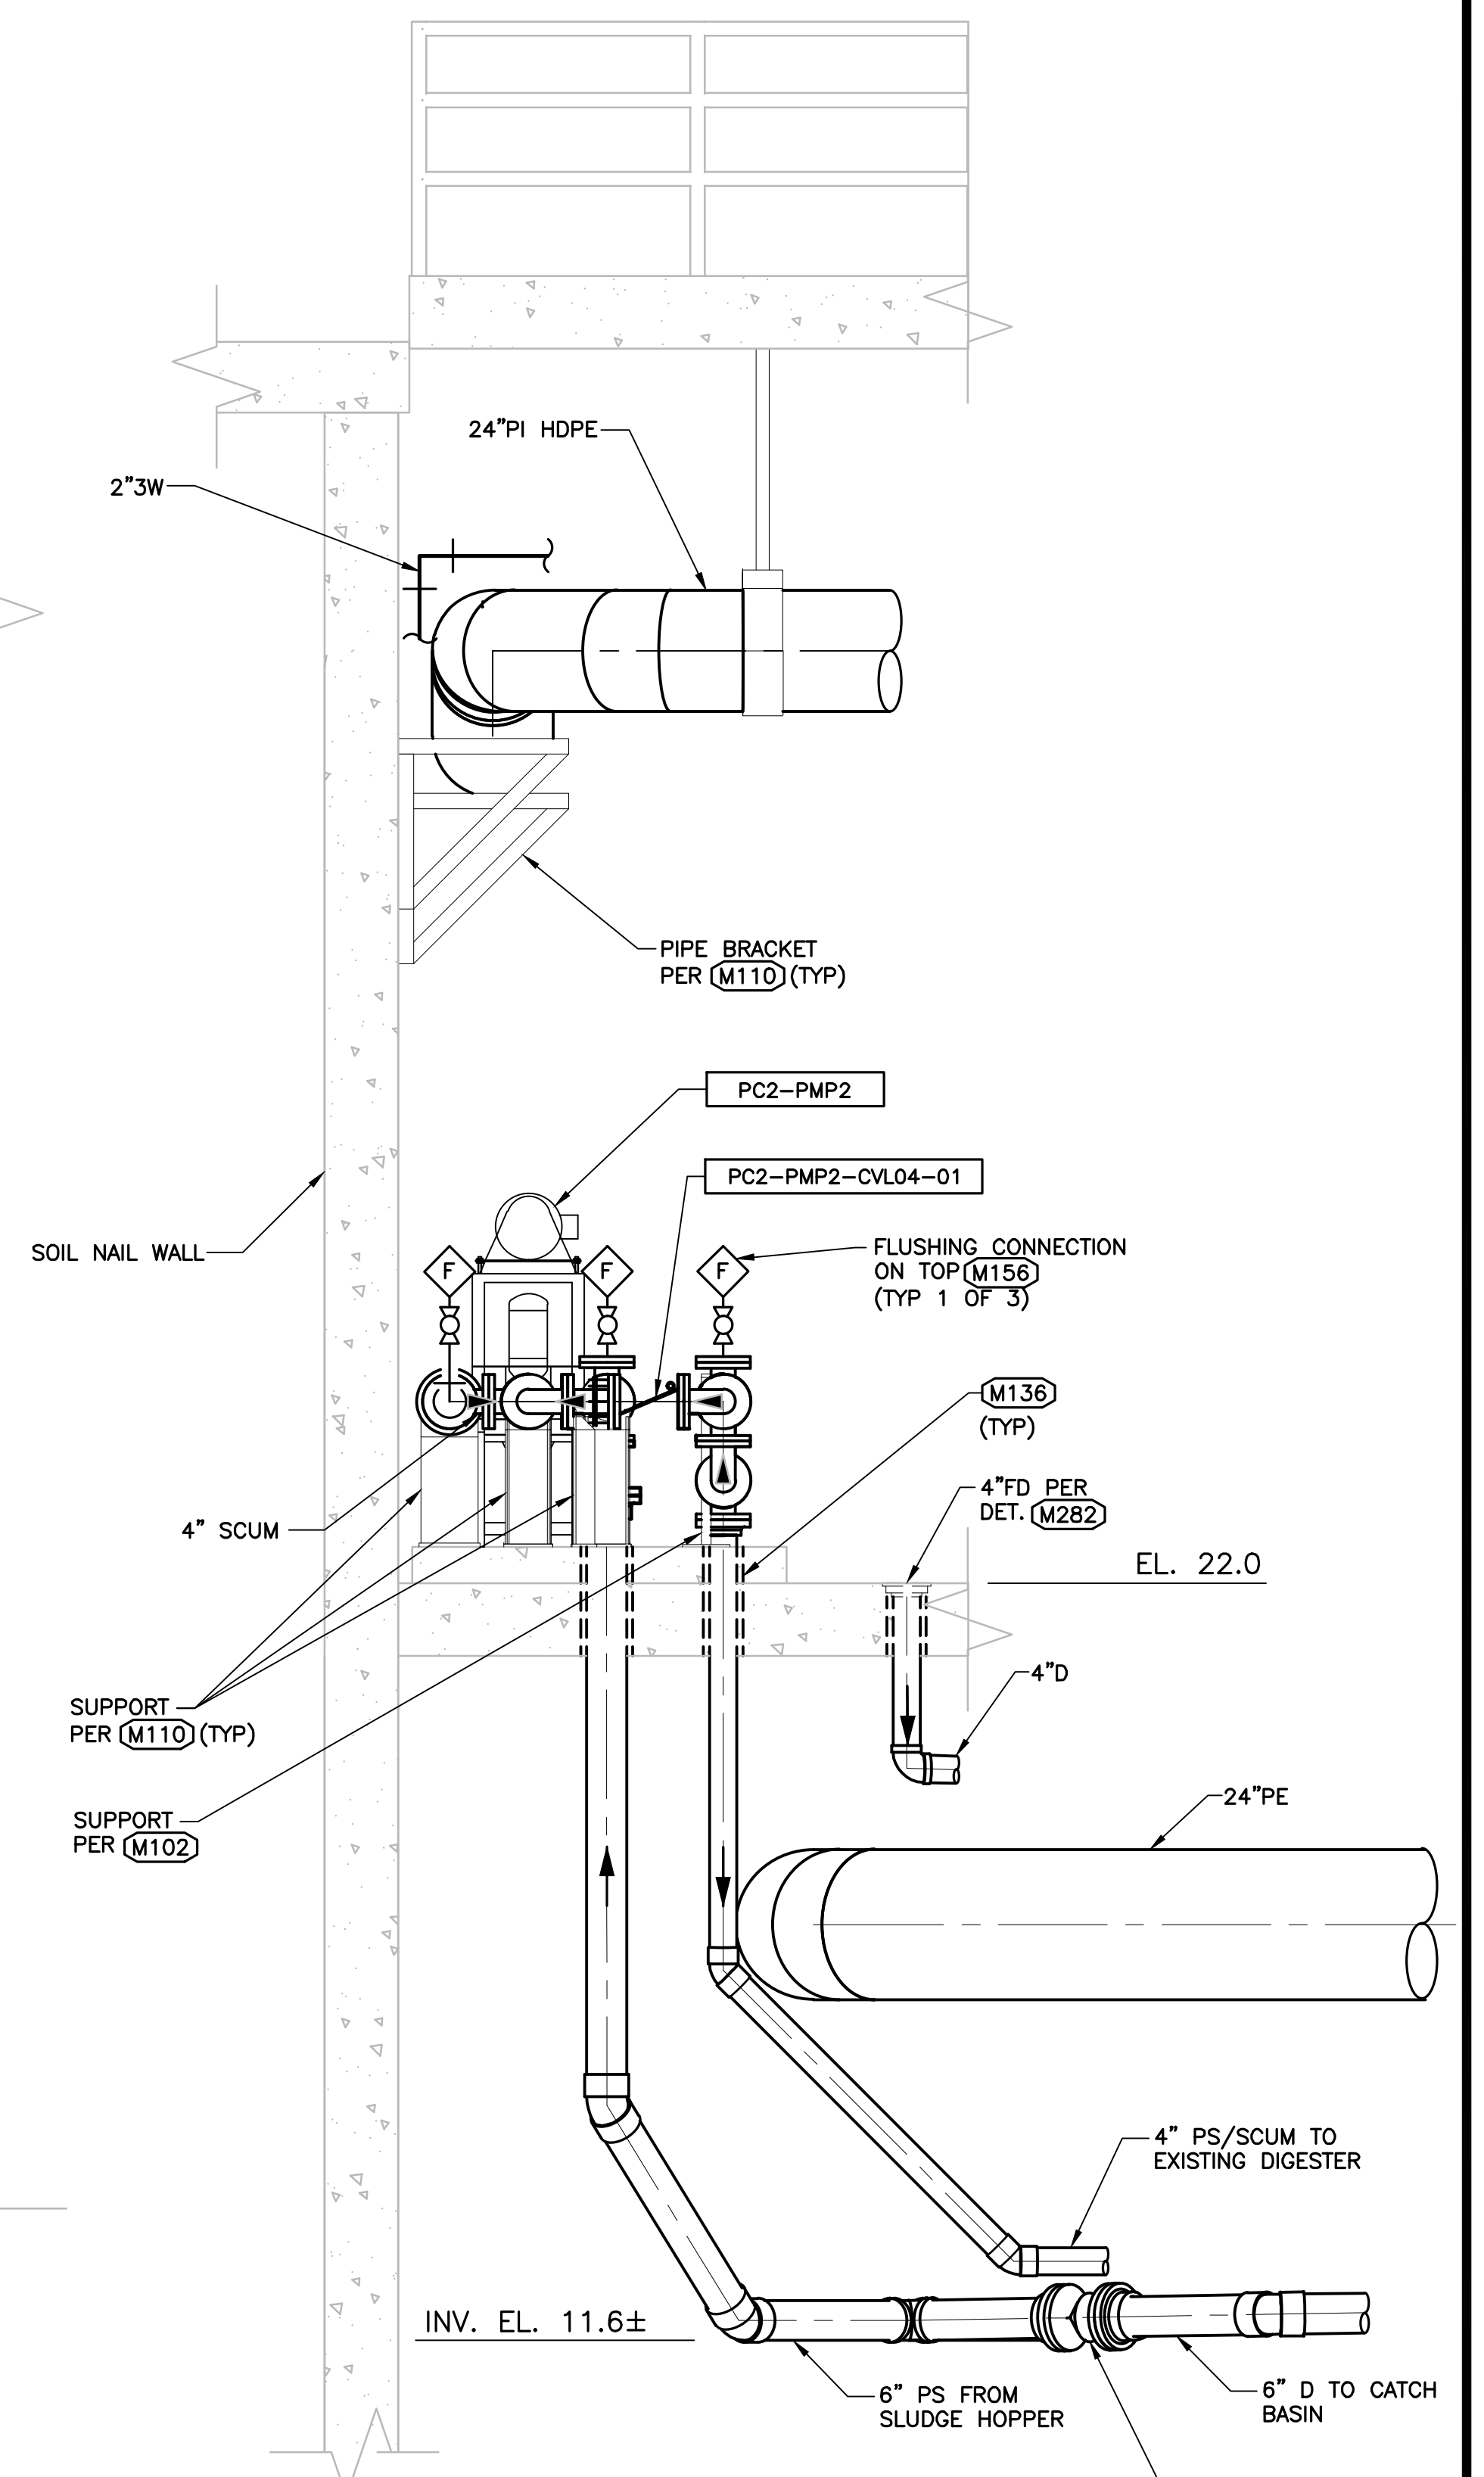

**SECTION**  
 SCALE: 1/2"=1'-0"

FILENAME: 0055-006-M210-1\_B-01-22\_11:42am.ctb | XREFS: | X-SMCSO-IBLK | X-Topic: Survey new | X-Site: | X-Station: | X-Treatment Plant: site plan | S-HEADWORKS-PLAN | X-Headworks Sections | cct--

**RECORD DRAWING**  
 THIS RECORD DRAWING HAS BEEN PREPARED FROM THE ORIGINAL CONTRACT DOCUMENTS SIGNED AND SEALED BY THE RESPONSIBLE ENGINEER OF RECORD. ADDITIONAL INFORMATION HAS BEEN PROVIDED BY OTHERS TO REPRESENT AS-CONSTRUCTED CONDITION AND IS SHOWN ON THESE RECORD DRAWINGS. THE RESPONSIBLE ENGINEER OF RECORD CANNOT VERIFY THE ACCURACY OF THE AS-CONSTRUCTED CONDITION INFORMATION REPRESENTED ON THE RECORD DRAWINGS.

0" = 1"  
 VERIFY SCALES - BAR IS ONE INCH LONG ON FULL SIZE DRAWING. IF NOT ONE INCH LONG ON THIS DRAWING, ADJUST SCALES ACCORDINGLY



REV	DATE	BY	APVD	DESCRIPTION
▲	07/22	CT	TV	RECORD DRAWING
▲				
▲				


DESIGNED	M. TAKEMOTO	SUBMITTED	MARK TAKEMOTO
DRAWN	S. NGUYEN		RMC PROJECT ENGINEER CE-64369
CHECKED	M. NAKAMOTO	APPROVED:	STEVE CLARY
			RMC ENGINEER CE-30318



TREATMENT AND WET WEATHER FLOW UPGRADE		DWG NO	M210-1
PRIMARY SLUDGE/SCUM PUMPS PARTIAL PLAN AND SECTION		SHEET NO	151 OF 226
		PROJ NO	055-006
		DATE	JULY 2022

**NOTE:**

1. CONTRACTOR SHALL PROVIDE ALL PIPE SUPPORT AS REQUIRED IN SECTION 15006. SUPPORT ANCHORAGE CALCULATION SHALL BE SUBMITTED TO THE CONSTRUCTION MANAGER FOR APPROVAL.

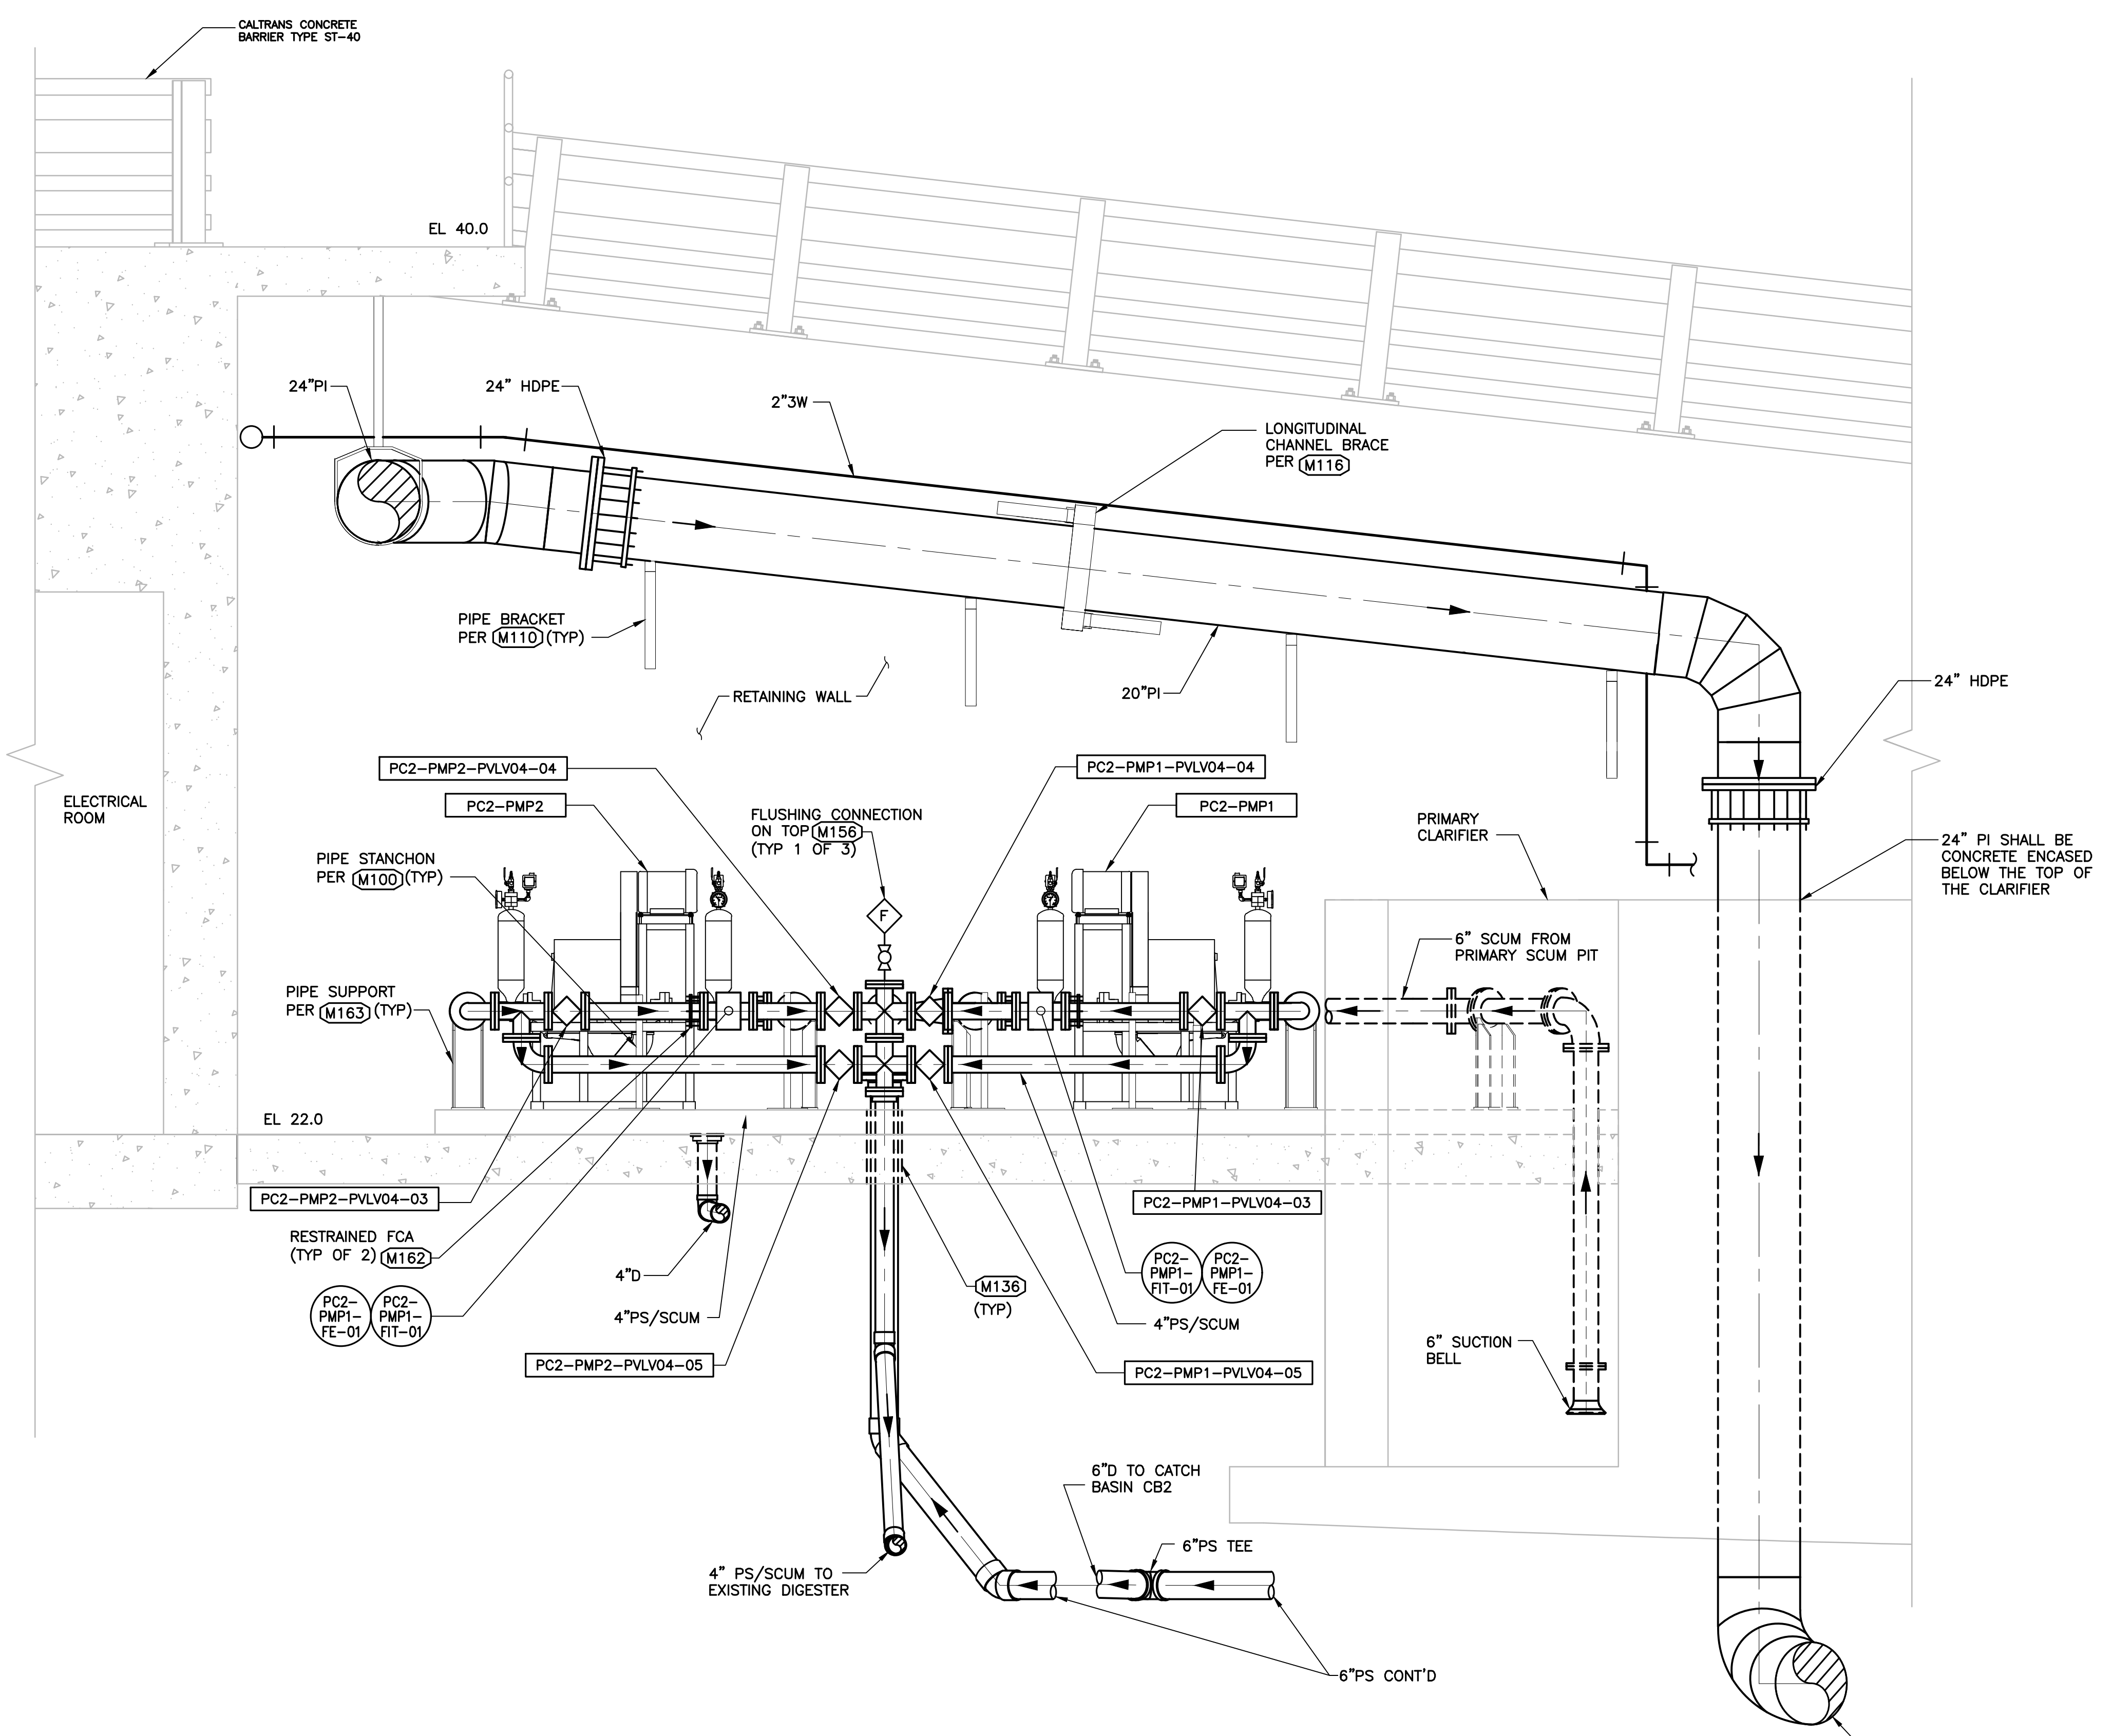

**SECTION M**  
SCALE: 1/2"=1'-0"  
M210-1

FILENAME: 0055-006-M210-2 - 8-01-22 11:43am.ctb XREFS: X-SMCSD-Bulk X-Headworks Sections X-Station kcc-

**RECORD DRAWING**  
 THIS RECORD DRAWING HAS BEEN PREPARED FROM THE ORIGINAL CONTRACT DOCUMENTS SIGNED AND SEALED BY THE RESPONSIBLE ENGINEER OF RECORD. ADDITIONAL INFORMATION HAS BEEN PROVIDED BY OTHERS TO REPRESENT AS-CONSTRUCTED CONDITION AND IS SHOWN ON THESE RECORD DRAWINGS. THE RESPONSIBLE ENGINEER OF RECORD CANNOT VERIFY THE ACCURACY OF THE AS-CONSTRUCTED CONDITION INFORMATION REPRESENTED ON THE RECORD DRAWINGS.

0" = 1"  
 VERIFY SCALES —  
 BAR IS ONE INCH  
 LONG ON FULL  
 SIZE DRAWING.  
 IF NOT ONE INCH  
 LONG ON THIS  
 DRAWING, ADJUST  
 SCALES ACCORDINGLY



REV	DATE	BY	APVD	DESCRIPTION
▲	07/22	CT	TV	RECORD DRAWING

DESIGNED: M. TAKEMOTO  
 DRAWN: S. NGUYEN  
 CHECKED: M. NAKAMOTO

SUBMITTED: MARK TAKEMOTO  
 RMC PROJECT ENGINEER CE-64369  
 APPROVED: STEVE CLARY  
 RMC ENGINEER CE-30318



TREATMENT AND WET WEATHER FLOW UPGRADE  
**PRIMARY SLUDGE/SCUM PUMPS  
 PARTIAL PLAN AND SECTION**

DWG NO: M210-2  
 SHEET NO: 152 OF 226  
 PROJ NO: 055-006  
 DATE: JULY 2022